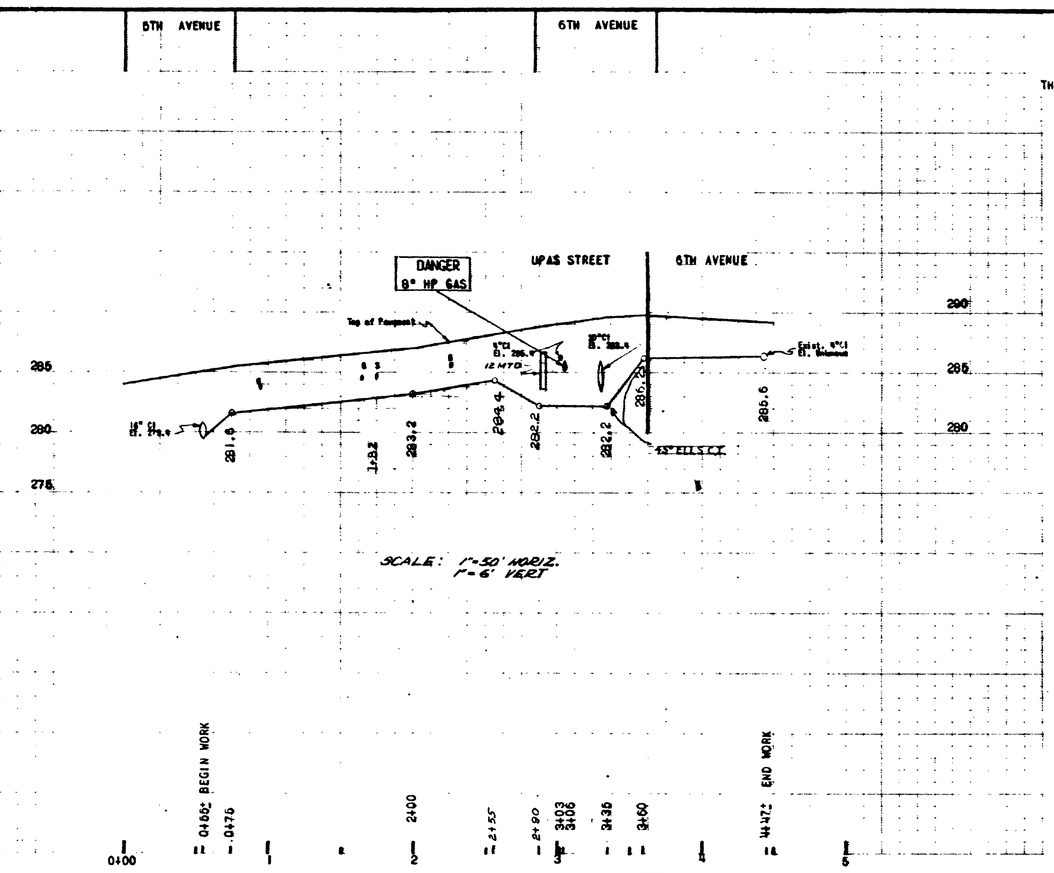

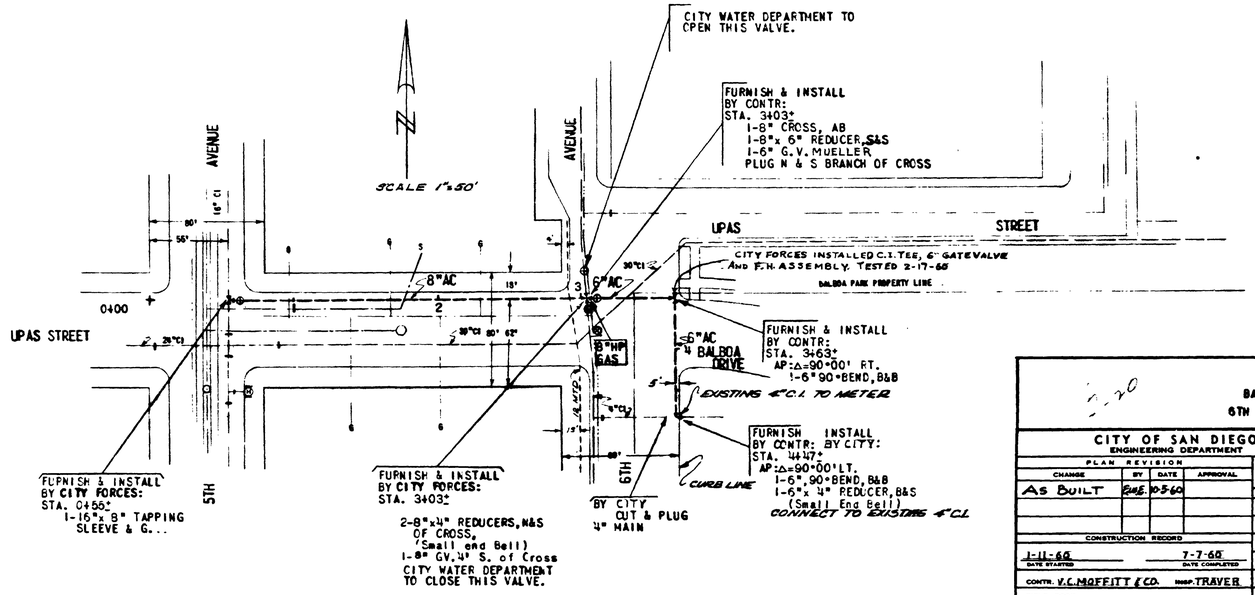

WORK TO BE DONE

THE IMPROVEMENT CONSISTS OF THE FOLLOWING WORK TO BE DONE ACCORDING TO THESE PLANS AND SPECIFICATIONS, HERETO ATTACHED:

THE CONSTRUCTION OF ASBESTOS CEMENT WATER MAINS AND APPURTENANCES AS SHOWN THUS: 8"A.C. 6"A.C.

THE FURNISHING AND INSTALLING OF GALVANIZED IRON PIPE AS SHOWN THUS: 1" G.I.

THE FURNISHING AND INSTALLING OF HOSE BIBBS & RISERS AS SHOWN THUS:

THE FURNISHING AND INSTALLING OF PRESSURE RELIEF VALVES AS SHOWN THUS:

ADDITIONAL WORK TO BE DONE SHOWN ON SHEET 1...

STANDARD DRAWINGS

702-EB, 206-WB, 212-WB, 240-WB, 231-WB, 238-WB, 243-WB, 402-WB, 224-WB, 7461-B, 5511-W

REDUCED PLAN
USE SCALE BELOW
0 1 2 3 4
4" ON ORIGINAL SCALE

BALBOA PARK SPRINKLER SYSTEM
6TH AVENUE, LAUREL STREET, ET AL

MICROFILMED APR - - 1963

CITY OF SAN DIEGO
ENGINEERING DEPARTMENT

SHEET 2 OF 13 SHEETS

W.O. NO. 21725

PLAN REVISION			
CHANGE	BY	DATE	APPROVAL
As Built	RHS	10-5-60	

CONSTRUCTION RECORD
1-11-60 DATE STARTED — 7-7-60 DATE COMPLETED
CONTR. V.C. MOFFITT & CO. INSP. TRAVER
FIELD BOOK

E. J. Fabian — 10/22/63 DATE
CITY ENGINEER

APPROVALS FOR: WATER DEPT., SEWERAGE, PLANNING DEPT., DRAINAGE, ELECTRICAL, HIGHWAY, STRUCTURAL, GRADES, TRAFFIC, CONTROL

ASS'T CITY ENGINEER AND OFFICE ENGINEER
SUPERVISOR
CHECKED
DESIGNED — GARRETT
7045 - D