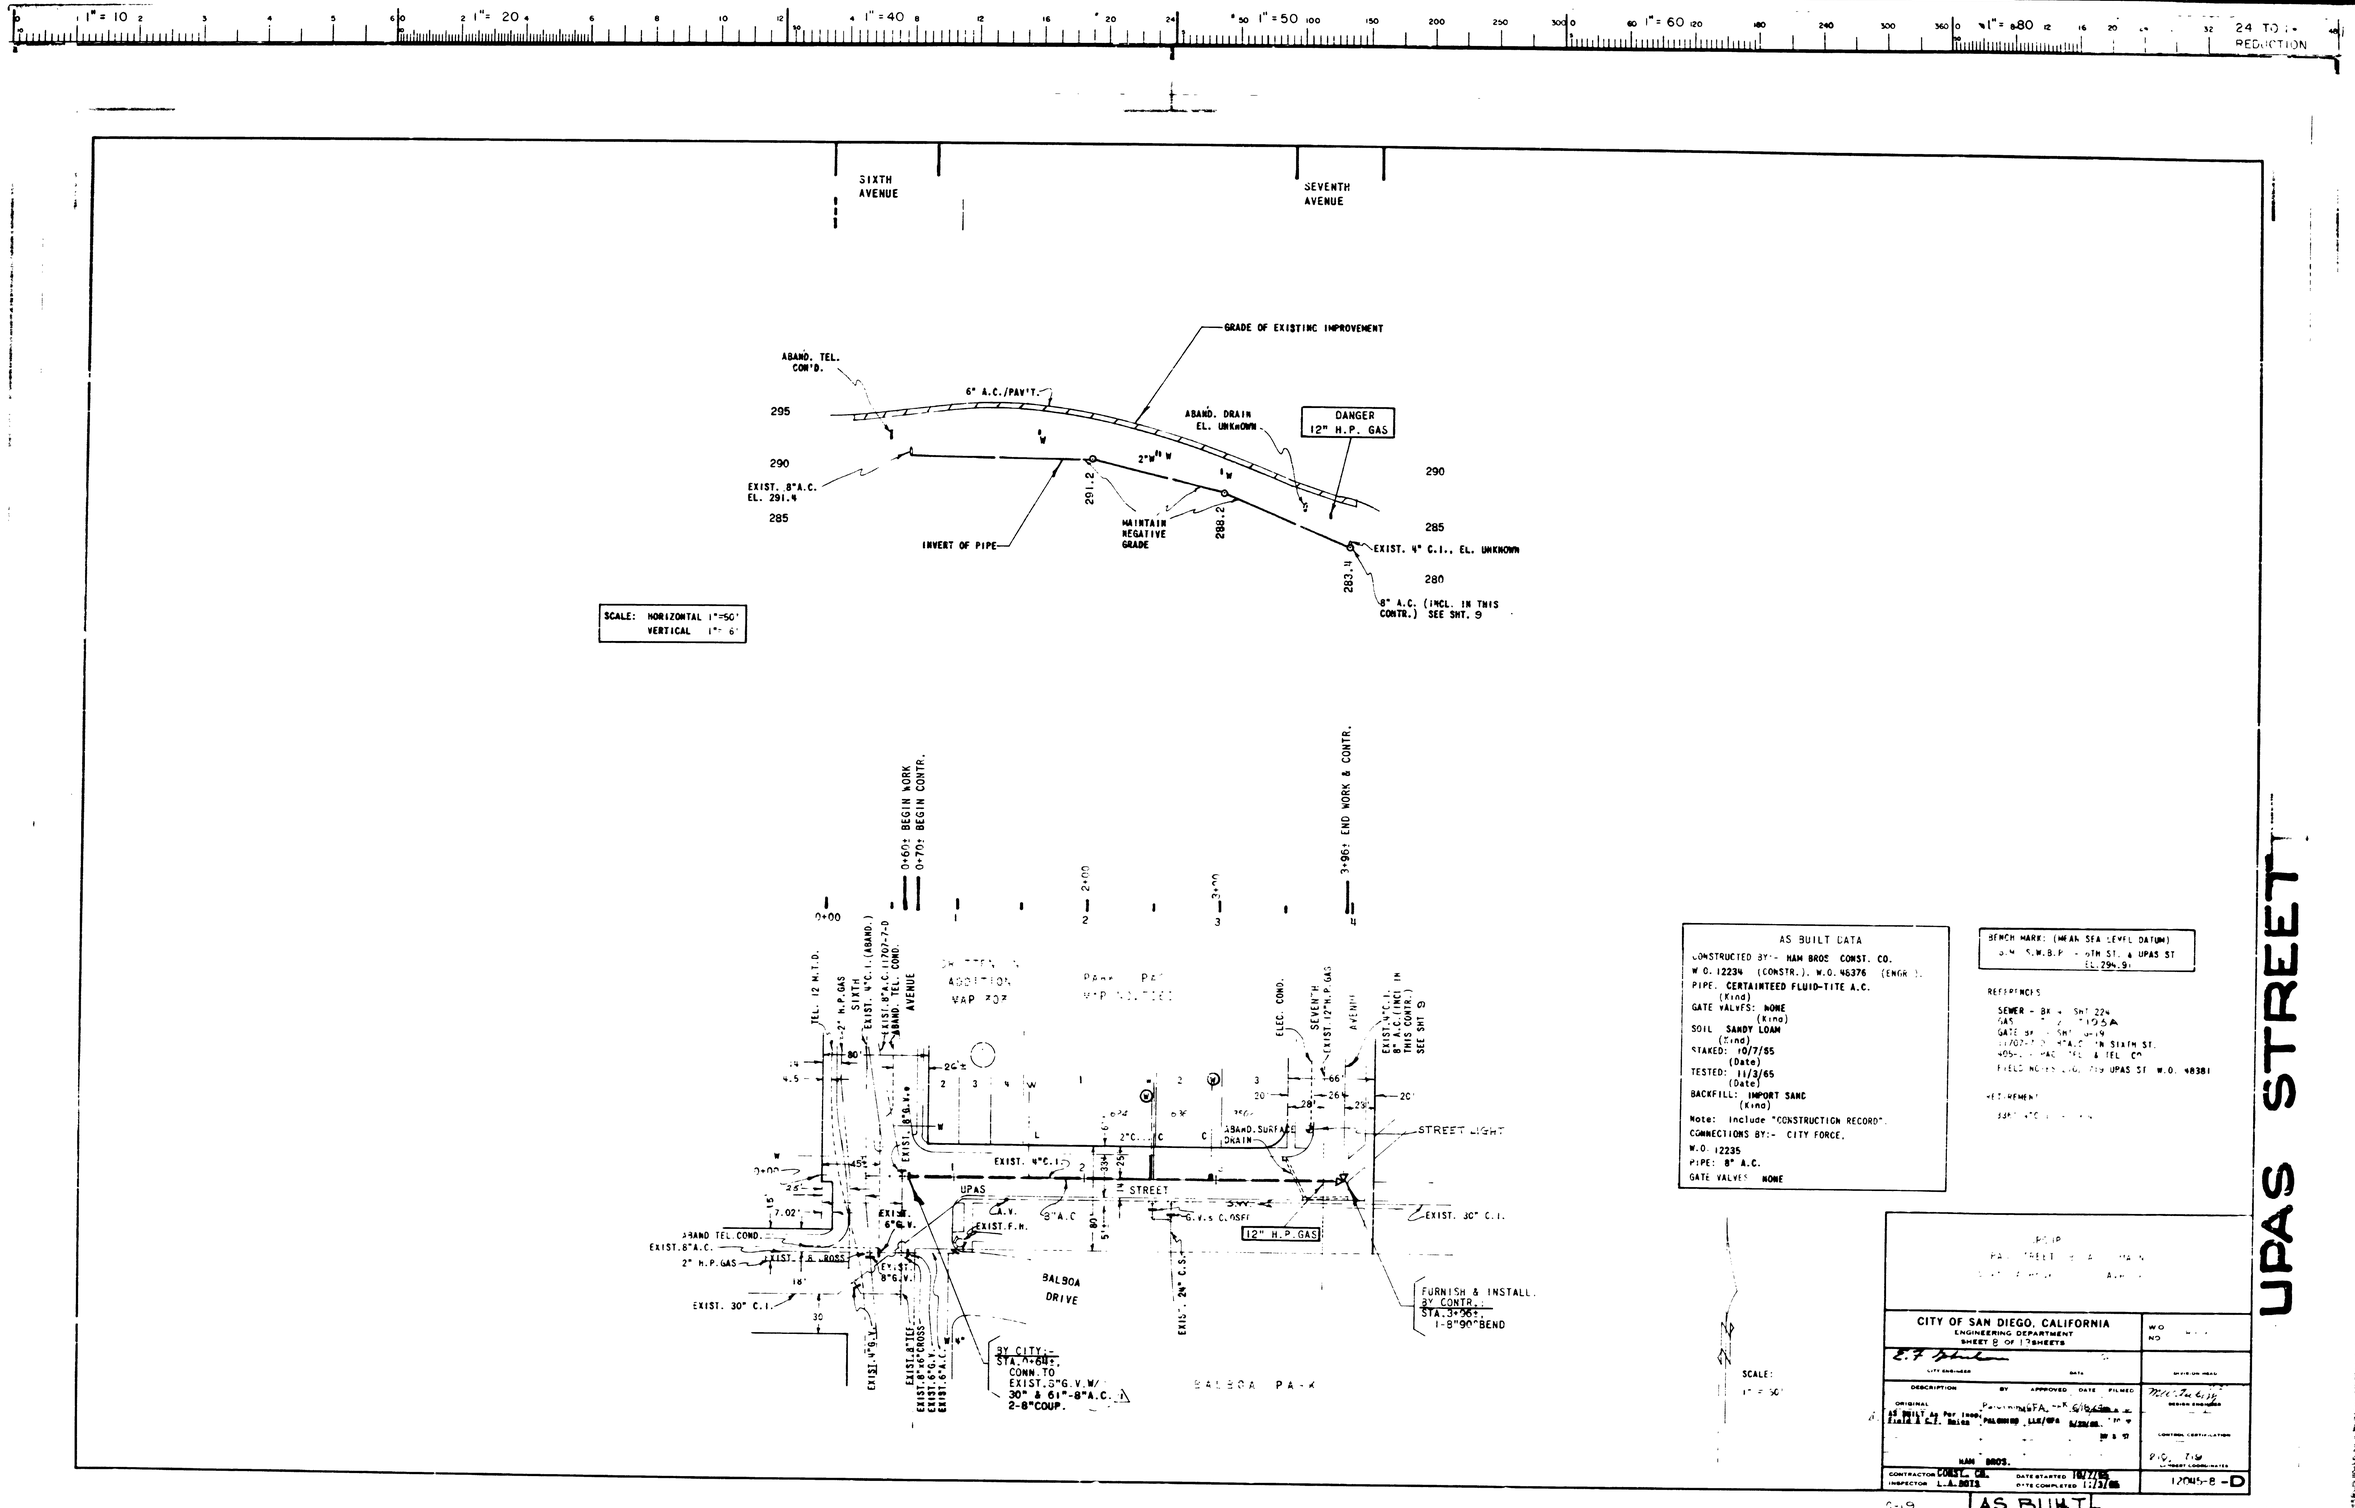
SIXTH AVENUE
SEVENTH AVENUE
GRADE OF EXISTING IMPROVEMENT
ABAND. TEL. CON'D.
6" A.C./PAV'T.
ABAND. DRAIN EL. UNKNOWN
DANGER 12" H.P. GAS
EXIST. 8"A.C. EL. 291.4
INVERT OF PIPE
MAINTAIN NEGATIVE GRADE
291.2
288.2
283.4
EXIST. 4" C.I., EL. UNKNOWN
8" A.C. (INCL. IN THIS CONTR.) SEE SHT. 9
SCALE: HORIZONTAL 1"=50' VERTICAL 1"= 6'
0+60± BEGIN WORK
0+70± BEGIN CONTR.
3+96± END WORK & CONTR.
0+00
2+00
3+00
TEL. 12 M.T.D.
2" H.P. GAS
SIXTH AVENUE
EXIST. 8"G.V.
ABAND. TEL. COND.
ELEC. COND.
SEVENTH AVENUE
EXIST. 12"H.P. GAS
EXIST. 8" A.C. (INCL. IN THIS CONTR.) SEE SHT 9
STREET LIGHT
ABAND. SURFACE DRAIN
EXIST. 4"C.I.
UPAS STREET
EXIST. 30" C.I.
ABAND. TEL. COND.
EXIST. 8"A.C.
2" H.P. GAS
EXIST. 8" CROSS
EXIST. 8"G.V.
EXIST. F.H.
8"A.C.
G.V.s CLOSED
12" H.P. GAS
BALBOA DRIVE
EXIST. 24" C.S.P.
FURNISH & INSTALL. BY CONTR.. STA. 3+96±. 1-8"90°BEND
BY CITY:- STA. 0+60±. CONN. TO EXIST. 5"G.V. W/ 30" & 61"-8"A.C. 2-8"COUP.
EXIST. 8"TEE
EXIST. 8"x6" CROSS
EXIST. 6"G.V.
EXIST. 6"A.C.
BALBOA PARK
AS BUILT DATA
CONSTRUCTED BY:- HAM BROS CONST. CO.
W.O. 12234 (CONSTR.). W.O. 48376 (ENGR.).
PIPE: CERTAINTEED FLUID-TITE A.C.
GATE VALVES: NONE
SOIL: SANDY LOAM
STAKED: 10/7/55 (Date)
TESTED: 11/3/65 (Date)
BACKFILL: IMPORT SAND
Note: Include "CONSTRUCTION RECORD".
CONNECTIONS BY:- CITY FORCE.
W.O. 12235
PIPE: 8" A.C.
GATE VALVES: NONE
BENCH MARK: (MEAN SEA LEVEL DATUM)
S.W.B.P. - 6TH ST. & UPAS ST
EL. 294.91
REFERENCES
SEWER - BK. - SHT. 22%
GAS
GATE BK. - SHT. 4-19
SEWER - 8" A.C. IN SIXTH ST.
WATER - 8" A.C. TEL & TEL CO.
ELEC. NOTES - W.O. 7-19 UPAS ST. W.O. 48381
SCALE:
1" = 50'
CITY OF SAN DIEGO, CALIFORNIA
ENGINEERING DEPARTMENT
SHEET 8 OF 17 SHEETS
DESCRIPTION
BY
APPROVED
DATE
FILMED
ORIGINAL
AS BUILT As Per Inspr. Field & C.F. Notes
HAM BROS.
CONTRACTOR COMST. CO.
INSPECTOR L.A. BOTA
DATE STARTED 10/7/55
DATE COMPLETED 11/3/65
12045-8-D
AS BUILT
UPAS STREET