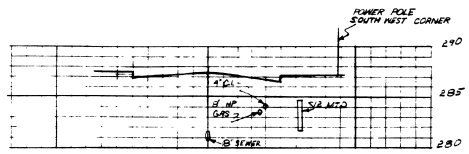

CROSS SECTION OF SIXTH AVE. AT THORN ST.

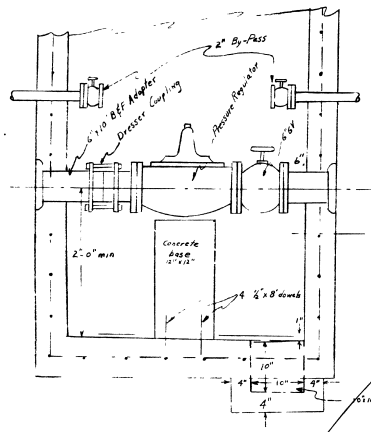

PRESSURE REGULATOR VAULT
Adapt Type F Storm Drain Cleanout sec 311E8
Make manhole cover flush with ground
Vault includes 2" By Pass

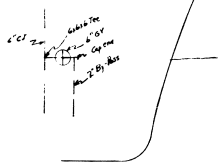

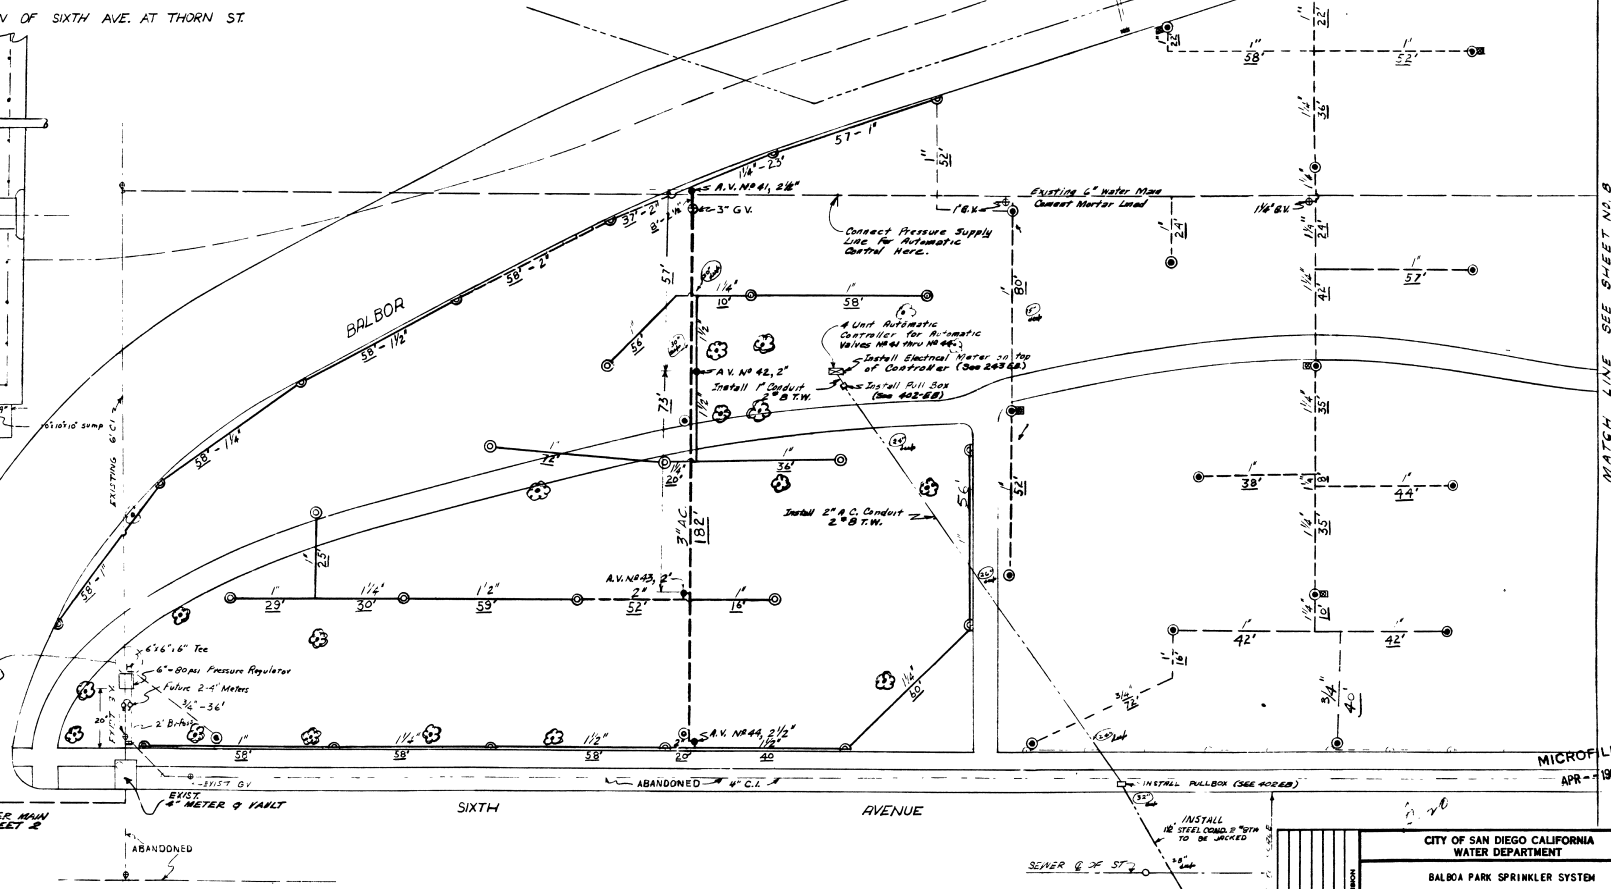

MICROFILMED
APR - 1 1963

REDUCED PLAN
USE SCALE BELOW
0 1 2 3 4
4" ON ORIGINAL SCALE

ELECTRICAL PLAN REVISION			
CHANGE	BY	DATE	APPROV
NONE			
"As Built"			
CONSTRUCTION RECORD			
2-7-60		6-23-60	
DATE STARTED		DATE COMPLETED	
SUB CONTR.	Ess Bolkin & Sellers, Inc.	E.E. Russell	

REVISION			
NO.	DATE	BY	

CITY OF SAN DIEGO CALIFORNIA
WATER DEPARTMENT

BALBOA PARK SPRINKLER SYSTEM
6TH AVENUE, LAUREL STREET, ET AL

RECOMMENDED: HYDRAULIC ENGINEER — APPROVED: C. F. Schneider, CITY ENGINEER
DATE 8/12/49 — DATUM:
DRAWN: Schneider — TRACED: — CHECKED: [illegible] 7/1/49
F. B. — SCALE
WD-21725 — SHEET 9 OF 13 SHEETS — FILE NO. 7052-D

9866-D Sheet 9
9869-D Sheet 13
"As Built" 10-5-60 EHE

9