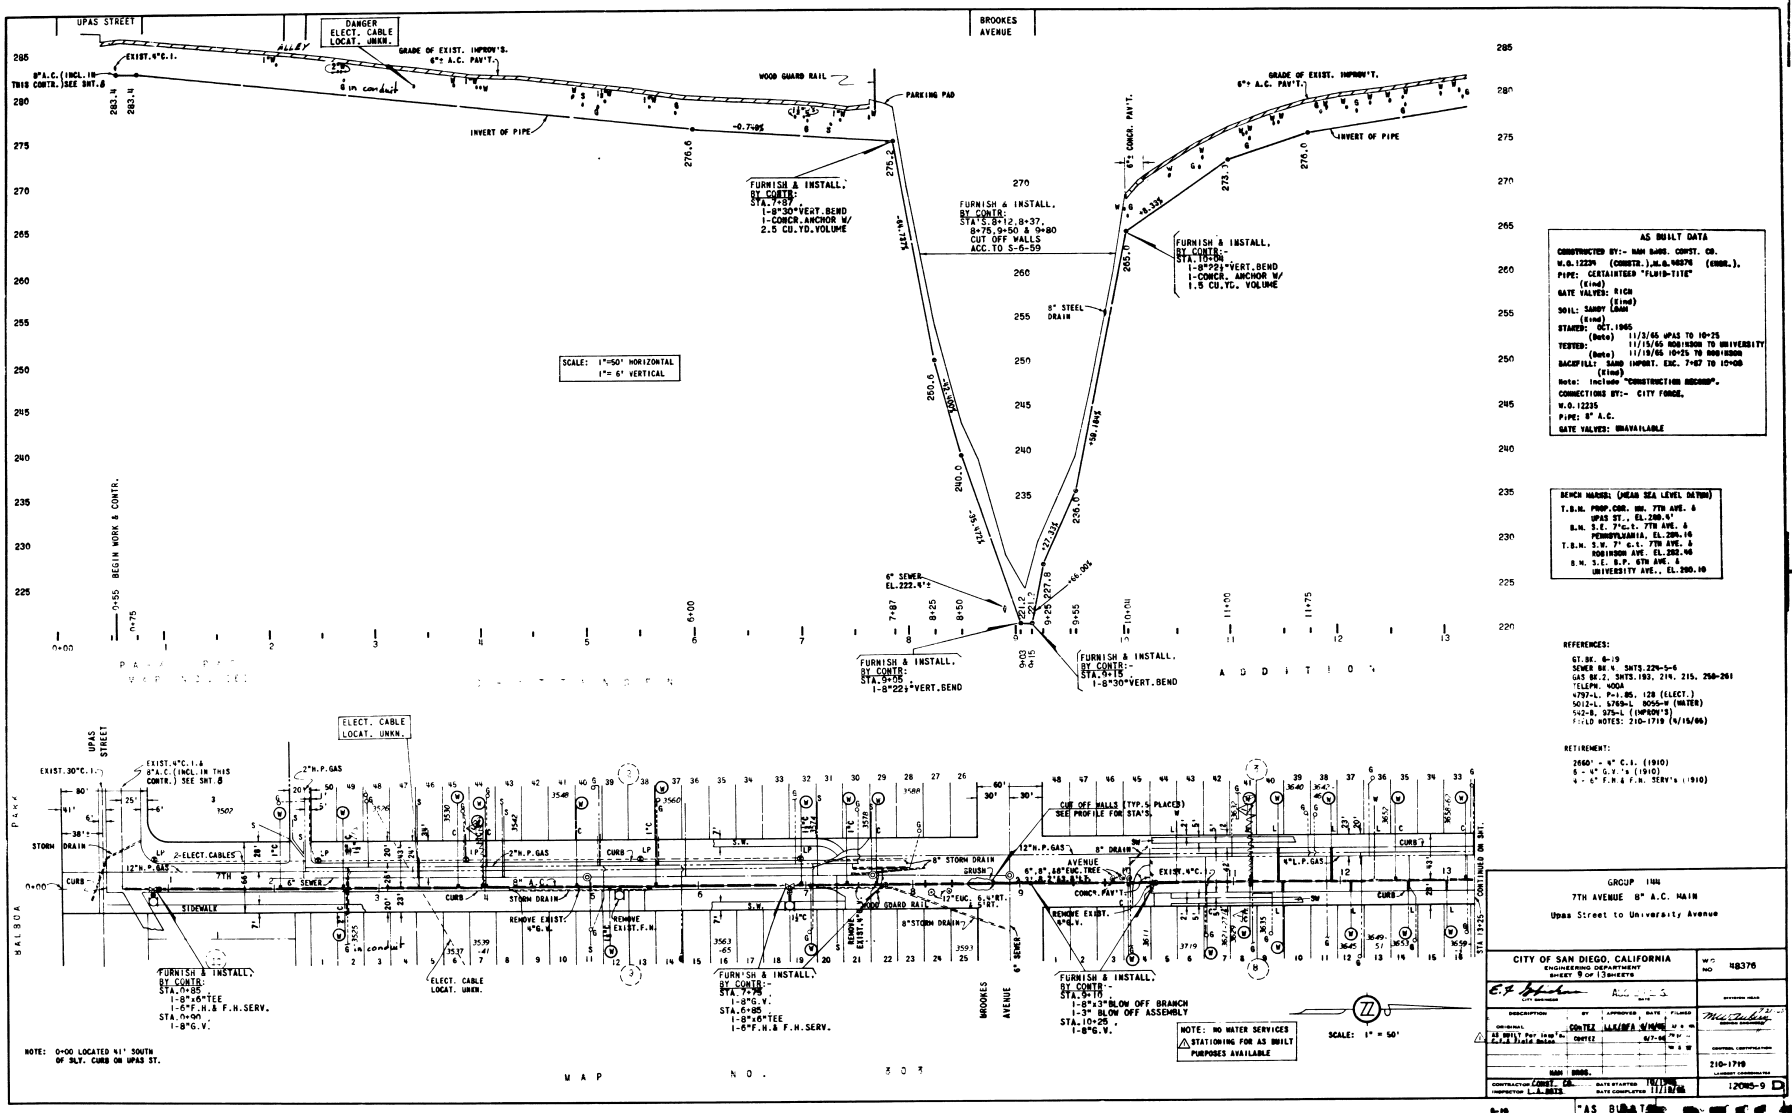

AS BUILT DATA

CONSTRUCTED BY:- NAH BROS. CONST. CO.
W.O.12234 (CONSTR.),W.O.48376 (ENGR.).
PIPE: CERTAINTEED "FLUID-TITE" (Kind)
GATE VALVES: RICH (Kind)
SOIL: SANDY LOAM (Kind)
STARTED: OCT.1965 (Date) 11/3/65 UPAS TO 10+25
TESTED: 11/15/65 ROBINSON TO UNIVERSITY (Date) 11/19/65 10+25 TO ROBINSON
BACKFILL: SAND IMPORT. EXC. 7+87 TO 10+08 (Kind)
Note: Include "CONSTRUCTION ASCAMP".
CONNECTIONS BY:- CITY FORCE.
W.O.12235
PIPE: 8" A.C.
GATE VALVES: UNAVAILABLE

BENCH MARKS: (MEAN SEA LEVEL DATUM)

T.B.M. PROP.COR. NE. 7TH AVE. & UPAS ST., EL.280.4'
B.M. S.E. 7"c.t. 7TH AVE. & PENNSYLVANIA, EL.284.16
T.B.M. S.W. 7" c.t. 7TH AVE. & ROBINSON AVE. EL.282.46
B.M. S.E. B.P. 6TH AVE. & UNIVERSITY AVE., EL.280.10

REFERENCES:

GT.DV. 6-19
SEWER BK.4 SHTS.224-5-6
GAS BK.2, SHTS.193, 214, 215, 258-261
TELEPH. VOCA
4797-L, P-1.85, 128 (ELECT.)
5012-L, 5769-L (WATER)
542-B, 975-L (IMPROV'S)
FIELD NOTES: 210-1719 (4/15/66)

RETIREMENT:

2660' - 4" C.I. (1910)
5 - 4" G.V.'s (1910)
4 - 6" F.H.& F.H. SERV's (1910)

GROUP 1144
7TH AVENUE 8" A.C. MAIN
Upas Street to University Avenue

CITY OF SAN DIEGO, CALIFORNIA
ENGINEERING DEPARTMENT
SHEET 9 OF 13 SHEETS

CITY ENGINEER — DATE

DESCRIPTION	BY	APPROVED	DATE	FILMED
ORIGINAL		CONTZ		
AS BUILT Per Inst'n. F.J.'s Field Notes	CONTZ		6/7-66	

CONTRACTOR NAH BROS. CONST. CO. — DATE STARTED 11/3/65
INSPECTOR L.L. BATES — DATE COMPLETED 11/19/65

W.O. NO. 48376
DIVISION HEAD
CONTROL CERTIFICATION
210-1719
LAYOUT COORDINATES
12085-9 D

"AS BUILT"

AS BUILT