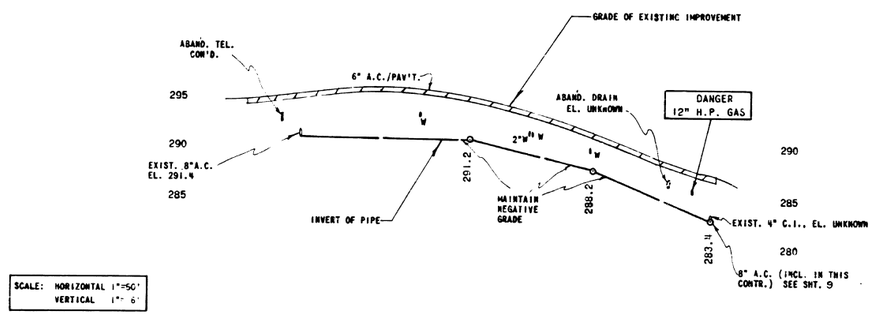

SCALE: HORIZONTAL 1"=50'
VERTICAL 1"= 6'

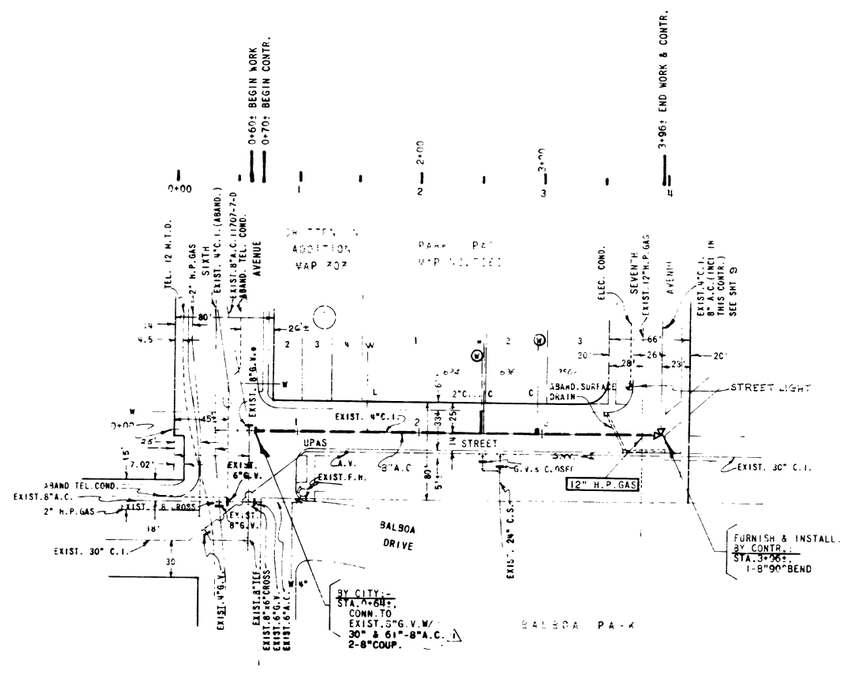

AS BUILT DATA

CONSTRUCTED BY:- HAM BROS CONST. CO.
W.O. 12234 (CONSTR.). W.O. 46376 (ENGR.)
PIPE: CERTAINTEED FLUID-TITE A.C.
(Kind)
GATE VALVES: NONE
(Kind)
SOIL: SANDY LOAM
(Kind)
STAKED: 10/7/55
(Date)
TESTED: 11/3/65
(Date)
BACKFILL: IMPORT SAND
(Kind)
Note: Include "CONSTRUCTION RECORD".
CONNECTIONS BY:- CITY FORCE.
W.O. 12235
PIPE: 8" A.C.
GATE VALVES: NONE

BENCH MARK: (MEAN SEA LEVEL DATUM)
B.M. S.W.B.P. - 6TH ST. & UPAS ST
EL. 294.91

REFERENCES
SEWER - BK. - SHT. 224
GAS - [illegible] 19.5 A
GATE BK. - SHT. [illegible]
[illegible] 8" A.C. IN SIXTH ST.
[illegible] & TEL. CO.
FIELD NOTES [illegible] UPAS ST. W.O. 48381

RETIREMENT
[illegible]

SCALE:
1" = 50'

CITY OF SAN DIEGO, CALIFORNIA
ENGINEERING DEPARTMENT
SHEET 8 OF 17 SHEETS

W.O. [illegible]
NO. [illegible]

CITY ENGINEER — DATE — DIVISION HEAD

DESCRIPTION	BY	APPROVED	DATE	FILMED
ORIGINAL				
AS BUILT As Per Inspr. Field & C.F. Notes	PAL/DWD	LLK/GPA	8/30/66	

DESIGN ENGINEER — CONTROL CERTIFICATION — PROJ. ENGR. — CURRENT COORDINATES

CONTRACTOR: HAM BROS. CONST. CO. — DATE STARTED: 10/7/65
INSPECTOR: L.A. BOTS — DATE COMPLETED: 12/3/65

12045-8-D

UPAS STREET

AS BUILT

AS BUILT