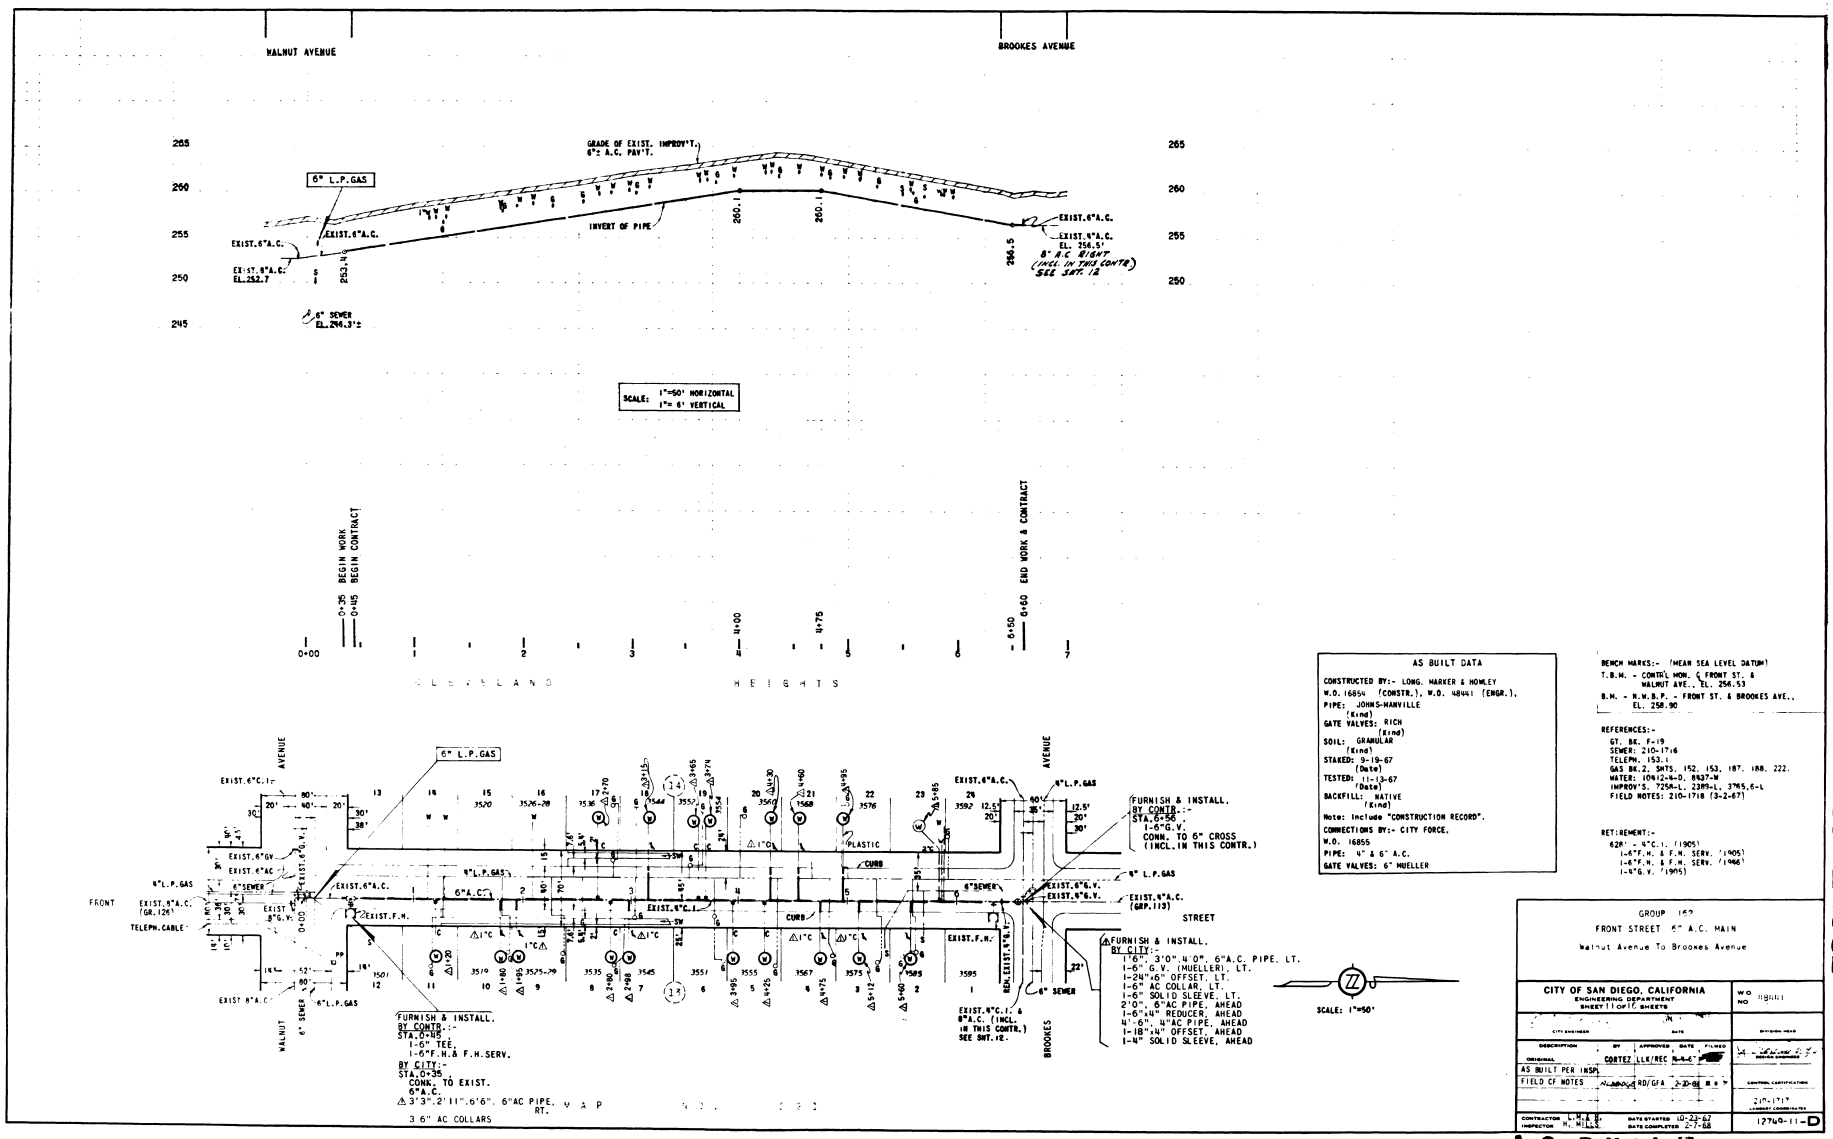
WALNUT AVENUE
BROOKES AVENUE
GRADE OF EXIST. IMPROV'T. 6"± A.C. PAV'T.
6" L.P.GAS
INVERT OF PIPE
EXIST.6"A.C.
EXIST.8"A.C. EL.252.7
6" SEWER EL.246.3'±
EXIST.4"A.C. EL. 256.5'
8" A.C. RIGHT (INCL. IN THIS CONTR.) SEE SHT. 12
SCALE: 1"=50' HORIZONTAL 1"= 6' VERTICAL
0+35 BEGIN WORK
0+45 BEGIN CONTRACT
6+50 END WORK & CONTRACT
CLEVELAND HEIGHTS
FRONT
STREET
WALNUT AVENUE
BROOKES AVENUE
FURNISH & INSTALL. BY CONTR.:- STA.6+56 1-6"G.V. CONN. TO 6" CROSS (INCL. IN THIS CONTR.)
FURNISH & INSTALL. BY CITY:- 1'6", 3'0", 4'0", 6"A.C. PIPE, LT. 1-6" G.V. (MUELLER), LT. 1-24"x6" OFFSET, LT. 1-6" AC COLLAR, LT. 1-6" SOLID SLEEVE, LT. 2'0", 6"AC PIPE, AHEAD 1-6"x4" REDUCER, AHEAD 4'-6", 4"AC PIPE, AHEAD 1-18"x4" OFFSET, AHEAD 1-4" SOLID SLEEVE, AHEAD
FURNISH & INSTALL. BY CONTR.:- STA.0+45 1-6" TEE, 1-6"F.H.& F.H.SERV. BY CITY:- STA.0+35 CONN. TO EXIST. 6"A.C. 3'3",2'11",6'6", 6"AC PIPE, RT.
3 6" AC COLLARS
SCALE: 1"=50'
AS BUILT DATA
CONSTRUCTED BY:- LONG, MARKER & HOWLEY
W.O. 16854 (CONSTR.), W.O. 48441 (ENGR.),
PIPE: JOHNS-MANVILLE (Kind)
GATE VALVES: RICH (Kind)
SOIL: GRANULAR (Kind)
STAKED: 9-19-67 (Date)
TESTED: 11-13-67 (Date)
BACKFILL: NATIVE (Kind)
Note: Include "CONSTRUCTION RECORD".
CONNECTIONS BY:- CITY FORCE,
W.O. 16855
PIPE: 4" & 6" A.C.
GATE VALVES: 6" MUELLER
BENCH MARKS:- (MEAN SEA LEVEL DATUM)
T.B.M. - CONTR'L MON. ℄ FRONT ST. & WALNUT AVE., EL. 256.53
B.M. - N.W.B.P. - FRONT ST. & BROOKES AVE., EL. 258.90
REFERENCES:-
GT. BK. F-19
SEWER: 210-1716
TELEPH. 153.1
GAS BK.2, SHTS. 152, 153, 187, 188, 222.
WATER: 10412-4-D, 8437-W
IMPROV'S. 7254-L, 2389-L, 3765,6-L
FIELD NOTES: 210-1718 (3-2-67)
RET:REMENT:-
628' - 4"C.I. (1905)
1-6"F.H. & F.H. SERV. (1905)
1-6"F.H. & F.H. SERV. (1946)
1-4"G.V. (1905)
GROUP 162
FRONT STREET 6" A.C. MAIN
Walnut Avenue To Brookes Avenue
CITY OF SAN DIEGO, CALIFORNIA
ENGINEERING DEPARTMENT
SHEET 11 OF 16 SHEETS
W.O. NO. 48441
CITY ENGINEER
DATE
DIVISION HEAD
DESCRIPTION
BY
APPROVED
DATE
FILMED
ORIGINAL
CORTEZ
LLK/REC
AS BUILT PER INSP.
FIELD CF NOTES
RD/GFA
CONTROL CERTIFICATION
210-1717
LANDSCAPE COORDINATES
CONTRACTOR L.M.& B.
INSPECTOR N. MILLS
DATE STARTED 10-23-67
DATE COMPLETED 2-7-68
12749-11-D
AS BUILT
FRONT ST.