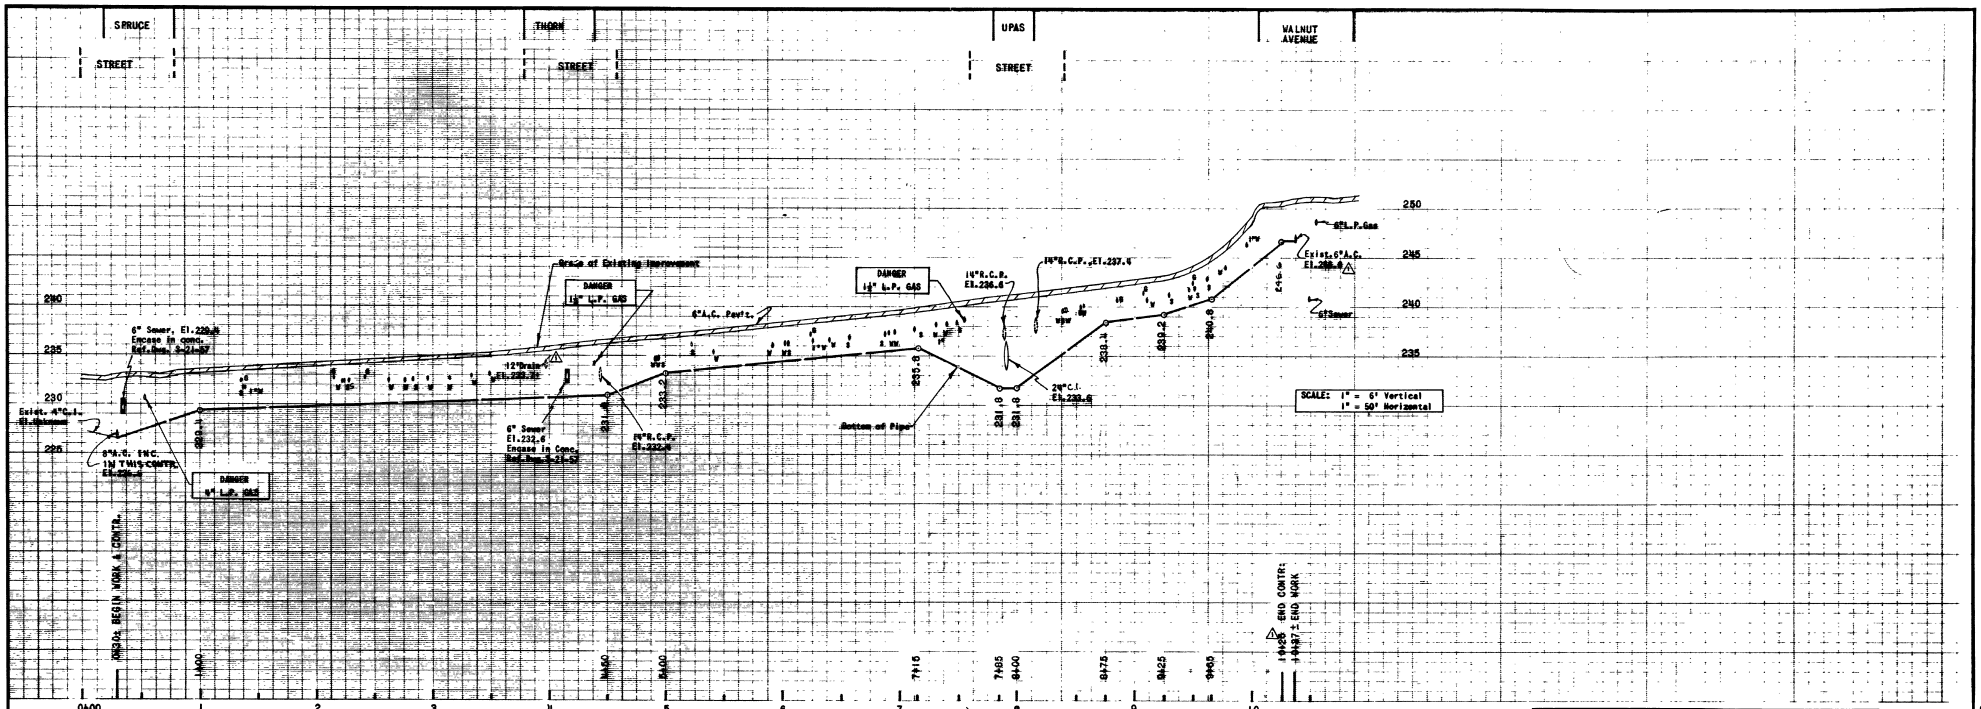

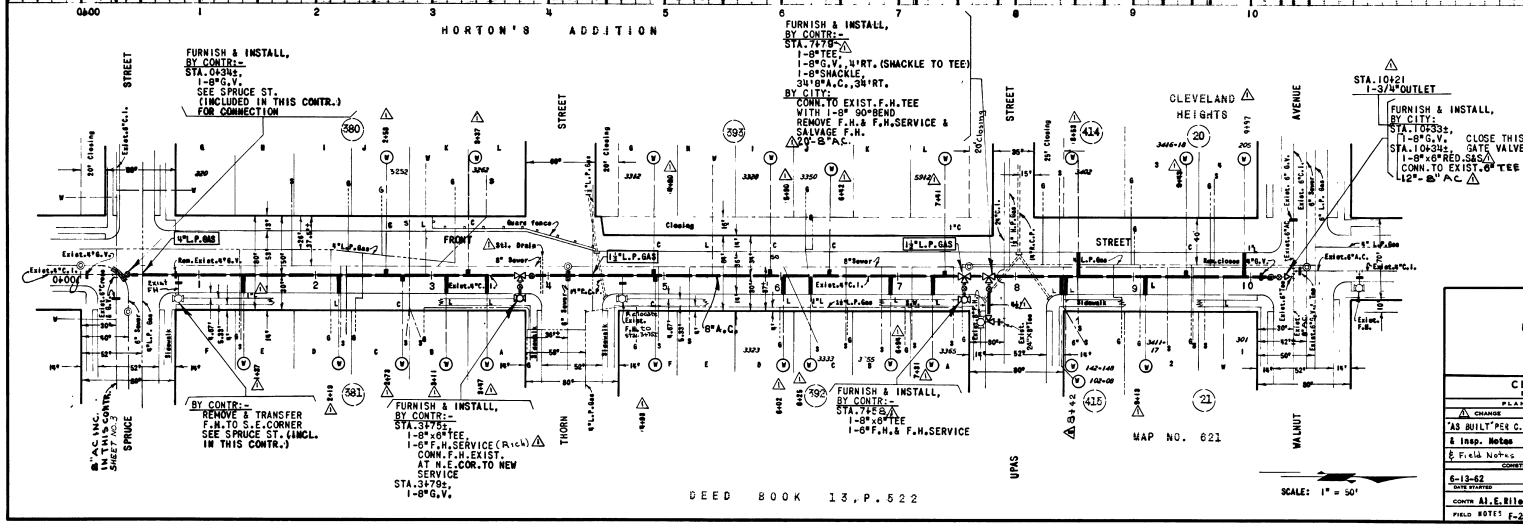

AS BUILT DATA

CONSTRUCTED BY:- Al.E. Riley
W.O.19854 (CONSTR.), W.O.48273 (ENGR.)
PIPE: K-M Fluid Tite (Kind)
GATE VALVES: Mueller (Kind)
SOIL: Red granular (Kind)
STAKED: 6-7-62 (Date)
TESTED: 7-13-62 (Date)
BACKFILL: Select (Kind)
NOTE: Include "CONSTRUCTION RECORD".
CONNECTIONS BY:- CITY FORCE, W.O. 19855
PIPE: 8" A.C.
GATE VALVES: Pacific States

BENCH MARK: (City Datum)
B.M. N.E.B.P. Spruce St. & Front St.
Elev. 233.96

REFERENCES:
Water Rk. #10, Shts. F-19-C & F-20-B
Sewer Books #1 & 4, Sht. 43
Gas Book, #2, Shts. 100, 101, 140, 141, 152 & 153
Gate Book, Sht. A-45
1823-L Pav. Front St.
1317-L Pav. Spruce St.
5927-L 24" C.I. @ Upas St.
4186-B Closing on Front St.
Resolution 11841 & 8191 Closing Spruce St.

RETIREMENT:
1007' 4" C.I. 9-09
2 - 4" G.V.s "
2 - 6" F.H. Services 9-09
1 - 8" F.H. & F.H. Service 1-41

GROUP 126
FRONT STREET 8" A.C. MAIN
Spruce Street to Walnut Avenue

ENGINEERING W.O. 48273

MICROFILMED

CITY OF SAN DIEGO
ENGINEERING DEPARTMENT

SHEET 4 OF 13 SHEETS

PLAN REVISION			
CHANGE	BY	DATE	APPROVAL
"AS BUILT" PER C.F. & Insp. Notes & Field Notes	P.P.	2-11-63	

CONSTRUCTION RECORD
6-13-62 DATE STARTED
7-24-62 DATE COMPLETED
CONTR. Al.E. Riley
TALBO DEX ABOVE
INSP. H. Mills
FIELD NOTES F-20

CITY ENGINEER 11/5/62 DATE

APPROVALS FOR
WATER DEPT. | SEWERAGE
PLANNING DEPT. | DRAINAGE
ELECTRICAL | HIGHWAY
STRUCTURAL | GRADES
TRAFFIC | CONTROL

ASS'T CITY ENGINEER AND OFFICE ENGINEER
SUPERVISOR
CROSBY: KLEE CHECKED
KLEE: PALOMINO DESIGNED 11-13-61

10,412-4-D

F-19-C & F-20-B

"AS BUILT"

MICROFILMED

FRONT STREET