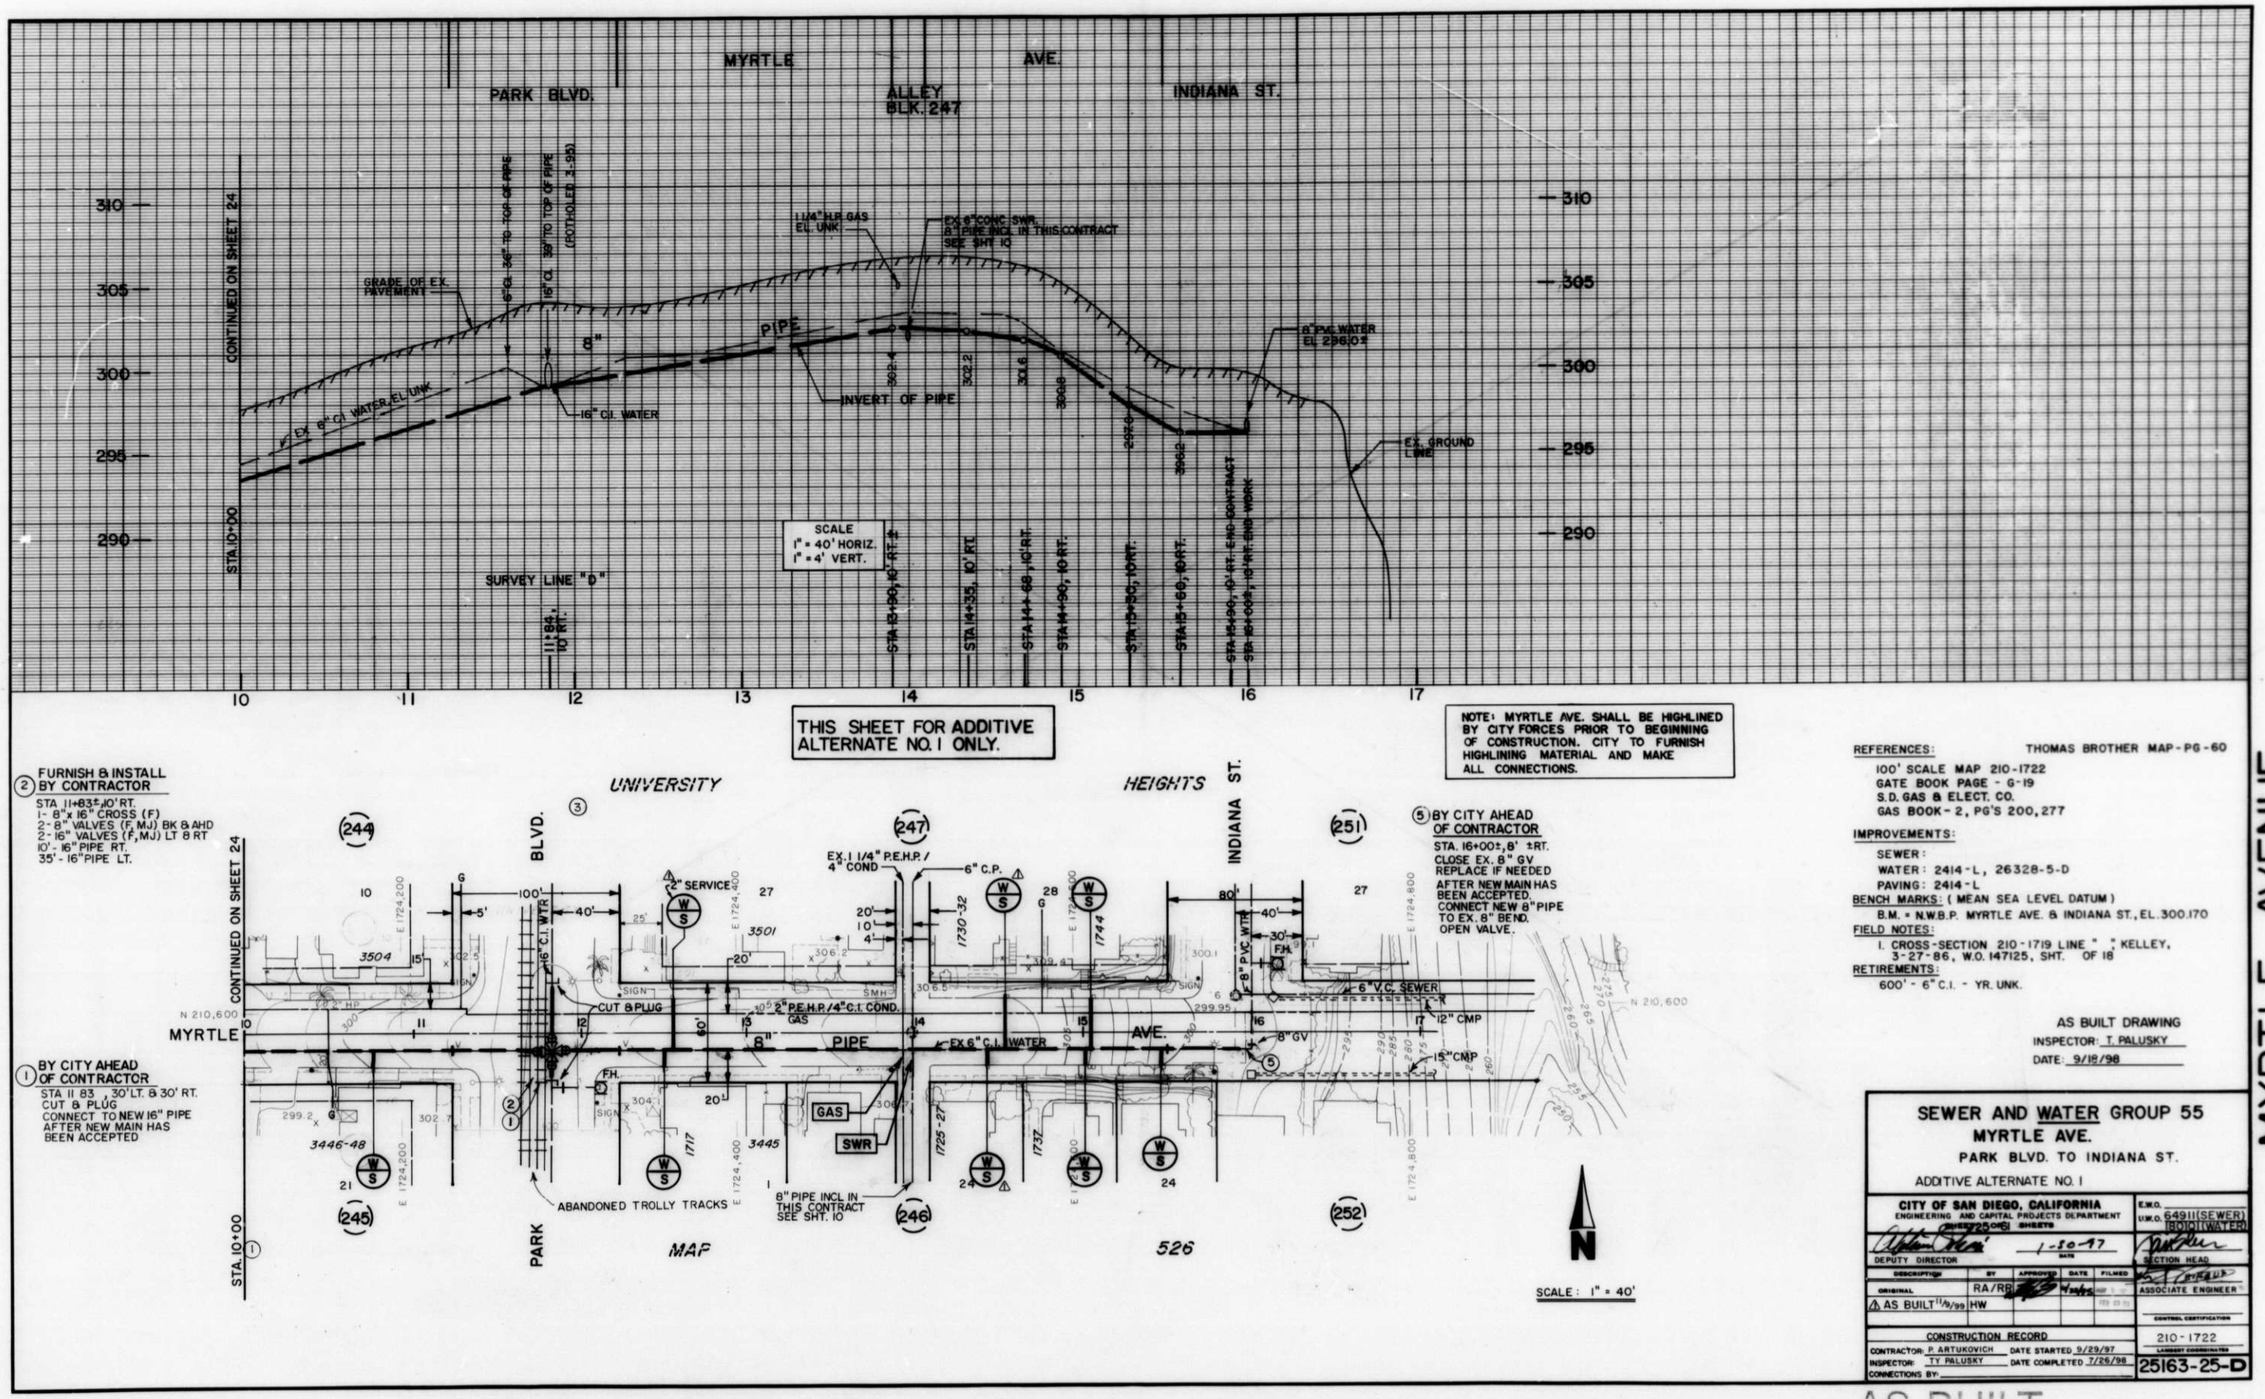

THIS SHEET FOR ADDITIVE ALTERNATE NO. 1 ONLY.

NOTE: MYRTLE AVE. SHALL BE HIGHLINED BY CITY FORCES PRIOR TO BEGINNING OF CONSTRUCTION. CITY TO FURNISH HIGHLINING MATERIAL AND MAKE ALL CONNECTIONS.

(2) FURNISH & INSTALL BY CONTRACTOR
STA. 11+83±, 10' RT.
1 - 8" x 16" CROSS (F)
2 - 8" VALVES (F, MJ) BK & AHD
2 - 16" VALVES (F, MJ) LT & RT
10' - 16" PIPE RT.
35' - 16" PIPE LT.

(1) BY CITY AHEAD OF CONTRACTOR
STA. 11+83, 30' LT. & 30' RT.
CUT & PLUG
CONNECT TO NEW 16" PIPE AFTER NEW MAIN HAS BEEN ACCEPTED

(5) BY CITY AHEAD OF CONTRACTOR
STA. 16+00±, 8' ±RT.
CLOSE EX. 8" GV
REPLACE IF NEEDED
AFTER NEW MAIN HAS BEEN ACCEPTED.
CONNECT NEW 8" PIPE TO EX. 8" BEND.
OPEN VALVE.

REFERENCES: THOMAS BROTHER MAP - PG - 60
100' SCALE MAP 210-1722
GATE BOOK PAGE - G-19
S.D. GAS & ELECT. CO.
GAS BOOK - 2, PG'S 200, 277

IMPROVEMENTS:
SEWER:
WATER: 2414-L, 26328-5-D
PAVING: 2414-L

BENCH MARKS: (MEAN SEA LEVEL DATUM)
B.M. = N.W.B.P. MYRTLE AVE. & INDIANA ST., EL. 300.170

FIELD NOTES:
1. CROSS-SECTION 210-1719 LINE " ", KELLEY, 3-27-86, W.O. 147125, SHT. OF 18

RETIREMENTS:
600' - 6" C.I. - YR. UNK.

AS BUILT DRAWING
INSPECTOR: T. PALUSKY
DATE: 9/18/98

SEWER AND WATER GROUP 55
MYRTLE AVE.
PARK BLVD. TO INDIANA ST.
ADDITIVE ALTERNATE NO. 1

CITY OF SAN DIEGO, CALIFORNIA
ENGINEERING AND CAPITAL PROJECTS DEPARTMENT
SHEET 25 OF 61 SHEETS

E.W.O. 64911 (SEWER)
U.W.O. 80101 (WATER)

DEPUTY DIRECTOR — DATE 1-30-97 — SECTION HEAD

DESCRIPTION	BY	APPROVED	DATE	FILMED
ORIGINAL	RA/RR			
AS BUILT 11/9/99	HW			

ASSOCIATE ENGINEER
CONTROL CERTIFICATION
210-1722
LAMBERT COORDINATES

CONSTRUCTION RECORD
CONTRACTOR: P. ARTUKOVICH DATE STARTED 9/29/97
INSPECTOR: TY PALUSKY DATE COMPLETED 7/26/98
CONNECTIONS BY:

25163-25-D

MYRTLE AVENUE

AS-BUILT

FILMED FROM THE ORIGINAL. BEST QUALITY OBTAINABLE. EXCESSIVE GRAY BACKGROUND MAY CAUSE A POOR QUALITY REPRODUCTION.

0 1 2 3 4 IN.