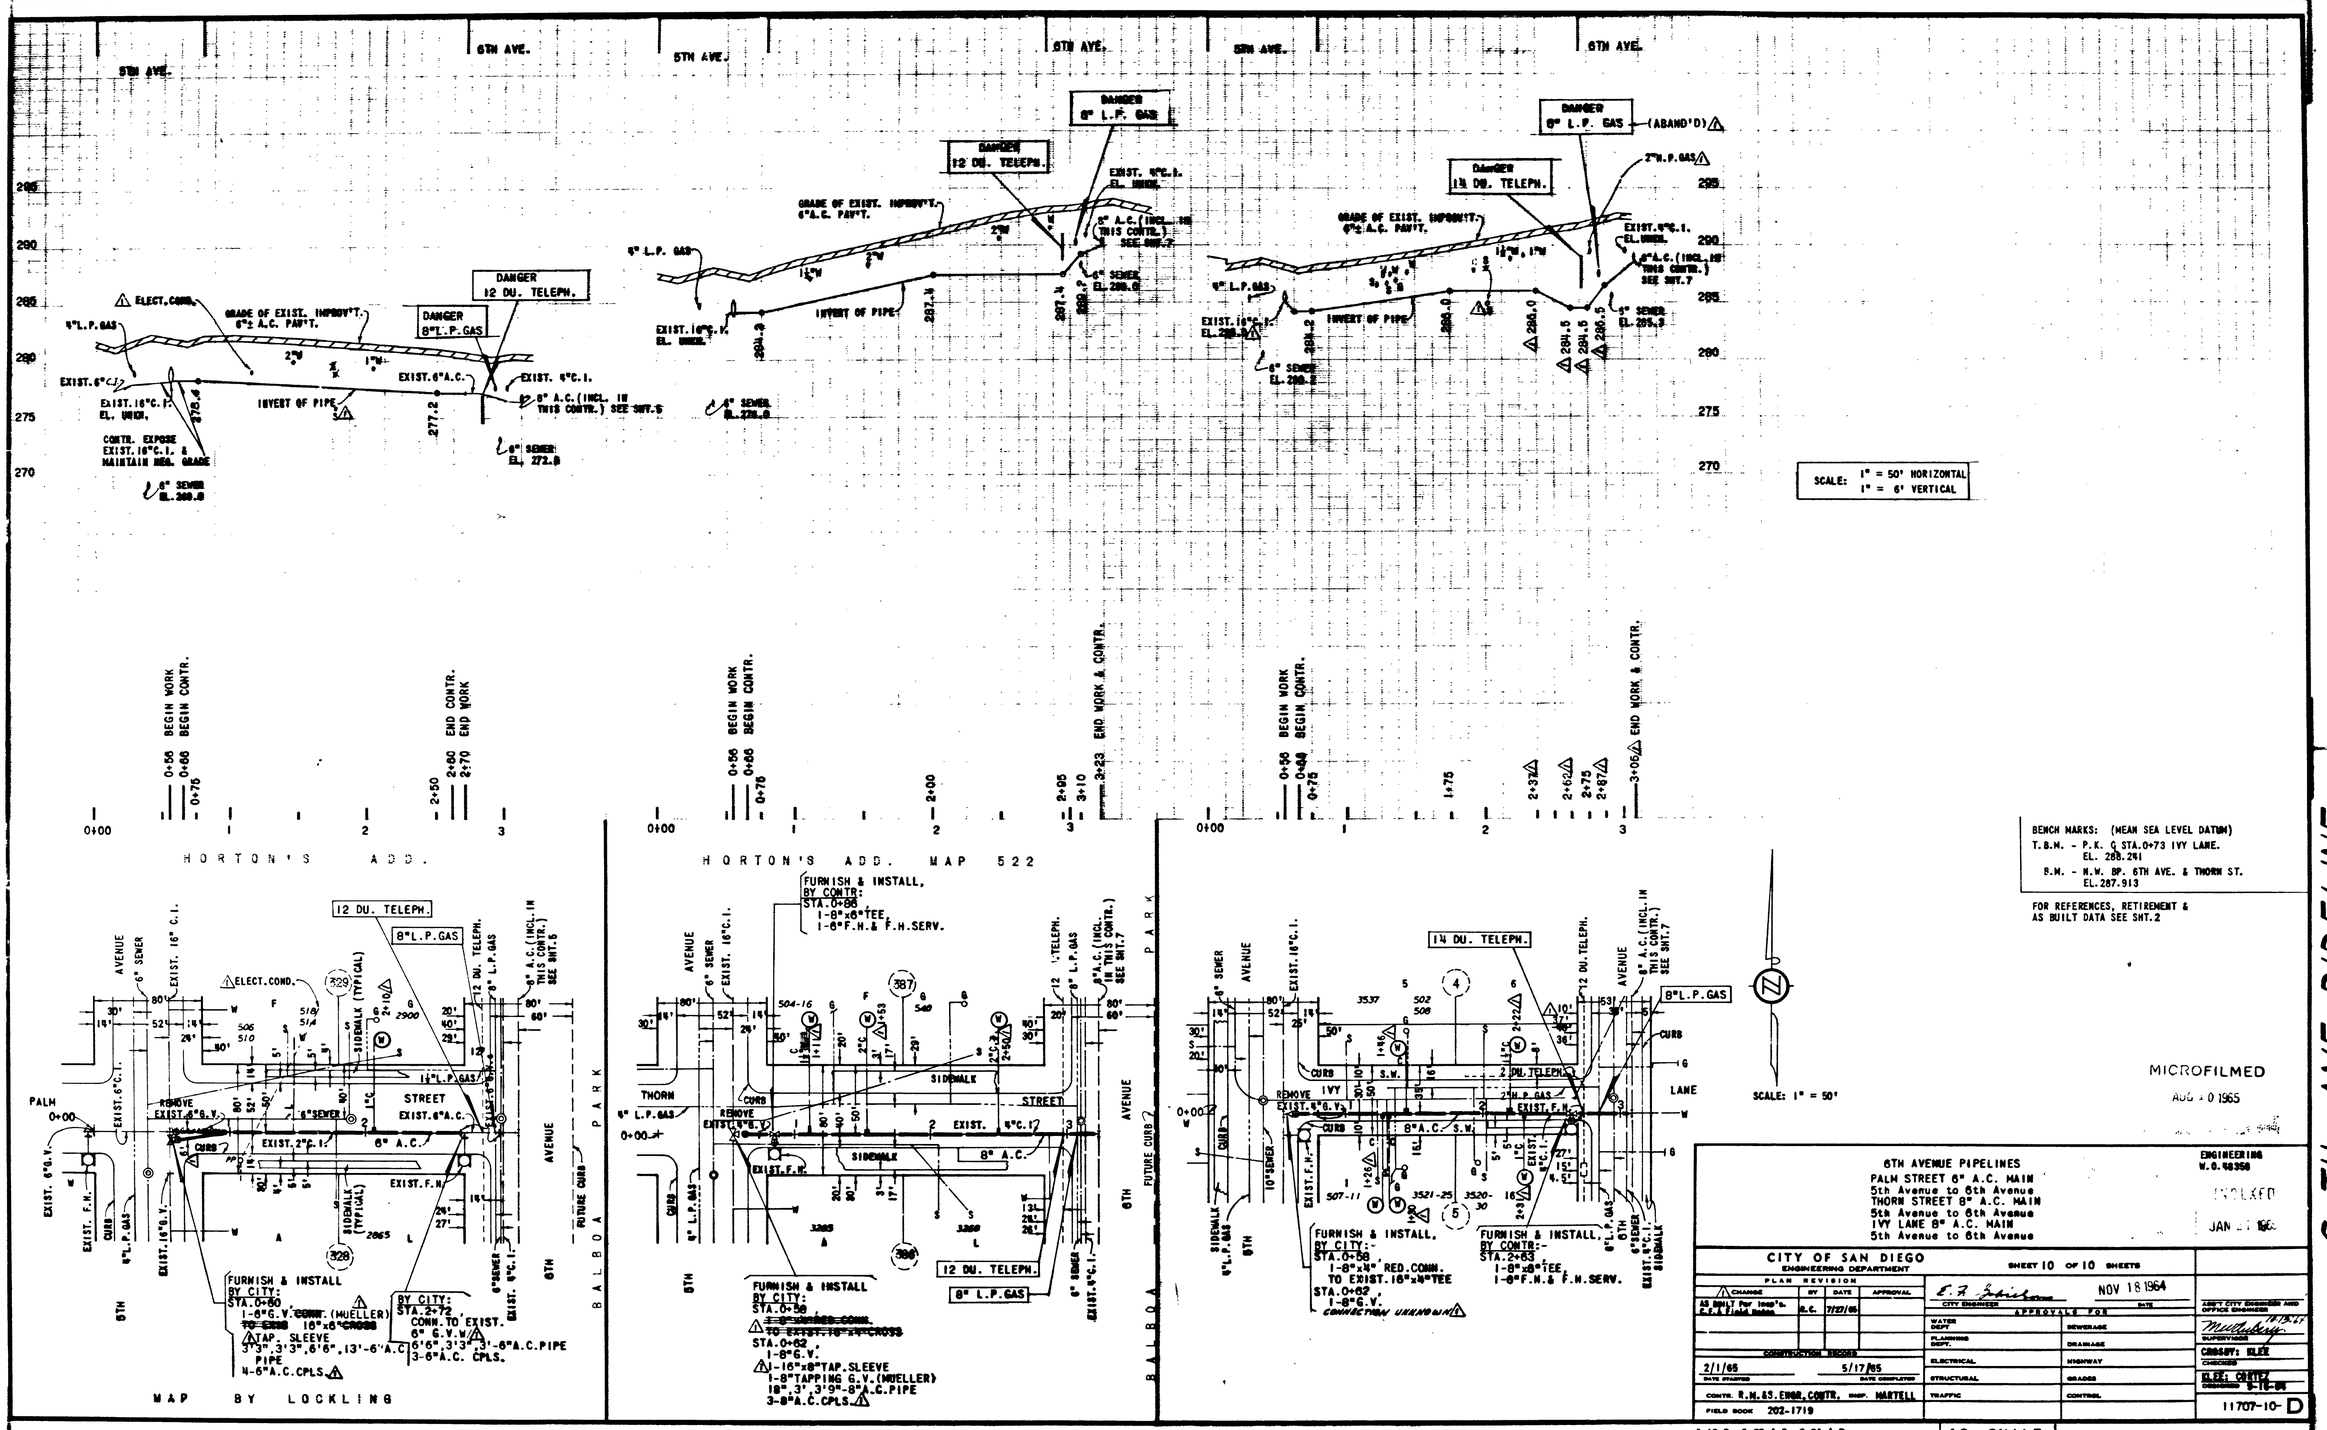
6TH AVE.
DANGER 12 DU. TELEPH.
DANGER 8" L.P. GAS
DANGER 1½ DU. TELEPH.
DANGER 8" L.P. GAS (ABAND'D)
ELECT. COND.
8" L.P. GAS
GRADE OF EXIST. IMPROV'T. 6" A.C. PAV'T.
EXIST. 6" C.I.
EXIST. 16" C.I. EL. UNKN.
CONTR. EXPOSE EXIST. 16" C.I. & MAINTAIN MIN. GRADE
INVERT OF PIPE
EXIST. 6" A.C.
EXIST. 6" C.I.
8" A.C. (INCL. IN THIS CONTR.) SEE SHT. 5
8" SEWER EL. 272.8
8" SEWER EL. 269.8
8" A.C. (INCL. IN THIS CONTR.) SEE SHT. 7
8" SEWER EL. 286.6
8" SEWER EL. 283.3
2" N.P. GAS
SCALE: 1" = 50' HORIZONTAL
1" = 6' VERTICAL
0+56 BEGIN WORK
0+66 BEGIN CONTR.
0+75
2+60 END CONTR.
2+70 END WORK
3+23 END WORK & CONTR.
3+06 END WORK & CONTR.
HORTON'S ADD.
HORTON'S ADD. MAP 522
12 DU. TELEPH.
8" L.P. GAS
14 DU. TELEPH.
ELECT. COND.
REMOVE EXIST. 6" G.V.
PALM STREET
THORN STREET
IVY LANE
EXIST. 6" A.C.
EXIST. 2" C.I.
EXIST. F.H.
SIDEWALK (TYPICAL)
FUTURE CURB
BALBOA PARK
6TH AVENUE
FURNISH & INSTALL BY CITY: STA. 0+60 1-6" G.V. CONN. (MUELLER) TO EXIST. 16" x 6" CROSS
TAP. SLEEVE 3'3", 3'3", 6'6", 13'-6" A.C. PIPE
N-6" A.C. CPLS.
BY CITY: STA. 2+72 CONN. TO EXIST. 6" G.V.
6'6", 3'3", 3'-6" A.C. PIPE
3-6" A.C. CPLS.
FURNISH & INSTALL, BY CONTR: STA. 0+56 1-8" x 6" TEE, 1-6" F.H. & F.H. SERV.
FURNISH & INSTALL BY CITY: STA. 0+58 1-8" x 8" RED. CONN. TO EXIST. 16" x 8" TEE
STA. 0+62 1-8" G.V.
1-16" x 8" TAP. SLEEVE
1-8" TAPPING G.V. (MUELLER)
18", 3', 3', 9'-8" A.C. PIPE
3-8" A.C. CPLS.
FURNISH & INSTALL, BY CONTR:- STA. 2+63 1-8" x 6" TEE, 1-6" F.H. & F.H. SERV.
CONNECTION UNKNOWN
MAP BY LOCKLING
SCALE: 1" = 50'
BENCH MARKS: (MEAN SEA LEVEL DATUM)
T.B.M. - P.K. ℄ STA. 0+73 IVY LANE. EL. 288.241
B.M. - N.W. BP. 6TH AVE. & THORN ST. EL. 287.913
FOR REFERENCES, RETIREMENT & AS BUILT DATA SEE SHT. 2
MICROFILMED
AUG 10 1965
6TH AVENUE PIPELINES
PALM STREET 6" A.C. MAIN
5th Avenue to 6th Avenue
THORN STREET 8" A.C. MAIN
5th Avenue to 6th Avenue
IVY LANE 8" A.C. MAIN
5th Avenue to 6th Avenue
ENGINEERING W.O. 48350
INDEXED
JAN 21 1965
CITY OF SAN DIEGO
ENGINEERING DEPARTMENT
SHEET 10 OF 10 SHEETS
PLAN REVISION
AS BUILT Per Insp'ts. F.F. Field Books
R.C. 7/27/65
NOV 18 1964
CITY ENGINEER
APPROVALS FOR
WATER DEPT.
SEWERAGE
PLANNING DEPT.
DRAINAGE
ELECTRICAL
HIGHWAY
STRUCTURAL
GRADES
TRAFFIC
CONTROL
CONSTRUCTION RECORD
2/1/65 DATE STARTED
5/17/65 DATE COMPLETED
CONTR. R.N. & S. ENGR. CONTR. INSP. HARTELL
FIELD BOOK 202-1719
CHECKED
FILED: CRITTER
11707-10-D
6-19-B, 6-20-A,B, 6-21-A,B
AS BUILT
6TH AVE. PIPELINE

AS BUILT