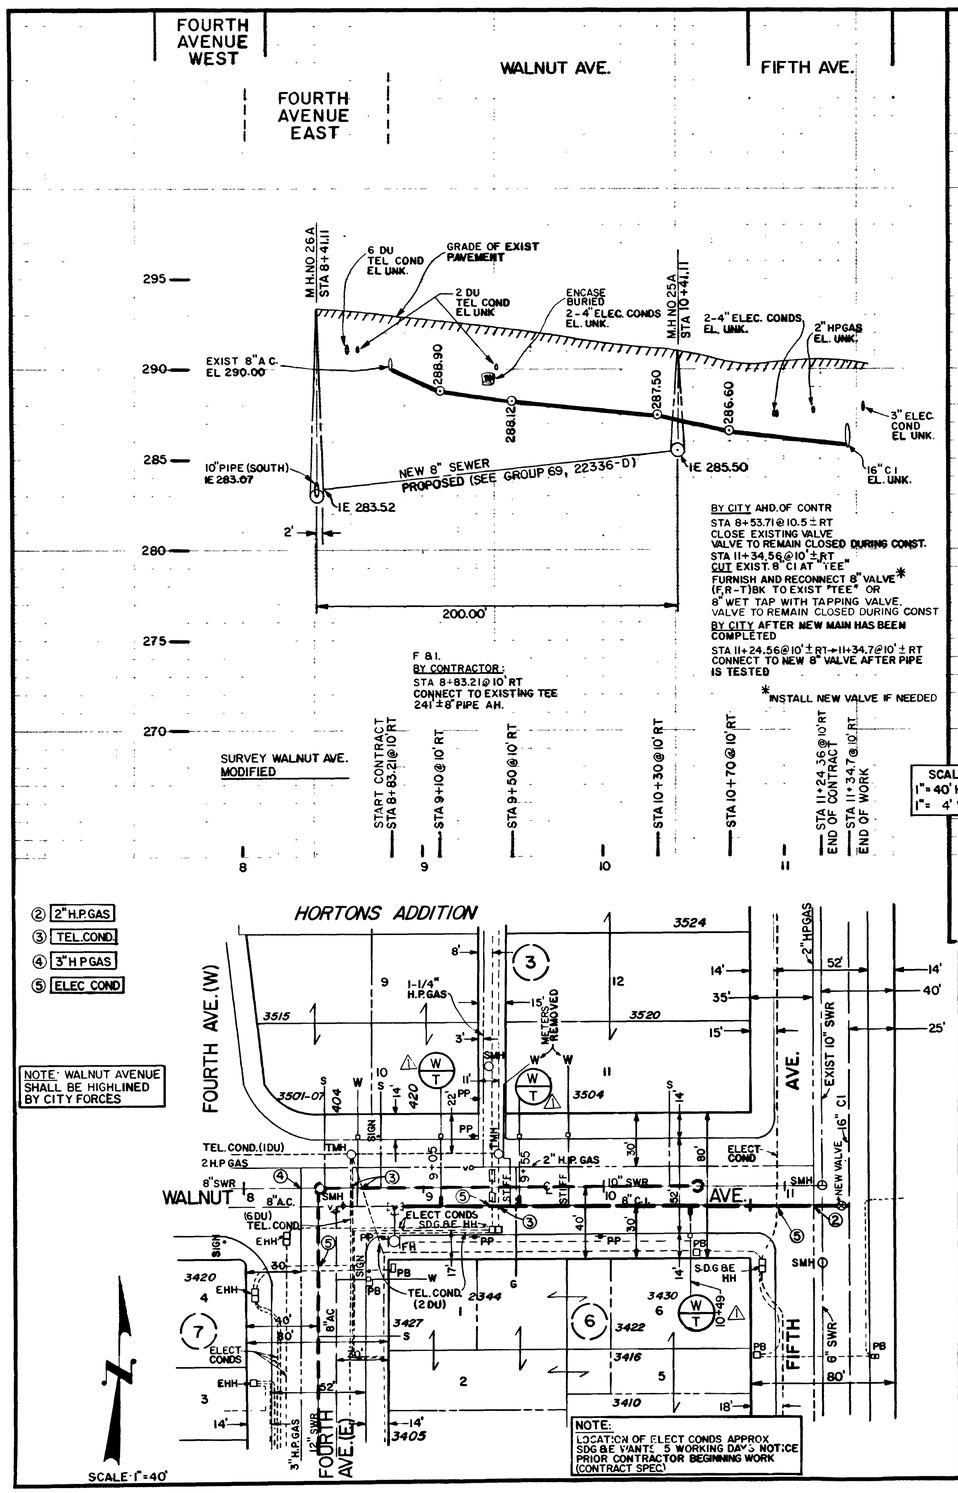

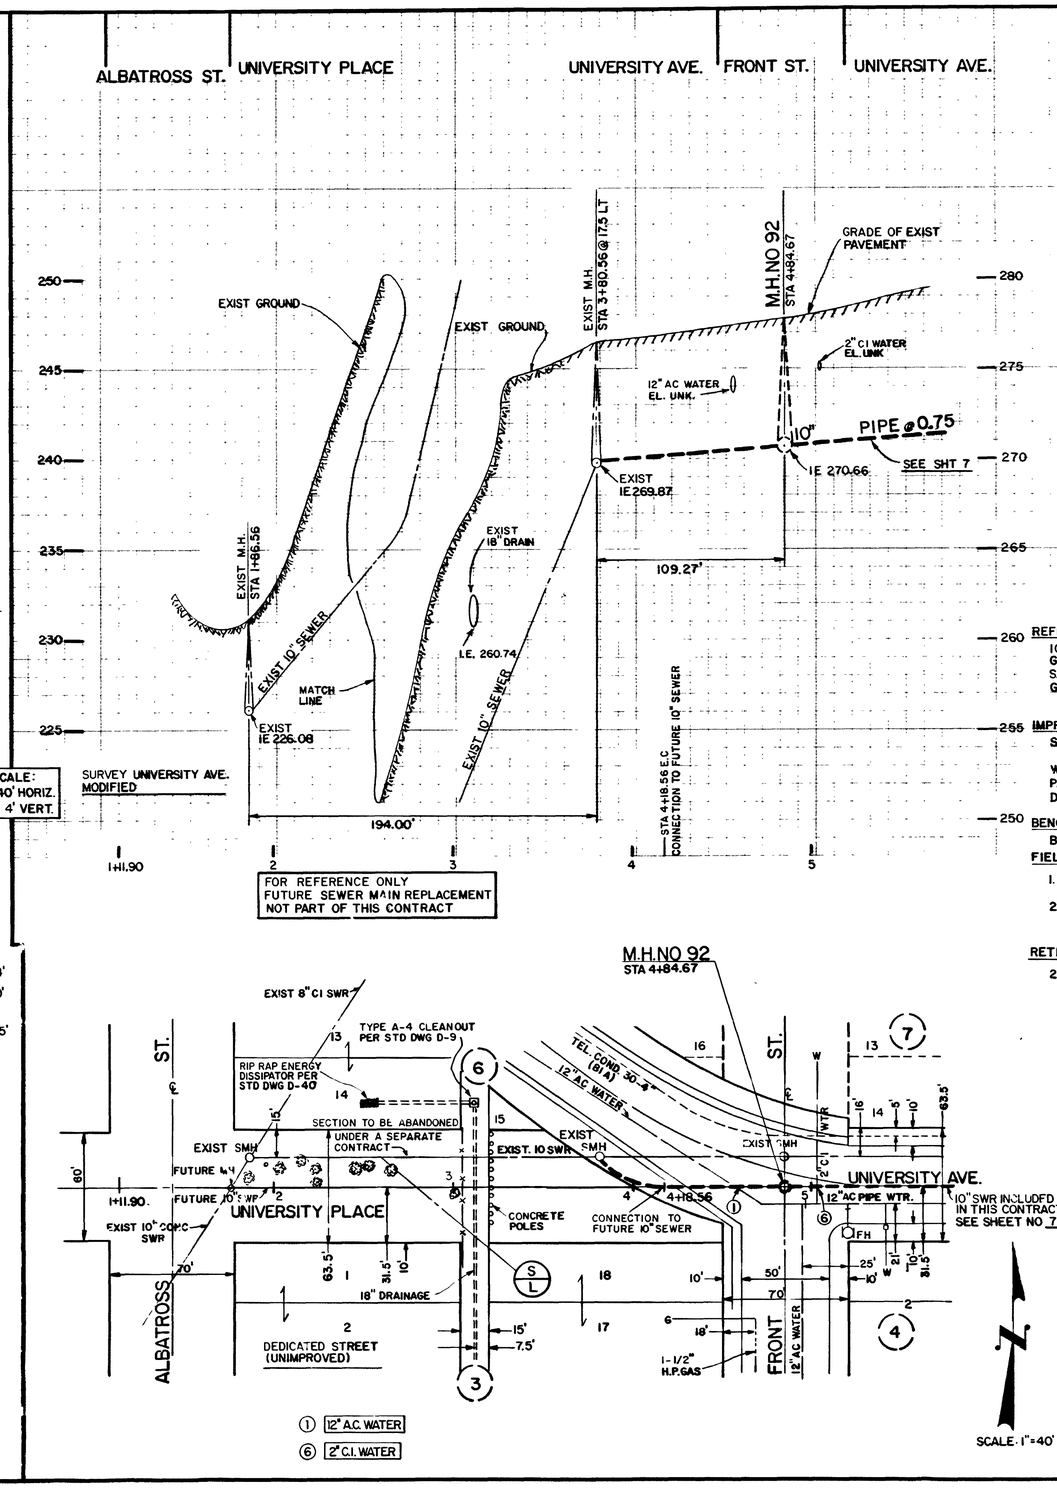

REFERENCES:
100' SCALE MAPS 210-1719, 212-1716 — THOMAS BROTHER MAP-PG-60
GATE BOOK PAGES G19, F19
S.D.GAS & ELECT. CO.
GAS BOOK-2 PGS 147, 254
22 PGS 291, 292, 293
PACIFIC BELL TEL.
DWGS-4192, C03, C03A, C04, C05, 3018, 3020

IMPROVEMENTS:
SEWER: 982-3-L, 982-4-L, 1338-L, 12395-2-D, 22706-11-D, 323-1-D, -2-D, -3-D, 52-1-L, 508-12-L, 13881-2-L, 2211-B
WATER: 20548-9-D, 11725-8-D, 7907-D
PAVING: 10211-4-D, 9873-1, 9901-L, 425-B, 10797-B, 11391-B
DRAINAGE: 23803-1-D

BENCH MARKS: (MEAN SEA LEVEL DATUM)
B.M.-N.W.B.P., 3RD & UNIVERSITY AVE. EL. 290.639

FIELD NOTES:
1. CROSS SECTION, 212-1716 FRONT ST. TO ALBATROSS ST., KELLEY W.O. 170151, SHT 1 THRU 4 OF 4, 12-23-87 (REVISED).
2. CROSS SECTION, 208-1719, WALNUT AVE. BETWEEN 4TH & 5TH AVE. KELLEY W.O. 170151, SHT 1 THRU 5 OF 5, 08-18-87

RETIREMENT:
240' C.I. WTR. YR. UNK.

UNIVERSITY PLACE/WALNUT AVE.

SEWER AND WATER GROUP 68
UNIVERSITY PLACE 10" PIPE
ALBATROSS ST. TO 240' EAST OF ALBATROSS ST.
WALNUT AVE. 8" PIPE
FOURTH AVE. (E) TO FIFTH AVE.

CITY OF SAN DIEGO, CALIFORNIA
UTILITIES DEPARTMENT
SHEET 8 OF 18 SHEETS

WATER W.O. 180541
SEWER W.O. 170151

UTILITIES DIRECTOR — DATE 2-6-89
ENG. SUPERINTENDENT — 2/6/89

DESCRIPTION	BY	APPROVED	DATE	FILMED
ORIGINAL	MH/LS			
AS-BUILT PER CITY INSPECTOR	HKN			

DESIGN ENGINEER
CONTROL CERTIFICATION
212-1716, 210-1719
LAMBERT COORDINATES
22708-8-D

CONNECTIONS BY CITY FORCES
CONTRACTOR DUARTE & BAUM INC. DATE STARTED 8/11/89
INSPECTOR SAFWAT ABUZAID DATE COMPLETED 7/26/90

AS-BUILT