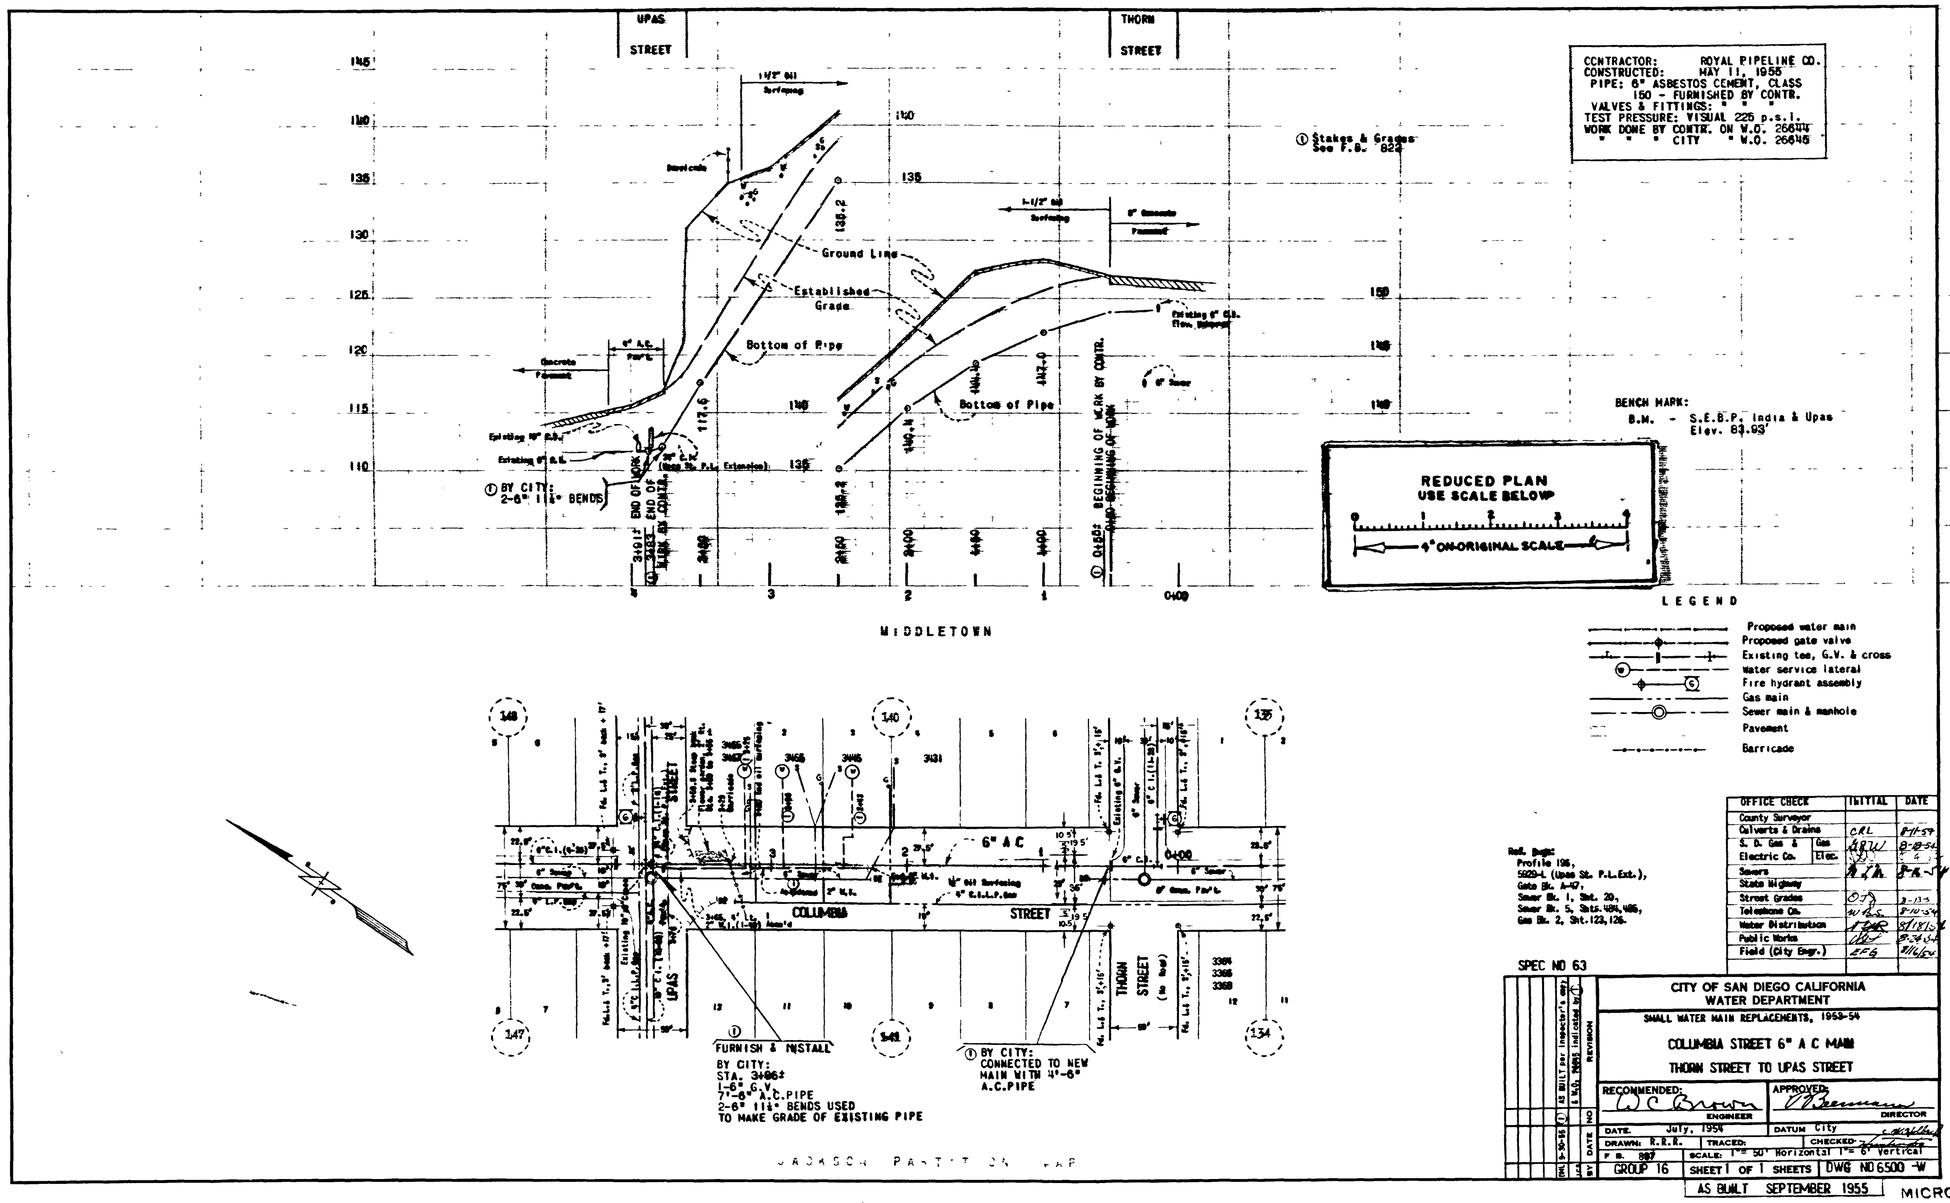

Ref. Dwgs:
Profile 196,
5929-L (Upas St. P.L.Ext.),
Gate Bk. A-47,
Sewer Bk. 1, Sht. 20,
Sewer Bk. 5, Shts. 484,486,
Gas Bk. 2, Sht. 123,126.

OFFICE CHECK		INITIAL	DATE
County Surveyor			
Culverts & Drains		CRL	8-11-54
S. D. Gas & Electric Co.	Gas	GRW	8-18-54
	Elec.		
Sewers			8-18-54
State Highway			
Street Grades		OJ	8-13-54
Telephone Co.		WBS	8-10-54
Water Distribution			8/18/54
Public Works			8-24-54
Field (City Engr.)		EFG	8/16/54

SPEC NO 63

CITY OF SAN DIEGO CALIFORNIA
WATER DEPARTMENT

SMALL WATER MAIN REPLACEMENTS, 1953-54

COLUMBIA STREET 6" A C MAIN
THORN STREET TO UPAS STREET

RECOMMENDED: W C Brown, ENGINEER
APPROVED: [signature], DIRECTOR

DATE: July, 1954 | DATUM: City
DRAWN: R.R.R. | TRACED: | CHECKED:
F.B. 887 | SCALE: 1" = 50' Horizontal 1" = 6' Vertical
GROUP 16 | SHEET 1 OF 1 SHEETS | DWG NO 6500 -W

AS BUILT SEPTEMBER 1955

MICROFILMED
DEC 26 1955