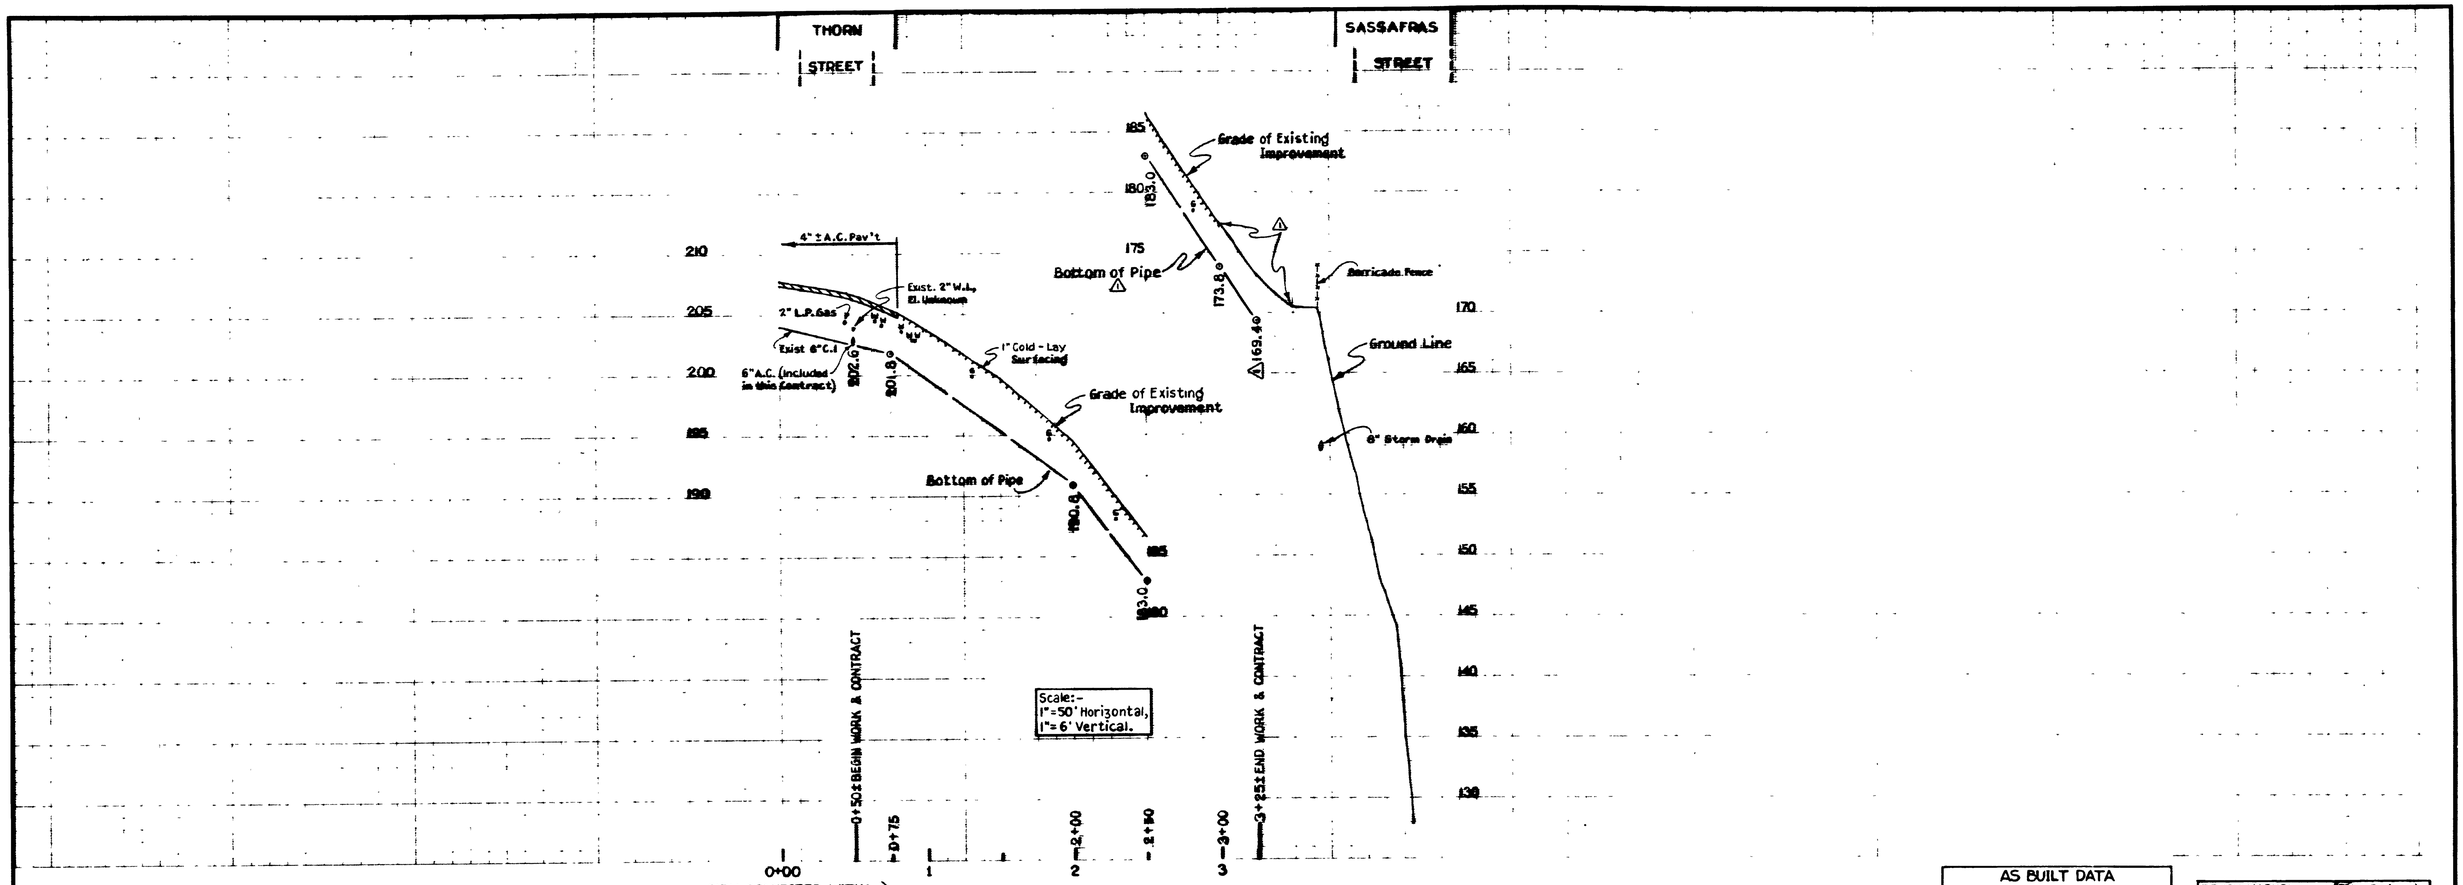

NOTE:- Contractor not to replace existing Surfacing between Sta. 0+00± & 3+00±.

AS BUILT DATA

CONSTRUCTED:- HAYNES CONST. CO., WO 28774 (CONST.), W.O. 48172 (ENGR.),
PIPE:- 6" A.C., "J.M.",
GATE VALVES:- MUELLER,
SOIL:- GRANULAR.
STAKED:- 6-28-60, F.N. E-19,20,
TESTED:- UNAVAILABLE,
BACKFILL:- EXISTING, AS ABOVE.
CONNECTIONS:- BY CITY FORCE, W.O. 28775,
PIPE:- 6" A.C.,
GATE VALVES:- NONE.

BENCH MARKS:- (City Datum)
BM - S.E., B.P., State St. & Thorn St., El. 187.27';
BM - S.E., B.P., India St. & Spruce St., El. 86.00'.

References -
Water Rack 10, Shts F-20-A & B; & Sewer Bk. 1, Sht. 31;
Gate Bk. A-47;
Gas Bk 2, Shts. 127-29;
#5518-W, (Water);
#3844-B, #3901-B, (Openings).

Retirement:-
43' 2" W.I. 1939;
1 2" G.V. " .

GROUP 31
UNION STREET 6" A.C. MAIN
THORN STREET TO SASSAFRAS STREET

ENGINEERING W.O. 48172

CITY OF SAN DIEGO
ENGINEERING DEPARTMENT

SHEET 9 OF 12 SHEETS

8800-W

PLAN REVISION

CHANGE	BY	DATE	APPROVAL
AS BUILT:- For Inspector Field & City Force Notes	ROCKY	10-5-60	

CONSTRUCTION RECORD

JUNE, 1960 — DATE STARTED
JULY, 1960 — DATE COMPLETED
CONTR. SEE ABOVE — INSP. DIAS. TRAVER
FIELD BOOK F-19, 20

E F Johnson — CITY ENGINEER — 4/7/60 — DATE

APPROVALS FOR
WATER DEPT — SEWERAGE
PLANNING DEPT — DRAINAGE
ELECTRICAL — HIGHWAY
STRUCTURAL — GRADES
TRAFFIC — CONTROL

ASS'T CITY ENGINEER AND OFFICE ENGINEER
SUPERVISOR
MARSHALL CROSBY: KLEE
CHECKED
KLEE: ROCKY
DESIGNED 11-13-59

8924-D

AS BUILT

MICROFILMED
JUL 1 1963

UNION STREET