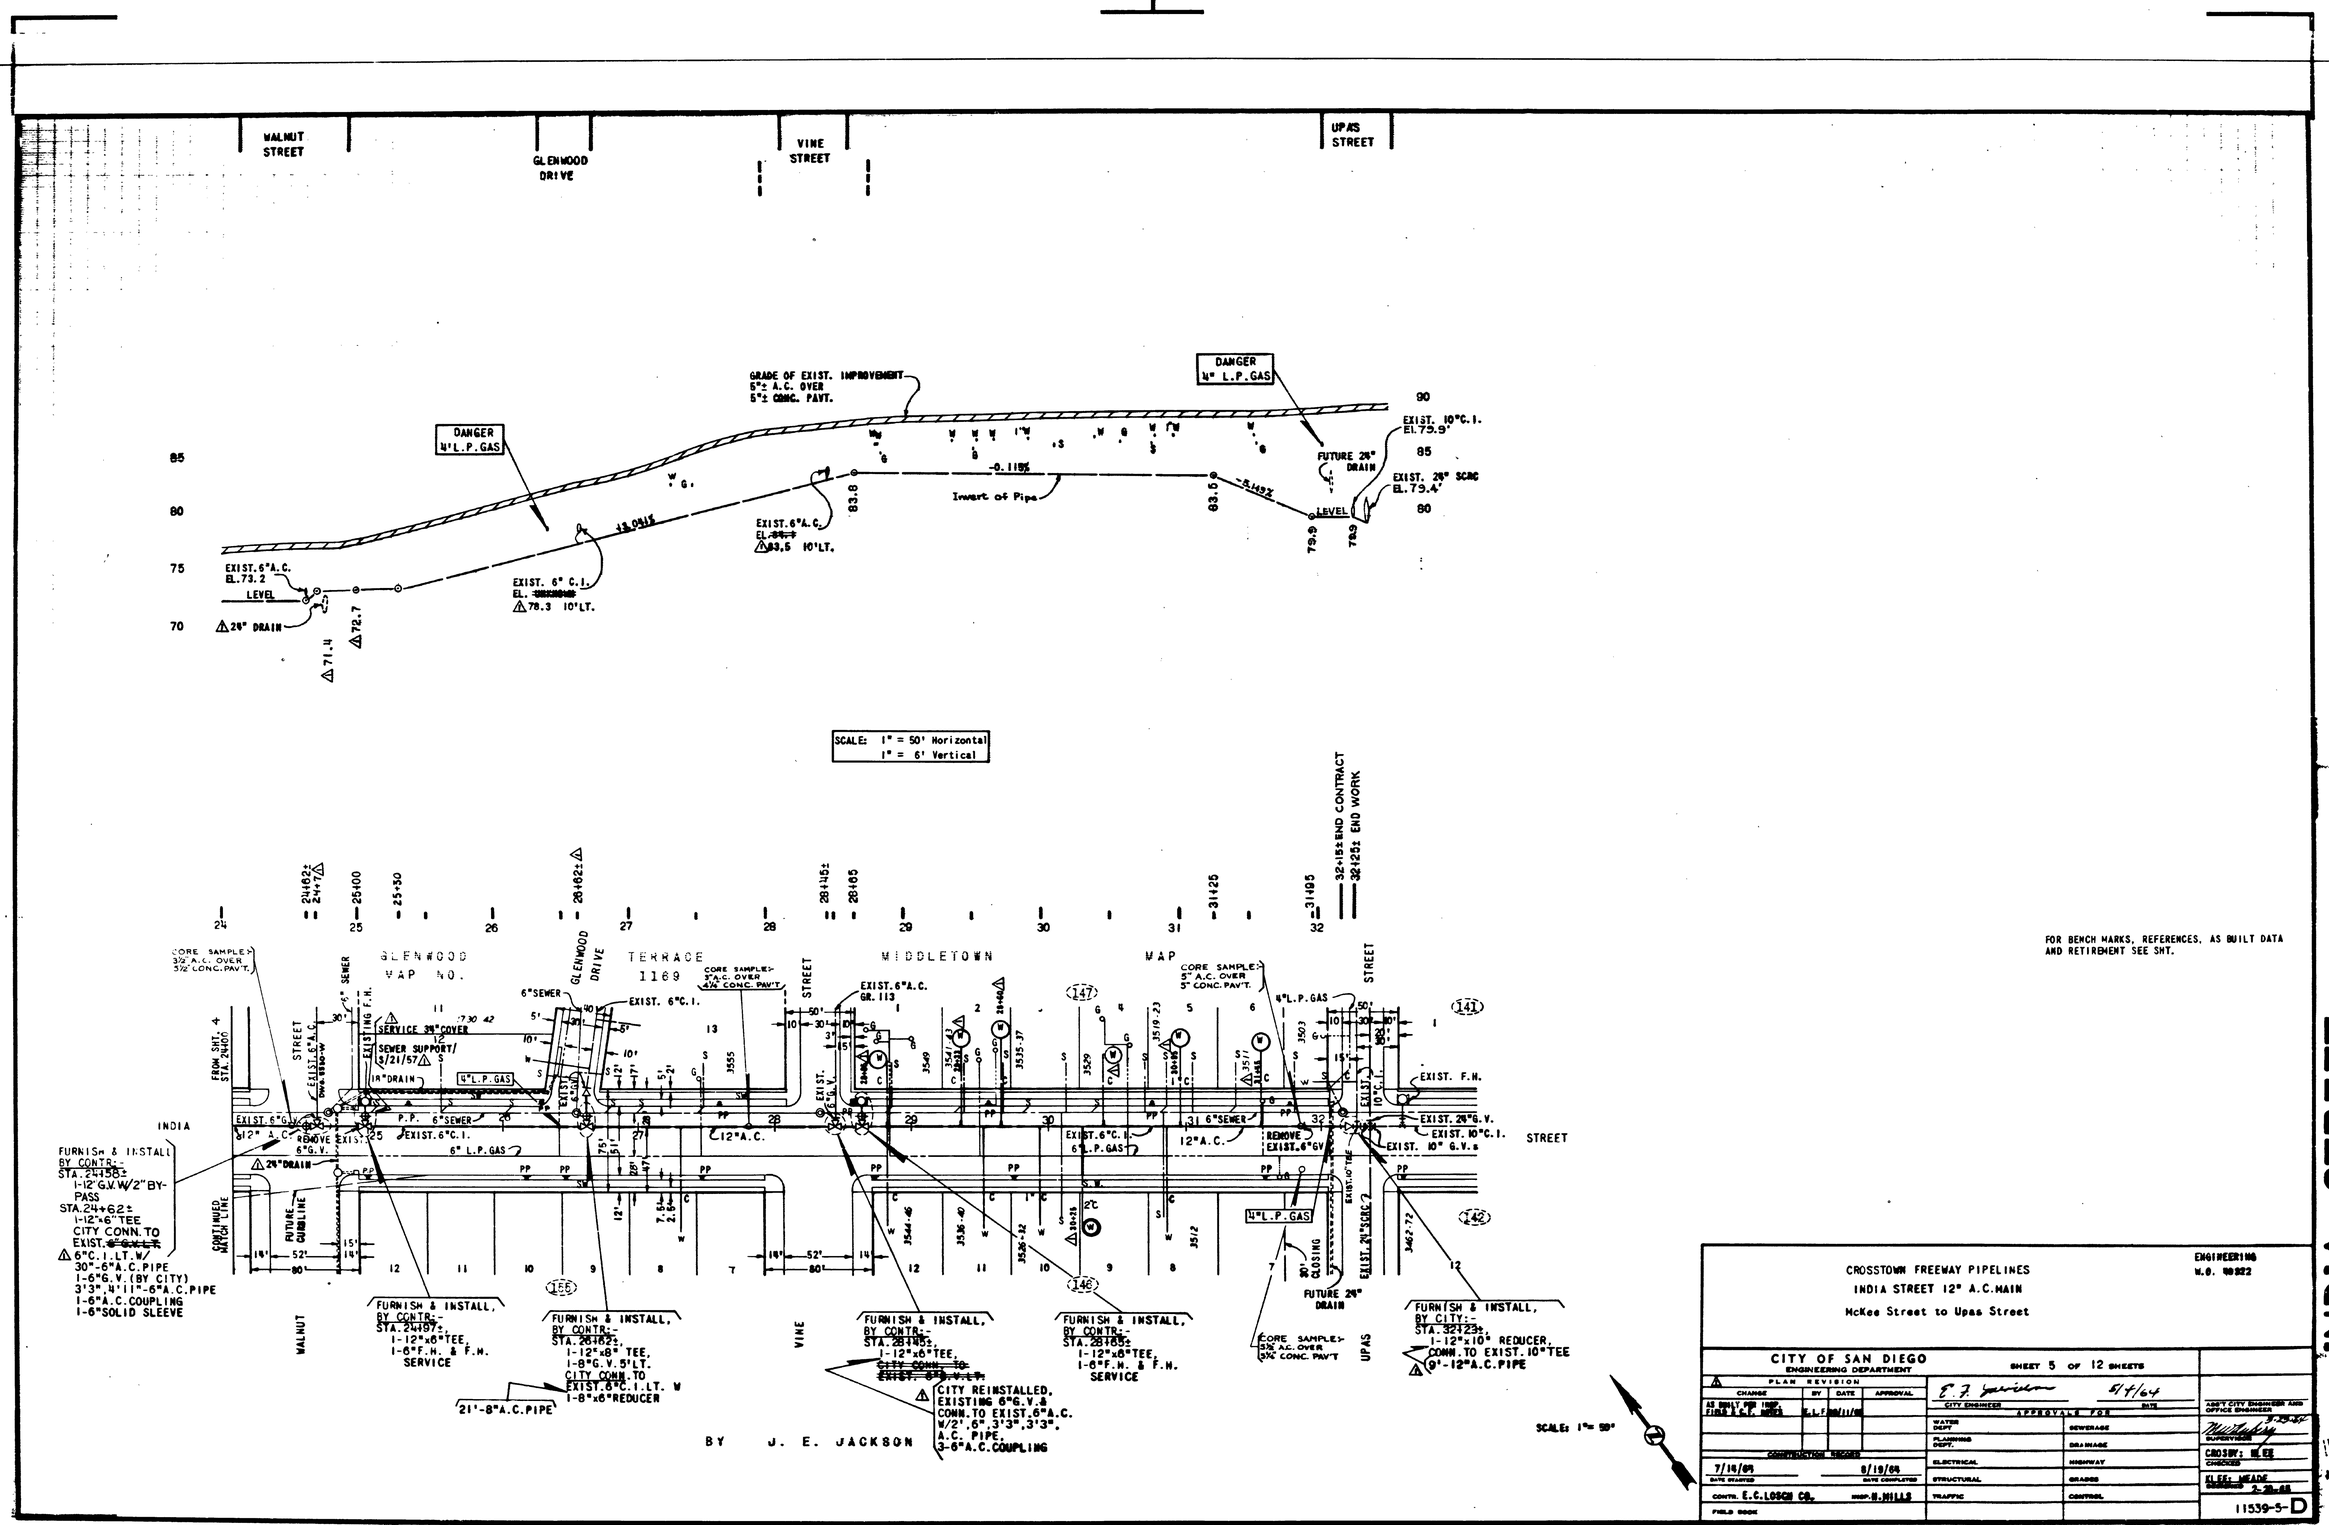

FOR BENCH MARKS, REFERENCES, AS BUILT DATA AND RETIREMENT SEE SHT.

CROSSTOWN FREEWAY PIPELINES
INDIA STREET 12" A.C.MAIN
McKee Street to Upas Street

ENGINEERING W.O. 40322

CITY OF SAN DIEGO
ENGINEERING DEPARTMENT

SHEET 5 OF 12 SHEETS

PLAN REVISION

CHANGE	BY	DATE	APPROVAL
AS BUILT PER INSP. FIELD & C.F. NOTES	E.L.F.	8/11/64	

CONSTRUCTION RECORD

7/14/64 DATE STARTED — 8/19/64 DATE COMPLETED

CONTR. E.C.LOSCH CO. INSP. H.HILLS

FIELD BOOK

E. F. Jackson 5/4/64
CITY ENGINEER DATE

APPROVALS FOR

WATER DEPT	SEWERAGE
PLANNING DEPT.	DRAINAGE
ELECTRICAL	HIGHWAY
STRUCTURAL	GRADES
TRAFFIC	CONTROL

ASS'T CITY ENGINEER AND OFFICE ENGINEER

SUPERVISOR 9-29-64

CROSBY: KLEE
CHECKED

KLEE: MEADE
DESIGNED 2-28-65

11539-5-D

INDIA STREET

INDEXED MAY 1 1964

F-20-A

AS BUILT