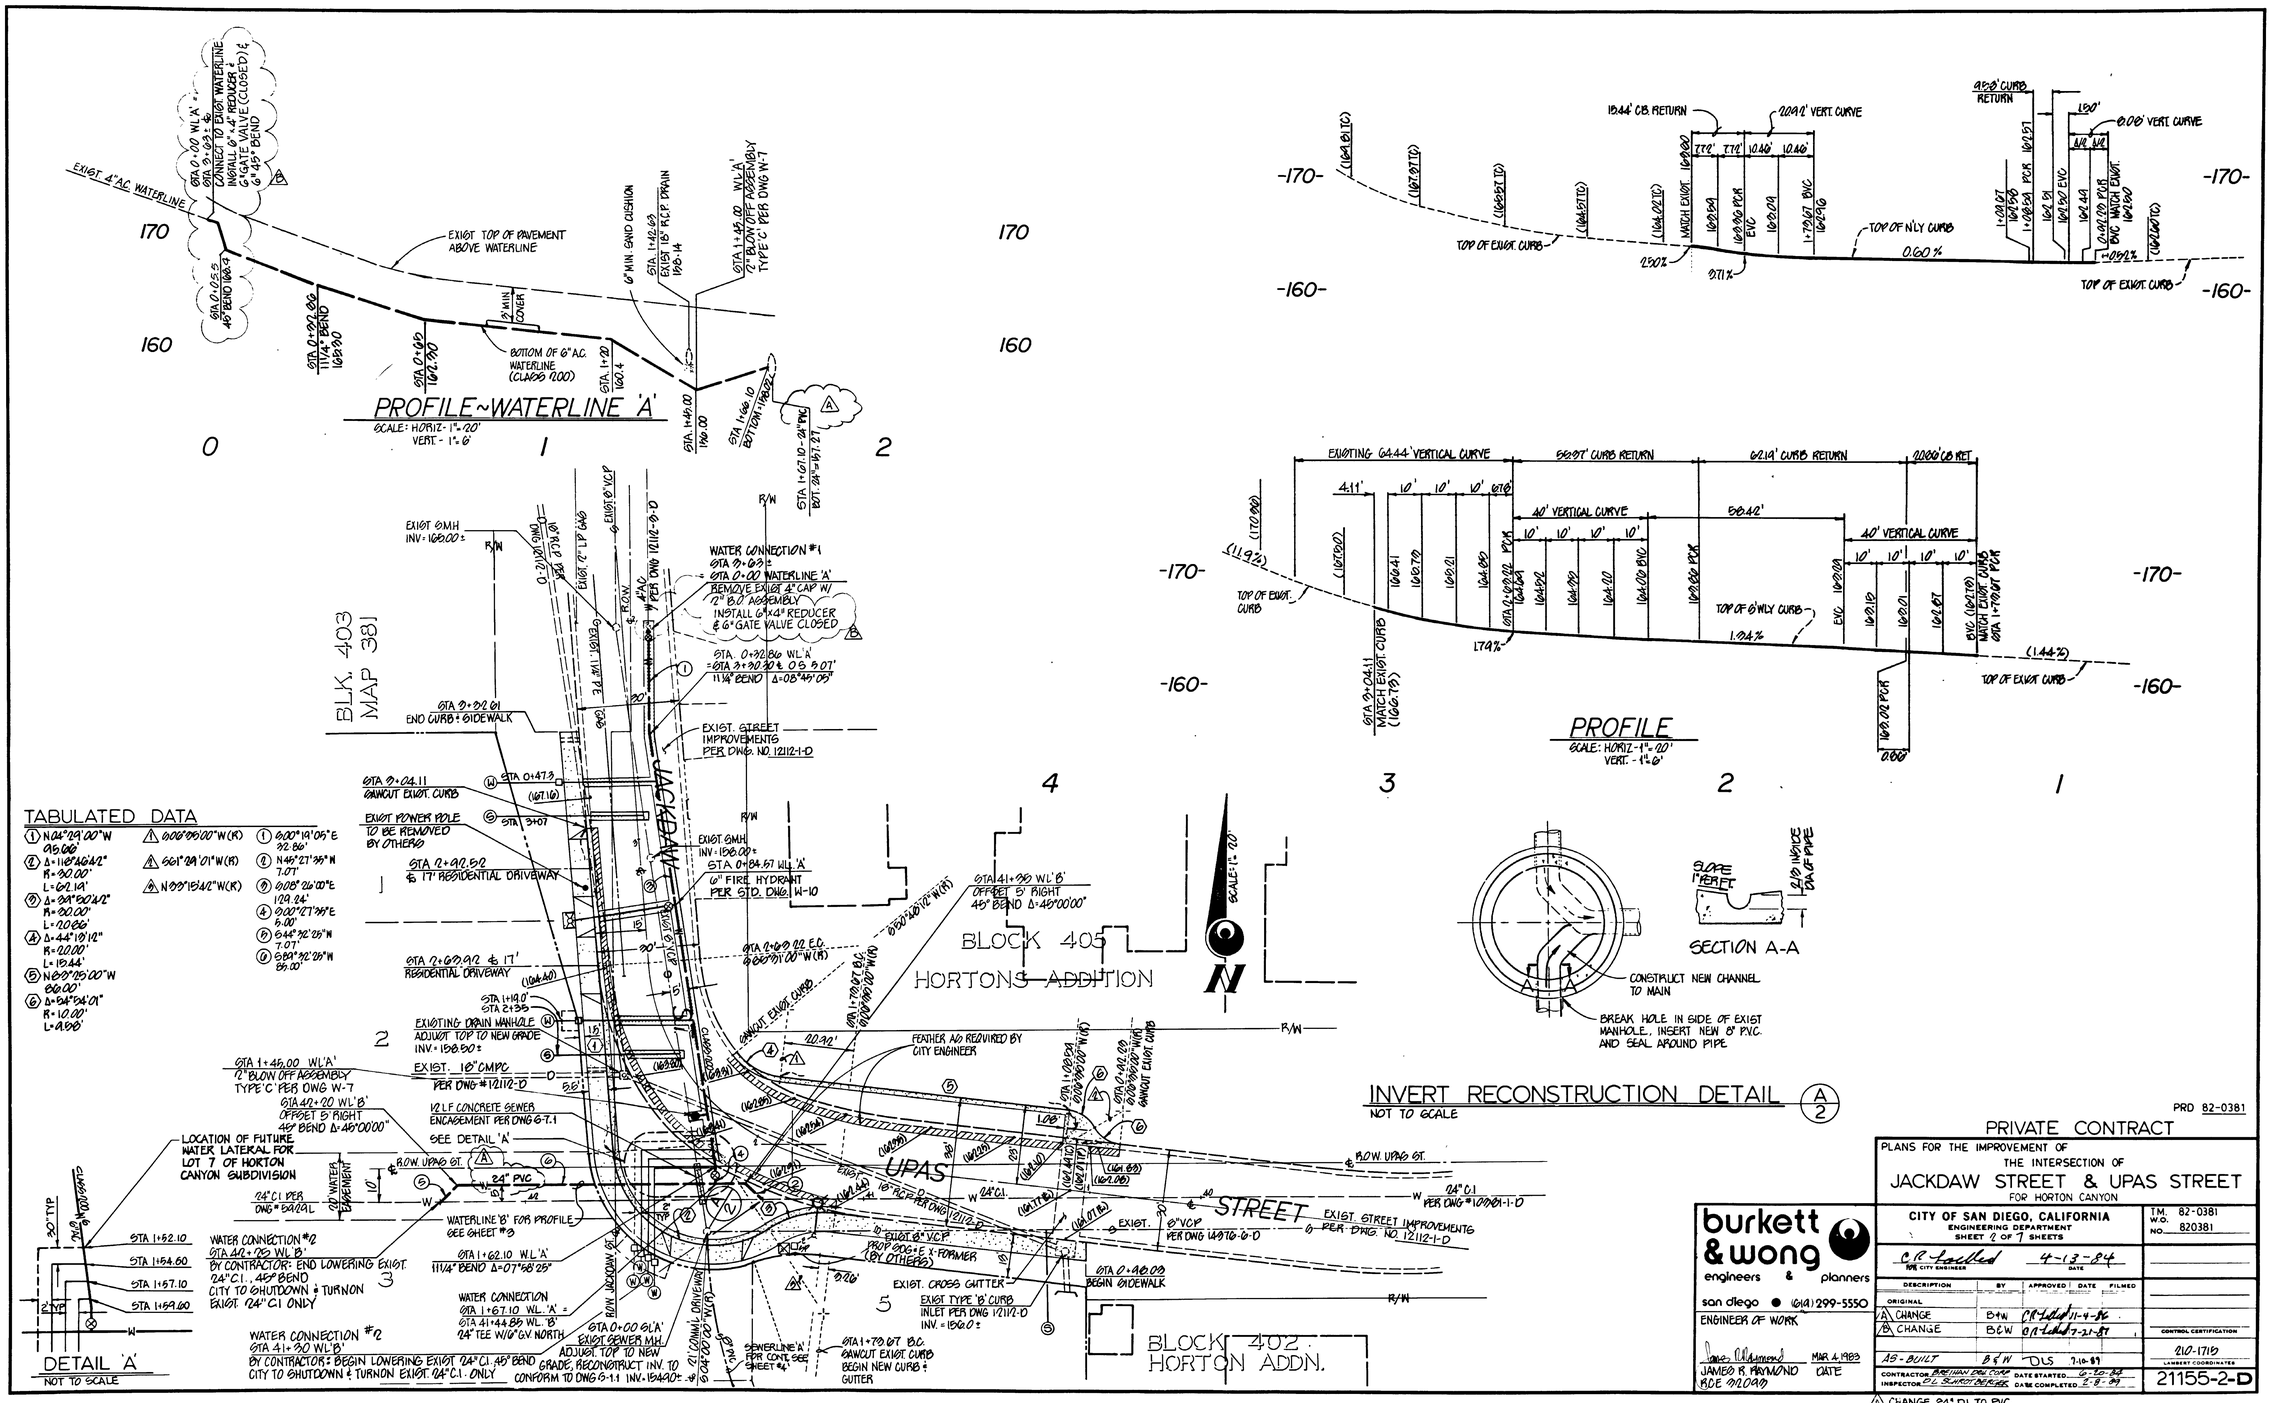

PRD 82-0381

PRIVATE CONTRACT

PLANS FOR THE IMPROVEMENT OF THE INTERSECTION OF

JACKDAW STREET & UPAS STREET

FOR HORTON CANYON

burkett & wong engineers & planners

san diego ● (619) 299-5550

ENGINEER OF WORK

James R. Raymond MAR 4 1983

JAMES R. RAYMOND DATE

RCE 32093

CITY OF SAN DIEGO, CALIFORNIA

ENGINEERING DEPARTMENT

SHEET 2 OF 7 SHEETS

T.M. 82-0381

W.O. NO. 820381

C.R. Lollied 4-13-84

CITY ENGINEER DATE

DESCRIPTION	BY	APPROVED	DATE	FILMED
ORIGINAL				
A CHANGE	B&W	C.R. Lollied	11-4-86	
B CHANGE	B&W	C.R. Lollied	7-21-87	
AS-BUILT	B&W	DLS	7-10-89	

CONTROL CERTIFICATION

210-1715

LAMBERT COORDINATES

CONTRACTOR BRETHAN DRILLCORP DATE STARTED 6-20-84

INSPECTOR D.L. SCHROTBERGER DATE COMPLETED 2-8-89

21155-2-D

A CHANGE 24" DI TO PVC

B ADD GATE VALVE

AS-BUILT

180+W