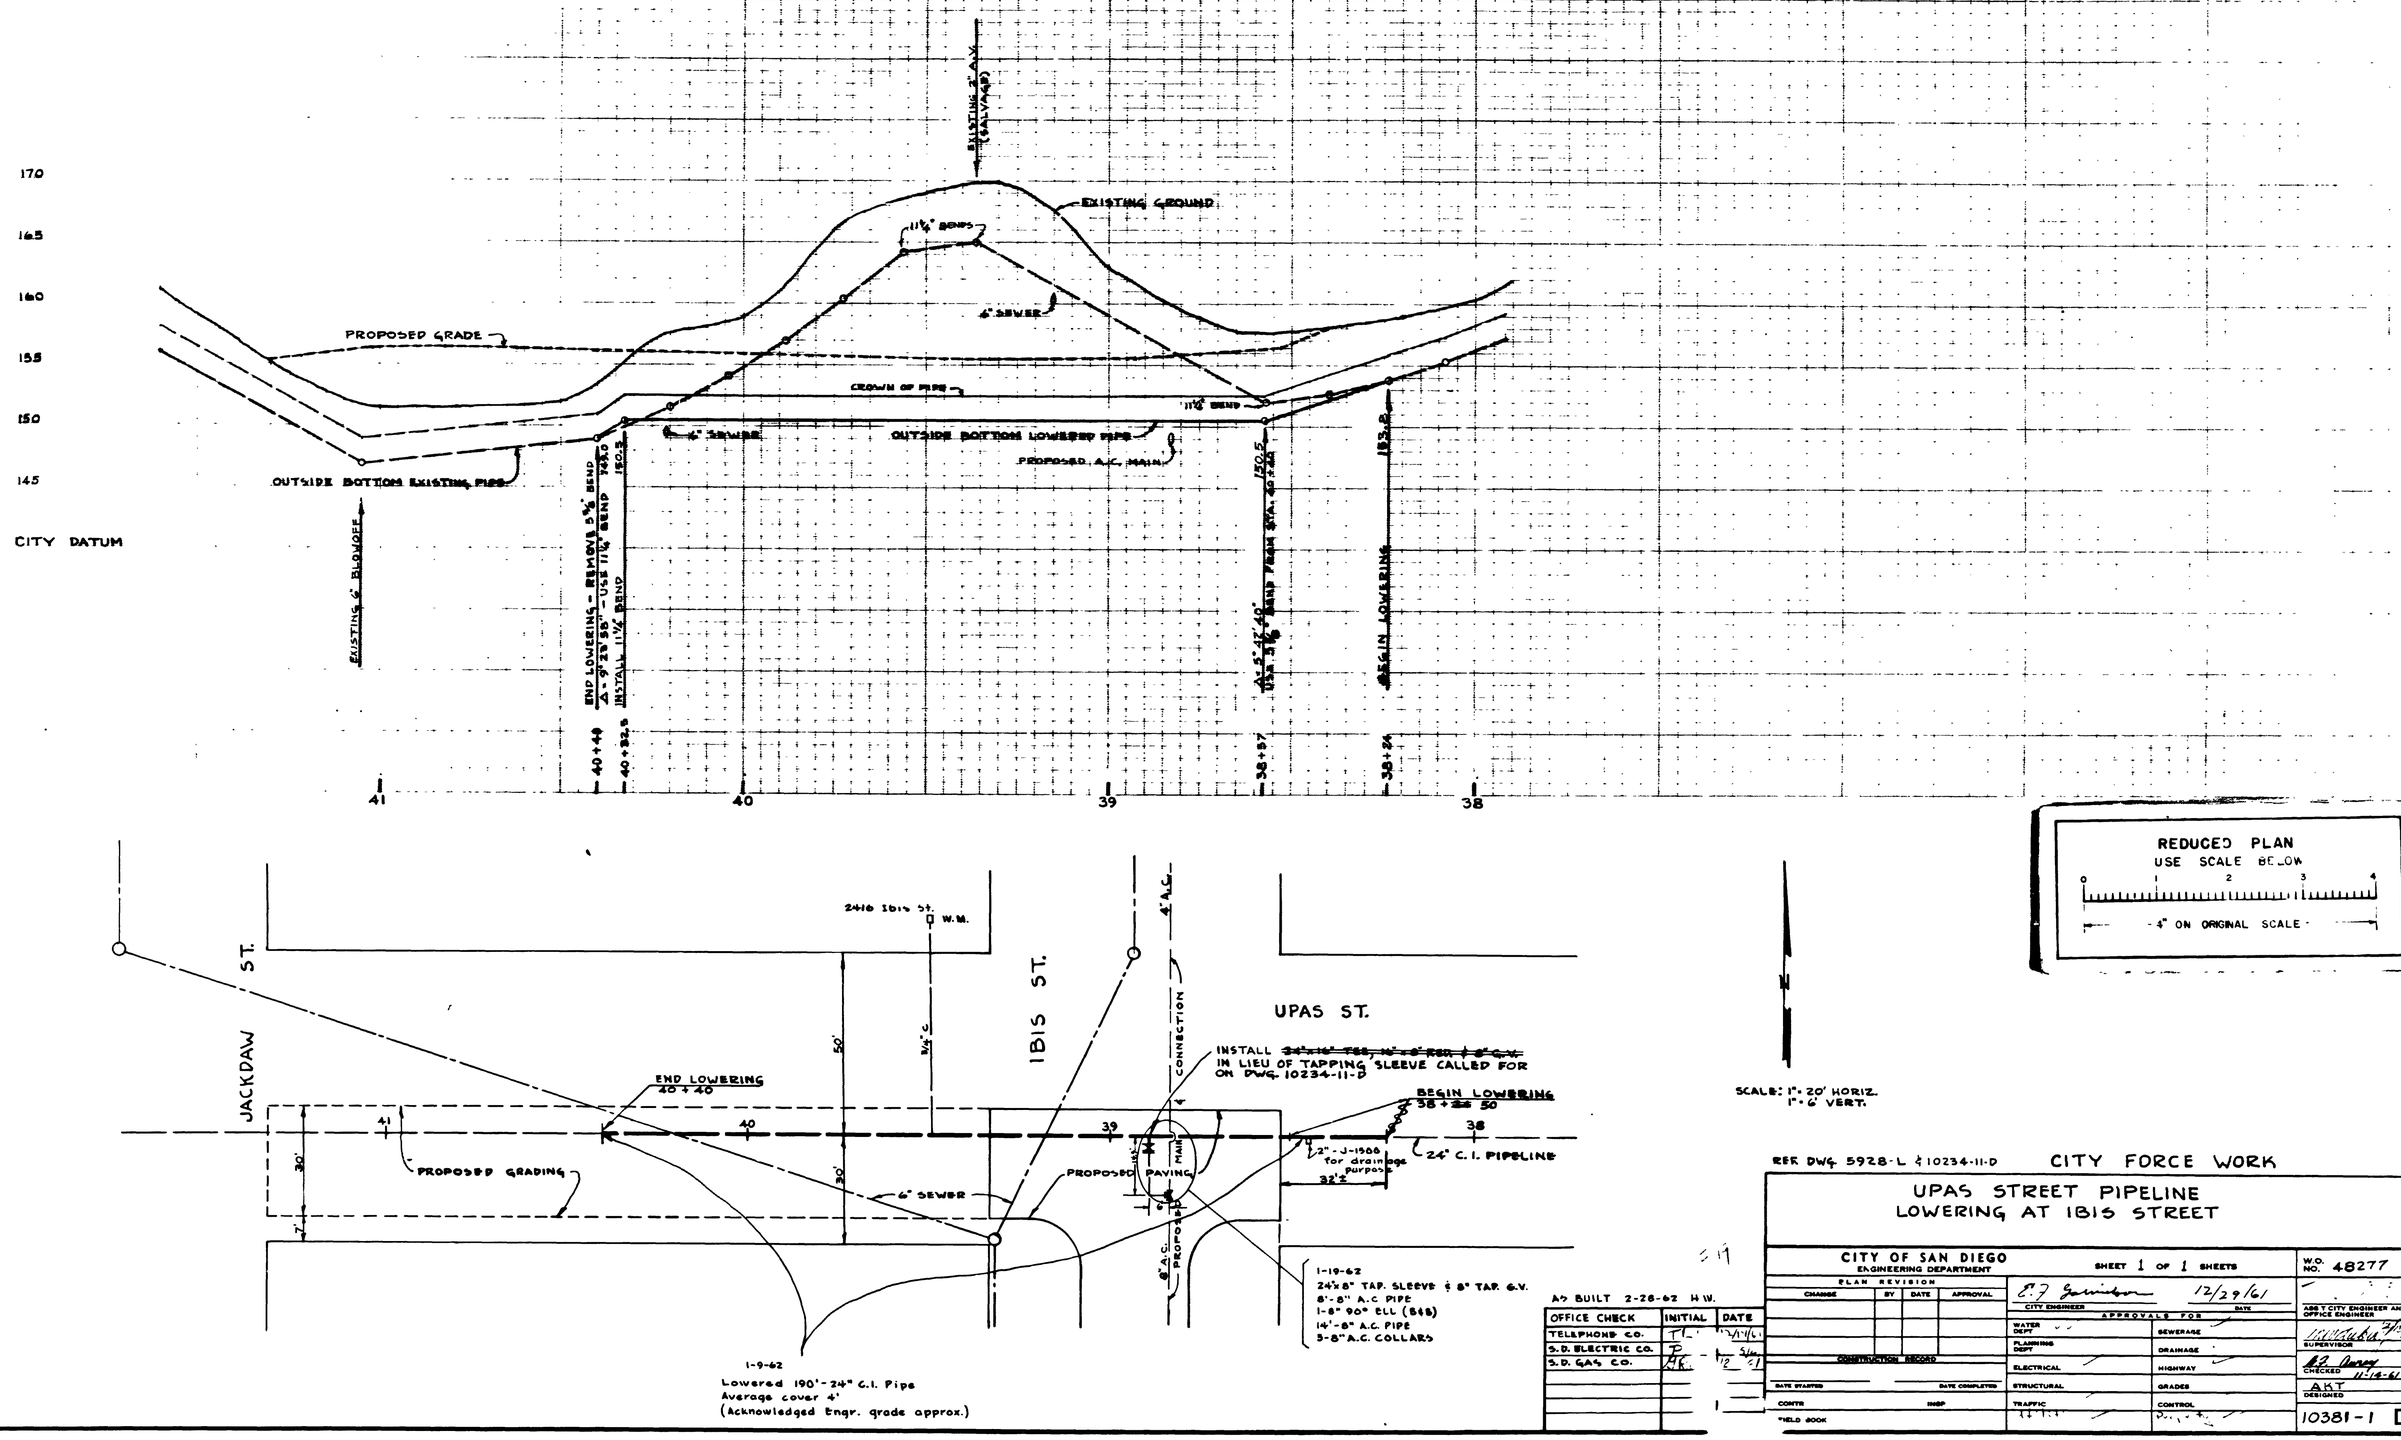

REF. DWG. 5928-L & 10234-11-D

CITY FORCE WORK

UPAS STREET PIPELINE LOWERING AT IBIS STREET

AS BUILT 2-28-62 H.W.

OFFICE CHECK	INITIAL	DATE
TELEPHONE CO.	[illegible]	12/1/61
S.D. ELECTRIC CO.	[illegible]	5/61
S.D. GAS CO.	[illegible]	12/61

CITY OF SAN DIEGO
ENGINEERING DEPARTMENT

SHEET 1 OF 1 SHEETS

W.O. NO. 48277

PLAN REVISION

CHANGE	BY	DATE	APPROVAL

CONSTRUCTION RECORD

DATE STARTED — DATE COMPLETED

CONTR — INSP

FIELD BOOK

E. J. Garrison — 12/29/61
CITY ENGINEER — DATE

APPROVALS FOR

WATER DEPT	SEWERAGE
PLANNING DEPT	DRAINAGE
ELECTRICAL	HIGHWAY
STRUCTURAL	GRADES
TRAFFIC	CONTROL

ASS'T CITY ENGINEER AND OFFICE ENGINEER

SUPERVISOR

CHECKED 11-14-61

AKT
DESIGNED

10381-1 D

MICROFILMED

INDEXED