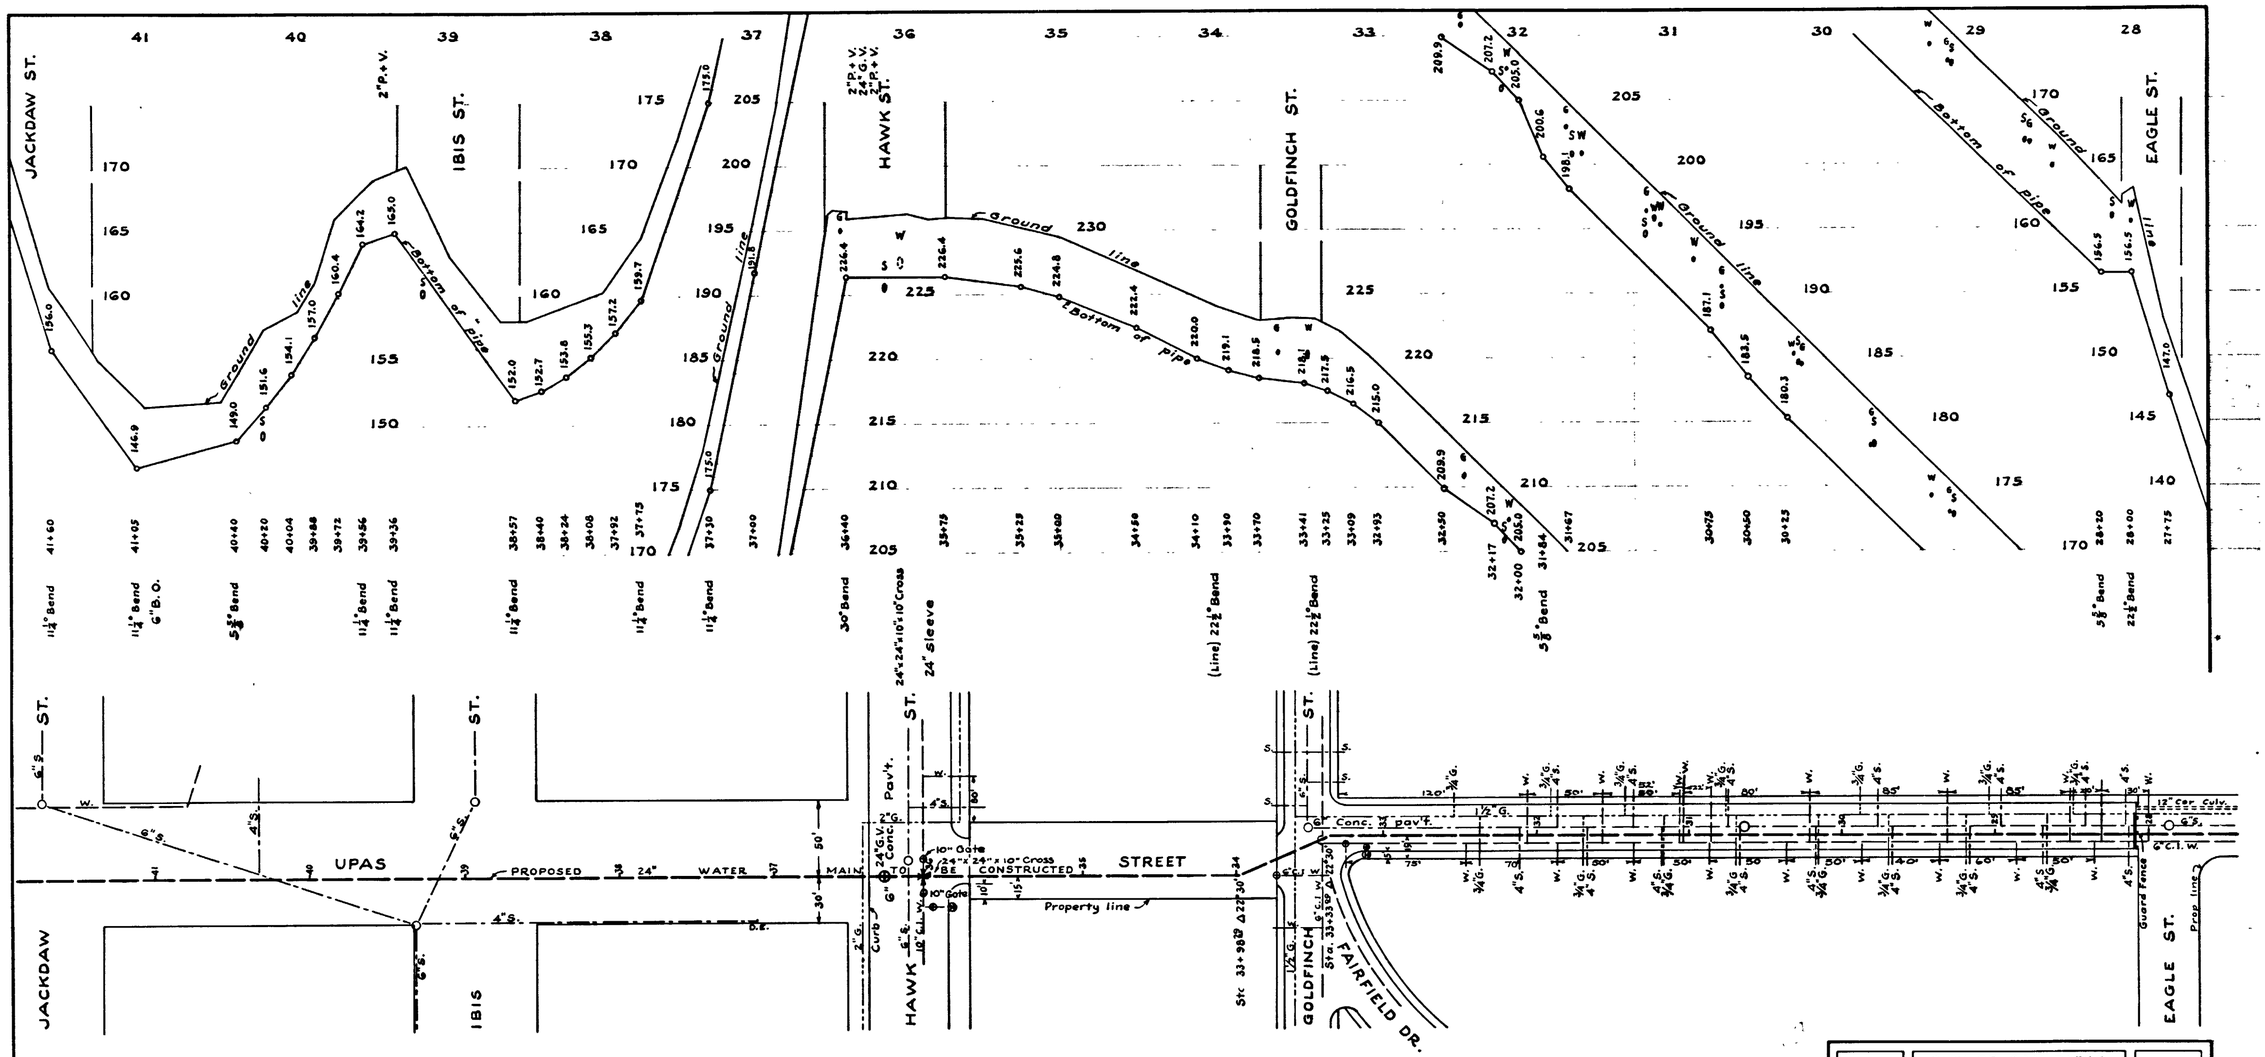

REDUCED PLAN
USE SCALE BELOW
0 1 2 3 4
4" ON ORIGINAL SCALE

NOTE:
Contractor to cut short sections where required.
Bends will be furnished with all bell ends.

CITY DATUM
ADD 6.119 FEET
TO CONVERT TO
MEAN SEA LEVEL.

5 SHEETS	CITY OF SAN DIEGO ENGINEERING DEPARTMENT	SHEET 3

WATER DEPARTMENT
UPAS ST. PIPE-LINE EXTENSION
PLAN AND PROFILE

APPROVED [signature] CITY ENGR. [signature] HYDR. ENGR.		DATE 7-18-40 SCALE 1" = 50'
DRAWN BY A.L.R. TRACED " " CHECKED " " F.B. 564 & 552.	AS BUILT EDITED TO 12-27-40.	DRAWING NUMBER 5928-L

MICROFILMED
JUL 3 1963