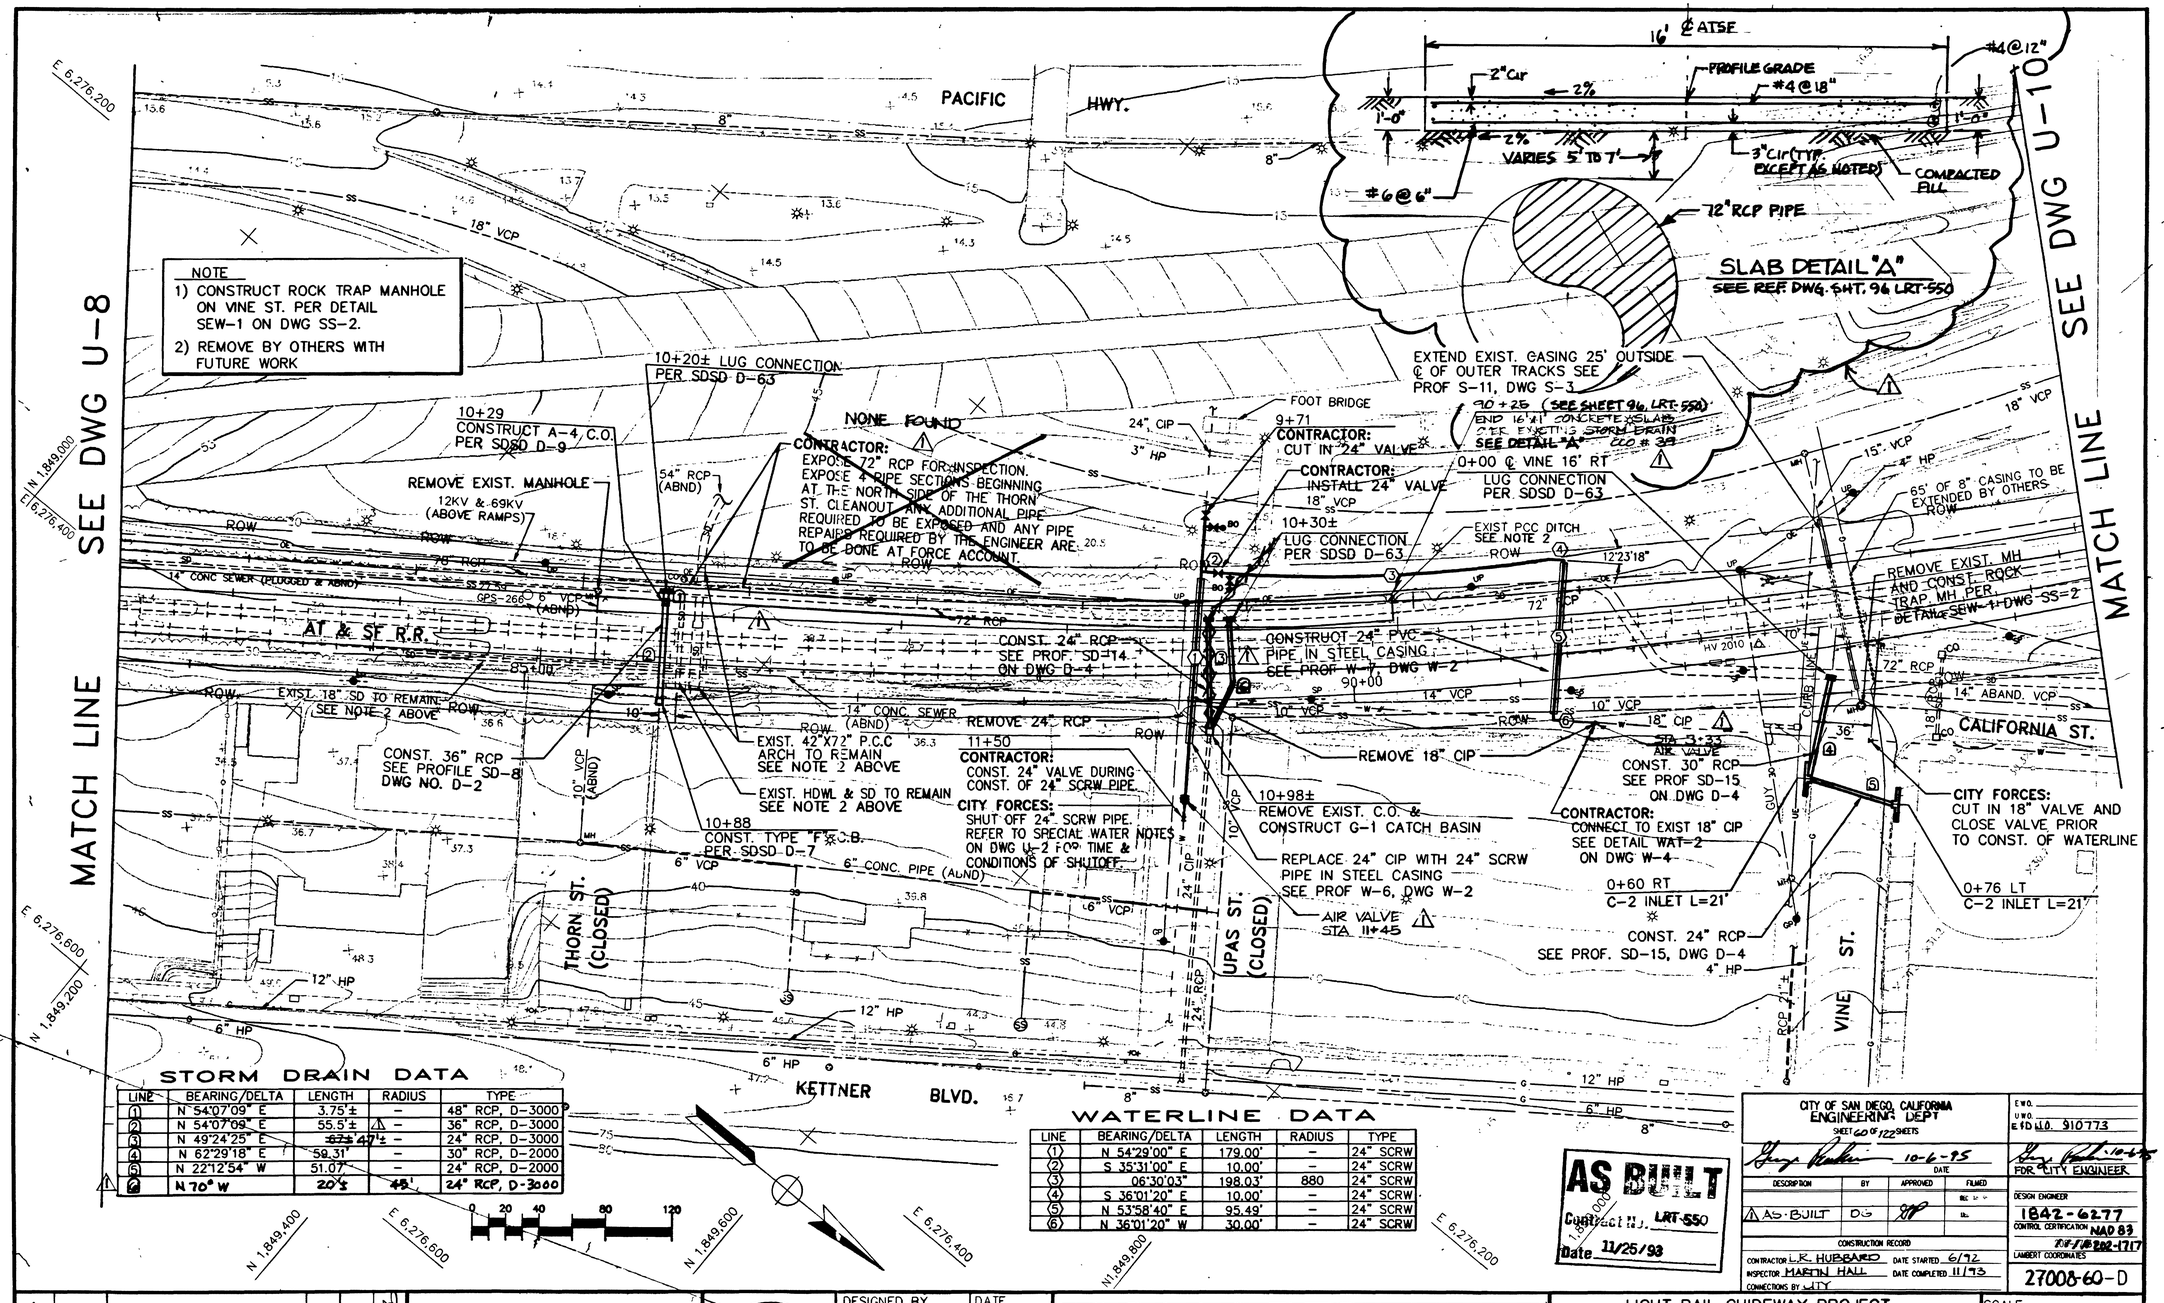

STORM DRAIN DATA

LINE	BEARING/DELTA	LENGTH	RADIUS	TYPE
1	N 54°07'09" E	3.75'±	–	48" RCP, D-3000
2	N 54°07'09" E	55.5'±	–	36" RCP, D-3000
3	N 49°24'25" E	~~67'±~~ 47'±	–	24" RCP, D-3000
4	N 62°29'18" E	59.31'	–	30" RCP, D-2000
5	N 22°12'54" W	51.07'	–	24" RCP, D-2000
6	N 70° W	20'±	45'	24" RCP, D-3000

WATERLINE DATA

LINE	BEARING/DELTA	LENGTH	RADIUS	TYPE
1	N 54°29'00" E	179.00'	–	24" SCRW
2	S 35°31'00" E	10.00'	–	24" SCRW
3	06°30'03"	198.03'	880	24" SCRW
4	S 36°01'20" E	10.00'	–	24" SCRW
5	N 53°58'40" E	95.49'	–	24" SCRW
6	N 36°01'20" W	30.00'	–	24" SCRW

AS BUILT
Contract No. LRT-550
Date 11/25/93

CITY OF SAN DIEGO, CALIFORNIA
ENGINEERING DEPT
SHEET 60 OF 122 SHEETS

10-6-95
DATE

DESCRIPTION	BY	APPROVED	FILMED
1 AS-BUILT	DG		

CONSTRUCTION RECORD
CONTRACTOR L.R. HUBBARD DATE STARTED 6/92
INSPECTOR MARTIN HALL DATE COMPLETED 11/93
CONNECTIONS BY CITY

E.W.O. ____
U.W.O. ____
E&D W.O. 910773

FOR CITY ENGINEER

DESIGN ENGINEER
1842-6277
CONTROL CERTIFICATION NAD 83
LAMBERT COORDINATES
27008-60-D

NO.	DATE	REVISIONS	BY	CHK	APRV
1	10/28/93	AS-BUILT	DG		

FRASER ENGINEERING, INC.
2191 EL CAMINO REAL, OCEANSIDE CALIFORNIA (619) 722-3495

REGISTERED PROFESSIONAL ENGINEER — DRAWN E. FRASER — No. 29618 — EXPIRES 3-31-94 — CIVIL — STATE OF CALIFORNIA

DESIGNED BY	D.W.	1/06/92
DRAWN BY	M.S.B.	1/06/92
CHECKED BY	M.A.	1/06/92
MTDB PRJ. ENG.		

MTDB
Metropolitan Transit Development Board
1255 Imperial Avenue, Suite 1000, San Diego, CA. 92101-7490 (619)231-1466

LIGHT RAIL GUIDEWAY PROJECT
San Diego

OLD TOWN LRT SITE PREPARATION
UTILITY RELOCATION PLAN

SCALE 1" = 40'
MTDB CONTRACT NO. LRT 550
DRAWING NO. U-9
SHEET NO. 64

FE\46801\03\46BUR-9.DWG PLOT 1=40
JULY 15, 1992 - 16:46:08