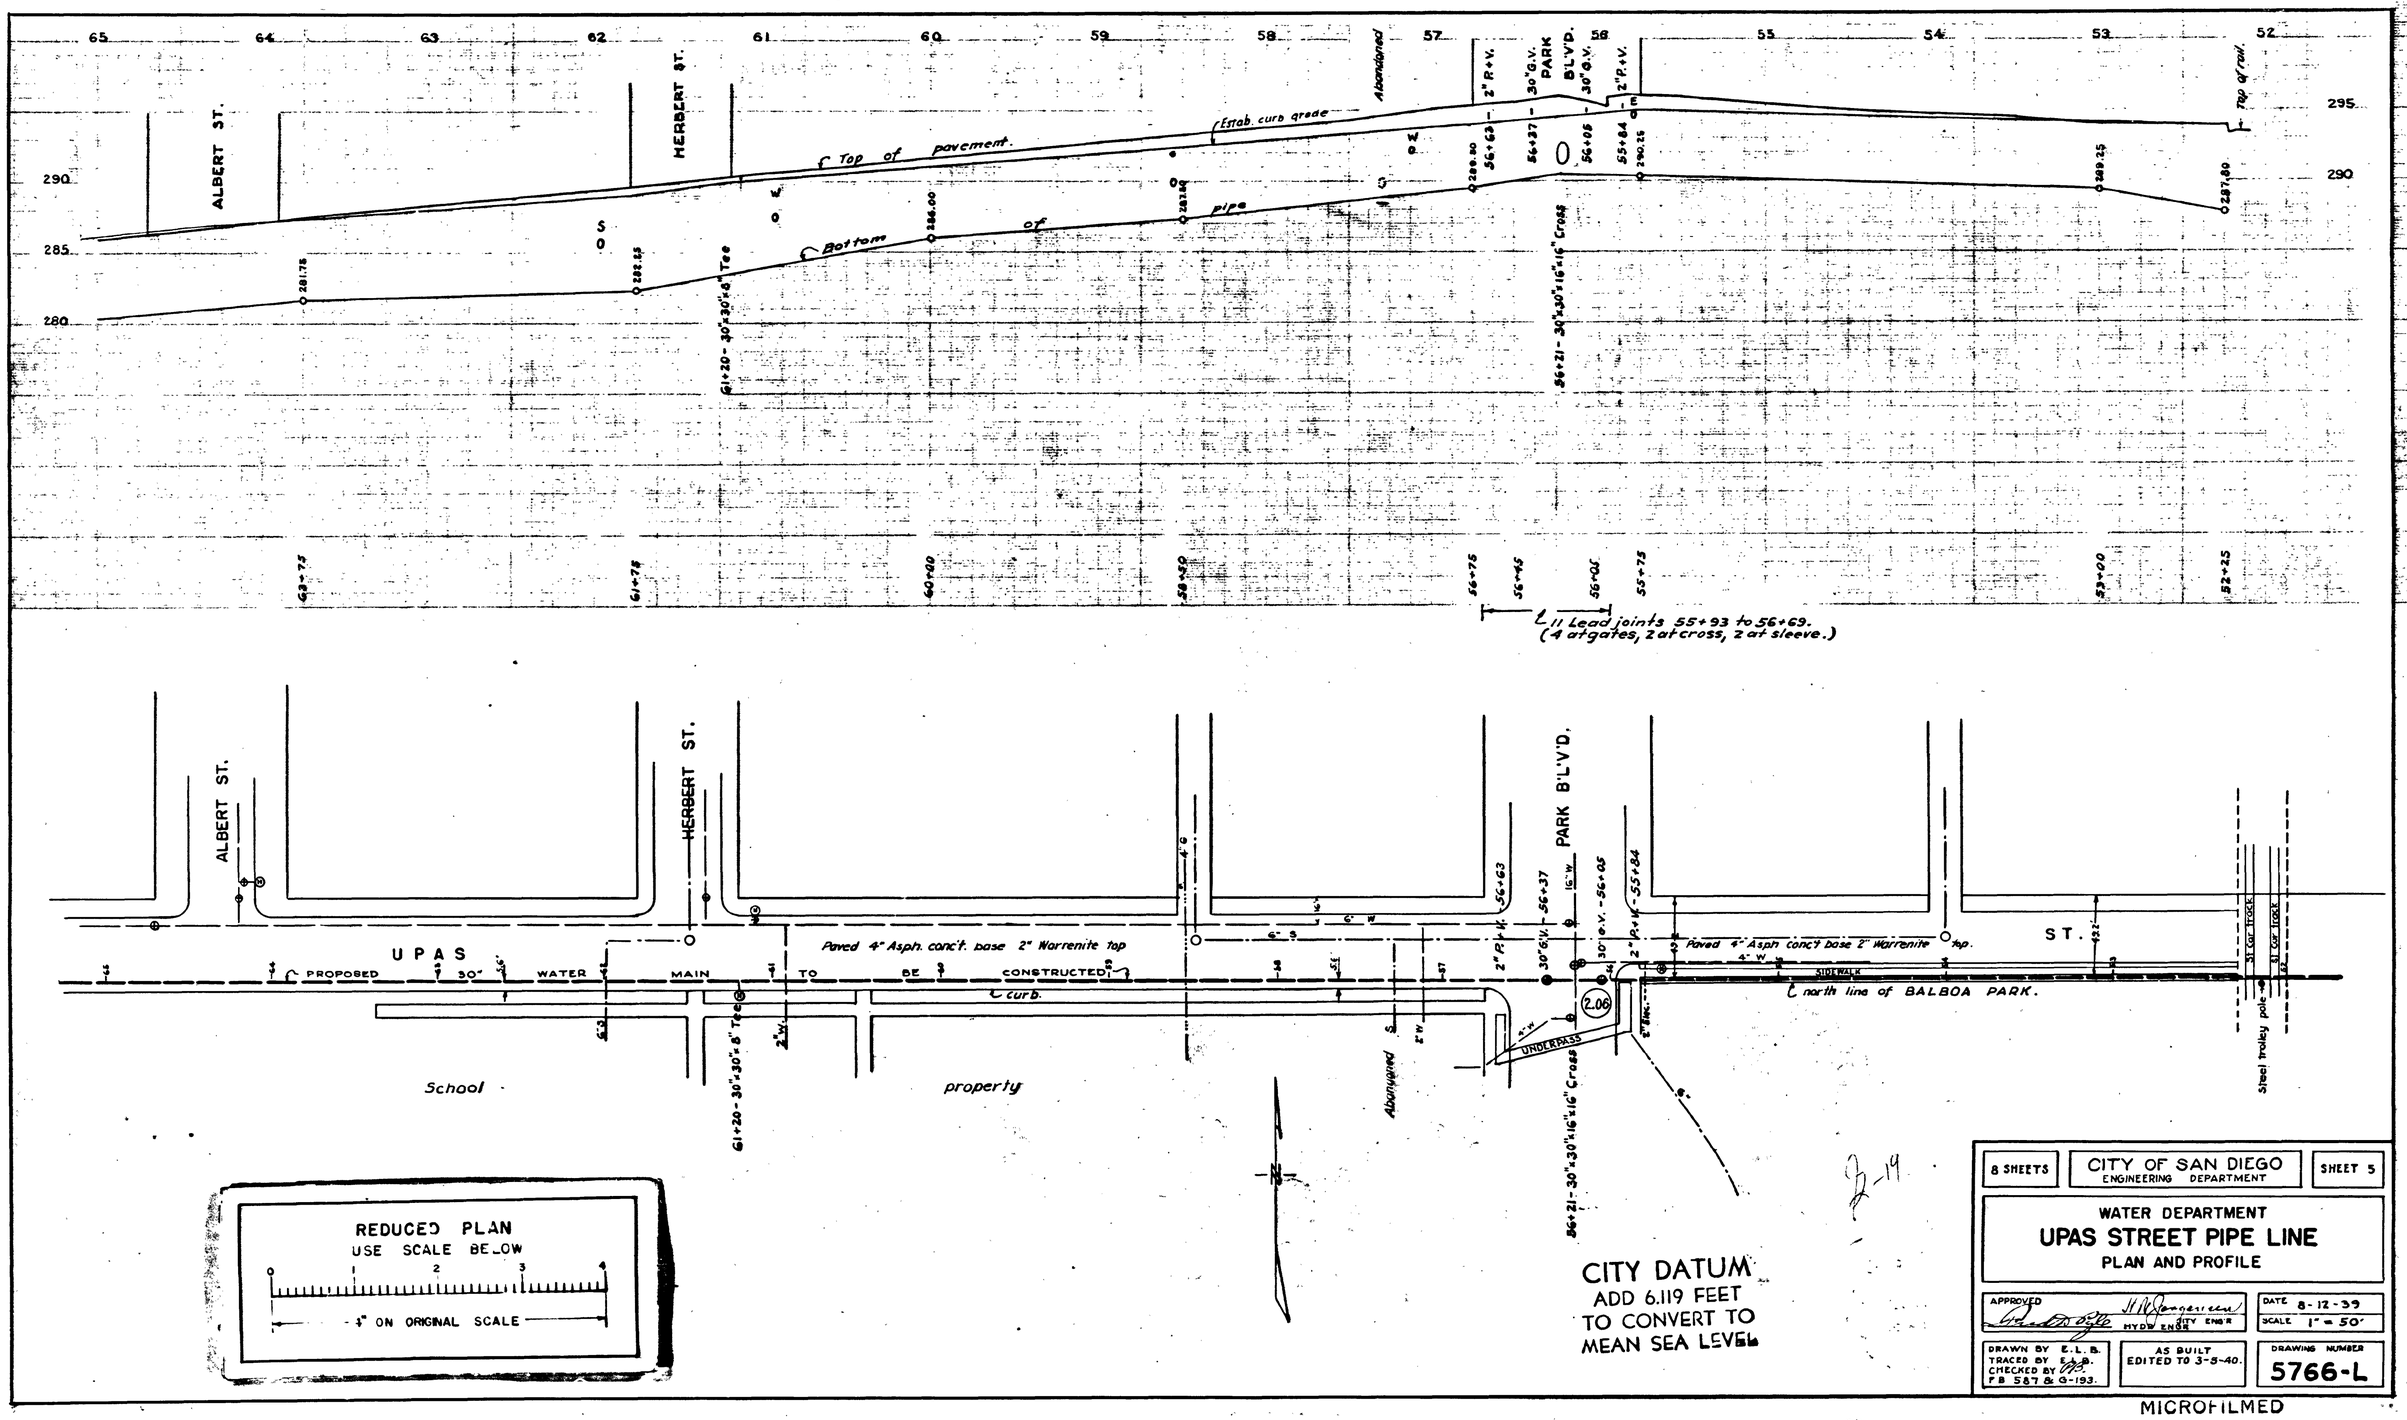

8 SHEETS	CITY OF SAN DIEGO ENGINEERING DEPARTMENT	SHEET 5

WATER DEPARTMENT
UPAS STREET PIPE LINE
PLAN AND PROFILE

APPROVED [signature] HYDR ENGR. [signature] CITY ENG'R		DATE 8-12-39 SCALE 1" = 50'
DRAWN BY E.L.B. TRACED BY E.L.B. CHECKED BY [initials] FB 587 & G-193.	AS BUILT EDITED TO 3-5-40.	DRAWING NUMBER 5766-L

MICROFILMED
JUL 3 1963