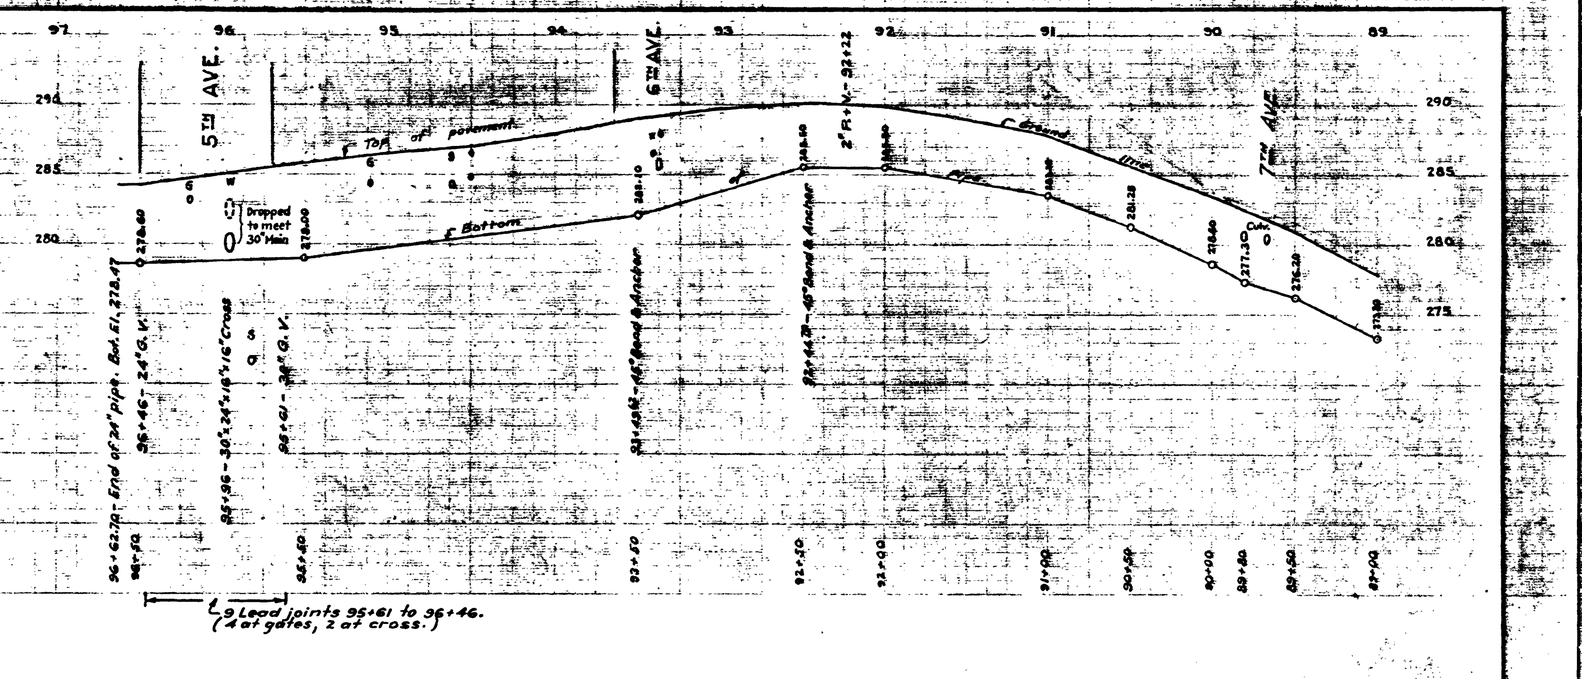

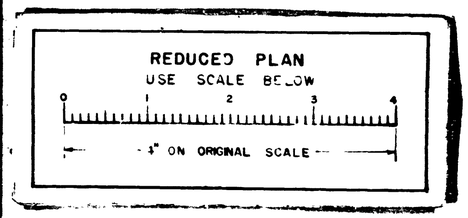

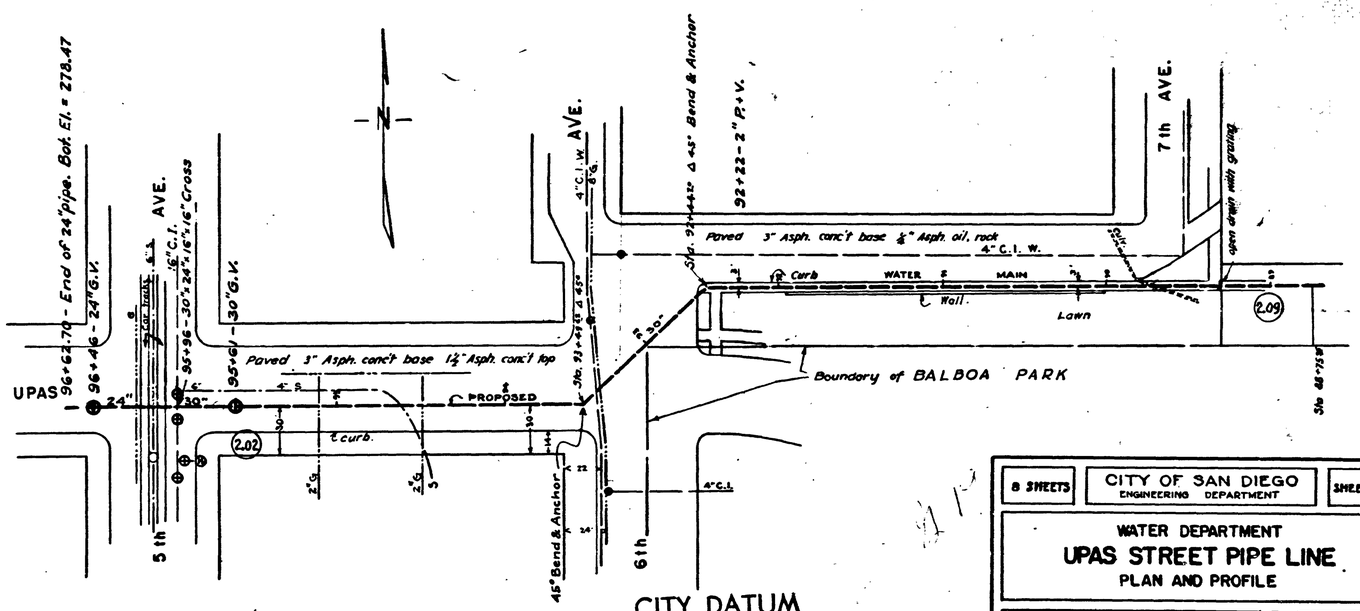

CITY DATUM
ADD 6.119 FEET
TO CONVERT TO
MEAN SEA LEVEL

8 SHEETS	CITY OF SAN DIEGO ENGINEERING DEPARTMENT	SHEET 8

WATER DEPARTMENT
UPAS STREET PIPE LINE
PLAN AND PROFILE

APPROVED [signature] HYDR. ENGR. / [signature] CITY ENGR.		DATE 8-12-39 / SCALE 1" = 50'
DRAWN BY E.L.B. / TRACED BY E.J.B. / CHECKED BY [signature] / F.B. 587 & 6-193.	AS BUILT EDITED TO 3-5-40.	DRAWING NUMBER 5769-L

MICROFILMED
JUL 3 1963