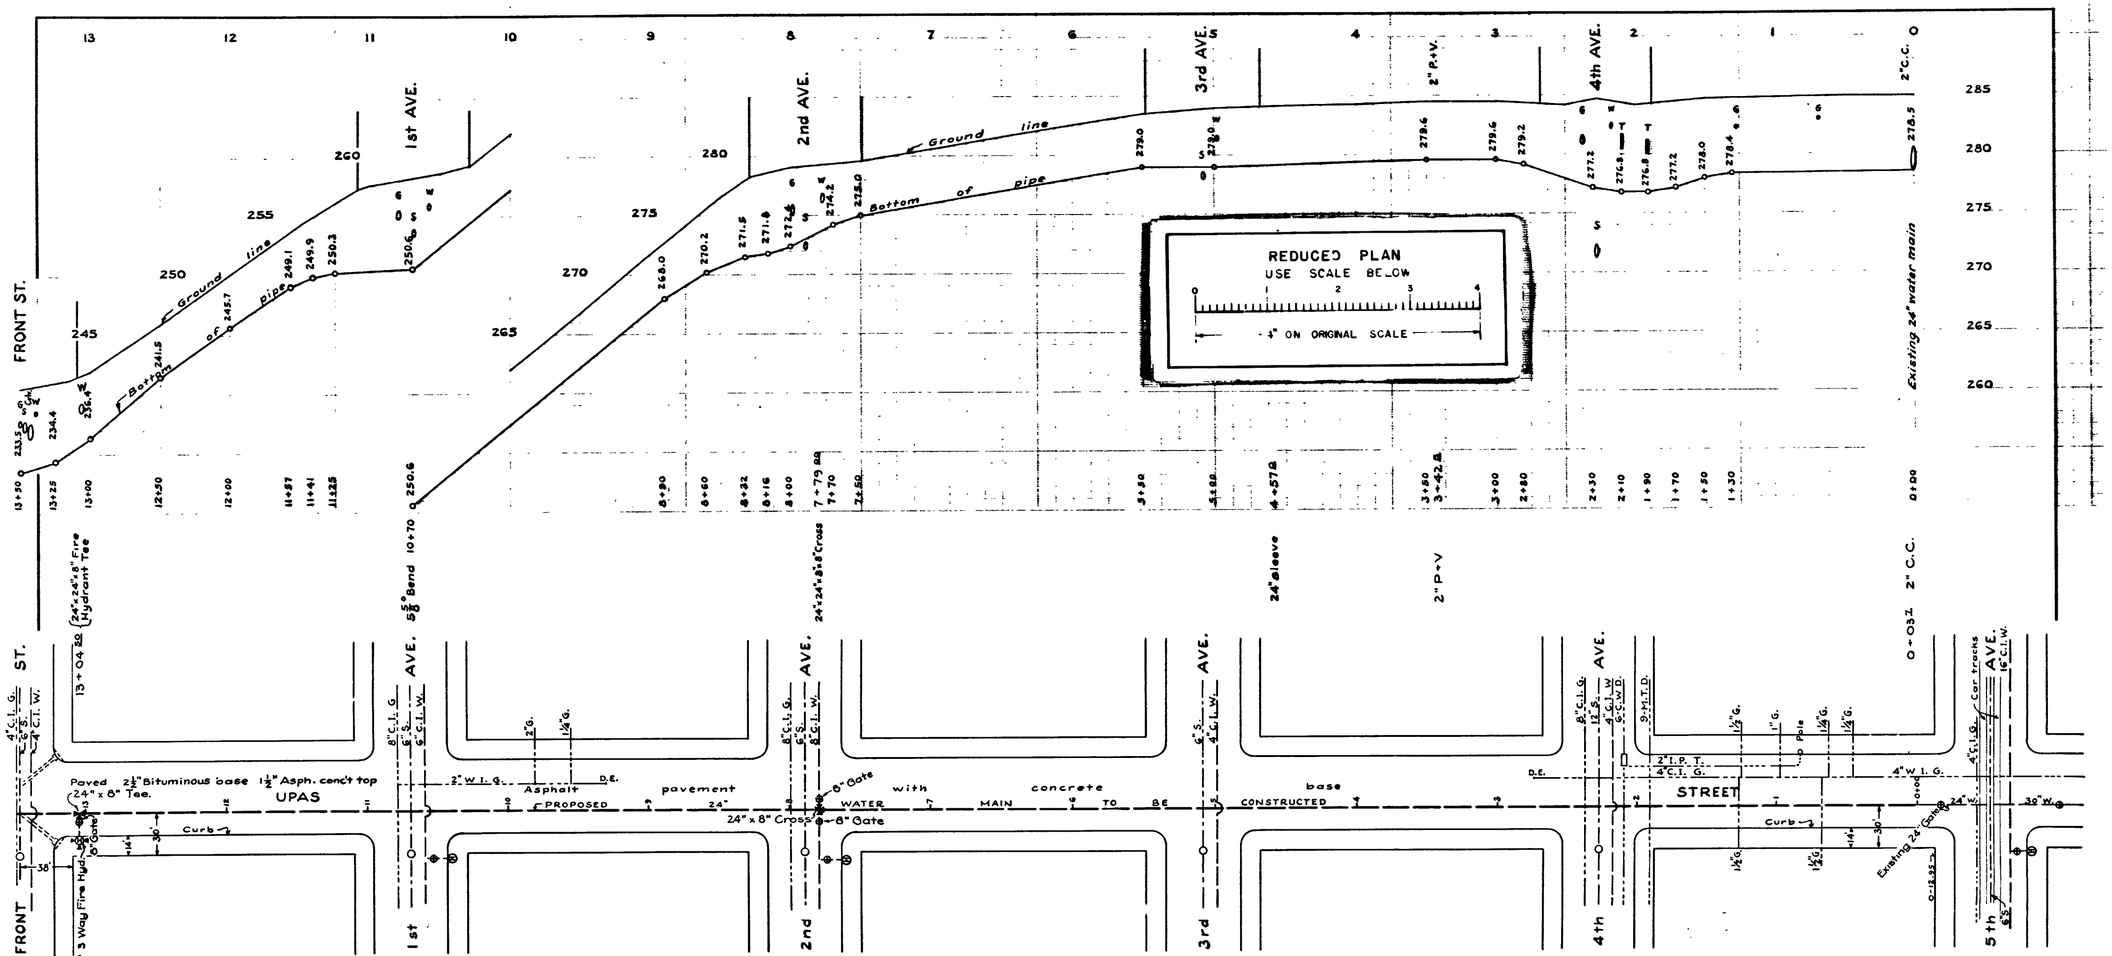

EXISTING WORKS

- Culvert
- W Water
- S Sewer
- G Gas
- T Tel. cond't.
- Sewer manhole
- Water gate
- Fire hydrant

WORK TO BE DONE

- Water main to be constructed.
- Gate to be installed.
- P+V Combination Pressure air and Vacuum valve.
- B.O. Blow off.
- P.A. Pressure air valve.
- C.C. Corporation cock.

NOTE:
Contractor to cut short sections where required.
Bends will be furnished with all bell ends.

CITY DATUM
ADD 6.119 FEET
TO CONVERT TO
MEAN SEA LEVEL

5 SHEETS	CITY OF SAN DIEGO ENGINEERING DEPARTMENT	SHEET 1
WATER DEPARTMENT UPAS ST. PIPE LINE EXTENSION PLAN AND PROFILE		
APPROVED CITY ENGR. / HYDR. ENGR.	DATE 7-18-40 SCALE 1" = 50'	
DRAWN BY A.L.R. TRACED " CHECKED " F.B. 564 & 552.	AS BUILT EDITED TO 12-27-40.	DRAWING NUMBER 5926-L

MICROFILMED
JUL 3 1963