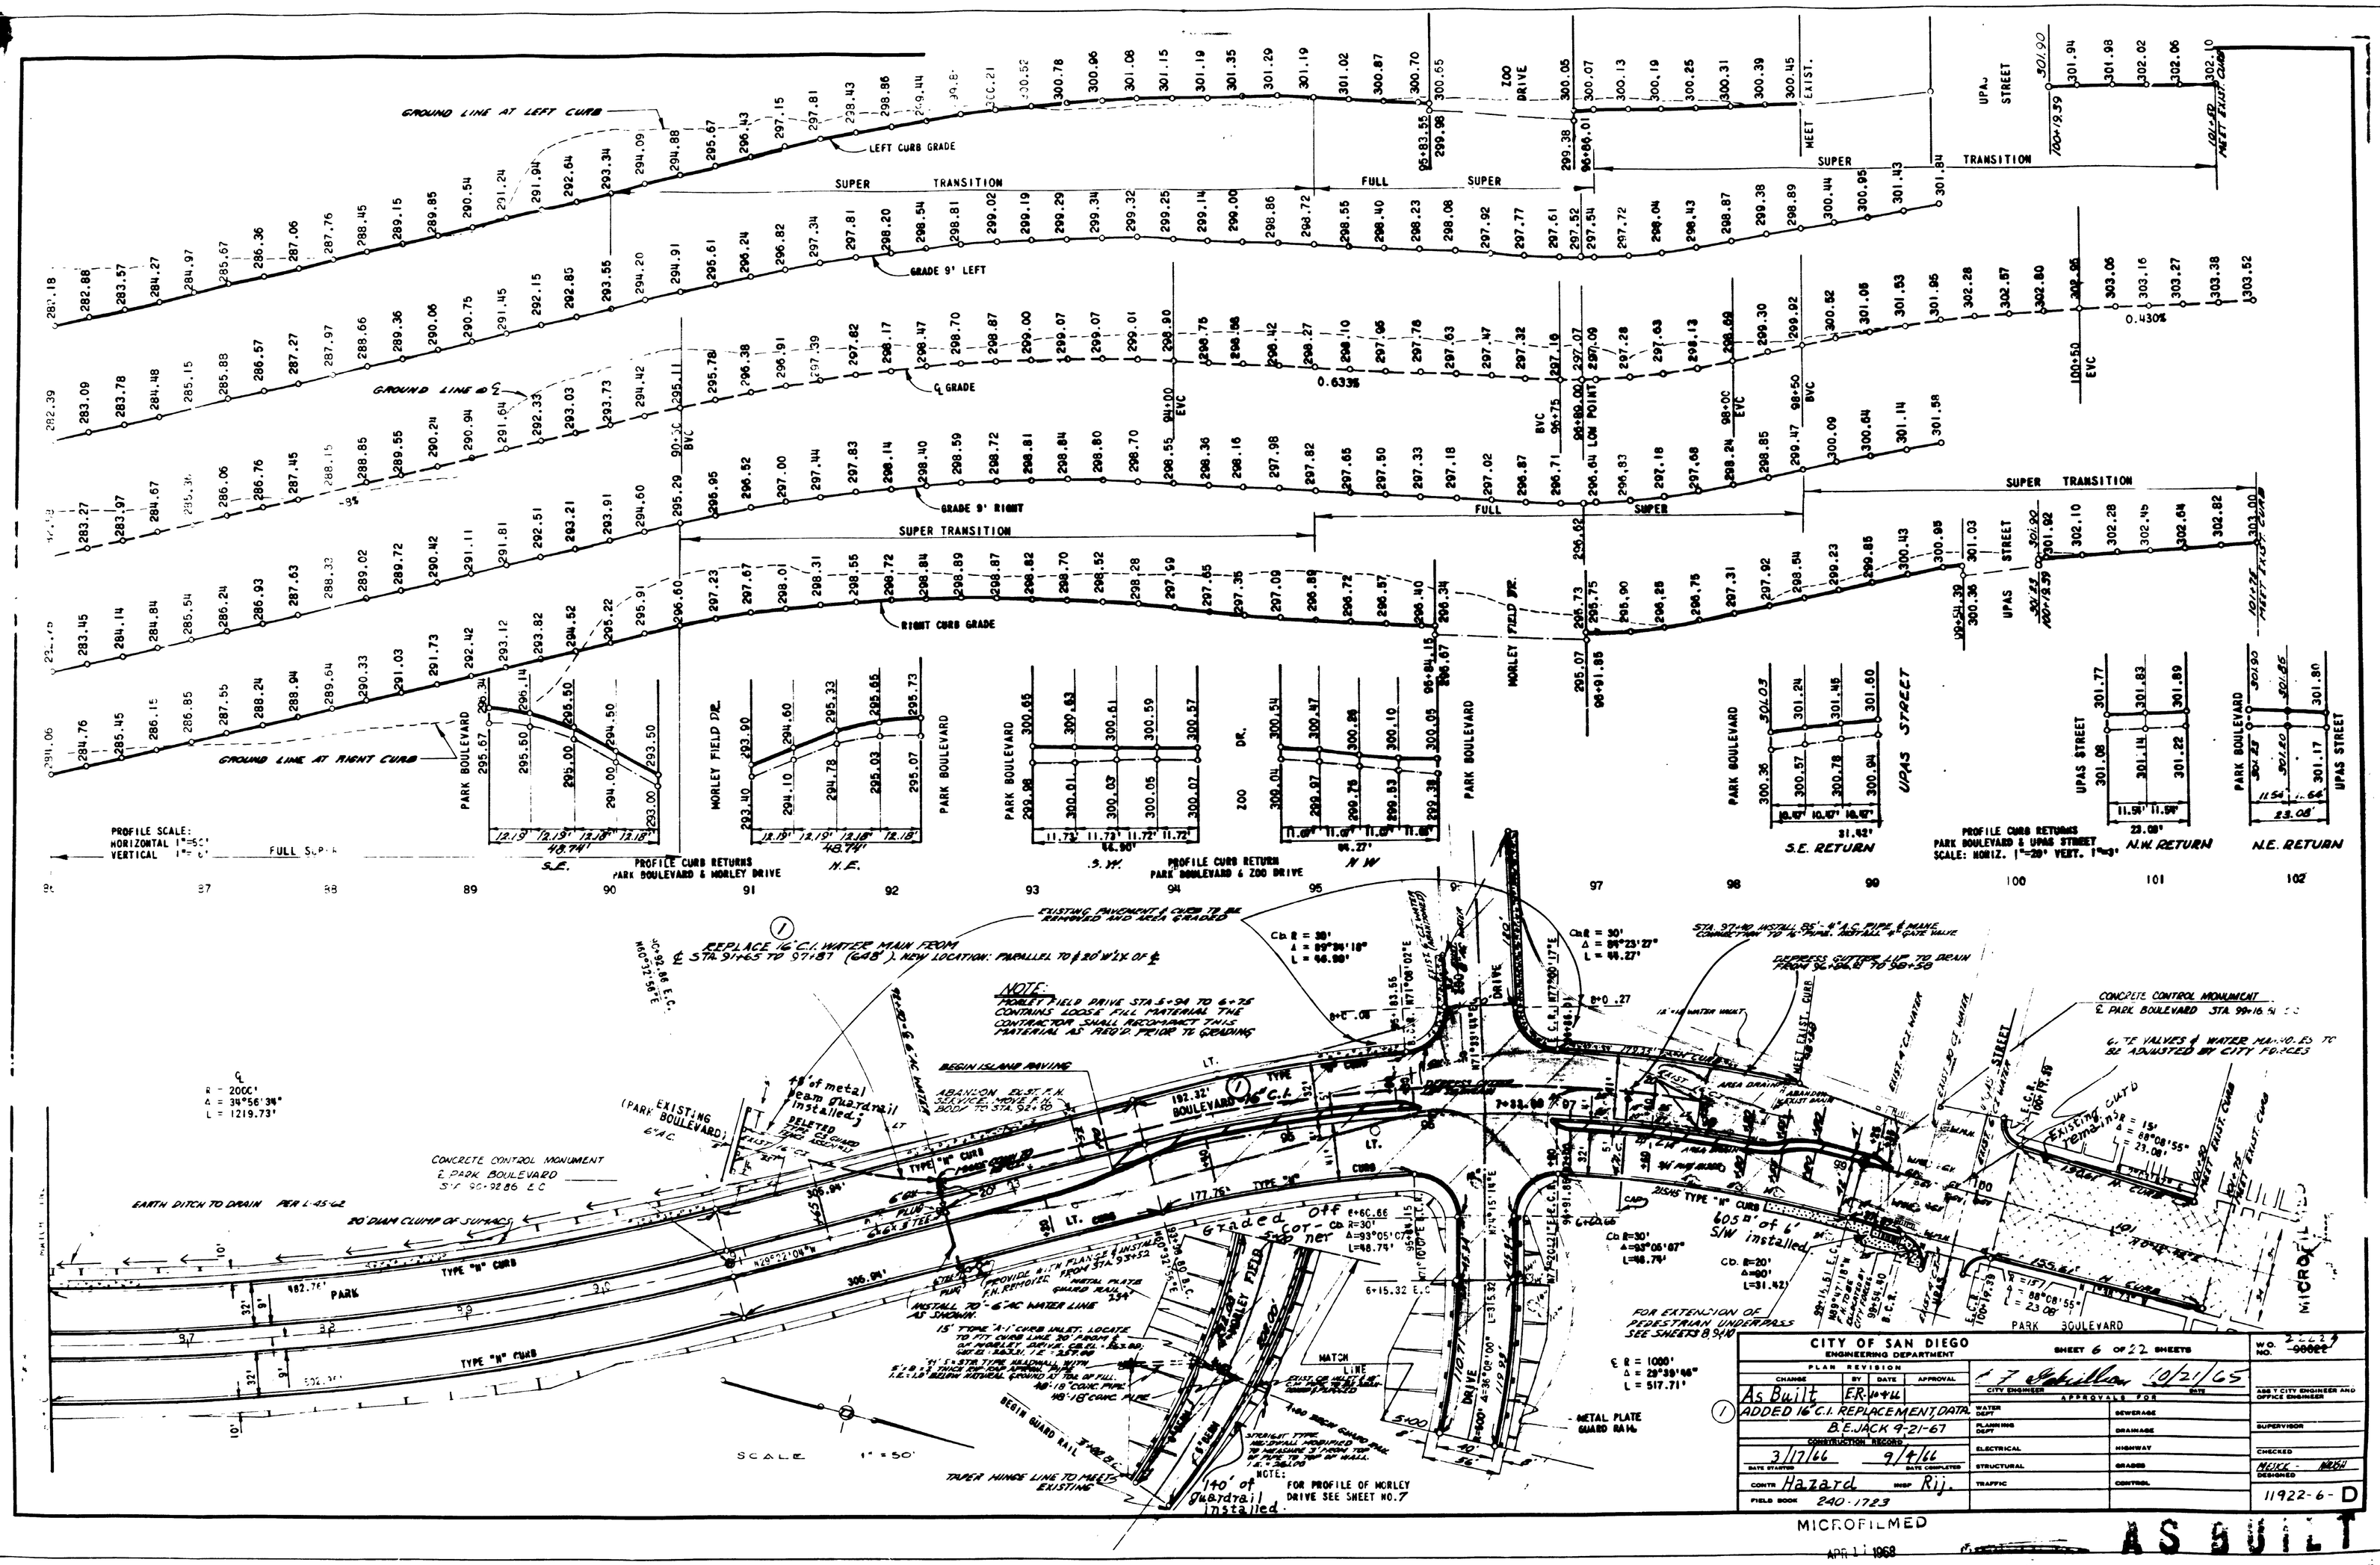

CITY OF SAN DIEGO ENGINEERING DEPARTMENT	SHEET 6 OF 22 SHEETS	W.O. NO. 200227
PLAN REVISION: CHANGE / BY / DATE / APPROVAL	CITY ENGINEER / DATE	ASS'T CITY ENGINEER AND OFFICE ENGINEER
As Built / ER / 10-66	J. T. Sabellico 10/21/65	
(1) ADDED 16" C.I. REPLACEMENT DATA B.E. JACK 9-21-67	APPROVALS FOR: WATER DIV. / SEWERAGE	SUPERVISOR
CONSTRUCTION RECORD	PLANNING DIV. / DRAINAGE	CHECKED
3/17/66 DATE STARTED / 9/4/66 DATE COMPLETED	ELECTRICAL / HIGHWAY	DESIGNED
STRUCTURAL / GRADES		
CONTR. Hazard / INSP. Rij	TRAFFIC / CONTROL	
FIELD BOOK 240-1723		11922-6-D