

7910 ST. LOUIS TERRACE LA JOLLA, CA 92037

PROJECT INFORMATION

APN: 346-454-00

La Jolla Beach

forrey Pines Rd

Dorado & Tennis Club

The Marine Room

HYDRANT .

BUS STOP Pines Rd

BUS STOP

7910 Saint Louis Terrace

- LEGAL DESCRIPTION: LOTS 70 & 71 OF LA JOLLA VISTA, CITY OF SAN DIEGO, COUNTY OF SAN DIEGO, MAP NO. 1762 AT COUNTY RECORDER OFFICE AUGUST 1, 1923
- LOT SIZE 6500 SF
- LA JOLLA SHORES PLANNED DISTRICT "SF"
- COASTAL HEIGHT LIMIT & PARKING IMPACT OVERLAY
- RESIDENTIAL TANDEM PARKING & TRANSIT AREA OVERLAY
- EXISTING BUILDING BUILT 1951 NOT HISTORICAL
- DETERMINED 9/13/17 PTS # 570128 GEOGRAPHIC HAZARD CATEGORY 27
- NO EASEMENTS
- COASTAL ZONE (30FT HEIGHT LIMIT 29FT PROPOSED)
- OCCUPANCY CLASS R-3
- CONSTRUCTION TYPE: VB SPRINKLERED

SETBACKS:	NEIGHBORHOOD AVERAGE	PROPOSED
FRONT	15/16	15
STREET SIDE	8/9	10
INTERIOR SIE	DE 5/6.5	5
REAR	10/7	10

OWNER INFORMATION

TULIP 1031, LLC 7910 ST. LOUIS TERRACE LA JOLLA, CA 92037

PROJECT TEAM

JAMES ALCORN, ARCHITECT, AIA 9736 CLAIBORNE SQUARE LA JOLLA, CALIFORNIA 92037

NERI LANDSCAPE ARCHITECTURE 928 HORNBLEND STREET, SUITE #3 SAN DIEGO, CALIFORNIA 92109

LANDMARK CONSULTING 9555 GENESEE AVENUE, SUITE 200 SAN DIEGO, CA 92121

COASTAL DEVELOPMENT & SITE DEVELOPMENT PERMITS PROJECT SCOPE -

• REMOVE ALL STRUCTURES:

1821 SF RESIDENCE OVER 750 SF BASEMENT AND 540 SF GARAGE. COVERAGE = 2400 SF, LOT = 6500 SF, THEREFORE 2400 SF = .37 LOT COVERAGE. RETAINING WALLS AT NORTH AND WEST PROPERTY LINE TO BE RETAINED

CONSTRUCT:

2 STORY, 4640 SF RESIDENCE OVER BASEMENT GARAGE AND STUDIO OF 2176 SF & ADJACENT LAP POOL. COVERAGE 3120 SF= .48 LOT COVERAGE ALLOWABLE LOT COVERAGE = .60

SHEET LIST

COVER PAGE & NORTH PERSPECTIVE VIEW

SITE SURVEY C1 300' RADIUS SETBACK SITE PLAN

LOWER LEVEL PLAN

ENTRY LEVEL PLAN UPPER FLOOR PLAN

ROOF PLAN ELEVATIONS

EAST PERSPECTIVE & SECTIONS LANDSCAPE DEVELOPMENT PLAN LANDSCAPE CONCEPT IMAGES

C1.2 SITE INFORMATION/NOTES C1.3 PRELIMINARY GRADING PLAN


Grady Residence

3 October, 2017

R 13 SEPT 2018

1 of 13

Cover Sheet

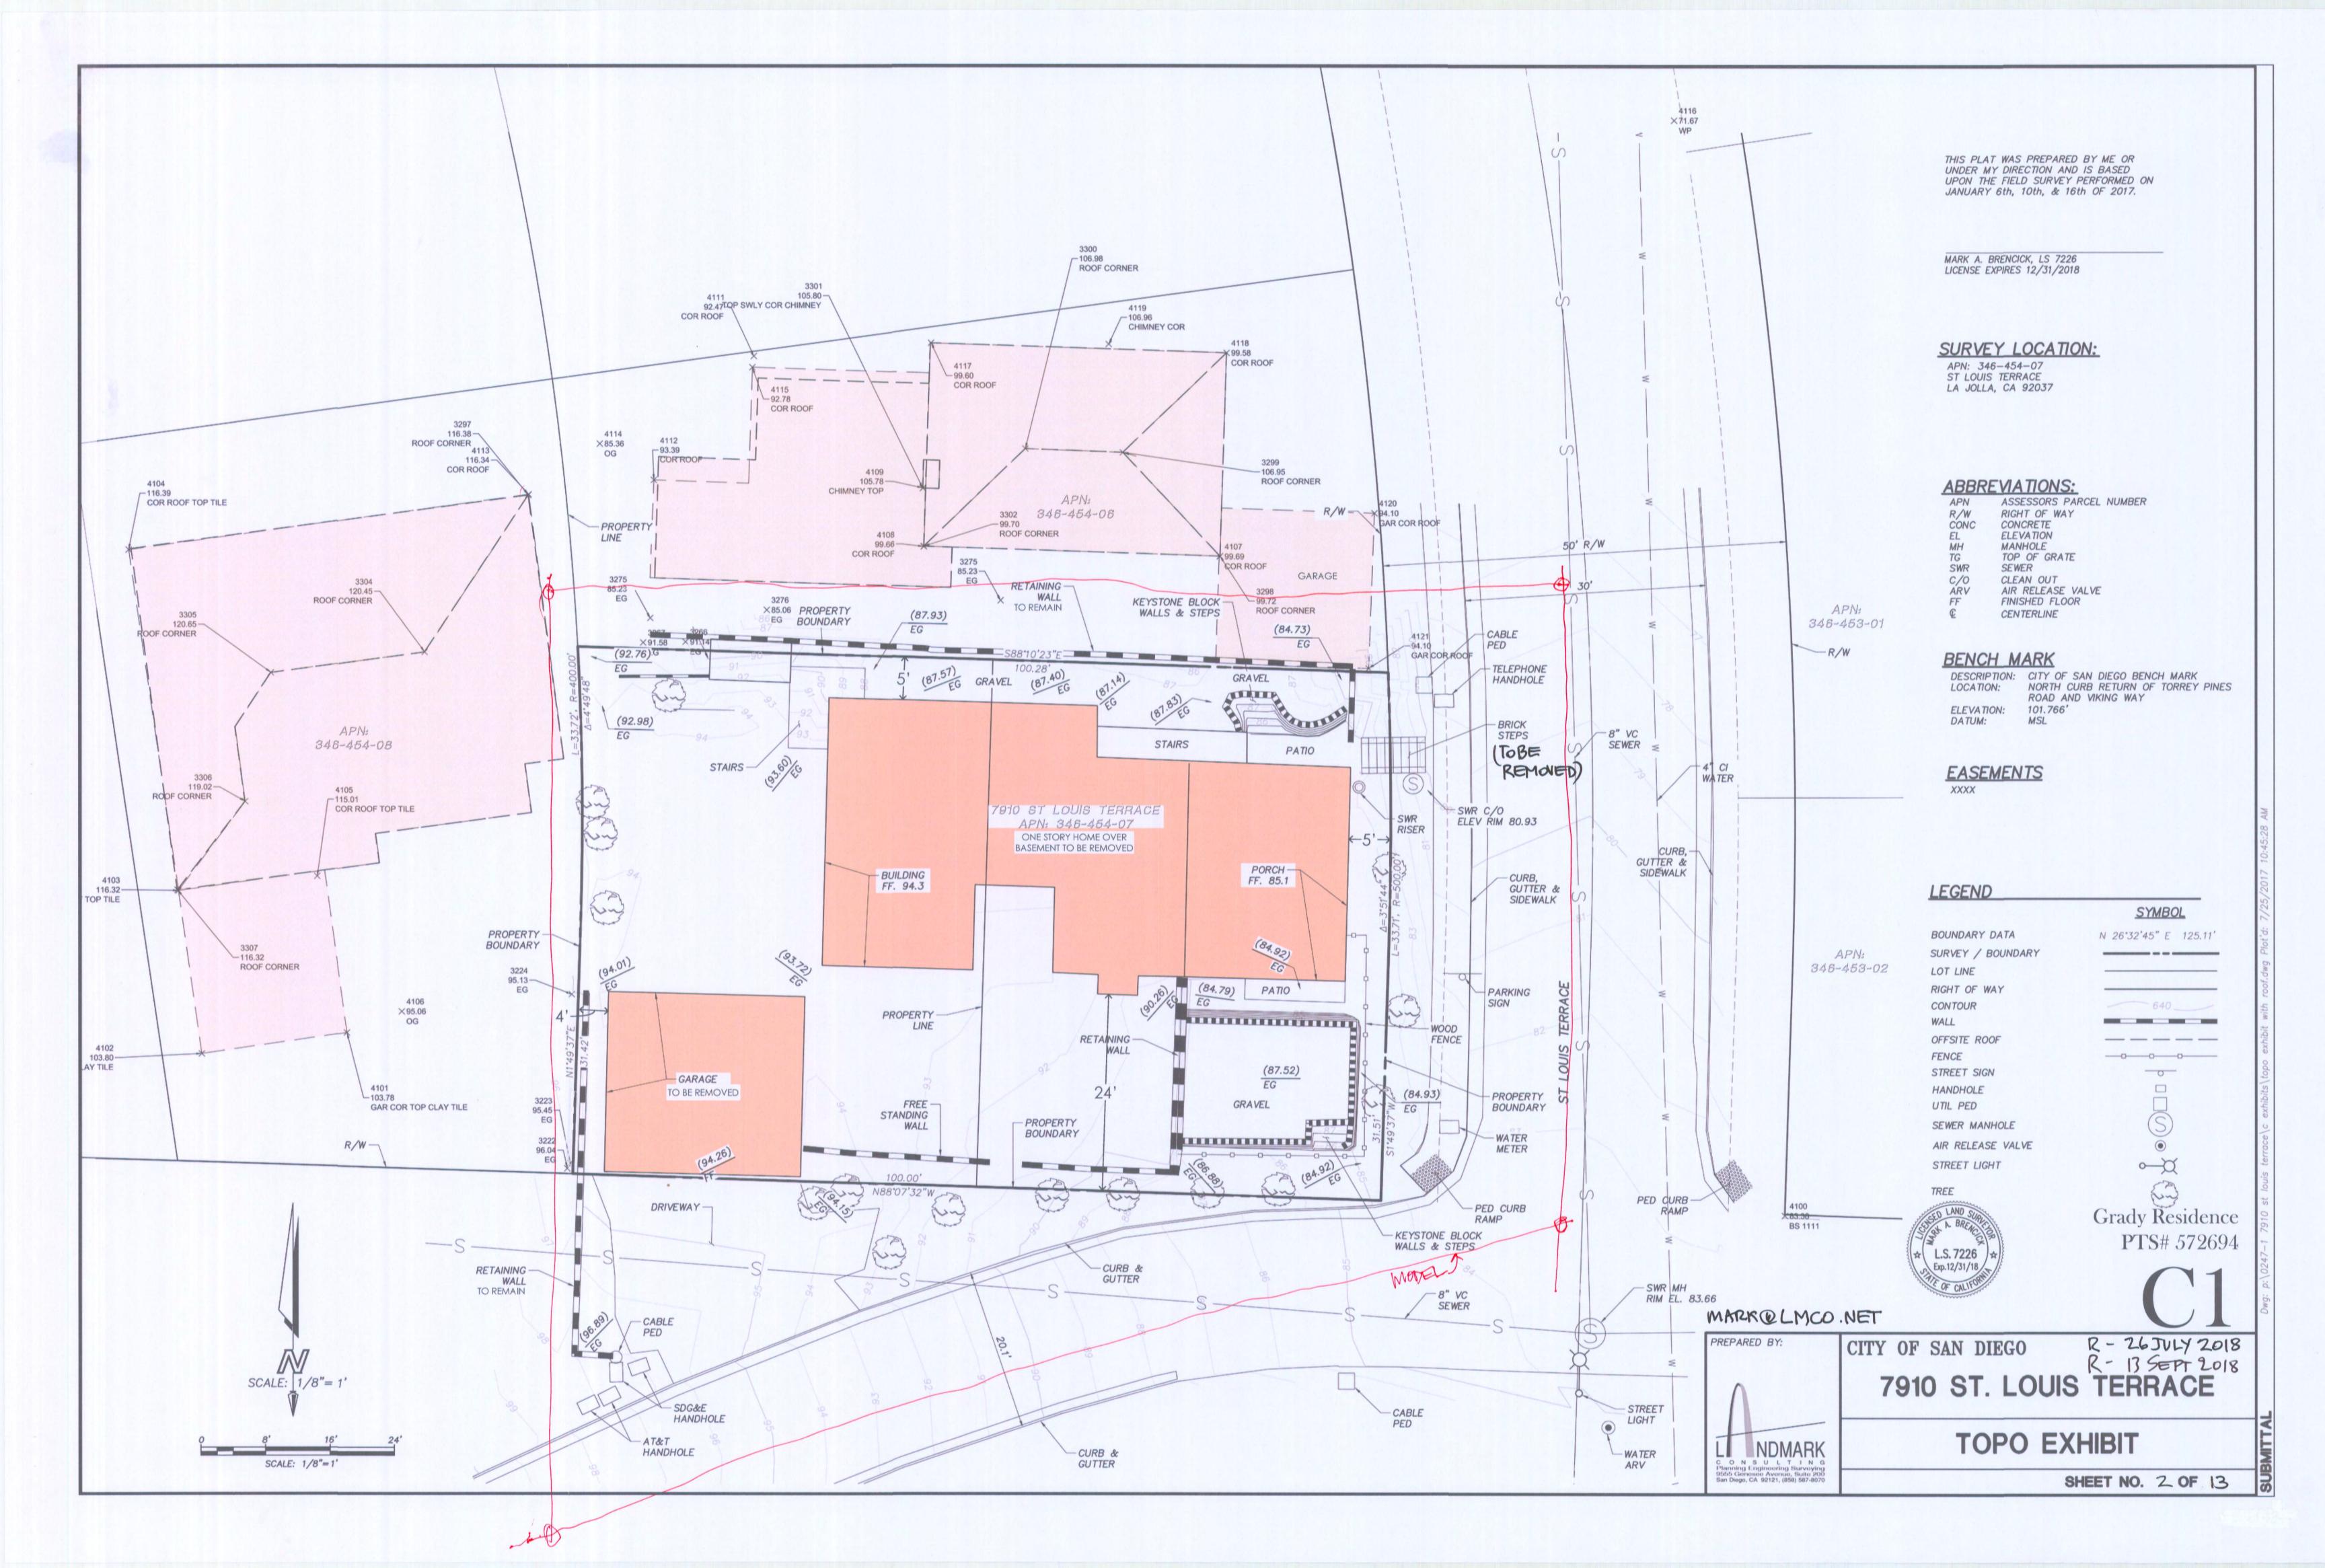




James Alcorn Architect 9736 Claiborne Square La Jolla, California 92037 619/701.8488

Grady Residence

R 13 SEPT 2018

300' RADIUS SET-BACK SITE-PLAN

LEGEND NTS FRONT SET-BACK (10'-25') AVG. FRONT SET-BACK = 15' REAR YARD SET-BACK (8'-15') AVG. REAR SET-BACK = 10' SIDE YARD SET-BACK (5' - 10') AVG. SIDE SET-BACK = 5' **AVERAGE SET-BACK** AVERAGE SET-BACK

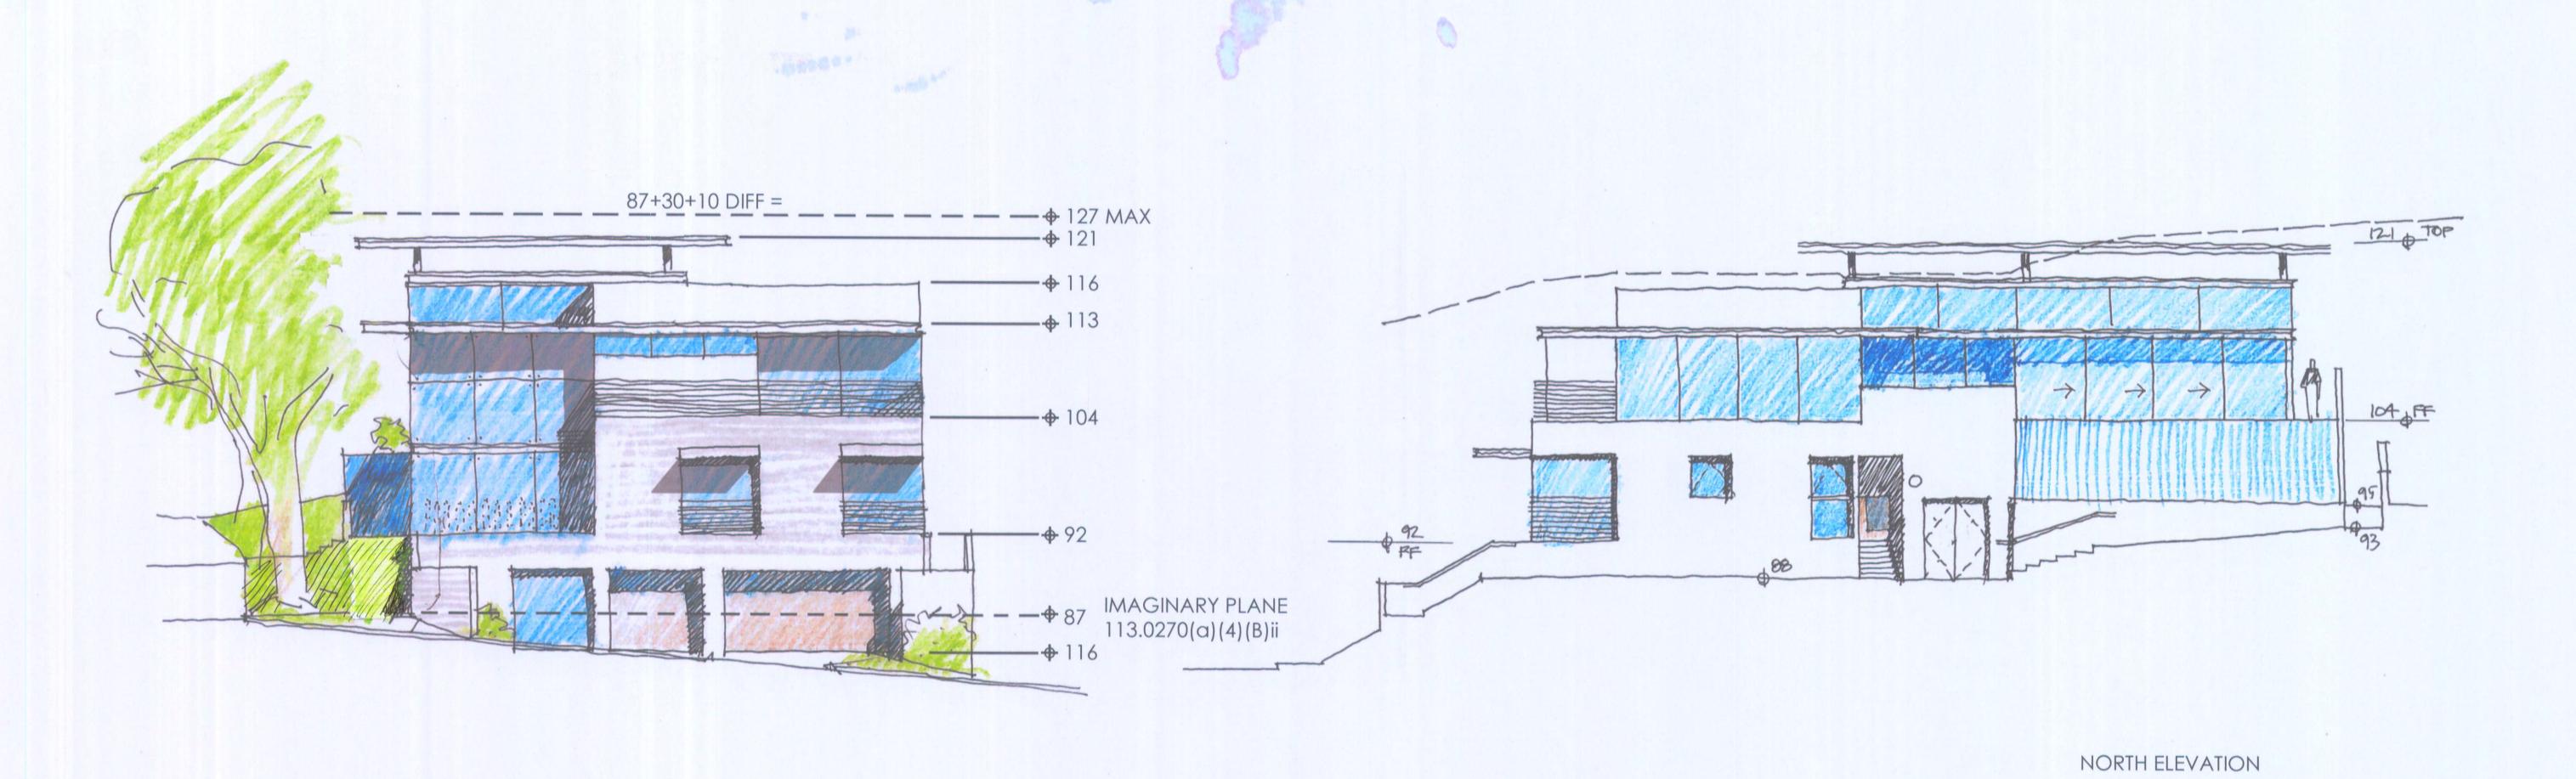

James


9736 Claiborne Square La Jolla, California 92037 619/701.8488

Grady Residence

R 135EPT 2018

Elevations

10 of 13

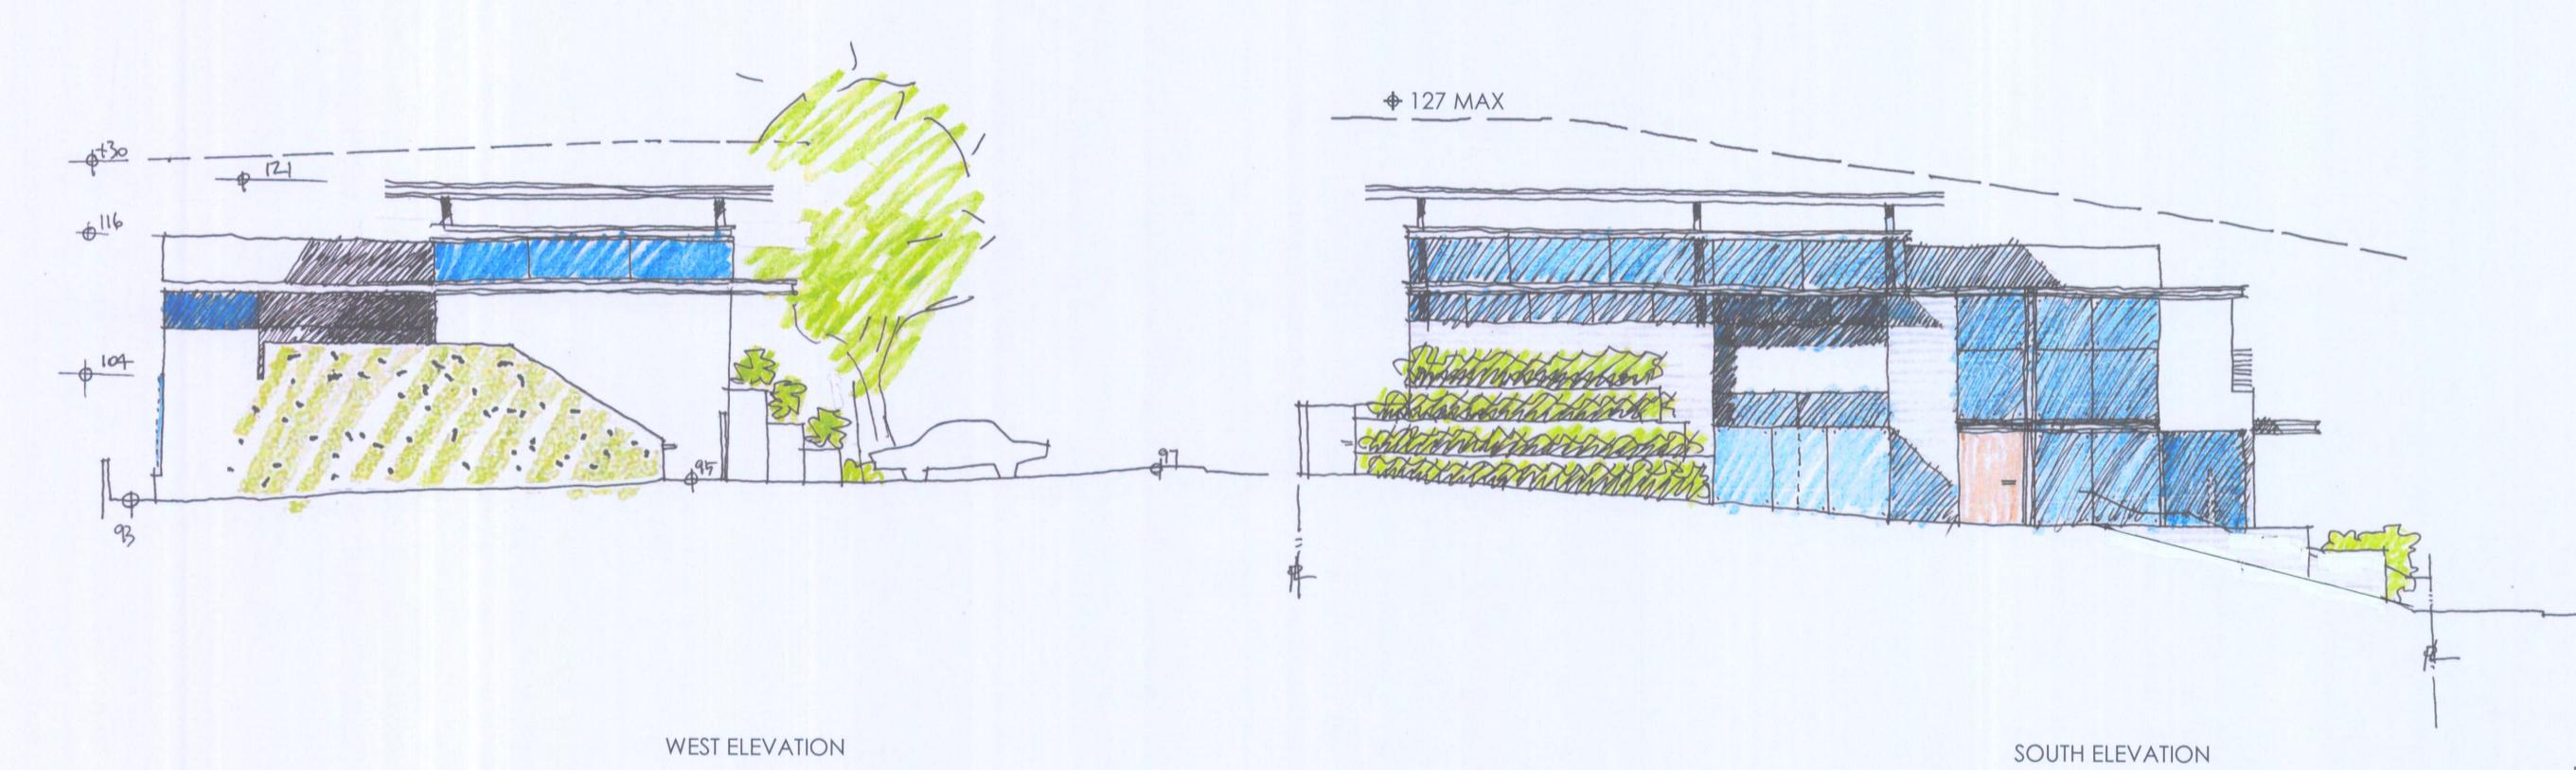




EAST PERSPECTIVE VIEW

James Architect

9736 Claiborne Square La Jolla, California 92037 619/701.8488

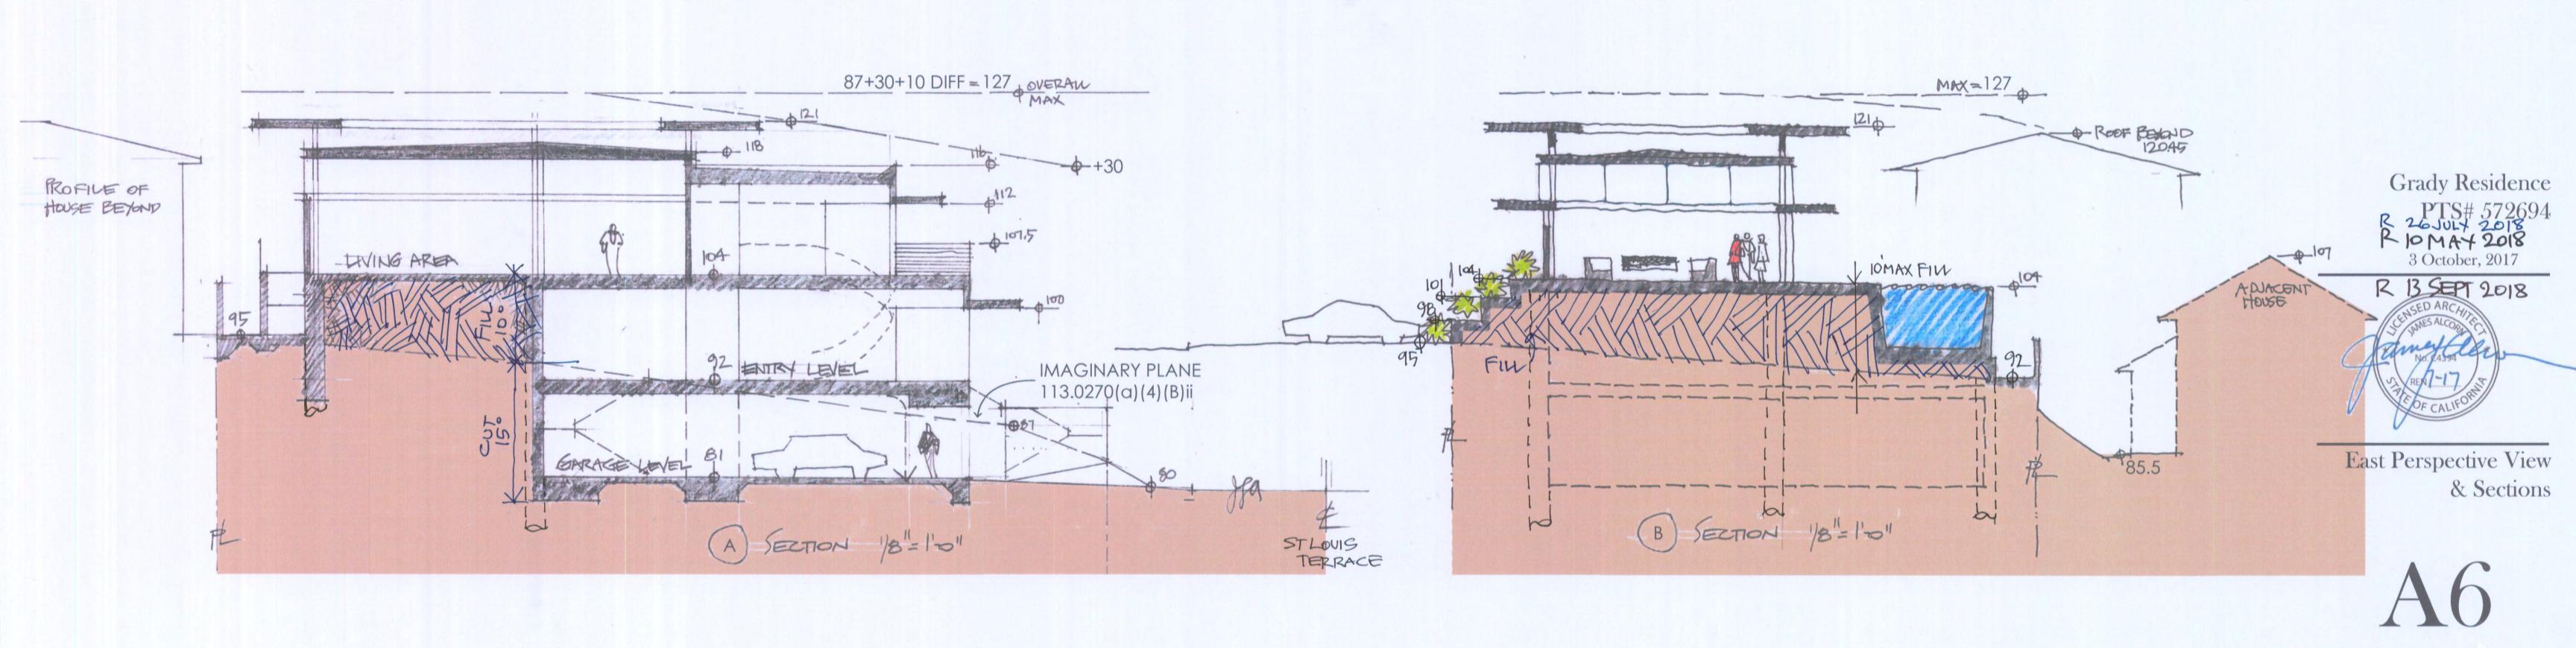

*Bougainvillea x 'Rosenka'

Small scale -2' x 2', such as:

Dianella tasmanica variegata

EVERGREEN ACCENT VINES

Liriope muscari 'Variegata'

Climbing vines - such as:

Bougainvillea x 'Rosenka'

Bougainvillea 'La Jolla'

Clematis armandii

EVERGREEN ACCENT PERENNIALS

Rosa floribunda 'Iceberg'

Pelargonium peltatum

*Zephyranthes candida

QTY / % / SIZE

2 / 100% / 24 box

" Hong Kong Orchid Tree"

22 / 100% / 24 box

"Italian Cypress"

"Carolina Cherry"

"Sweet Bay"

PROPOSED PLANT MATERIAL LEGEND:

EVERGREEN SHADE TREE

*Bauhinia blakeana

Laurus nobilis

Prunus caroliniana

*Cupressus sempervirens

:-

Small scale tree - 20' tall x 20' wide, such as:

EVERGREEN SCREENING HEDGE

Large scale shrub - clipped 6' tall, such as:

"Bougainvillea

"Ivy Geranium"

"Zephyr Flower"

"White Shrub Rose"

23 / 100% / 5 GAL

"Variegated Flax Lily"

"Variegated Lily Turf"

1 / 100% / 5 GAL

"Evergreen Clematis'

"Bougainvillea"

"Bougainvillea"

LA JOLLA SHORES PLANNED DISTRICT ORDINANCE LANDSCAPE CALCULATIONS:

MULTI FAMILY LANDSCAPE REQUIREMENTS

LA JOLLA SHORES PLANNED DISTRICT ORDINANCE

ALL OF THE LANDSCAPE TO MEET THE 30% AREA REQUIREMENT SHALL BE INSTALLED AS REQUIRED BY THE LA JOLLA SHORES PLANNED DISTRICT ORDINANCE [LDC 1510.0306(G)].

TOTAL PARCEL AREA: PLANTING AREA REQUIRED:

6,500 S.F. 1,950 S.F. (30%)

PLANTING AREA PROVIDED: EXCESS AREA PROVIDED:

1,126 SF

HARDSCAPE LEGEND

PROPOSED HARDSCAPE MATERIAL LEGEND:

HARDSCAPE PAVING 'A' Non-porous paving such as:

"Integral Color Concrete" "Integral Color Concrete with Exposed Aggregate Finish"

"Uncolored Concrete with Enhanced Finish" HARDSCAPE PAVING 'B'

1,117 SF Permeable paving such as: Decomposed Granite Paving

LANDSCAPE KEY NOTES:

- A PROPERTY LINE, TYPICAL SYMBOL
- (B) EXISTING (8) STREET TREES TO REMAIN
- C TERRACED MASONRY PLANTER WALL
- **(D)** EXISTING CONCRETE CITY SIDEWALK TO REMAIN
- SIDE YARD GATE
- F POOL
- © POOL DECK
- ⟨ VISIBILITY AREA NO OBSTRUCTION INCLUDING WALLS IN THE SIBILITY AREA SHALL EXCEED 3 FEET IN HEIGHT. PLANT MATERIAL OTHER THAN TREES. WITHIN THE ROW THAT IS LOCATED WITHIN VIBILITY AREAS SHALL NOT EXCEED 24" INCHES IN HEIGHT, MEASURED FROM THE TOP OF THE ADJACENT CURB
- (J) PLANTED PARKING STALL
- **(R)** CONCRETE STEPS
- RETAINING WALL
- **EXISTING UTILITIES TO REMAIN**
- N DECOMPOSED GRANITE PAVING
- INSTALL 3" DEEP ORGANIC MULCH IN ALL PLANTING BEDS EXCEPT AT
- PLANTING AREA BELOW OPEN STAIRS
- **EXISTING TREE TO BE REMOVED**
- R EXISTING OFF-SITE TREES

Low growing turf grass - 12" tall and spreading, such as:

Turf/Sedge Groundcover - 12" tall and spreading, such as:

EVERGREEN GROUNDCOVER - SHADE

*Carex pansa

TURF AREA

*Carex pansa

Festuca rubra

*Carex pansa

Lippia nodiflora

*Fragaria chiloensis

Paspalum vaginatum

LA JOLLA SHORES PDO NOTES:

1. IN THE SINGLE FAMILY ZONE, ALL OF THE PROPERTY NOT USED OR OCCUPIED BY STRUCTURES, UNPLANTED RECREATIONAL AREAS, WALKS AND DRIVEWAYS SHALL BE LANDSCAPED AND MAY INCLUDE NATIVE MATERIALS, AND IN NO CASE SHALL THIS LANDSCAPED AREA BE LESS THAN 30 PERCENT OF THE TOTAL PARCEL AREA. ALL LANDSCAPING AND IRRIGATION SHALL BE DEVELOPED IN CONFORMANCE WITH THE LANDSCAPE GUIDELINES OF THE LAND DEVELOPMENT MANUAL 2. ALL LANDSCAPING SHALL BE COMPLETED WITHIN 6 MONTHS OF OCCUPANCY OR WITHIN ONE YEAR OF THE NOTICE OF COMPLETION OF A RESIDENCE. 3. ALL LANDSCAPED MATERIALS SHALL BE PERMANENTLY MAINTAINED IN A GROWING AND HEALTHY CONDITION INCLUDING TRIMMING AS APPROPRIATE TO THE LANDSCAPING MATERIAL.

Low growing groundcover - 4" tall and spreading, such as: 2,050 / 100% / @ 8" O.C.

QTY / % / SIZE

'Carmel Ceanothus'

55 SF / 100% / SOD

"California Meadow Sedge"

"California Meadow Sedge"

"California Meadow Sedge"

PLUGS PLANTS

"Seashore Paspalum"

323 / 100% /SOD

"Creeping Red Fescue"

"Beach Strawberry"

"Kurapia"

"Natal Plum'

GENERAL NOTES:

- 1. THE LANDSCAPE PLAN IS FOR GENERAL SITE REFERENCE ONLY. REFER TO OTHER CONSTRUCTION DOCUMENTS FOR COMPLETE SCOPE OF WORK
- 2. BEFORE COMMENCING ANY SITE EXCAVATION, VERIFY LOCATIONS OF ALL EXISTING SITE UTILITIES, INCLUDING WATER SEWER, GAS AND ELECTRICAL LINES. FLAG OR OTHERWISE MARK ALL LOCATIONS AND INDICATE UTILITY
- 3. GRADE SITE TO DIRECT GROUND WATER AWAY FROM BUILDING AND NEW ADDITIONS AND LANDSCAPE DRAINS SHALL BE INSTALLED AT LOW POINTS TO REDUCE RUNOFF CROSSING PATHS AND PAVING.
- 4. LOCATE REFUSE BIN AT APPROVED ON-SITE LOCATION. CONTRACTOR SHALL DISPOSE OF ALL SITE REFUSE AT
- 5. ALL REQUIRED PLANTING AREAS SHALL BE COVERED WITH MULCH TO A MINIMUM DEPTH OF
- 3 INCHES, EXCLUDING SLOPES REQUIRING REVEGETATION AND AREAS TO BE PLANTED WITH GROUND COVER. ALL EXPOSED SOIL AREAS WITHOUT VEGETATION SHALL ALSO BE MULCHED TO THIS MINIMUM DEPTH RED TREES SHALL HAVE AT LEAST ONE WELL DEFINED TRUNK AND SHALL NORMALLY ATTAIN A
- MATURE HEIGHT AND SPREAD OF AT LEAST 15 FEET. ALL PROPOSED STREET TREE PALMS SHALL HAVE A MINIMUM
- 7. PROPOSED LANDSCAPING SHALL NOT CONFLICT WITH EXISTING UTILITIES.
- JTILITIES SHALL NOT CONFLICT WITH PROPOSED LANDSCAPING
- PLANT MATERIAL SHALL BE SATISFACTORILY TREATED OR REPLACED PER THE CONDITIONS OF THE PERMIT
- LANDSCAPE IMPROVEMENTS IN THE RIGHT-OF WAY CONSISTENT WITH THE LA JOLLA SHORES PLANNED DISTRICT **ORDINANCE**
- 12. ALL LANDSCAPE AND IRRIGATION SHALL CONFORM TO THE CITY OF SAN DIEGO'S LAND DEVELOPMENT MANUAL, LANDSCAPE STANDARDS, THE LA JOLLA SHORES PLANNED DISTRICT STANDARDS, AND ALL OTHER CITY AND REGIONAL STANDARDS
- 13. ALL REQUIRED LANDSCAPE SHALL BE MAINTAINED IN A DISEASE, WEED AND LITTER FREE CONDITION AT ALL TIMES. SEVERE PRUNING OR "TOPPING" OF TREES IS NOT PERMITTED UNLESS SPECIFICALLY NOTED IN THIS
- 15. IF ANY REQUIRED LANDSCAPE (INCLUDING EXISTING OR NEW PLANTINGS, HARDSCAPE, LANDSCAPE DURING DEMOLITION OR CONSTRUCTION, IT SHALL BE REPAIRED AND/OR REPLACED IN KIND AND EQUIVALENT
- 16. PRIOR TO ISSUANCE OF ANY CONSTRUCTION PERMITS FOR STRUCTURES, THE OWNER PERMITTEE SHALL 'A', THE LA JOLLA SHORES PLANNED DISTRICT ORDINANCE, THE LA JOLLA COMMUNITY PLAN, AND THE LAND DEVELOPMENT MANUAL - LANDSCAPE STANDARDS
- 18. IF ANY REQUIRED LANDSCAPE (INCLUDING EXISTING OR NEW PLANTINGS, HARDSCAPE, LANDSCAPE FEATURES ETC.) INDICATED ON THE APPROVED CONSTRUCTION DOCUMENT PLAN IS DAMAGED OR REMOVED DURING DEMOLITION OR CONSTRUCTION, T SHALL BE REPAIRED AND/OR REPLACED IN KIND AND EQUIVALENT SIZE PER THE APPROVED DOCUMENTS TO THE SATISFACTION OF THE DEVELOPMENT SERVICES WITHIN 30 DAYS OF

IRRIGATION NOTE:

1. ALL PLANTING AREAS SHALL BE IRRIGATED BY A DEDICATED, BACKFLOW-PREVENTED IRRIGATION SYSTEM, ACCORDING TO PLANT TYPE AND ENVIRONMENTAL EXPOSURE AND SHALL RECEIVE UNIFORM WATER COVERAGE BY MEANS OF A HIGH EFFICIENCY, AUTOMATICALLY CONTROLLED, ELECTRICALLY ACTUATED, UNDERGROUND PIPED SPRINKLER SYSTEM. FOR WATER CONSERVATION AND TO MINIMIZE EROSION, STATE OF THE ART LOW PRECIPITATION RATE SPRINKLER EQUIPMENT SHALL BE USED. IRRIGATION MAINLINE PIPING SHALL BE PVC PLASTIC (TYPE 1120) CLASS 315 PRESSURE PIPE AND LATERAL LINE PIPING SHALL BE SCHEDULE 40 NON-PRESSURE PIPE. PRESSURE LINES SHALL BE INSTALLED 18" DEEP, NON-PRESSURE LINES 12" DEEP. A MASTER VALVE AND FLOW SENSOR SHALL BE INSTALLED TO MINIMIZE DAMAGE IN THE CASE OF A VALVE FAILURE OR MAINLINE BREAK. A SEPARATE HOSE BIB MAINLINE SHALL BE INSTALLED UPSTREAM OF THE MASTER VALVE AND EACH HOSE BIB SHALL BE FITTED WITH AN ATMOSPHERIC VACUUM BREAKER.

_2_ALL PROPOSED IRRIGATION SYSTEMS WILL USE AN APPROVED RAIN SENSOR SHUTOFF DEVICE. 3. EXISTING STREET TREES LOCATED IN THE PUBLIC RIGHT-OF-WAY SHALL BE IRRIGATED BY A HOMEOWNER-FUNDED AND MAINTAINED, DEEP-WATERING, LOW-VOLUME BUBBLER.

LANDSCAPE PLAN

1. THE DRAINAGE SYSTEM FOR THIS PROJECT SHALL BE PRIVATE AND WILL BE SUBJECT TO APPROVAL BY THE CITY ENGINEER. 2. ALL DEVELOPMENT SHALL BE CONDUCTED TO PREVENT EROSION AND STOP

SEDIMENT AND POLLUTANTS FROM LEAVING THE PROPERTY TO THE MAXIMUM EXTENT PRACTICABLE 3. ALL ROOF DRAINS AND FLATWORK SHALL DRAIN POSITIVELY INTO STORM

DRAINAGE SYSTEM. SURFACE RUNOFF SHALL NOT DRAIN DIRECTLY INTO THE ADJOINING PROPERTY, AND CONSTRUCTION RUNOFF MAY NOT DRAIN INTO THE STORMWATER CONVEYANCE SYSTEM

DRAINAGE NOTES:

1. A BRIGHT YELLOW OR ORANGE TEMPORARY FENCE WILL BE PLACED AROUND EXISTING TREES AT THE DRIP LINE. 2. STOCKPILING, TOPSOIL DISTURBANCE, VEHICLE USE, AND MATERIAL

STORAGE OF ANY KIND IS PROHIBITED WITHIN THE DRIPLINE. 3. A TREE WATERING SCHEDULE WILL BE MAINTAINED AND DOCUMENTED DURING CONSTRUCTION.

EXISTING TREE NOTES:

EXISTING TREES TO REMAIN ON SITE WITHIN THE AREA OF WORK WILL BE PROTECTED IN PLACE. THE FOLLOWING PROTECTION MEASURES WILL BE PROVIDED:

4. ALL DAMAGED TREES WILL BE REPLACED WITH ONE OF EQUAL OR GREATER SIZE.

DEVELOPMENT 9-21-2018


Ш

S

V

ANDSCAF VELOPME PLAN

120F13 =

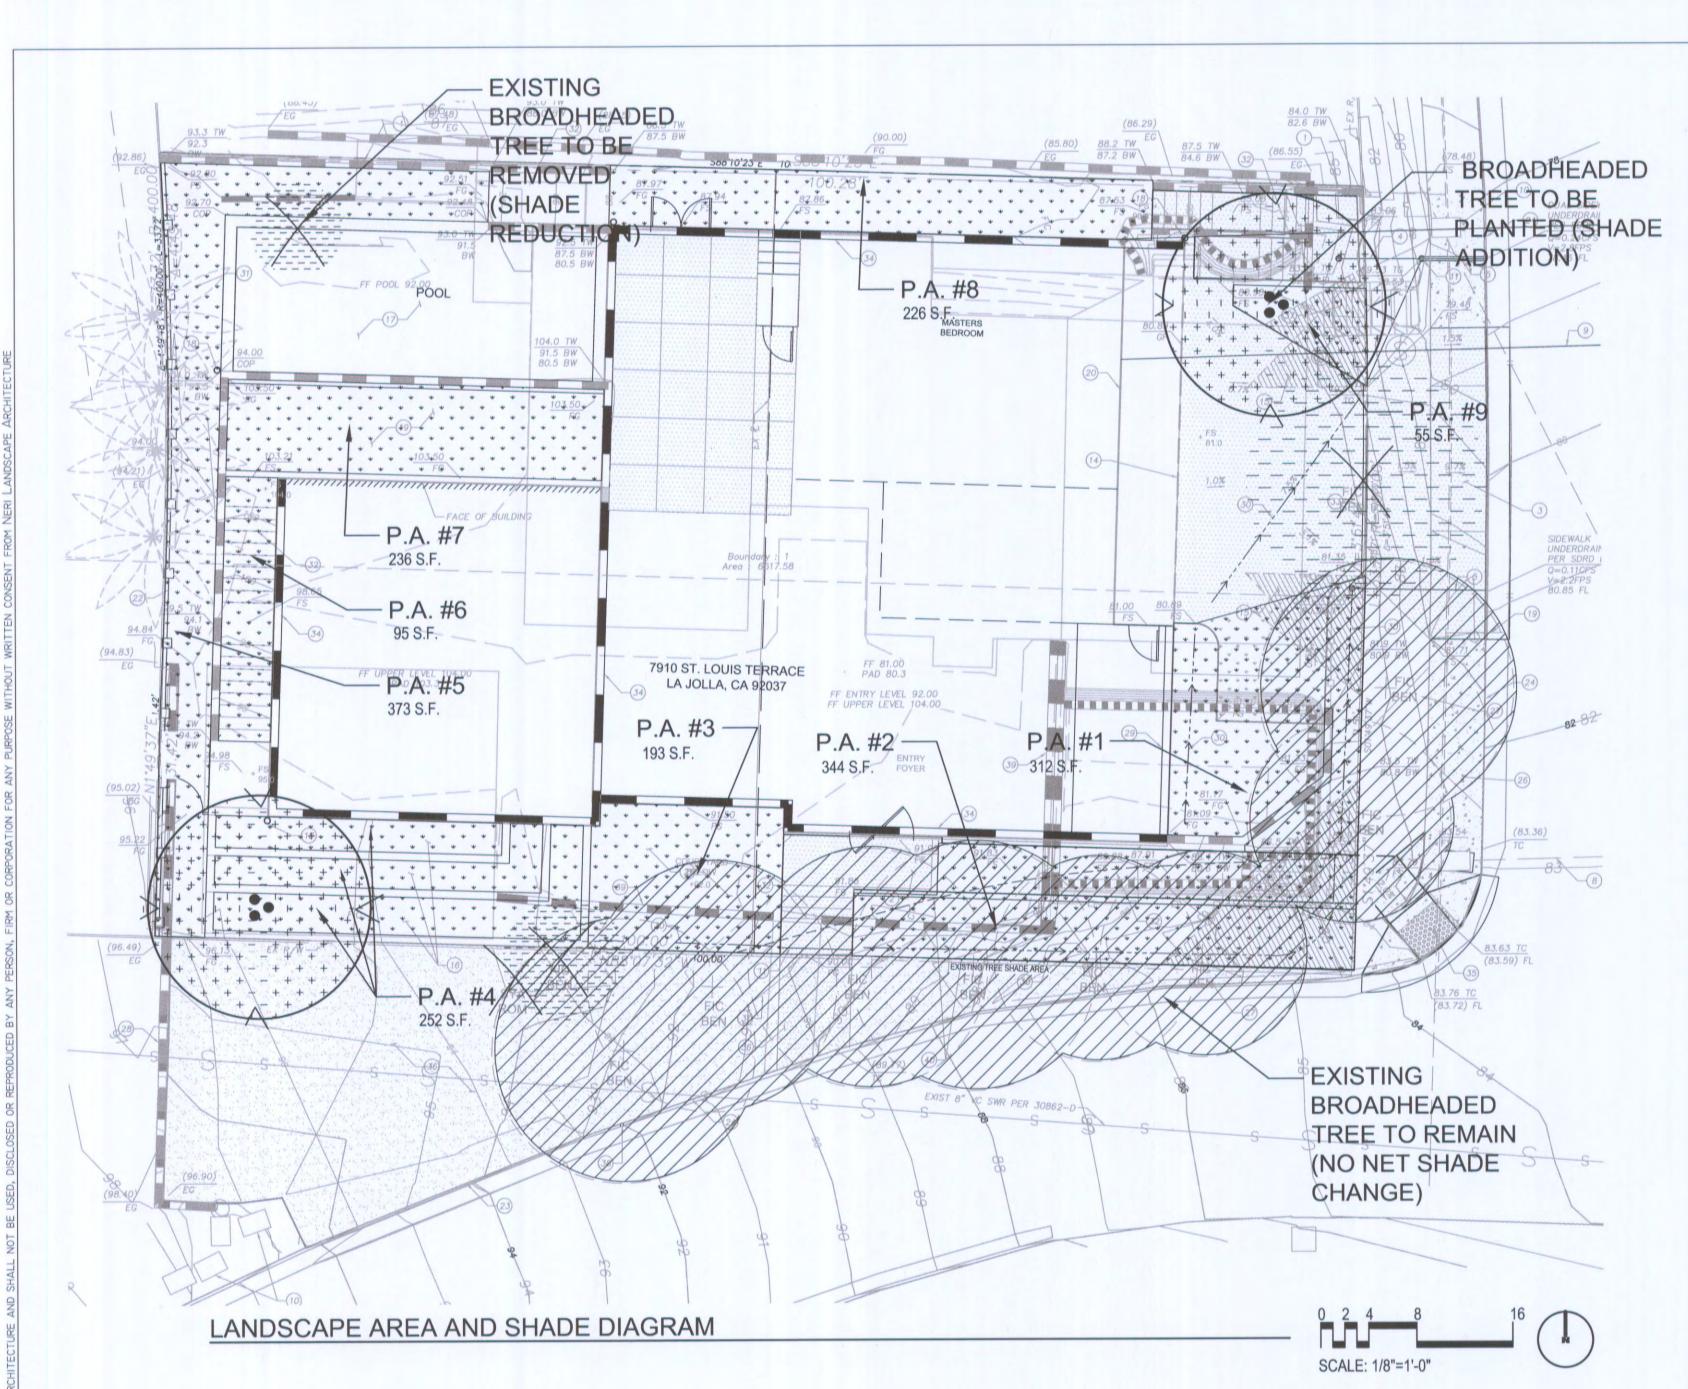

LA JOLLA SHORES PLANNED DISTRICT ORDINANCE LANDSCAPE CALCULATIONS:

MULTI FAMILY LANDSCAPE REQUIREMENTS: LA JOLLA SHORES PLANNED DISTRICT ORDINANCE ALL OF THE LANDSCAPE TO MEET THE 30% AREA REQUIREMENT SHALL BE INSTALLED AS REQUIRED BY THE LA JOLLA SHORES PLANNED DISTRICT ORDINANCE [LDC 1510.0306(G)].

TOTAL PARCEL AREA: PLANTING AREA REQUIRED: 1,950 S.F. (30%)

PLANTING AREA PROVIDED: EXCESS AREA PROVIDED:

2,086 S.F. (32.09%)

CITY OF SAN DIEGO CLIMATE ACTION PLAN NET CANOPY TREE GAIN:

EXISTING SHADE AREA: 2,247 SQ. FT. SHADE REDUCTION AREA: 504 SQ. FT

SHADE INCREASE AREA: 540 SQ. FT. 36 SQ. FT.

1.6% NET AREA INCREASE OF CANOPY TREE SHADE PROVIDED ASSOCIATED WITH THE PROJECT SITE.

LANDSCAPE AREA

LANDOOM	
PLANTING AREA (P.A.) #	S.F.
1	312
2	344
3	193
4	252
5	373
6	95
7	236
8	226
9	55
TOTAL	2,086 SF

ST LOUIS TERRACE Project: 9/21/2017 Date: NLA

MAXIMUM APPIED WATER ALLOWANCE (MAWA)

 $MAWA = ETo \times 0.62 \times [ETAF \times (LA+SLA)] + [(1 - ETAF) \times SLA]$

MAWA = Maximum Applied Water Allowance (gallons per year)

ETo = Evapotranspiration Rate (inches per year)

0.62 = Conversion factor to gallons per square foot ETAF = ET Adjustment Factor, 0.55 for Residential, 0.45 for Non-residential, 0.65 for Public Schools

36,609

LA = Total Landscape Area, including Special Landscape Area (square feet)

SLA = Special Landscape Area (square feet)

ETo = ETAF = 2,391 LA = SLA =

ESTIMATED TOTAL WATER USE (ETWU)

STATE: ETWU = (Eto)(0.62)(ETAF)(HA)CITY OF SAN DIEGO = $(Eto)(0.62)[(PF \times HA/IE) + SLA]$

ETo =

MAWA =

ETWU = Estimated Total Water Use (gallons per year)

ETo = Evapotranspiration Rate (inches per year) 0.62 = Conversion factor to gallons per square foot

ETAF = ET Adjustment Factor = PF / IE HA (Area) = Hydrozone Area (square feet)

PF = Plant Factor, Very Low Water (VLW) Use = 0 - 0.1, Low Water (LW) Use = 0.1 - 0.3, Medium Water (MW) Use = 0.4 - 0.6, High Water (HW) Use = 0.7 - 1.0)

IE = Irrigation Efficiency, Drip = 0.81, Spray = 0.75

REGULAR LANDSCAPE AREAS

REGULAR LANDSCAPE AREAS											
CONTROLLER	HYDROZONE (VALVE) NO.	HYDROZONE (VALVE) DESCRIPTION	PLANT TYPE	PF	IRRGATION METHOD		ETAF	HA (SF)	% TOTAL LANDSCAPE	ETAF X HA	(GAL/YR)
Α	1	ORNAMENTAL PLANTING	LOW	0.1	DRIP	0.81	0.123	190	7.9%	23.457	582
	2	SOD	MEDIUM	0.4	DRIP	0.81	0.494	92	3.8%	45.432	1,127
	3	ORNAMENTAL PLANTING	LOW	0.1	DRIP	0.81	0.123	208	8.7%	25.679	637
	4	ORNAMENTAL PLANTING	LOW	0.1	DRIP	0.81	0.123	132	5.5%	16.296	404
	5	ORNAMENTAL PLANTING	MEDIUM	0.4	DRIP	0.81	0.494	170	7.1%	83.951	2,082
	6	TERRACE PLANTING	LOW	0.1	DRIP	0.81	0.123	237	9.9%	29.259	726
	7	ORNAMENTAL PLANTING	MEDIUM	0.4	DRIP	0.81	0.494	218	9.1%	107.654	2,670
	8	SOD	MEDIUM	0.4	DRIP	0.81	0.494	224	9.4%	110.617	2,743
	9	ORNAMENTAL PLANTING	MEDIUM	0.4	DRIP	0.81	0.494	237	9.9%	117.037	2,903
	10	HEDGE	LOW	0.1	DRIP	0.81	0.123	271	11.3%	33.457	830
	11	BIORETENTION	MEDIUM	0.4	DRIP	0.81	0.494	54	2.3%	26.667	661
			REC	GULAR L	ANDSCAPE A	REA TO	= JATC	2,033	85.0%	619.5	15,364
		AVERAGE ETAF FOR REGULAR	LANDSCAPE AREAS ¹ =	TOTAL	(ETAF X HA)	TOTA	LHA =	0.30			

Average ETAF for Regular Landscape Areas shall be a maximum of 0.55 for Residential and 0.45 for non-residential, 0.65 for public schools

SPECIAL LANDSCAPE AREAS

% TOTAL ETWU (GAL/YR) HYDROZONE (VALVE) NO. PLANT TYPE PF METHOD IE ETAF HA (SF) LANDSCAPE ETAF x HA CONTROLLER POOL 8,878 0.0 358.0 8,878

AVERAGE ETAF FOR ENTIRE SITE = TOTAL (SPECIAL AND REG.) ETAF X HA / SPECIAL AND REG. TOTAL HA = 0.41

ESTIMATED TOTAL WATER USE (ETWU) = 24,242 MAXIMUM APPLIED WATER ALLOWANCE (MAWA) = 36,609 ETWU < MAWA = YES

MAWA NOTE:

THE APPLICANT AGREES TO COMPLY WITH THE REQUIREMENTS OF THE PRESCRIPTIVE COMPLIANCE OPTION TO THE MODEL WATER EFFICIENT LANDSCAPE ORDINANCE (MWELO) IN ACCORDANCE WITH STATE LAW AND LAND DEVELOPMENT CODE SECTION 142.0413(H), AND WILL PROVIDE THE COMPLETION, CERTIFICATE OF INSTALLATION, IRRIGATION SCHEDULE, AND SCHEDULE OF LANDSCAPE AND IRRIGATION MAINTENANCE.

LANDSCAPE DESIGN COMPLIANCE STATEMENT

I HAVE COMPLIED WITH THE CRITERIA OF THE ORDINANCE AND APPLIED THEM FOR THE EFFICIENT USE OF WATER IN THE LANDSCAPE DESIGN PLAN

NERI LANDSCAPE ARCHITECTURE LICENSED LANDSCAPE ARCHITECT, RLA#3321

HYDROZONE DIAGRAM



LANDSCAPE DEVELOPMENT PLAN 9-21-2018

SID