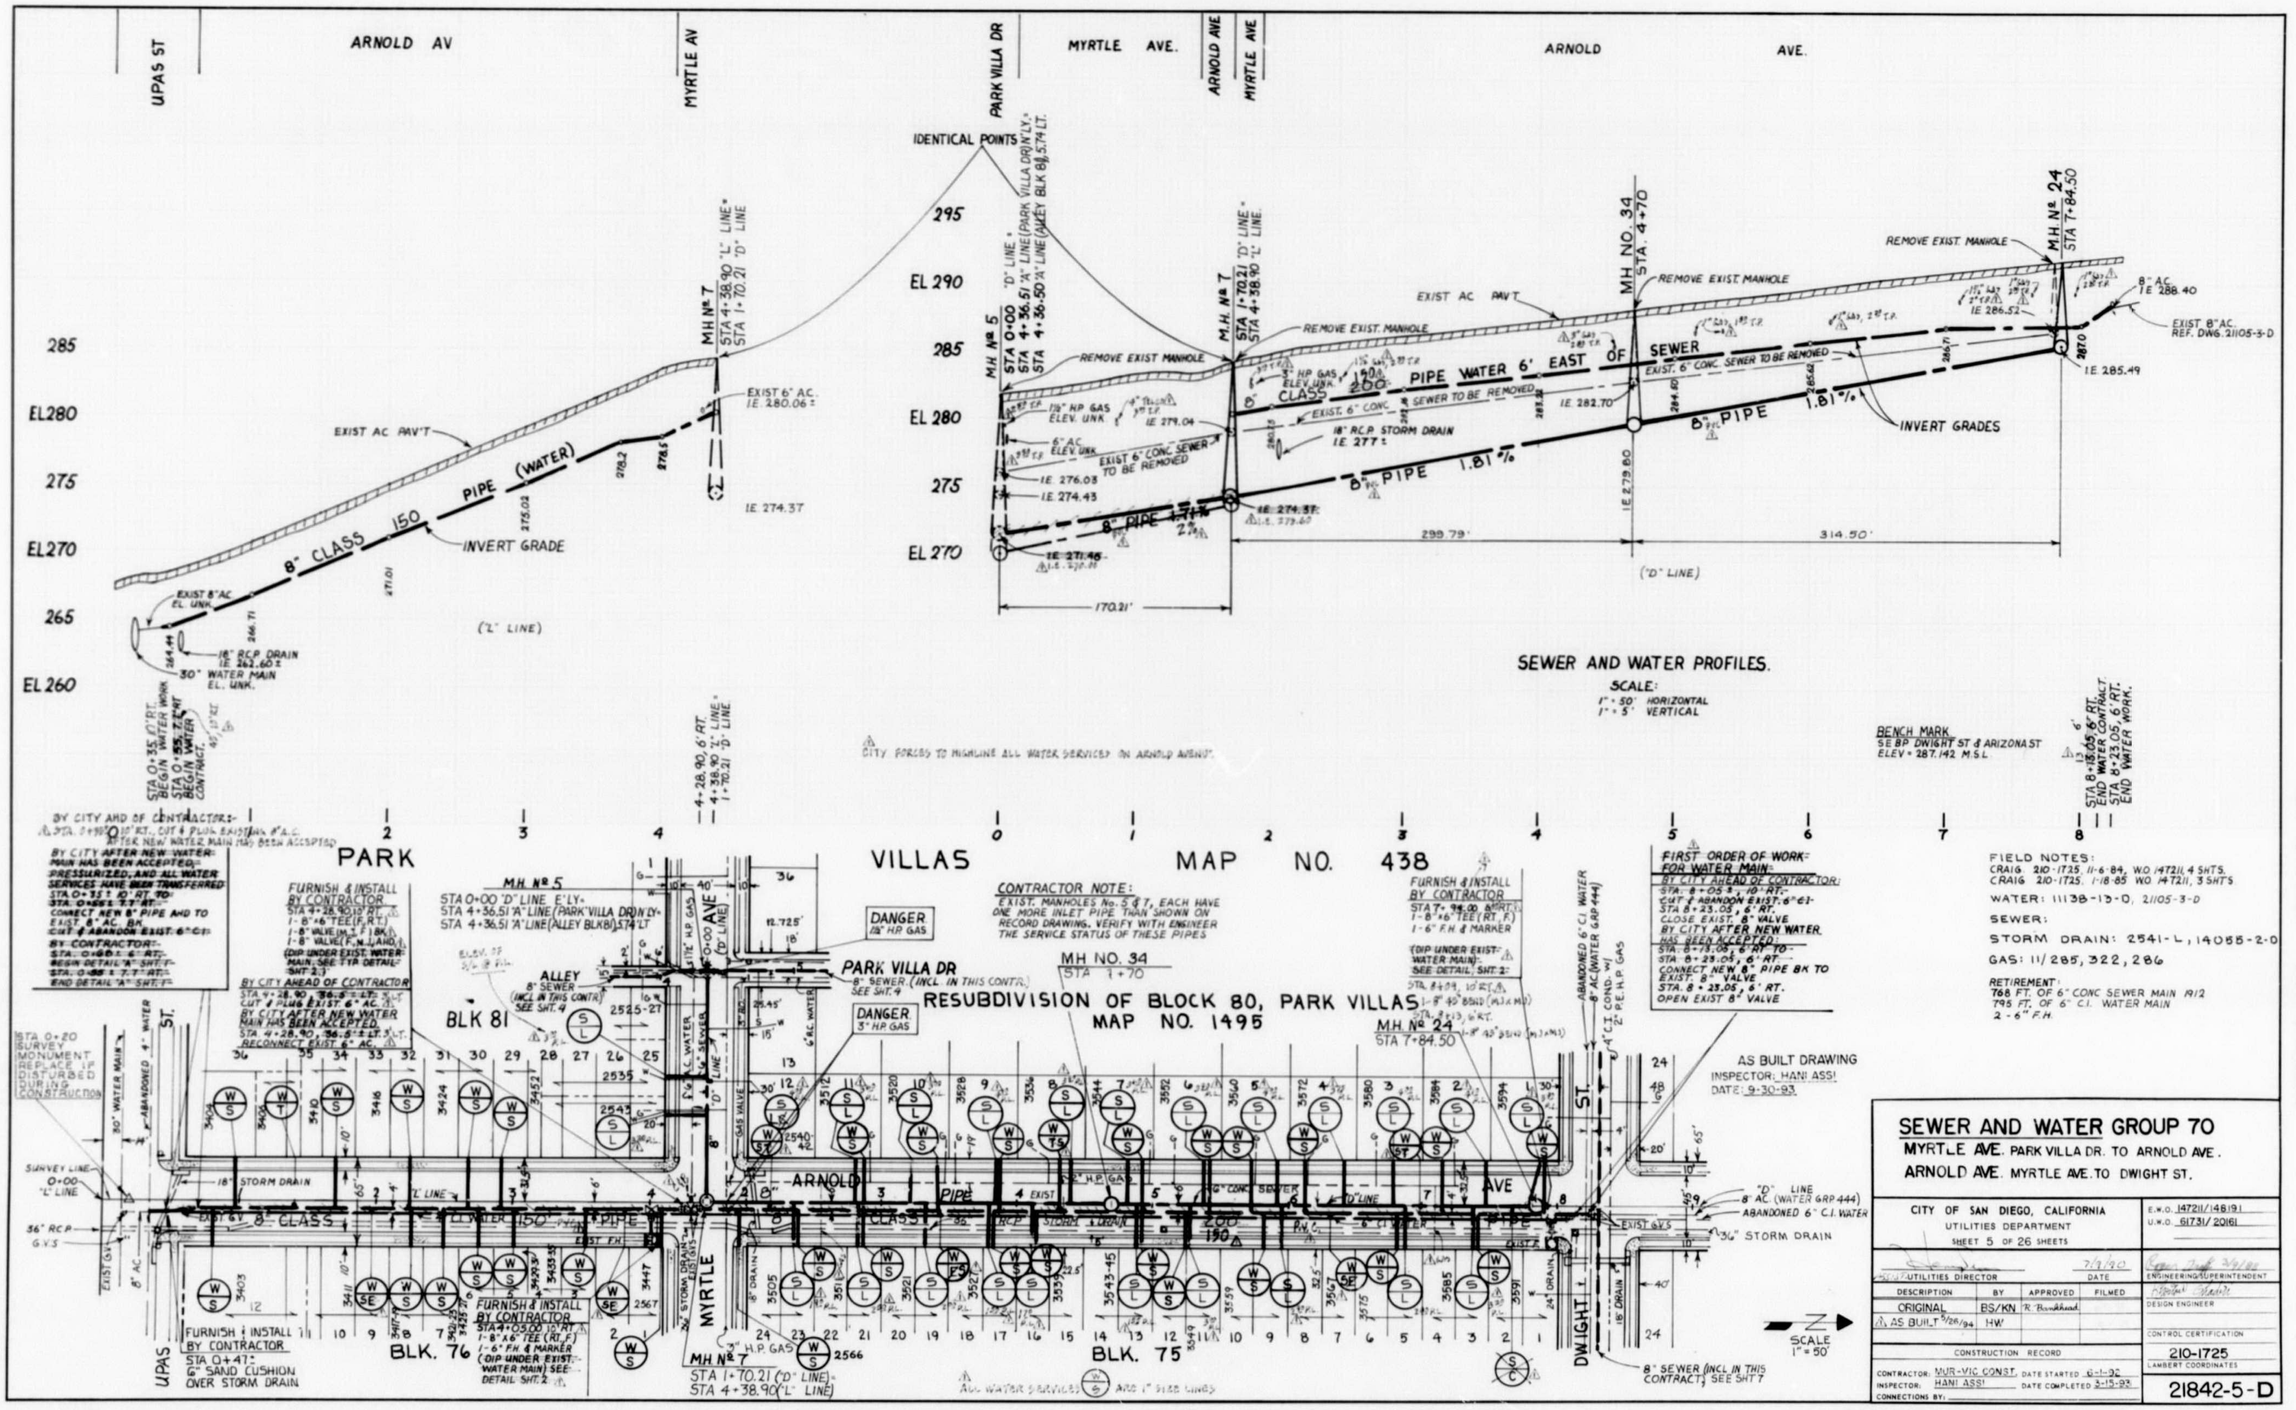

SEWER AND WATER GROUP 70

MYRTLE AVE. PARK VILLA DR. TO ARNOLD AVE.
ARNOLD AVE. MYRTLE AVE. TO DWIGHT ST.

CITY OF SAN DIEGO, CALIFORNIA
UTILITIES DEPARTMENT
SHEET 5 OF 26 SHEETS

E.W.O. 14721/14819
U.W.O. 61731/20161

7/9/90
UTILITIES DIRECTOR — DATE

ENGINEERING/SUPERINTENDENT

DESCRIPTION	BY	APPROVED	FILMED
ORIGINAL	BS/KN	R. Bradstreet	
AS BUILT 9/28/94	HW		

DESIGN ENGINEER

CONSTRUCTION RECORD

CONTROL CERTIFICATION

CONTRACTOR: MUR-VIC CONST. DATE STARTED 6-1-92
INSPECTOR: HANI ASSI DATE COMPLETED 2-15-93
CONNECTIONS BY:

210-1725
LAMBERT COORDINATES

21842-5-D

AS BUILT