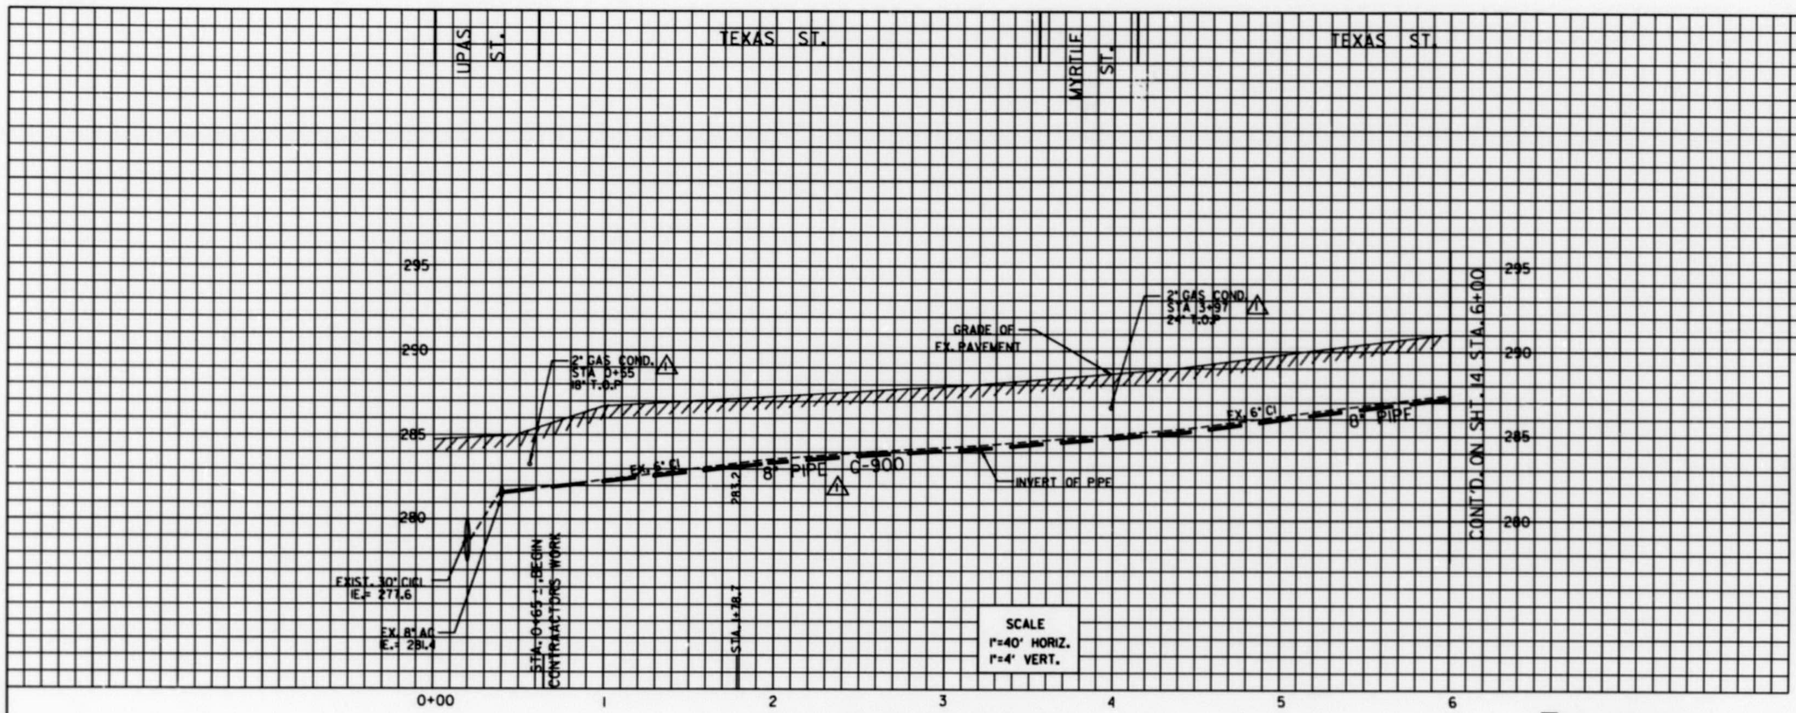


| COORDINATE TABLE | | | |
|---|---|---|---|
| NO. | NORTHING | EASTING | DESCRIPTION |
| 740 | N247799.24 | E1756287.20 | 8" TEE, FH ASSY. |
| 741 | N247813.57 | E1755935.72 | STA. 0+00 |
| 742 | N247813.27 | E1755965.72 | ℄ INTERSECTION |
| 743 | N247802.94 | E1755975.61 | CUT & PLUG |

| PROPOSED PIPE DATA TABLE | | | | |
|---|---|---|---|---|
| NO. | △/BEARING | RADIUS | LENGTH | REMARKS |
| 1 | N89° 15'42"W | | 10' | CITY FORCES |
| 2 | N89° 15'42"W | | 535' | 8" CLASS 150 |

NOTE:

TEXAS ST. SHALL BE HIGHLINED BY CITY FORCES PRIOR TO BEGINNING OF CONSTRUCTION. CITY TO FURNISH HIGHLINING MATERIAL AND MAKE ALL CONNECTIONS.

SEE SHEET 21 FOR SEWER LINE ON TEXAS STREET

GAS

STA 1+08 ¾" Cu. 36" T.O.P
STA 1+38 1" Cu. 36" T.O.P
STA 1+86 ¾" Cu. 29" T.O.P
STA 1+95 ¾" Cu. 30" T.O.P
STA 2+25 ¾" Cu. 26" T.O.P
STA 2+87 ¾" Cu. 30" T.O.P
STA 3+29 ¾" Cu. 30" T.O.P
STA 3+55 ¾" Cu. 26" T.O.P
STA 4+02 1" Cu. 36" T.O.P
STA 4+57 1" Cu. 30" T.O.P
STA 5+02 1" Cu. 36" T.O.P
STA 5+34 ¾" Cu. 30" T.O.P
STA 6+00 1" Cu. 36" T.O.P

STA 1+09 ¾" Cu. 20" T.O.P
STA 1+30 ¾" Cu.
STA 2+04 ¾" Cu. 30" T.O.P
STA 2+05 ¾" Cu. 30" T.O.P
STA 2+66 1" Cu. 36" T.O.P
STA 3+06 ¾" Cu. 20" T.O.P
STA 3+50 F.H. ASS., 6" P.V.C
STA 4+64 1" P.V.C. 28" T.O.P
STA 5+05 1" Cu. 36" T.O.P
STA 5+52 1" P.V.C. 30" T.O.P
STA 5+88 1" P.V.C. 36" T.O.P

EXIST. 1¼" P.C. H.P. 2" COND
EXIST. 8" AC
EXIST. 2" HP
EXIST. 6" CONC
EXIST. 6" CI
8" PIPE
MYRTLE AVE.
TEXAS ST.
CONT'D. ON SHT. 14, STA. 6+00

(1) BY CITY FORCES
AHEAD OF CONTRACTOR STA. 0+40 ± , 11'RT. CUT & PLUG RECONNECT AFTER NEW MAIN HAS BEEN ACCEPTED

(2) BY CITY FORCES
STA. 0+55 ± , 11'RT. REMOVE EXIST. 8"X4" RED. AHEAD REMOVE EXIST. 4" VALVE AHEAD 15' FURNISH AND INSTALL 18" VALVE (MJ,MJ) AHD. AFTER NEW MAIN HAS BEEN ACCEPTED CONNECT TO NEW 8" VALVE

(3) BY CONTRACTOR
STA. 3+50 ± , 11'RT. FURNISH & INSTALL 1- 8" X 6" TEE ( MJ, F, F ) 1- FH ASSEMBLY ( STD. W-10 ) 1- 8" VALVE AHEAD ( F, MJ )

(4) BY CONTRACTOR
STA. 4+14 ± , 11'RT. REMOVE EXIST. VALVE

DETAIL
SCALE : NONE
EXIST. 30" CI
EXIST. 4" CI
EXIST. 4" CI
NEW 8" PIPE
EXIST. 8" AC

SCALE 1" = 40'

REFERENCE:

BENCH MARK: SWBP PARK BLVD. & UNIVERSITY AVE. EL.= 321.89' MSL

FIELD NOTES: HOLT 12-21-90, 208-1725, WO 181651

WATER: 14432-9-D, 14432-10,D

SEWER:

STORM DRAIN: 21525-1-D

GAS: 11-338, 11-391, 11-270, 11-283 11-323

TELEPHONE:

WATER GATE BOOK: H-19
SEWER GATE BOOK: H-19

100' SCALE: 210-1722, 210-1725

THOMAS BROS.: 60, D, E-4

RETIREMENT:

545' OF EX. 6" CI, YR. FB. 1992

WATER AND SEWER GROUP 510
LEAD SERVICE REPLACEMENT
TEXAS STREET
UPAS ST. TO STA. 6+00

CITY OF SAN DIEGO, CALIFORNIA
UTILITIES DEPARTMENT
SHEET 13 OF 63 SHEETS

WATER W.O. 181651
SEWER W.O. 172561

UTILITIES DIRECTOR — DATE 7-22-92 — DEPUTY DIRECTOR

| DESCRIPTION | BY | APPROVED | DATE | FILMED |
|---|---|---|---|---|
| ORIGINAL | W.J.S./CDC | Torabi | 7/21/92 | Dec. 21, 1992 |
| ⚠ AS-BUILT PER CITY INSPECTOR | FM | | 4-9-96 | |

DESIGN ENGINEER

CONTROL CERTIFICATION
210-1725
LAMBERT COORDINATES
26328-13-D

CONTRACTOR DETROIT CORP. DATE STARTED 5-03-93
INSPECTOR CARLEEN GRANTHAM DATE COMPLETED 12-17-93

TEXAS STREET

AS-BUILT

FILMED FROM THE ORIGINAL ,BEST QUALITY OBTAINABLE,EXCESSIVE GRAY BACKGROUND MAY CAUSE A POOR QUALITY REPRODUCTION

0 1 2 3 4IN.