149
182

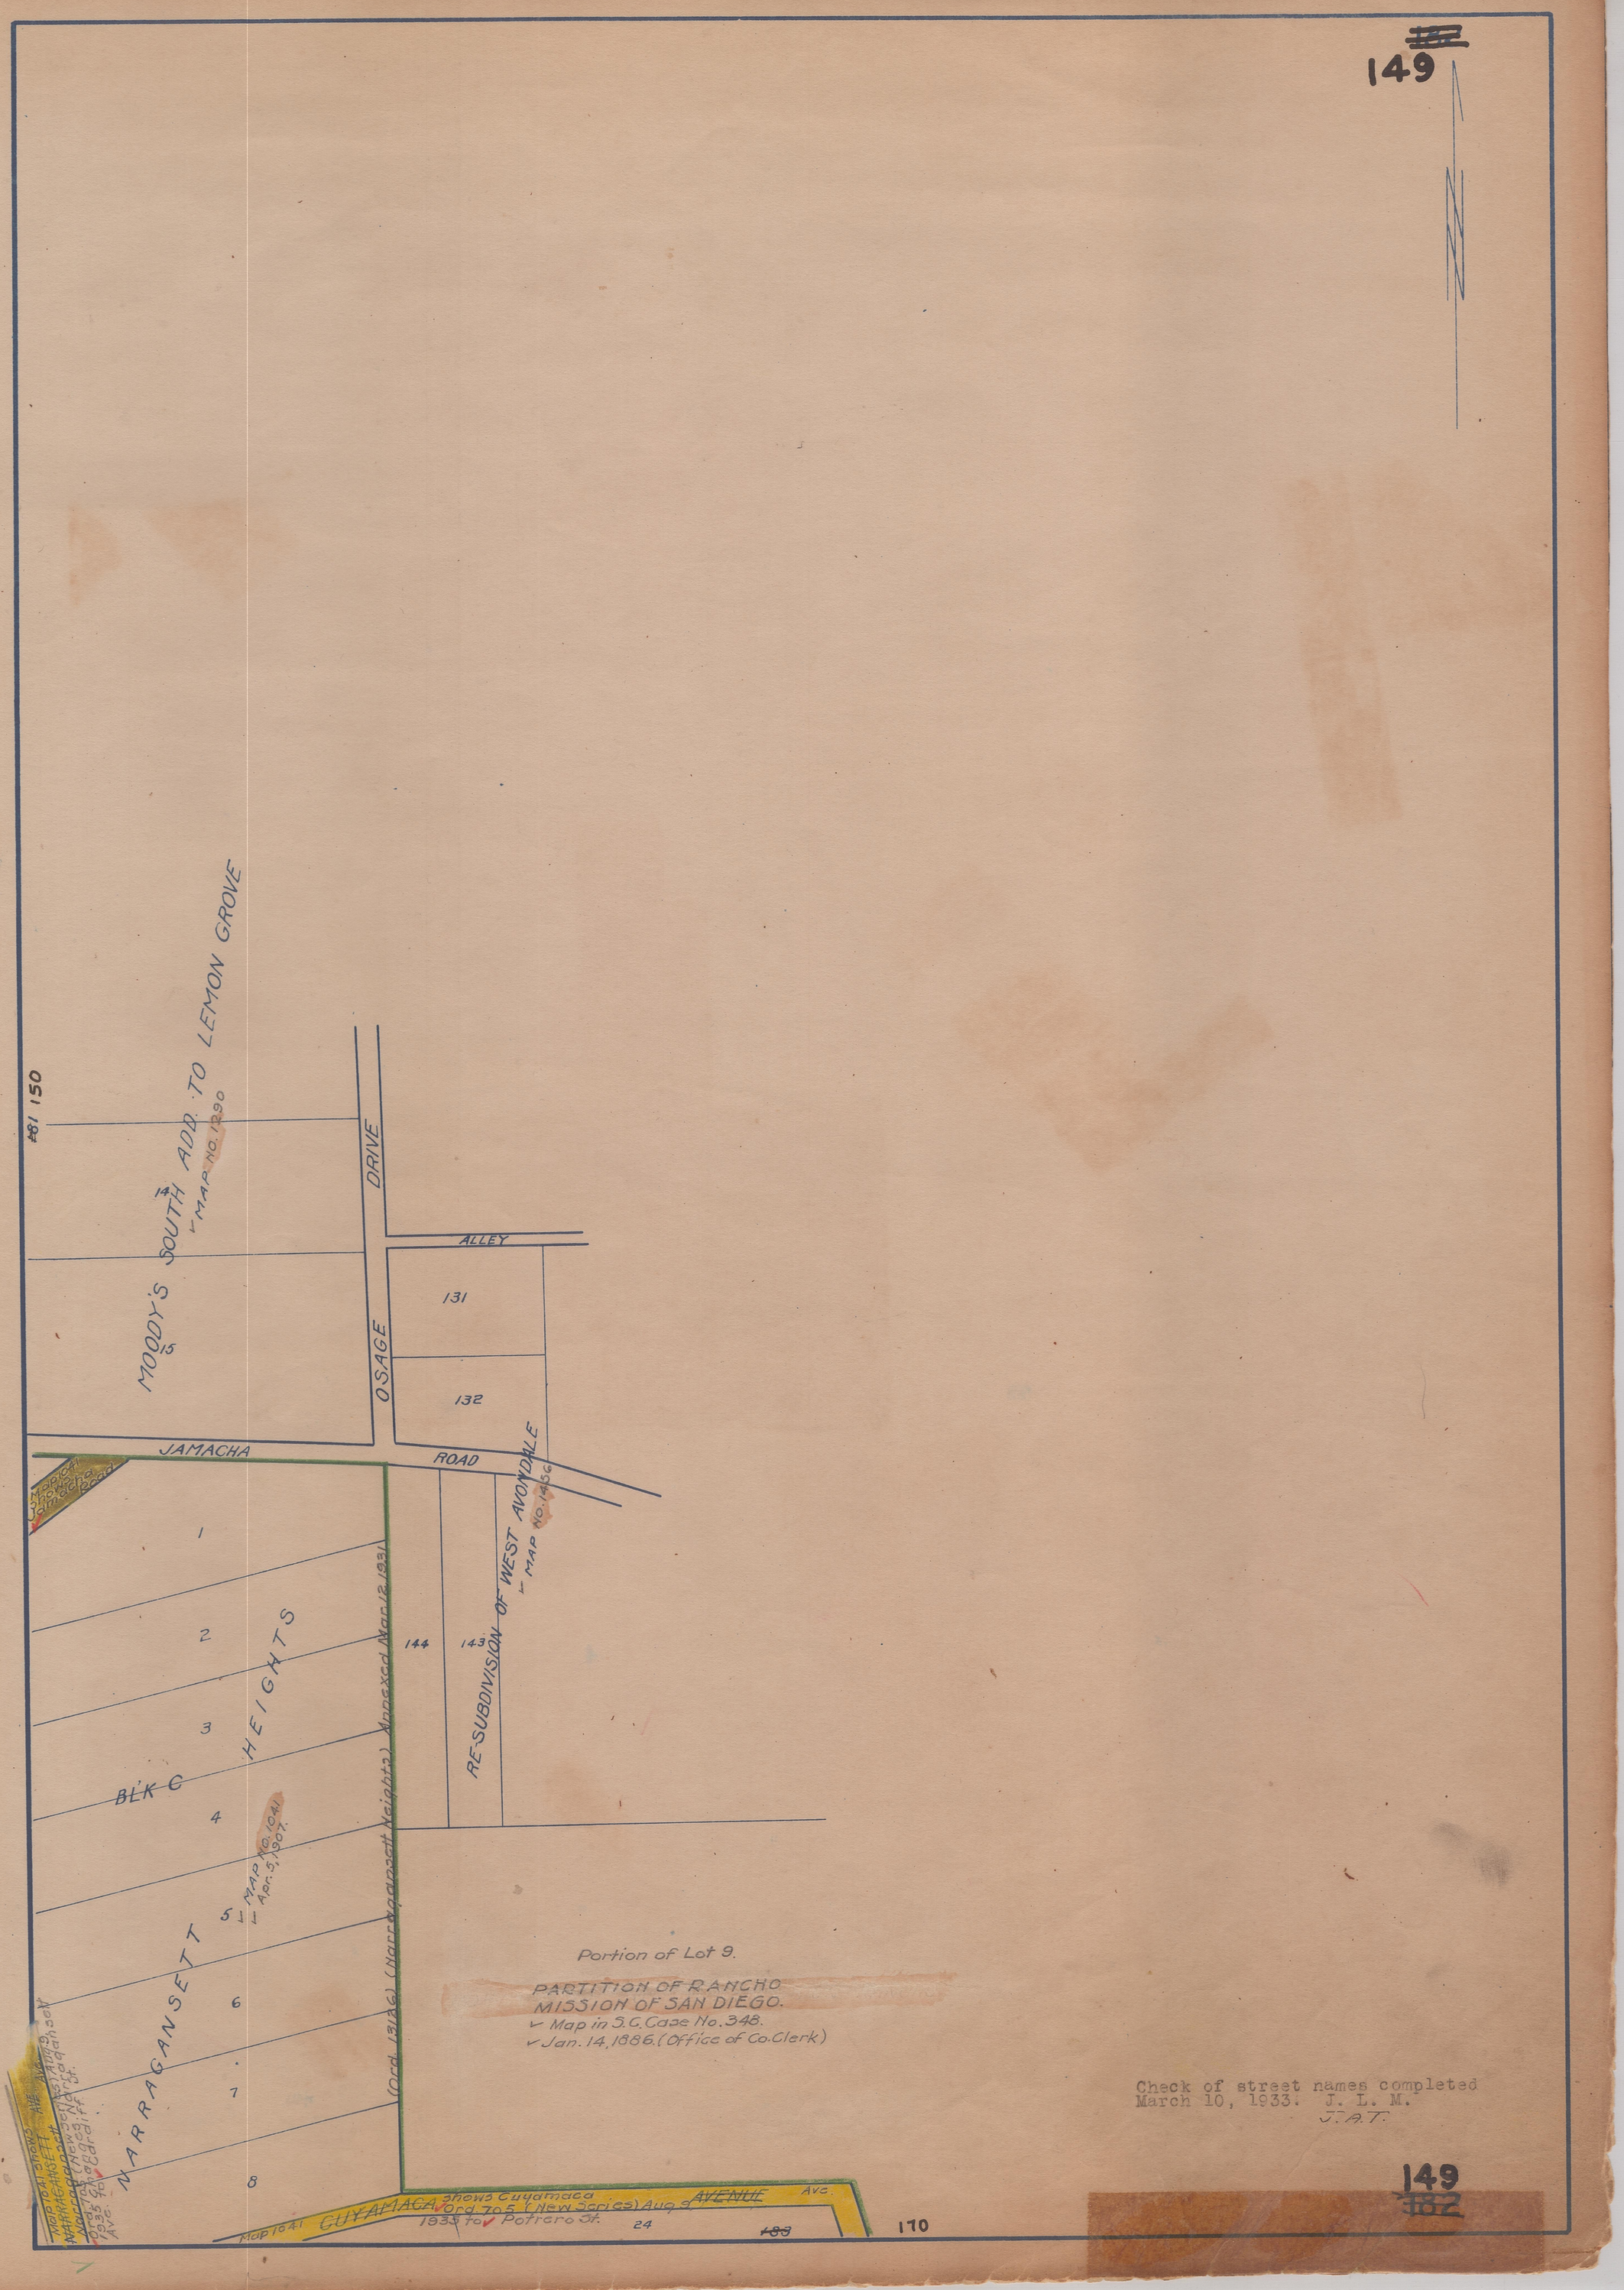

Portion of Lot 9.

PARTITION OF RANCHO
MISSION OF SAN DIEGO.
Map in S.C. Case No. 348.
Jan. 14, 1886. (Office of Co. Clerk)

Check of street names completed
March 10, 1933. J. L. M.
J.A.T.

149
182

150

LANSING DRIVE

KOE ST

GLENCOE DRIVE.

STREET

Reserved Future St.

GROVE HEIGHTS UNIT NO. 2 MAP NO. 3473

BRADDOCK STREET

BRADDOCK ST.

BRENNAN ST.

GROVE HEIGHTS UNIT NO. 1 MAP NO. 3472

Ord. 6561 (NS) 4-21-54

MONTEREY HT'S. ✓ MAP NO. 1966.

COLFAX DRIVE

NARRAGANSETT AVE.

MOODY'S SOUTH ADD. TO LEMON GROVE 75 ✓ MAP NO. 1290.

CARLISLE DRIVE

Annexed Mar. 12, 1931.

Closing 848 d.H. 1/22/57

Union Trust Co. of San Diego. to County of San Diego. Dec. 23, 1926. Rec. Apr. 7, 1927. 1344/162

Res. of Board of Co. Supervisors passed and approved Apr. 4, 1927 names Narragansett Ave.

LOMITA VILLAGE #1 RESUBDIVISION #1 MAP NO. ROS 5945

Lomita Village Unit 5 Map 2998

BL'K B

BL'K C

BL'K D

NARRAGANSETT ROAD

Ord. 5405 (N.S.) Dec. 3, 1952 names Glencoe Drive

Map 1494 shows Jamacha Road

Map 1494 shows Glencoe Drive

Ord. 704 (New Series) Aug. 2, 1935. County Road names Jamacha Road

Portion of Jamacha Road closed by SCC. 18250 June 11, 1953. Recorded in Book 4690, page 425, O.R., June 15, 1953. (Closing 780)

Map 1494 shows Jamacha Road

Map 1494 shows Section Jamacha Road

LINCOLN ANGELUS PLACE HEIGHTS ✓ MAP NO. 1494

SUBDIVISION NO. 5 IN EX-MISSION LOT NO. 12 OF THE EX MISSION RANCHO ✓ Licensed Survey No. 63. ✓ Sept. 6, 1894.

Check of street names completed March 10, 1933. J. L. M. J.A.T.

150 151

169

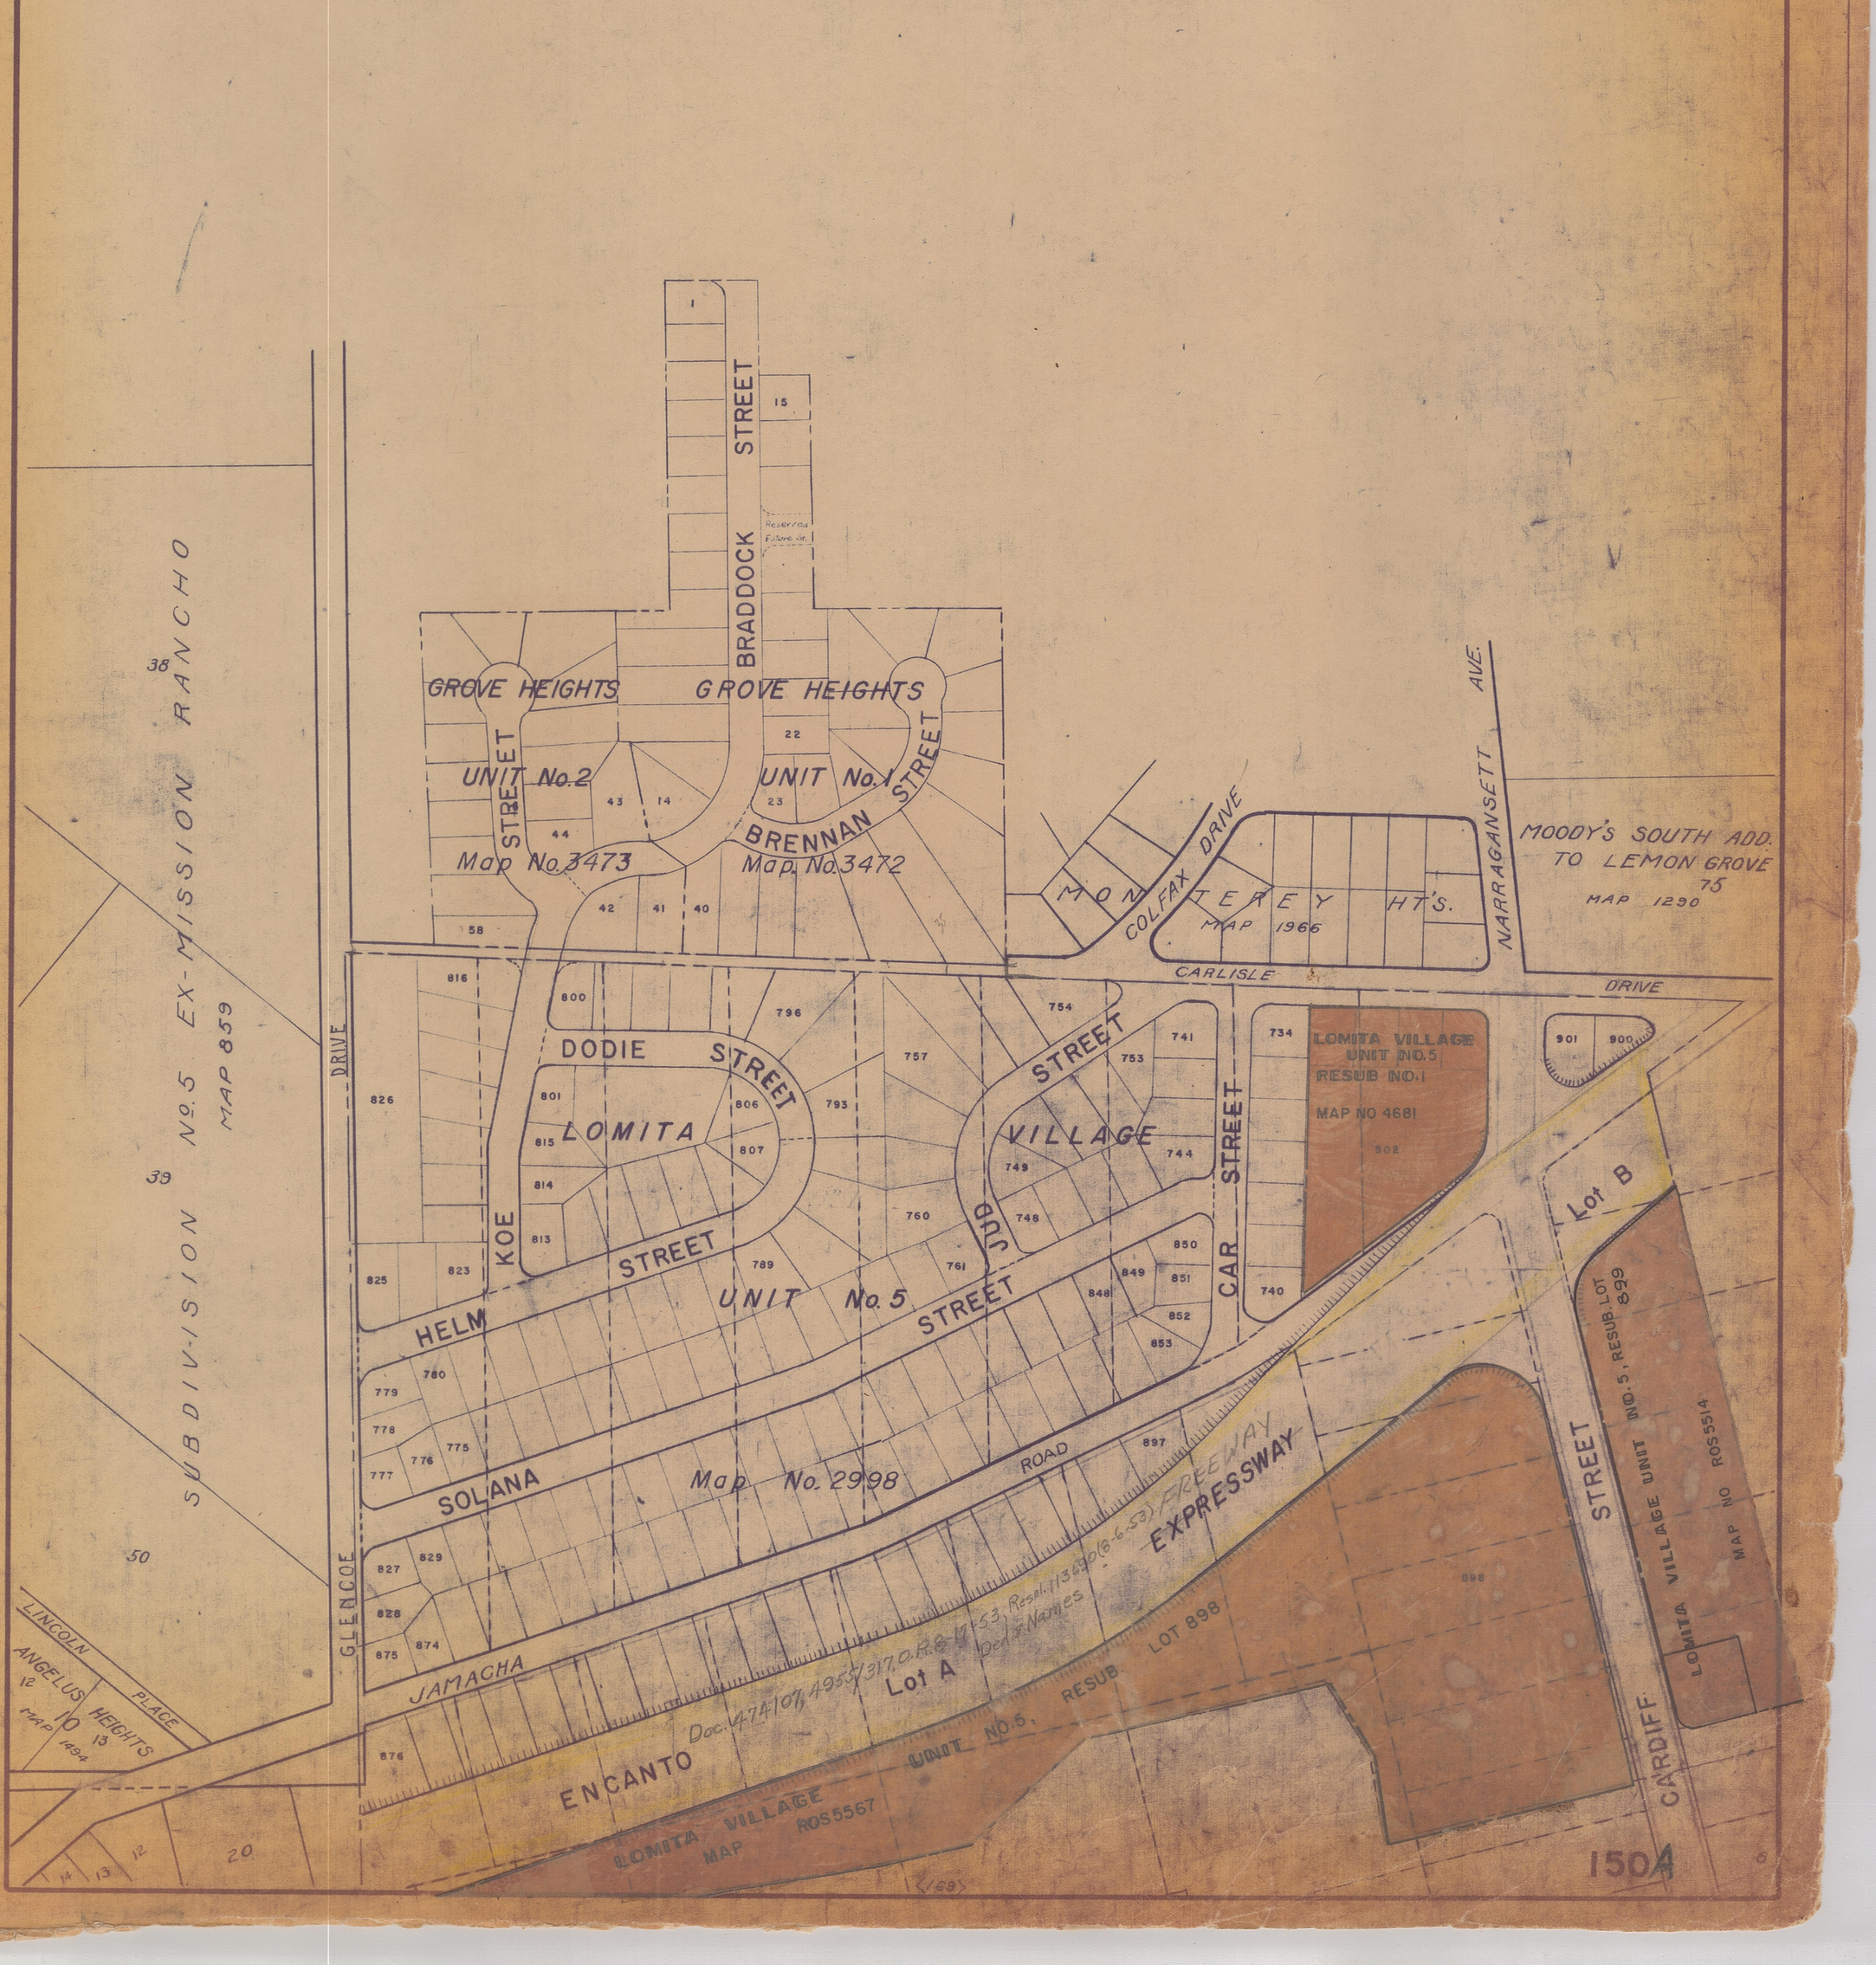
RANCHO
38
SUBDIVISION No.5 EX-MISSION
MAP 859
39
50
BRADDOCK STREET
15
Reserved Future St.
GROVE HEIGHTS
GROVE HEIGHTS
UNIT No.2
UNIT No.1
STREET
BRENNAN STREET
Map No.3473
Map No.3472
22
23
43
14
44
42
41
40
58
MONTEREY HT'S.
MAP 1966
COLFAX DRIVE
NARRAGANSETT
MOODY'S SOUTH ADD. TO LEMON GROVE
MAP 1290
75
CARLISLE DRIVE
816
800
796
754
757
741
753
734
LOMITA VILLAGE UNIT NO.5 RESUB NO.1
MAP NO 4681
902
901
900
826
801
806
793
815
LOMITA
807
VILLAGE
744
749
814
760
748
813
825
823
789
761
850
849
851
848
852
853
740
DODIE STREET
HELM STREET
KOE
JUD
CAR STREET
UNIT No.5
779
780
778
777
776
775
SOLANA
Map No. 2998
ROAD
897
827
829
828
875
874
JAMACHA
Doc. 47407, 4955, 317 O.R. 8-17-53, Resol. 113696 (6-6-53) FREEWAY
EXPRESSWAY
Lot A
Lot B
898
LOT 898
UNIT NO.5, RESUB.
LOMITA VILLAGE UNIT NO.5, RESUB. LOT 899
MAP NO ROS5514
STREET
CARDIFF
876
ENCANTO
LOMITA VILLAGE
MAP ROS5567
UNIT NO.5,
(69)
LINCOLN PLACE
ANGELUS HEIGHTS
MAP 1494
12
10
13
14
13
12
20
GLENCOE DRIVE
1504

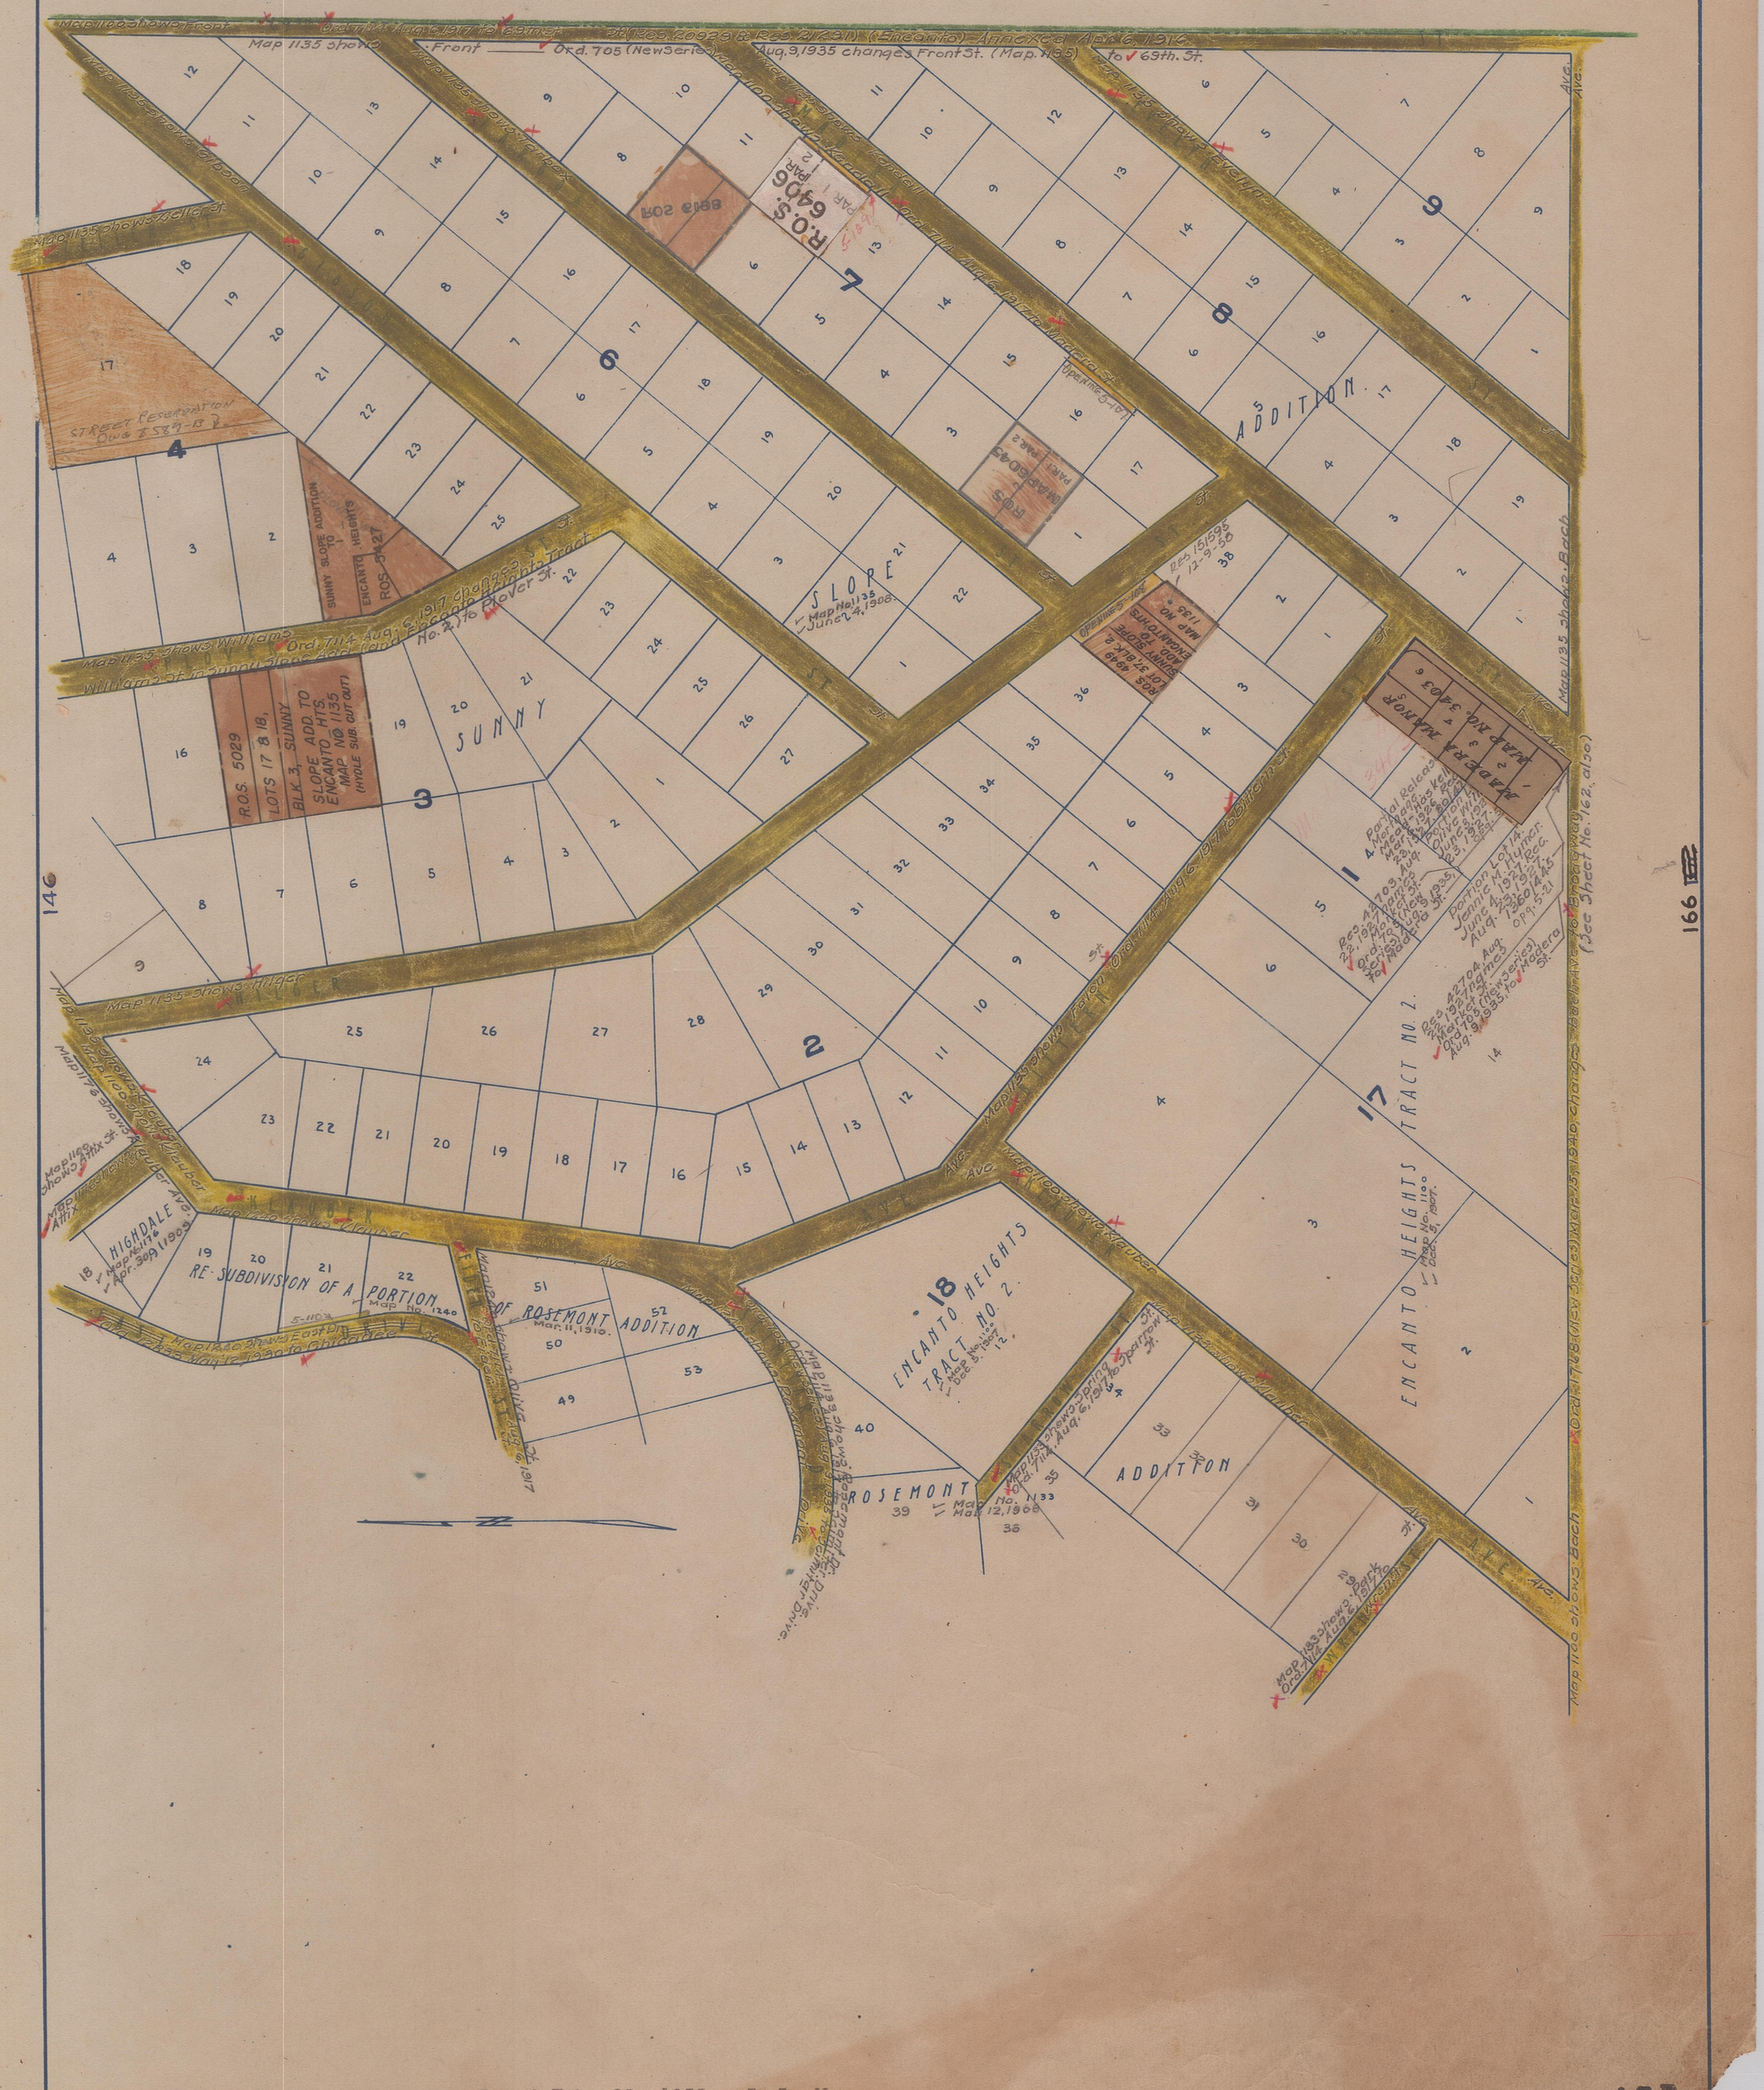
Map 1100 shows Front
Ord. 714 Aug. 6, 1917 to 65th St.
Pt. (Res. 20929 & Res. 21431) (Encanto) Annexed Apr. 6, 1916.
Map 1135 shows Front
Ord. 705 (New Series)
Aug. 9, 1935 changes Front St. (Map. 1135)
to 69th. St.
Map 1100 shows Kendall
Ord. 714 Aug. 6, 1917 to Mardella St.
Ord. 714 Aug. 6, 1917 changes Encanto Heights Tract No. 2 to Rover St.





54TH ST.

143

B'LV'D.

144

LEMON ~~GROVE~~ Federal Boulevard

5' Opening 4-148

5' Opg. 4-150

PARTITION of RANCHO MISSION of S. D.

Map in S.C. Case No. 348. Jan. 14, 1886. (Office of Co. Clerk)

17

(Sero Amusement)
Annexation-Ord. 7284 (NS)
1-15-57

157

COUNTY

1924
141
508

CITY LIMITS

(Recs. 20929 & Recs. 21291) (Encanto) Annexed Apr. 16, 1916.

BEVERLY

Map No. 1129 Apr. 11, 1908.

Map 1129 shows Lenox

LENOX AVE.

DRIVE

Map 1129 shows Elwood

ELWOOD AVE.

Map 1129 shows Winder Dr.

WINDER DR.

Map 1129 shows Geneva

GENEVA AVE.

Map 1129 shows Lenox, 18' strip being portion of Lenox Dr. to Beverly St. Dr.

BEVERLY DRIVE

Map 1129 shows Hanover

HANOVER ST.

Map 1129 shows Derby

DERBY ST.

Map 1129 shows Beverly St. Ave. Map 1114 Aug. 6, 1917 to 56 m. St.

55TH ST.

164

155

Lot 28 & portion Lot 6. Melville S. & Jessie Stewart. Apr. 5, 1927. Rec. May 4, 1927. 1362/50
Res. 415 & 2 May 2, 1927. names Geneva Ave.

4-50

Check of street names completed Oct. 31, 1932. J. L. M.
J.A.T

162

163

156

142

157

14

15

156

158

161-A

17

16

28

29

163

162

157

County Road Survey No. 90, known as Marilou Park to Lemon Grove Road

The San Diego Land & Town Co. deeds to County of San Diego portion of N. 1/2 of Lot 17. June 27, 1898. Rec. Aug. 4. 1898. 272/91 Ord. 704 (New Series) Aug. 2, 1935, names Marilou Road.

*NOTE: 153A for Plat of TMIG PARK No 1 SUBDIVISION
Also 157-B

LANDS OF SAN DIEGO (PURCHASE) 283

The San Diego Land & Town Co. deeds Portion of N.E. 1/4 of Lot 16 to County of San Diego. June 27, 1898. Rec. Aug. 4. 1898. 272/91 Ord 704 (New Series) Aug. 2, 1935, names Marilou Road.

Portion N 1/2 of N.E. 1/4 Lot 16 James B. Mason, June 22, 1926. Rec. July 13, 1926, Bk. 1208/440. Res. 38429, July 12, 1926 names Euclid Ave. 7-17

Portion of Marilou Road Closed by Res. 89070, April 13, 1948. C 34

See Sheet No. 157-B

See Sht. 157-B

(Quitclaim) Portion N. 1/2 of N.E. 1/4 Lot 16 J. F. Margeson. July 12, 1926. Rec. July 21, 1926. 1243/66. Res. 38532, July 19, 1926. names Euclid Ave. 7-17 See 157-B

LEMON GROVE

BLVD.

COUNTY

Portions N 1/2 Lots 16 & 17. 4-49 James B. Mason, J. F. Margeson, Maud Martin, Chas. N. Page & Minnie L. Page. Dec. 4, 1926. Rec. Jan. 12, 1927. 1315/62. Res. 40252, Jan. 10, 1927 names Lemon Grove Blvd. Ord. 13301. Sept. 8, 1931 to Federal Boulevard

EXMISSION LANDS (HORTON'S) MAP Mar. 9, 1870

Opening 4-124 (Sub. Agreement) Un. Tr. Co. of San Diego. June 30, 1926. Rec. July 13, 1926. 1221/289. Res. 38434. July 12, 1926 accepts. Portions of N 1/2 of S.E. 1/4 & S. 1/2 of N.E. 1/4 Lot 16. Maud Martin. June 30, 1926. Rec. July 13, 1926. 1221/282. Res. 38428. July 12, 1926 names Euclid Ave. 7-17

Opening 4-124

LYON ST.

Opening 4-148

Lot 17 Sexo Amuse. Annexation Ord. 7284 (NS) 1-15-57

*NOTE #153A for Plat of FEDERAL BOULEVARD SUBDIVISION

See 157-B

Portion S. 1/2 of S.E. 1/4 Lot 16. B.E. Northington & J. G. Ambrose, May 15, 1926. Rec. May 25, 1926. 1117/241 Res. 37902. May 24, 1926 names Euclid Ave. 7-17

Charles William McGrath Oct. 29, 1945 1979/293 Res. 82045 Nov. 16 1945 names Parcel #1 'A' St & Parcel #2 Euclid Ave. 4-69

Parcel #2

Opening & City Limits

Henry C. & Docia Mae Milam Sept. 8, 1944 Rec. 1739/449 - Res. 79998 Sept. 19, 1944 names 'A' St. 4-69

Parcel #1

(East San Diego) Consolidated Dec. 29 1933 (Court Order) (Res 20929 & Res 21291) (Encanto) Annexed AB

Ohmer H. Warner Sept. 8, 1944 Rec. Sept. 21, 1944 1739/451 Res. 79999 Sept. 19, 1944 names 'A' St. 4-69

(Quitclaim) Portion N 1/2 of N.E. 1/4 Lot 16. Anna Taggart. July 8, 1926. Rec. July 21, 1926. 1230/49. Portion Lot 17. Ex-Mission Rancho Res. 38540. July 19, 1926 names Euclid Ave. 7-17

Portion N 1/2 of N.E. 1/4 Lot 29. W. L. & Maude E. Frazer. May 13, 1926. Rec. May 19, 1926. 1204/394. Res. 37824. May 17, 1926. names Euclid Ave. 7-17

Portion S. 1/2 of N.E. 1/4 Lot 29. Alfred & Ellen E. Geroy. May 15, 1926. Rec. May 25, 1926. 1174/414. Res. 37898. May 24, 1926. names Euclid Ave. 7-17

Portion N 1/2 of S.E. 1/4 Lot 29. Meyer & Anna Goldstein. May 18, 1926. Rec. May 25, 1926. 1174/415. Res. 37899. May 24, 1926. names Euclid Ave. 7-17

Portion S. 1/2 of S.E. 1/4 Lot 29. Walter J. & Rose M. Backus. May 28, 1926. Rec. June 2, 1926. 1193/471 Res. 37983. Jun. 1, 1926. names Euclid Ave. 7-17

EUCLID AVE.

51 ST

AVE.

GENEVA

Check of street names completed Oct. 31, 1932. J. L. M. J. A. T.

~~157~~
~~157A~~
157-A

Res. 84440 #2

Res 82137 – Nov. 27, 1945
Marilou Rd.
49th St
Duval St.

44th St.
Mary Lou St.
50th St.
47th St

Fed. Blvd.

MARILOU ROAD

ST.

See Sheet 157-B

DUVAL ST.

Res. 84137 Nov. 27, 1945 names
Nov. 2nd 1945
Cass St.
Elm St.
49th St.

See Sheet 157B

IMIG PARK

Mary Lou St.
Federal Blvd.

RESUBDIVIDED

SEE 157-B

49TH ST.

NO. 1 SUBDIVISION

2298

MARY LOU ST.

50TH ST.

See Sheet 157-B

FEDERAL

BOULEVARD

Res. 75100 - Sept. 10, 1941 names
Federal Blvd., 47th St., 49th St.
Duval St., Lyon St., & 48th St.

FEDERAL BOULEVARD SUBDIVISION - UNIT NO. 1
2260

48TH

LYON ST.

BEECH

DUVAL ST.

FEDERAL BOULEVARD

SUBDIVISION - UNIT NO. 2
2272

Res. 76825 - May 5, 1942
names:
49th St.
47th St.
Duval St.
Beech St.
'A' St.

49TH

R.O.S. 5320
LOT 12A,
FEDERAL BLVD.
SUB. UNIT NO. 2
MAP NO. 2272

#1
Res 75100 Sept 10, 1941
~~Federal Blvd~~
~~47th St~~
~~49th St~~
~~Duval St~~
~~Lyon St~~
~~48th St~~

16

OF SAN DIEGO

283

4-69

ST.

AVE.

156

#2 ? Res 76825 - May 5, 1942
~~49th St~~
~~47th St.~~
~~Duval St~~
~~Beech St.~~
~~A St.~~

76825
Chkd

EX-MISSION LANDS
Map No.

158

47TH

28

29

EUCLID

See 157 B Also

157-A ~~157A~~ 153A

<142>

~~157~~
~~157-B~~
157-B

Portion of Marilou Road Closed by Res. No. 89070, April 13, 1948.

MARILOU ROAD

Res. 84440, Oct. 29, 1946, names Marilou Road.

Parcel 1. Parcel 2.
Larry A. Imig, Feb. 8, 1947. Rec. Feb. 20, 1947, Book 2359/12. Res. 85252, Feb. 18, 1947 names Parcel No. 1 - 47th St. and Parcel No. 2 - 48th St.
4-30

Res. 84440, Oct. 29, 1946, names 48th St.

IMIG PARK MAP NO. 2363

Res. 84440, Oct. 29, 1946, names Duval St.

Res. 84440, Oct. 29, 1946, names 49th St.

Res. 84440, Oct. 29, 1946, names Mary Lou St.

SUBDIVISION

Res. 84440, Oct. 29, 1944, names 50th St.

4-159' 4-71' 4-120'

Leo J. & Mildred C. Demers Aug. 4, 1947. Rec. Feb. 19, 1948, Bk. 2679, p. 1. Res. 88488, Feb. 17, 1948, names Federal Blvd, Euclid Ave., and Marilou Road.
opening 4-71

FEDERAL ST.

Res. 84440, Oct. 29, 1946, names Federal Blvd.

FEDERAL BOULEVARD

Res. 75100, Sept. 10, 1941 names Federal Blvd.

Res. 75100, Sept. 10, 1941 names 47th St.

Res. 75100, Sept. 10, 1941, names 48th St.

FEDERAL BOULEVARD SUBDIVISION - UNIT NO. 1 MAP 2260

Res. 75100, Sept. 10, 1941 names Lyon St.

LYON ST.

Res. 75100, Sept. 10, 1941, names 49th St.

Res. 75100, Sept. 10, 1941, names Duval St.

BEECH

Res. 76825, May 5, 1942 names Beech St.

Res. 76825, May 5, 1942 names Duval St.

FEDERAL BOULEVARD ST.

SUBDIVISION - UNIT NO. 2 MAP 2272

Res. 76825, May 5, 1942 names 47th St.

Res. 76825, May 5, 1942 names 49th St.

Res. 76825, May 5, 1942 names "A" St.

CHESTER SQUARE

MARY LOU ST.

CHESTER SQUARE ANNEX MAP NO. 3043

50TH ST.

ALTADENA AVENUE

LYON STREET

MAP NO. 2959

BEECH STREET

OPENING 4-134'

OPENING 4-124'

4-124

WELD SUB 2 MAP NO. 4733

4-138'

18.01'

1720

1443

OF SA

283

1691

See 157

ST.

EX-MISSION LANDS Map No.

47TH

10' opening 4-104

28

29

opening 4-113

HILLTOP DRIVE

EUCLID AVE.

<158>

<156>

See 157 A Also

157-

<162>