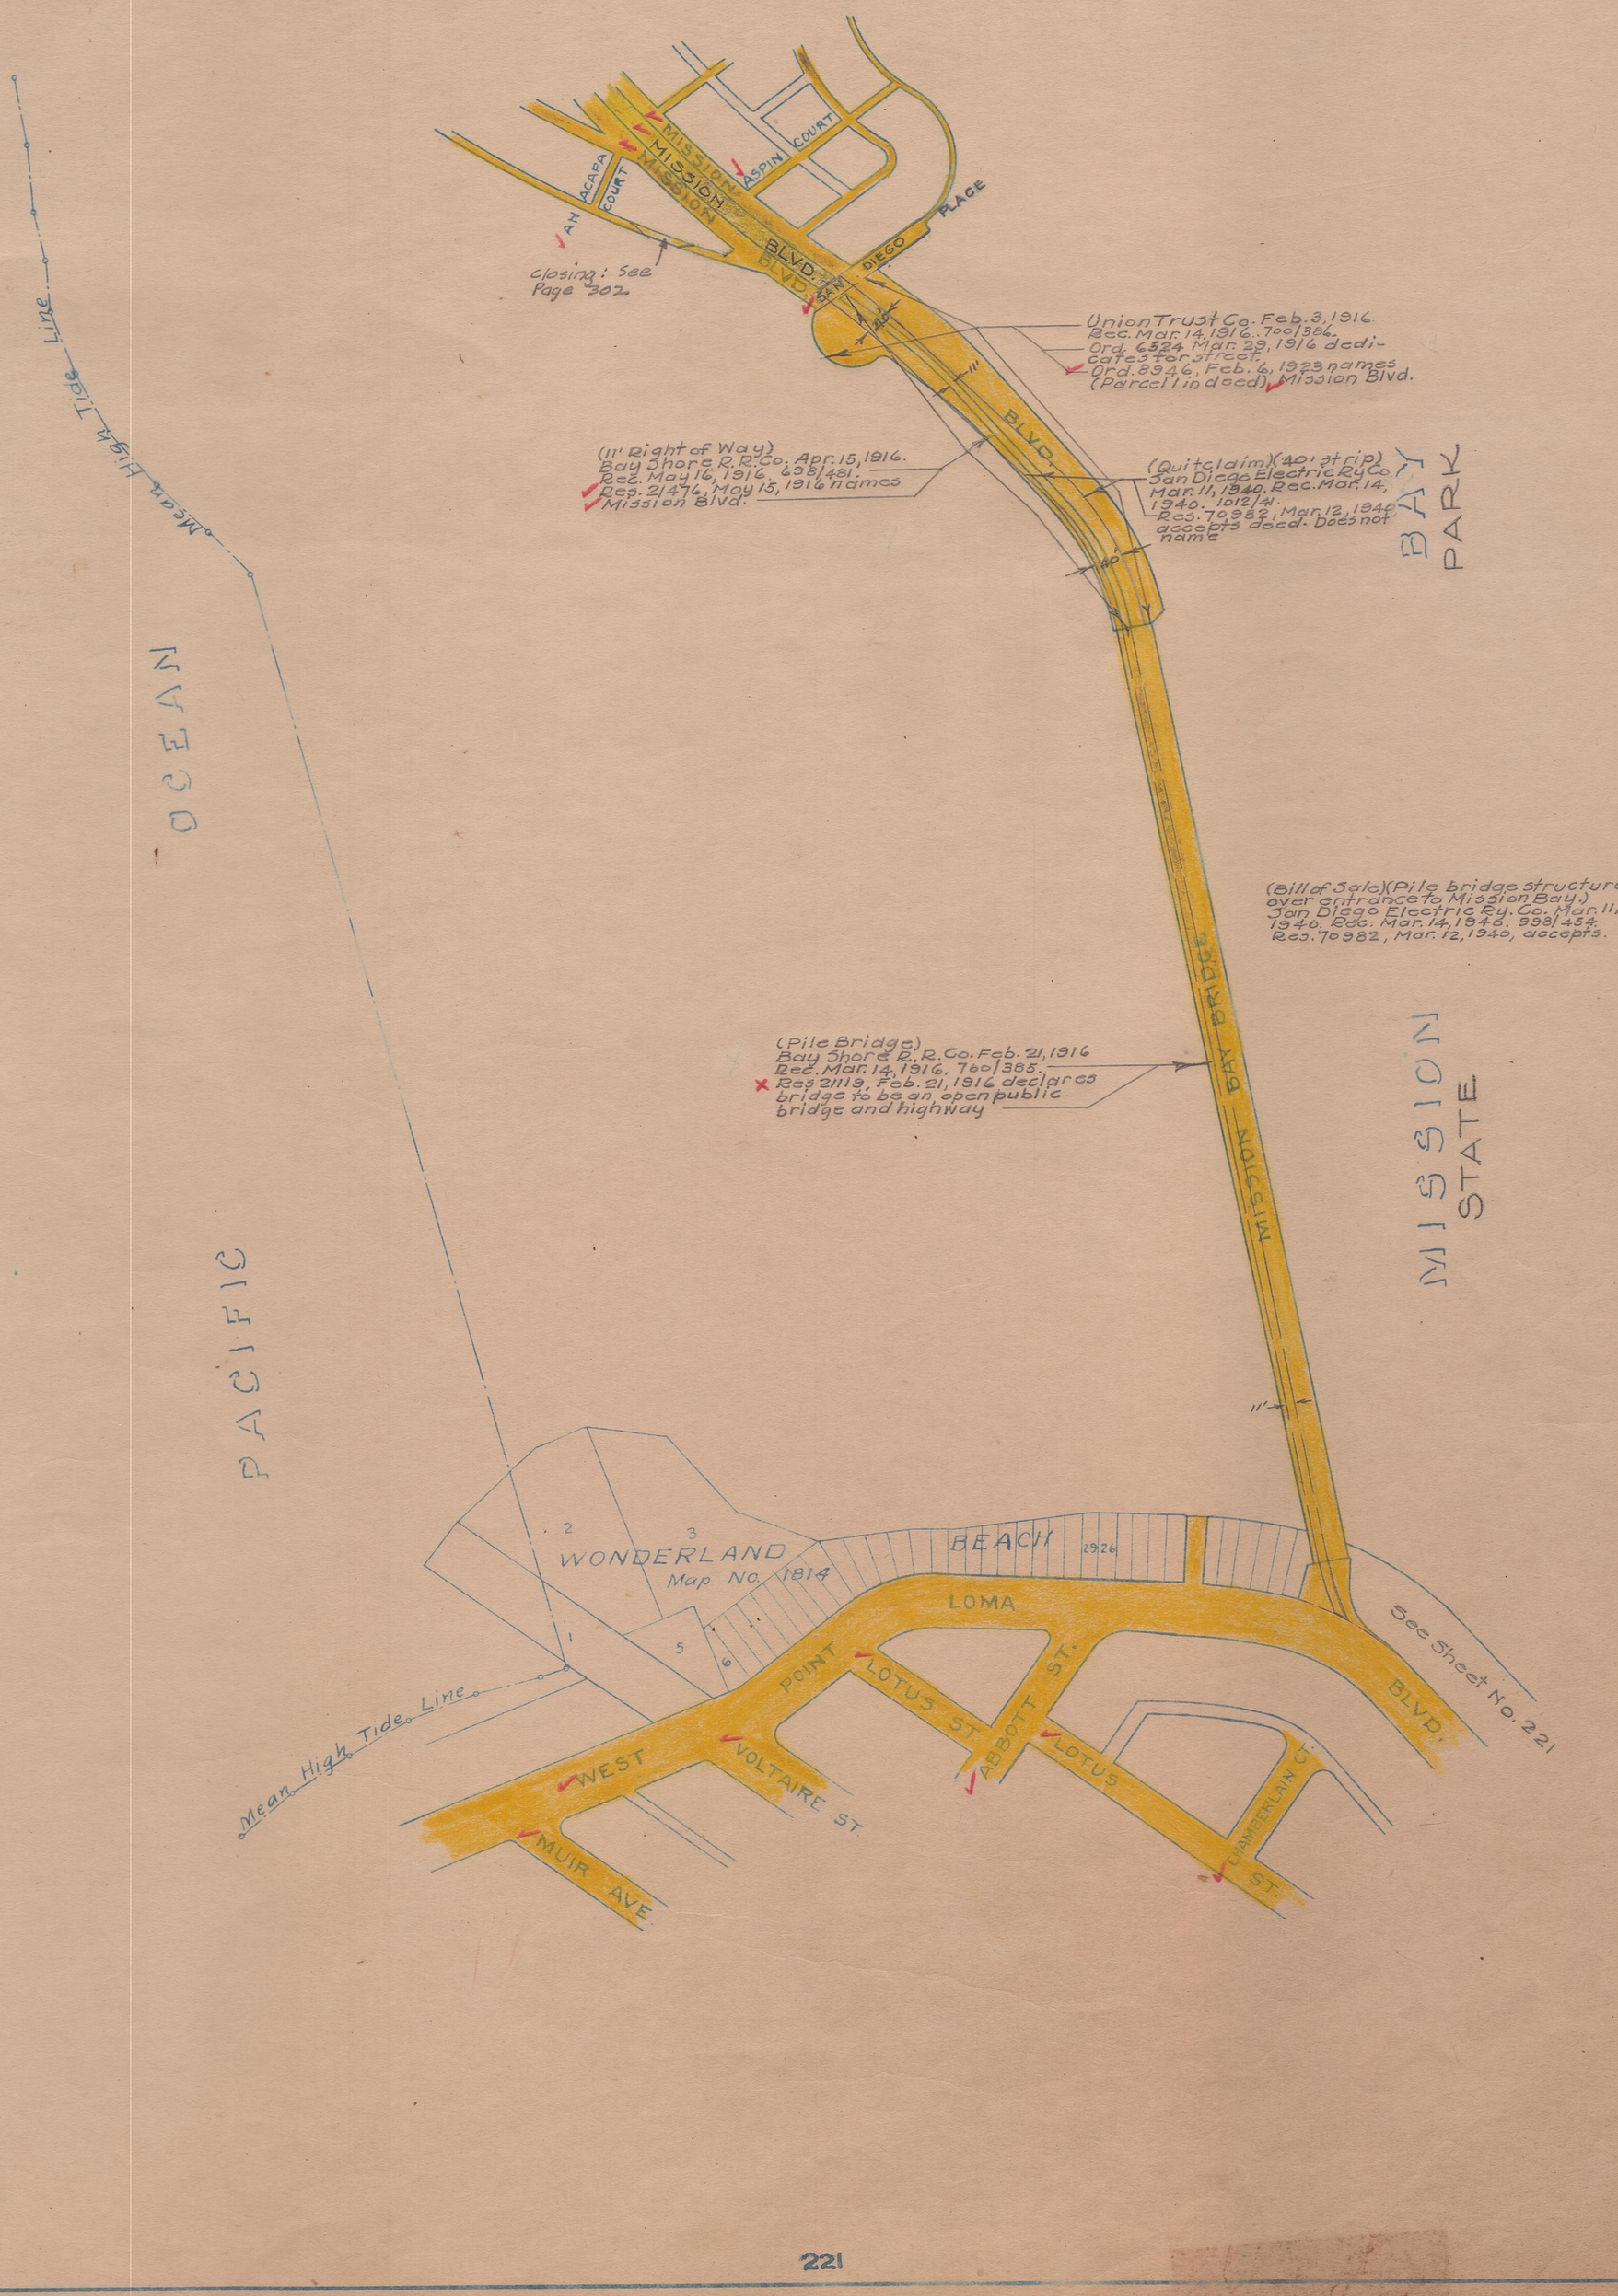
Mean High Tide Line
OCEAN
PACIFIC
BAY
PARK
MISSION
STATE
MISSION BLVD.
MISSION BLVD.
MISSION BLVD.
ACAPA COURT
ASPIN COURT
SAN DIEGO PLACE
BAY BRIDGE
Closing: See Page 302
Union Trust Co. Feb. 3, 1916. Rec. Mar. 14, 1916. 700/386. Ord. 6524 Mar. 29, 1916 dedicates for street. Ord. 8946, Feb. 6, 1923 names (Parcel 1 in deed) Mission Blvd.
(11' Right of Way) Bay Shore R.R. Co. Apr. 15, 1916. Rec. May 16, 1916. 698/481. Rec. 21474, May 15, 1916 names Mission Blvd.
(Quitclaim)(40' strip) San Diego Electric Ry Co. Mar. 11, 1940. Rec. Mar. 14, 1940. 1012/41. Res. 70983, Mar. 12, 1940 accepts deed. Does not name
(Bill of Sale)(Pile bridge structure over entrance to Mission Bay.) San Diego Electric Ry. Co. Mar. 11, 1940. Rec. Mar. 14, 1940. 998/454. Res. 70982, Mar. 12, 1940, accepts.
(Pile Bridge) Bay Shore R.R. Co. Feb. 21, 1916 Rec. Mar. 14, 1916. 760/385. Res 21119, Feb. 21, 1916 declares bridge to be an open public bridge and highway
WONDERLAND
Map No. 1814
BEACH
1926
LOMA
POINT
WEST
VOLTAIRE ST.
MUIR AVE
LOTUS ST.
ABBOTT ST.
LOTUS
CHAMBERLAIN CT.
ST.
BLVD.
See Sheet No. 221
Mean High Tide Line

(R. of S. Map 857) J. D. & Esther L. Wier. June 4, 1941. Rec. Aug. 14, 1941. 1219/351, Res. 74908. Aug. 12, 1941. accepts deed. 14-25

Mission Beach Co. Sept. 5, 1940, Rec. Sept. 13, 1940. 1077/116. Res. 7228, Sept. 10, 1940, names Mission Boulevard. (Deed excepts portions of East Way, West Way, Parcel A and Parcel B and land deeded to City by State) 14-24

Res. 72745, Nov. 19, 1940, dedicates Parcels 1, 2 & 3 for street purposes and names them Mission Boulevard. 14-24

Mission Beach Co. Jan. 30, 1924. Rec. Mar. 6, 1924. 999/64. Res. 30954 Mar. 3, 1924 Names East Way & West Way. 14-21

Parcel 1 3 — Parcel A — Parcel 2

783.66'

CLO. 576

Portion of Westway, also known as Mission Blvd. and West Drive of Mission Blvd.; also portion of East way, also known as Mission Blvd. and East Drive of Mission Blvd. closed by Res. No. 76888, May 12, 1942

(Quitclaim) Mission Beach Co. Oct. 17, 1940. Rec. Jan. 6, 1941. 1123/40 Res. 72855, Dec. 3, 1940, accepts deed. 14-24

(6219-L) J. D. & Esther L. Wier. June 3, 1942. Rec. June 17, 1942. 1362/191. Res. 77120, June 16, 1942, names San Fernando Place

14-27

Ord. 1928 (New Series) Oct. 11, 1940, changes portion of West Way and East Way to Mission Blvd.

(6219-A-L) J. D. & Esther L. Wier. June 3, 1942. Rec. June 17, 1942. 1362/191. Res. 77120, June 16, 1942, names Bayside Court

(6218-E) Portion of land deeded to J. D. & Esther L. Wier. June 3, 1942. Rec. June 17, 1942. 1362/191. Res. 77120, June 16, 1942, names San Fernando Place

Mean High Tide Line as shown on Record of Survey Map No. 857.

BULKHEAD LINE

ISLAND NO. 3

SAN FERNANDO PLACE

OCEAN WALK

BLVD. (A) BLVD. (B) BLVD. (C)

ENSENADA COURT — DOVER COURT — DEVON LANE COURT — DEAL COURT — CORONADO COURT — CATALINA COURT — BEACH COURT — SAN GABRIEL PLACE — CAPISTRANO PLACE — BRIGHTON COURT — BALBOA COURT — AVALON COURT — SAN LUIS REY PLACE — ASBURY COURT — ALLERTON COURT — CAPA COURT — ANA COURT — JUAN COURT — SAN DIEGO PLACE

Blocks: 60, 59, 61, 55, 56, 54, 52, 51, 53, 50, 47, 48, 46, 49, 44, 43, 45, 42, 39, 40, 38, 41, 36, 35, 37, 34, 31, 32, 30, 33, 28, 27, 29, 26, 23, 24, 22, 25, 20, 19, 21, 18, 15, 16, 14, 17, 12, 10, 13, 11, 8, 6, 7, 5, 9, 4, 3, 2, 1

MISSION BEACH RESUB. LOT 58 ROS 3533

MISSION BEACH RESUB. LOT 57 ROS 3534

Mean High Water

Mean High Tide Line

Map shows Res. 18782, Dec. 14, 1914 Names Ensenada Court. Ord. 12833, May 12, 1936 to Cahuenga Court.

Mission Beach Co. Feb. 14, 1924. Rec. Mar. 3, 1924. 1006/16 Res. 30677, Feb. 28, 1924 Names Capistrano Place.

Res. 18782. Dec. 14, 1914 Names streets in Mission Beach. (Map 1651) 14-67

Mission Beach Co. Feb. 14, 1924. Rec. Mar. 3, 1924. 1006/17 Res. 30678. Feb. 28, 1924. Names Capistrano Place.

Mission Beach Co. Oct. 3, 1924. Rec. Oct. 15, 1926. 1291/475 Res. 39422 Oct. 18, 1926. Names Ocean Front Walk. 14-30

14-30

Portion of Ocean Front Walk Closed by Res. 93483, Apr. 19, 1949 See Closing 659.

North Jetty Right of Way Line.

Ord. 4063; May 31, 1949 dedicates and names Ocean Front Walk

Ⓐ Ⓑ Ⓒ Ⓓ Parcel 5 in Grant Deed of San Diego Electric Ry. Co. Mar. 11, 1940. Rec. Mar. 14, 1940. 1084/11. Res. 70982, Mar. 12, 1940, accepts deed. Ord. 2380, (New Series) Effective Mar. 20, 1942, dedicates and names Mission Blvd. 14-38 + 39 (In Fee)

Un. Th. Co. Feb. 3, 1916. Rec. Mar. 14, 1916. 700/386. Ord. 6824, Mar. 29, 1916. Dedicates Does not name. Ord. 8946, Feb. 6, 1923. Names (Parcel 1. in Deed) Mission Blvd.

(11' R. of W.) Bay Shore R.R. Co. Apr. 15, 1916. Rec. May 16, 1916. 698/481. Res. 21476. May 15, 1916. Names Mission Blvd.

BAY PARK

MISSION STATE

Check of street names completed July 25, 1931.

J. L. M.
J. A. T.

1695 E 117° 14' 30" 14' 15"

VENTURA POINT

MISSION BAY

DANA BASIN

220 N

P.L. 251

SUNSET POINT

32°46'00"

VENTURA

P.L. 250

QUIVERA RD.

BOULEVARD

(243)

P.L. 214

(302)

QUIVERA BASIN

P.L. 215

45' 45"

P.L. 213

218 N

304

303

SAN JUAN PLACE

MANHATTAN

LIVERPOOL

LIDO

SAN LUIS OBISPO PLACE

KINGSTON

KENNEBECK

JERSEY

SANTA BARBARA PLACE

JAMAICA

ISTHMUS

ISLAND

VENTURA PLACE

NANTASKET

NAHANT

MONTEREY

EL CARMEL PLACE

COURT

BLVD.

WALK

FRONT

STRAND WAY

OCEAN

MISSION (E)

MISSION

BAYSIDE

ROCHA ISLAND

ISLAND NO. 1

ISLAND NO. 2

BULKHEAD LINE

Mean High Tide Line as shown on Hoopes Map

BAY PARK

MISSION BEACH

PACIFIC OCEAN

PLACE BLVD.

Mission Beach Co. Feb. 14, 1924. Rec. Mar. 3, 1924 1000/13 Reg. 30875. Feb. 25, 1924 Names San Juan Place.
14-67

Reg. 18782 Dec. 14, 1914 Names streets in Mission Beach (Map 651)

Mission Beach Co. Oct. 9, 1926. Rec. Oct. 19, 1926. 1224/475. Reg. 39422 Oct. 18, 1926. Names Ocean Front Walk.
14-32

14-36 + 37
(E)(F)(G)(H) Parcel 6 in Grant Deed of San Diego Electric Ry. Co. Mar. 11, 1940. Rec. Mar. 14, 1940. 1008/77. Reg. 70982, Mar. 12, 1940 accepts deed. Ord. 2380 (New Series) Effective Mar. 20, 1942, dedicates and names Mission Blvd.

Alley in Block 115 and portion of Jersey Court closed by Reg. 75661, Dec. 29, 1941 #572

Alley closed by Ord. 675 (N.S.) March 3, 1936. #524

Ord. 4017 (N.S.), March 29, 1949 changes to Ventura Blvd.

Ord. 1929 (New Series) Oct. 11, 1940 changes portion of West Way & East Way to Mission Blvd

Reg. 72745, Nov. 19, 1940 dedicates Parcels 1, 2 & 3 for street purposes and names them Mission Boulevard.

(Quitclaim) Mission Beach Co. Oct. 17, 1940. Rec. Jan. 6, 1941. 1123/40. Reg. 72855. Dec. 3, 1940. accepts deed.
14-24

Portion of Westway also known as Mission Blvd. and West Drive of Mission Blvd.; also portion of East Way also known as Mission Blvd. and East Drive of Mission Blvd. closed by Reg. No. 76888, May 12, 1942

(6219-L) J. D. & Esther L. Wier June 3, 1942. Rec. June 17, 1942. 1362/191 Reg. 77120 June 16, 1942, names Ventura Place. Ord. No. 4017 (N.S.) Mar. 29, 1949, changes to Ventura Blvd.

14-40
Mission Beach Co. Jan. 30, 1924. Rec. Mar. 6, 1924 939/64 Reg. 34934. Mar. 3, 1924, names East Way & West Way.

14-24
Mission Beach Co. Sept. 3, 1940. Rec. Sept. 13, 1940, 1871/116. Reg. 71205 Sept. 10, 1940, names Mission Blvd. (Deed excepts portions of East Way, West Way, Parcel A & Parcel B and land deeded to City by State)

14-25
(R. of S. Map 857) J. D. & Esther L. Wier June 4, 1941. Rec. Aug. 14, 1941. 1219/351. Reg. 74908, Aug. 12, 1941, accepts deed.

(6219-A-L) J. D. & Esther L. Wier June 3, 1942. Rec. June 17, 1942. 1362/191 Reg. 77120 June 16, 1942, names Ventura Place. Ord. No. 4017 (N.S.) Mar. 29, 1949, changes to Ventura Blvd.

14-41
Deed of land by J. D. Wier & wife to City of San Diego, Aug. 14, 1941. Rec. Sept. 24, 1941. 1241/338. Reg. 80121 accepts deed.

4) Strip of land deeded by State of California. (6218-L)

See Opening 14-76

See C/o. 60

See Bayside Walk

Mission Beach Co. Feb. 14, 1924. Rec. Mar. 3, 1924 1000/13 Reg. 30880 Feb. 25, 1924 Dedicates for public street. Does not name. Ord. 704 (New Series) Aug. 2, 1935 names Mission Bay Place.
14-66

783.66'

Parcel B.

Parcel A

Parcel 2

Check of street names completed July 25, 9131. J. L. M.
J. A. T.

7651-L

302

303

PACIFIC AVE. (See Sheet No. 314)

BRAEMAR LANE

314

Ord. 650 (New Series) May 25, 1935, to Braemar Ave.
Ord. 693 (New Series) July 26, 1935, to Pacific Beach Drive

BRAEMAR EXTENSION
Map No. 1921
July 12, 1926.
Clo. 58

BRAEMAR
Map No. 1038
Dec. 2, 1907.

Maps 1651 & 1883 show Pacific Ave.

BEACH
Map No. 1651
Dec. 2, 1907.

PACIFIC
Map No. 1651
Dec. 2, 1907.

STRANDWAY

Ord 225 New Series 5 June 5, 1928 names unnamed alley State Rita Block.

BLVD.

Clo. 469

Portions of Alley & Bayside Walk closed by Ord. 1312. Mar. 16, 1931.
Portion of Alley closed by Res. 56277. Apr. 18, 1932. Clo. 467

Alley deeded by F.T. Scripps Inc. Dec. 16, 1931. Rec. Apr. 26, 1932. 1201/7. Rec. 58301. Apr. 25, 1932 accepts deed. Deed states for alley. 14-29

F.T. Scripps Inc. Dec. 26, 1930. Rec Mar. 19, 1931. 1872/334. Deed states for Alley. Res. 56089. Mar. 16, 1931. dedicates for alley. (Closed 469)

14-29

F. T. Scripps, Inc. Dec. 20, 1930. Rec. Mar. 19, 1931. 1870/334. Deed states Parcel 1 is for portion of Verona Court; Parcel 2 is for portion of Whiting Court; Parcel 3 is for portion of Windimere Court; Parcel 4 is for portion of alley; Parcel 5 is for court or street purposes. Res. 56087. Mar. 16, 1931 dedicates for court, alley or street.

Henrietta E. Ross, et al. Dec. 11, 1930. Rec. Mar. 19, 1931. 1878/180. This deed designates Parcels 1, 2, 3, 4 & 5 for the same purposes named in deed. 1870/334, above. Res. 56086. Mar. 16, 1931 dedicates for court, alley or street.

14-29

Mission Beach Co. Feb. 17, 1931. Rec. Mar. 19, 1931. 1874/232. Deed states for portion of Verona Court. Res. 56084. Mar. 16, 1931 accepts deed. Does not name.

(I)(J)(K)(L)(M) Parcel 6 in Grant Deed of San Diego Electric Ry. Co. Mar. 11, 1940. Rec. Mar. 14, 1940. 1068/77. Res. 70982. Mar. 12, 1940 accepts deed. Ord. 2380 (New Series) Effective Mar. 20, 1942, dedicates and names Mission Blvd.

BAY PARK

NOTE: Portions of Bayside Lane closed by Res. No. 92505, Jan. 25, 1949. (Portions on easterly side closed to make 16' Right of way between Alley in Block 210 and Alley in Block 177. See Closing Sheets 657 a,b,c) Seed 72.14-4. (on sheet 14-18)

Kenny E. & Lucile L. Reed. Jan. 22, 1941. Rec. Feb. 7, 1941. 1129/387. Res. 73340, Feb. 4, 1941 names Bayside Lane. (2395-B) 14-18

J. M. & M. O. Asher Feb. 15, 1924. Rec. Mar. 3, 1924. 999/38. Res. 36893, Feb. 25, 1924 Ac. for public street. 14-66

J. M. & M. O. Asher July 30, 1926 Rec July 20, 1927. 1393/16. Res. 42404. July 18, 1927 Names Bayside Lane.

" " " " " July 30, 1926 Rec. July 20, 1927. 1387/48. Res. 42401 July 18, 1927. Names Bayside Lane.

" " " " " July 30, 1926 Rec July 20, 1927. 1393/15. Res. 42405 July 18, 1927 Names Bayside Lane.

" " " " " July 30, 1926 Rec. July 20, 1927. 1387/47. Res 42403. July 18, 1927 Names Bayside Lane.

14-17

Ord. 704 (New Series) Aug. 2, 1935 names portions of alleys in Blocks 179, 184, 187, 192, 195 and 203; and portion of unnamed street in Block 208, Bayside Lane.
Fern W. & Florence E. Gray. Jan. 17, 1941. Dec. Feb. 5, 1941. 1127/365. Res. 73275, Jan. 28, 1941, names Bayside Lane. (2394-B) 14-19
Wm. H. & Addie Griffin. Jan. 14, 1941. Rec. Feb. 5, 1941. 1127/363. Res. 73276 Jan. 28, 1941, names Bayside Lane (2394-B) 14-19

" " " " " Mar. 22, 1927 Rec. July 20, 1927. 1241/264. Res. 42399. July 18, 1927 Names Bayside Lane.

" " " " " July 30, 1926 Rec. July 20, 1927. 1338/490. Res. 42406 July 18, 1927. Names Bayside Lane.

" " " " " July 30, 1926 Rec. July 20, 1927. 1393/14. Res. 42407. July 18, 1927. Names Bayside Lane.

" " " " " July 30, 1926 Rec. July 20, 1927. 1338/488. Res. 42402 July 18, 1927 Names Bayside Lane.

14-17

" " " " " Apr. 25, 1927 Rec. July 20, 1927. 1338/486. Res. 42408 July 18, 1927. Names Bayside Lane.

N. D. & D. V. Kuhlman July 30, 1926. Rec July 20, 1927. 1362/273. Res. 42409 July 18, 1927 Names Bayside Lane.

J. M. & M. O. Asher Mar. 2, 1927. Rec July 20, 1927. 1241/263. Res. 42400. July 18, 1927 Names Bayside Lane.

" " " " " Mar. 2, 1927. Rec. July 20, 1927. 1241/266. Res. 42398. July 18, 1927 Names Bayside Lane.

See NOTE above.

14-2
Charles K. & Frances H. Wark, March 10, 1947. Rec. 3-27-47, Book 2343/439. Res. 85586, March 25, 1947, names Santa Clara Place.

Albert & Pearl Jumblatt, Jan. 20, 1947. Rec. 3-27-47, Book 2343/453. Res. 85587, 3-27-47, names Santa Clara Place.

Lulu Minor, trustee for Robert Mack Maskoske March 7, 1947. Rec. 3-27-47 Book 2343/430 Res. 85588 March 25, 1947, names Santa Clara Place.

Check of street names completed July 25, 1931. J. L. M.
J.A.T.

Map shows Res 18782, Dec. 14, 1914 Names Newport Court
Ord. 12833, May 12, 1930 to Niantic Court.

Res. 18782. Dec. 14, 1914 Names Streets in Mission Beach (Map 1651)

Mission Beach Co. Oct. 9, 1926. Rec. 19, 1926. 1241/475. Res. 39422. Oct. 18, 1926 Names Ocean Front Walk.

10316 Alley closed by Res. 39862. Dec. 6, 1926.

OCEAN

PACIFIC

14-2

OCEAN FRONT WALK

MEAN HIGH TIDE LINE as shown on Map No. 1651

BULKHEAD LINE

BAYSIDE WALK

BAYSIDE LANE

MISSION BLVD. STATE

RESUB OF BLOCK 170 MISSION BEACH Map No. 1727 Dec. 13, 1923.

ROCHA ISLAND

(See Sheet No. 303.)

303

304

306

307

LINE

High Tide Line - Misc. Map 71

MISSION BULKHEAD

Mean High Tide Line - Misc. Map 71

1226-1689

BULKHEAD

PARK BAY

14-15

Parcel 1 - Helen I & Francis M. Sawyer July 9, 1946, Rec Aug 24, 1946, 2222-147, Res 83963 Aug 20, 1946 names Ingraham Street.
Sec Trust & Savings Bank of S.D Aug 12, 1946 Rec Aug 24 1946 2210-418 (Subn Agmt)

Parcel 2 - Dan E. & Mary K. Thomas July 15, 1946, Rec Aug 24, 1946, 2204-302 Res 83964 Aug 20, 1946 names Ingraham Street.

Parcel 3 - Dons McNally July 30, 1946 Rec Aug 24, 1946, Bk 2204-303. Res 83962 Aug 20, 1946 names Ingraham Street.
First Federal Savings and Loan Ass'n of S.D Aug 1, 1946, Rec Aug 24, 1946, 2210-411. (Subn Agmt).

J. L. Tripp Sept. 30, 1927. Rec. July 19, 1928, 1499/245 Re-3.46344 July 16, 1928 Names Ingraham St.
14-60

Check of street names completed July 25, 1931. J. L. M.
J.A.T.

313

306

304 314

Ord. 650 (New Series) May 25, 1935 changes Pacific Ave. to Braemar Ave.
Ord. 693 (New Series) July 26, 1935 changes Braemar Ave to Pacific Beach Drive.

(See Sheet No. 313, also)

P.L. 179.4

CASS ST.

PACIFIC 60' — Map 1964 shows portions of Pacific Ave. Recs. 35641. Oct. 19, 1925 names

AVE. 60'

P.L. 180.3

WEST GRANFIELD DR. Ord. 696 (New Series) July 6, 1926 Names

BRAEMAR 10 EXTENSION Map No. 1927 July 12, 1926

EAST GRANFIELD DR.

DAWES ST. Map 1964 shows & names as Julia Ave. 1926

SOUTHERN P.C.S. MAP NO. 5749

TITLE

EVERTS ST. Map shows & names

PARKER Map 2004 shows Rec. 35641 Oct. 19, 1925 PL. names

P.L. 180.1

GUARANTY

ST.

LA PALMA Map shows Rec. 35641 Names ST.

FANNIE Map shows Rec. 35641 Names

GRESHAM Map shows Recs. 35641. Oct. 19, 1925 Names

ESTRELLA Ord. 12885 Map 1921 PL. Map shows Estrellita Rec. 35641 Oct. 19, 1925 Names

SUBDIVISION Map No. 1864 Oct. 20, 1925

P.L. 180.0

RIVIERA Dr. 307

So. Title Guaranty Co. Dec. 20, 1922 Rec. Jan. 10, 1923 926/11c. Recs. 28677 Jan. 8, 1923 names Pacific Ave. opening 14-1

Mean High Tide Line - Misc. Map 70

Streets extended to seawall in lease to Crescent Beach Imp. Assoc. by Bd. of State Harbor Comm. for Bay of S.D. in 1926

Scripps Lease No streets extended

BULKHEAD

MISSION BAY STATE PARK

LINE

See Opening 14-55, Dec. 4, 1923, 978/138. Co. Title Guaranty Co. Rec. Dec. 23, 1922, 926/11c. Map 1854 shows & names Portion of 14 as Frontera St. Rec. 35641 Names

FRONTERA

It is warranted & agreed, however that the following named street shall be prolonged across and across said leased premises and full access thereon & thereupon to and from the waters of said Mission Bay, to-wit: Dawes St. Estrella St. (now built) Everts St & Fannie St

Condition in lease of Crescent Beach Improvement Assoc. in Mission Bay

Check of street names completed July 25, 1931. J. L. M.
J.A.T.

306

See 226-1689 (III-18)

Ord. 2904 (New Series) Dec. 15, 1944 changes termination of Frontera St. to PACIFIC BEACH DRIVE

Un. Tr. Co. Oct. 12 1928. Rec. Nov. 1, 1928 1538/304. Res. 47748 Oct. 29, 1928. Names Pacific Ave. 14-64

Un. Tr. Co. Aug. 14, 1926. Rec. Sept. 14, 1926. 1249/274. Res. 39063, Sept. 13, 1926 Names Haines St. 14-54

Un. Tr. Co. Aug. 14, 1926 Rec. Sept. 14, 1926. 1249/277 Res. 39085 Sept. 13, 1926 Names Ingraham St. 14-54

R.L. 1795

See Opening 14-40 Folsom Bros. Co. May 10, 1907. Rec. June 13, 1907. 422/16 Ord. 2676, June 22, 1907 Names Pescadero St. & Pacific Ave.

Opening 14-53 Martha M. Frost. July 25, 1923. Rec. Aug. 11, 1923. 943/487 Res. 2969, Aug. 8, 1923 Names Lamont St.

(See Sheet No. 312)

Map 895 shows Pacific Ord. 1332 Apr. 28, 1903 Names ~~PACIFIC~~

Ord. 650 (New Series) May 25, 1935 changes Pacific Ave. to Braemar Ave. Ord. 692 (New Series) July 26, 1935 changes Braemar Ave. to Pacific Beach Drive.

Map 894 shows Pacific Ord. 1260 Jan. 20, 1903 Names

Portion of Yosemite St and Alley in Block 4 Closed by Res. No. 57644 Nov. 25, 1947 Closing Ord. 6246 Rec. 1052.

Map 894 shows Chicago St. Ord. 1260 Jan. 20, 1903 Names Ord. 3417 Jan. 13, 1914 to Van Nuys St. Ord. 2356 Jan. 19, 1922 to Chicago St.

Ord. 4054 May 13, 1910 Names Sea View Ave. ~~Kendall St.~~ May 15, 1911 to Kendall St.

Ord. 3417 Jan. 13, 1914 to Van Nuys St. Ord. 3562 Jan. 14, 1922 to Chicago St.

Map 1260 shows Chicago St. Ord. 4054 May 13, 1910 Names Sea View Ave. ~~Kendall St.~~ May 15, 1911 to Kendall St.

Map 895 shows Sunset SUNSET Ord. 1332 Apr. 28, 1903 Names Ord. 12833 May 12, 1930 to Fortuna Ave.

Map 894 shows Sunset Ord. 1260 Jan. 20, 1903 Names Ord. 12833 May 12, 1930 to Fortuna Ave.

Ord. 2904 (New Series) Dec. 15, 1944 changes termination of Frontera St. to PACIFIC BEACH DRIVE

Map 895 shows Roosevelt ROOSEVELT Ord. 1332 Names.

Map 894 shows Roosevelt Ord. 1260 Names

Map 1203 shows La Playa Ave. Ord. 3802 Aug. 21, 1939 Names

Map 895 shows La Playa LA PLAYA Ord. 1332 Apr. 28, 1903 Names

Map 894 shows La Playa Ord. 1260 Jan. 20, 1903 Names

Map 1203 shows Alta Vista Ord. 3802 Aug. 21, 1939 Names Ord. 3417 Jan. 13, 1914 to Haines St.

Map shows Ord. 1332 Apr. 28, 1903 Names

Ord. 1260 Jan. 20, 1903 Names Ord. 12833 May 12, 1930 to Fortuna Ave.

Ord. 1260 Jan. 20, 1903 Names Ord. 3417 Jan. 13, 1914 to Jewell St.

Ord. 1260 Jan. 20, 1903 Names Ord. 3417 Jan. 13, 1914 to Kendall St.

Map shows Ord. 1260 Jan. 20, 1903 Names Ord. 12833 May 12, 1930 to Fortuna Ave.

Map 894 shows Sequoia Ord. 1260 Names

Map 894 shows Lamont Ord. 1260 Jan. 20, 1903 Names

Ord. 1260 Jan. 20, 1903 Names Ord. 12833 May 12, 1930 to Ocean Point Drive.

(See Sheet No. 306)

(See Sheet No. 308)

R.L. 1801

R.L. 1799

R.L. 1802

MISSION STATE BAY PARK

MISSION LINE

BULKHEAD

Check of street names completed July 25, 1931. J. L. M.
J.A.T.

See 226-1689(III-19)