38

37

(See Sheet No. 38, also.)

Ord. 705 (N.S.) Aug. 9, 1935, changes Marcey Ave. to Marcy Ave. P.L. 1159

Map 327 shows Olive — Ord. 35. App. Oct. 10, 1888 to Logan Ave. — LOGAN — Ave. — Map 168 shows Olive — Ord. 35. App. Oct. 10, 1888 to Logan Ave. — AVE.

Map 327 shows National — NATIONAL — Ave. — Map 168 shows National — AVE.

Map 327 shows Grand — Ord. 4881 Oct. 19, 1912 to Newton Ave. — NEWTON — Ave. — Map 168 shows Grand — Ord. 4881 Oct. 19, 1912 to Newton Ave. — AVE.

Map 327 shows Boston — BOSTON — Ave. — Map 168 shows Boston — AVE.

Map 327 shows Topeka — Ord. 20 App. Aug. 15, 1888 to Main St. — MAIN — Ave. — Map 168 shows Topeka — Ord. 20 App. Aug. 15, 1888 to Main St. — Portion of Main St. closed by Res. 26632 July 11, 1927 — ST. — Ave.

Map 327 shows Colton — COLTON — Ave. — Map 168 shows Colton — COLTON — AVE.

Map 327 shows Bay — BAY — Ave. — Map 168 shows Bay — AVE.

Parcel 1

2-37 So. Calif. Ry. Co. Feb. 2, 1895. Rec. Dec. 6, 1895. 2.4 acres. Deed states for perpendiculars of 27th, 28th, 29th, 30th, 31st, 32nd, 33rd, 34th, 35th, 36th, 37th, 38th Sts. 29th, 31st & Bay Aves. across R. of W. of said Ry. Co. (See Sheet No. 35, also)

2-13 Portions of rights dedicated for streets and named Harbor Drive by Res. 2671 as harbor improvements, Nov. 1927 & the Harbor Drive Bond Act (1935)

Highway known as Harbor Drive

BAY OF SAN DIEGO

Governments O.P. 140.26

P.L. 1166

Property

Check of street names completed April 8, 1932. J. L. M.
J. A. T.

39

38

(See Sheet No. 39, also.)

Ord. 17500 Sept. 10, 1929 names portion of alley (Map 281) 123 Ft. St.

VALLEY PL.

Ord. 12194 Sept. 8, 1919 names portion of alley (Map 281) Valley Place

(Fractional Lots 1 to 24 Block 320) Claims adjudicated by Tax Collector Jan. 17, 1906. See Ord. 374 (N.S.)

P. L. 1153

320 321 331 332

Map 281 shows W Ord. 116 Sept. 1, 1887 to Webster Ave.

WEBSTER

Map 156 shows D Ord. 116 Sept. 1, 1887 to Webster Ave.

AVE

319 322 330 333

Map 281 shows P Ord. 116 Sept. 1, 1887 to Clay Ave.

REED AMD

DALEY'S

Map 156 shows P Ord. 116 Sept. 1, 1887 to Clay Ave.

CLAY

AVE

318 323 329 334

Map 281 shows Q Ord. 116 Sept. 1, 1887 to Sargent Ave. Ord. 599 Feb. 7, 1889 to Franklin St. Ord. 3417 Jan. 13, 1914 to Franklin Ave.

ADD

ITION

Map No. 291 June 19, 1886

Portion of Block 323 dedicated by Ord. 2439 Apr. 5, 1897 See Ord. 1130 (N.S.)

Map 156 shows Q Ord. 116 Sept. 1, 1887 to Sargent Ave. Ord. 5417 Jan. 13, 1914 changes Q Ave to Franklin Ave. Ord. 6314 Oct. 3, 1918 changes Sargent Ave. to Franklin Ave.

FRANKLIN

AVE.

317 324 328 335

Map 281 does not show a Street Vacation of Stratford Ave. See Ord. 704 (New Series) Aug. 2, 1935 names Ocean View Blvd.

Map 281 shows Woolman Ave.

Map 281 shows Park

Map 281 shows Stratford Ave.

Map 281 shows Ocean View Blvd.
































































40

39

P.L. 1150

MARKET ST.

Ord. 637 Nov. 27, 1915 changes H St. to Market St.

ADDITION

ISLAND AVE.

NEW SUBDIVISION

HOITT ST.

HOITT'S ADDITION

ODD'S ADDITION

FRINK AND WILDE'S SUB.

REED AND SWAYNE'S ADDITION

CENTRAL PARK

ADDITION

REED'S SUBDIVISION OF NE 1/4 (POWERS)

SUBDIVISION OF SW. OF P.L. 1153.

REED'S CENTRAL ADDITION

CENTRAL PARK

IMPERIAL AVE.

EAST SAN DIEGO

VALLEY HOME TRACT

VALLEY PL.

Ord. 6951 Apr. 13, 1917 changes M St. to Imperial Ave.

Ord. 11901 Aug. 27, 1928 changes N St. for its entire length to Commercial St.

Commercial Place closed by Res. 82698-Mar. 5, 1946 #602

Portion of 29th St. closed by Res. Ordering Work No. 116053 adopted Jan. 5, 1954 by the Council of the City of San Diego. (See Closing 789)

Check of street names completed May 10, 1932. J. L. M.
J.A.T.

39

38

30

42

57

40

59

29

41

39

Check of street names completed May 10, 1932. J. L. M.
J.A.T.

41-A

NOTE:
R/W for Wabash was not checked for deeds, but area shown as dedicated was copied from Mohler's Work Sheet #4; The same holds for Federal Blvd.
R/W alignment for Wabash as shown on Dwgs. but dedications and naming not checked.

P.L. 1140

7248-L

A ST. 121 150 ST.

B ST. 122 149 ST.

C ST. 123 148 ST.

C ST. 124 147 ST.

BROADWAY

BROADWAY 125 1 BRODERICK AND WEST PICKWICK ADDITION. 1 ORANGE PARK 2 3 ST.

E ST. 126

F ST. 127

G ST. 128

P.L. 1152

HAFFENDEN AND HIGHS ADDITION TO SUMMYDALE

QUALITY BRANDS TRACT UNIT NO 2 LOT 2 MAP NO 4915

7921-B ST.

7916-L SUMMYDALE

7247-L

7248-L

NOTE: Dwg. 7247-L does not show a gap. Mohler's work sheet shows. Titles are ok."

7248-BL
Mildred Gayer to City June 29, 1949; Rec. Bk. 3266, p. 84 O.R., July 25, 1949; City Clerk's Doc. 404452; Res. 94417, July 19, 1949 dedicates and names Wabash Blvd.

7248-BL
Mildred Gayer to City July 1, 1949; Rec. Book 3266, p. 87, O.R.; July 25, 1949; City Clerk's Doc. No. 404456;

Res. 94414 July 19, 1949 dedicates and names Wabash Blvd.

Ord. 4890 (N.S.) Aug. 14, 1951 names Wabash Blvd. (Sec. 3) names Wabash Blvd. (Sec. 2)

Ord. 4901 (N.S.) Aug. 14, 1951 changes name from Federal Blvd. to Wabash Blvd. also cancels 30th St. Overpass

Ord. 4902 (N.S.) Aug. 21, 1951 changes name from Federal Blvd. to Wabash Blvd. also cancels 30th St. Overpass

Ord. 4890 (N.S.) Aug. 14, 1951 changes name from Federal Blvd. to E St. (City Eng. Doc. 17094)

Ord. 4891 (N.S.) Aug. 14, 1951 names Federal Blvd. (Sec. 1)

Ord. 4891 (N.S.) Aug. 14, 1951, (Sect. 4) names Wabash Blvd.
" " " " " (Sect. 5) " Wabash Blvd.
" " " " " (Sect. 6) " Wabash Blvd.
Ord. 4935 (N.S.) Sept. 25, 1951 (Sect. 1) " Wabash Blvd.
(S.C.C. 158058)

(A) Albert & Romelia Taylor to City July 26, 1949; Ex. in Book p. (O.R.) Res. 94702, Aug. 2, 1949 dedicates & names Federal Boulevard.

(B) Ord. 4890 (N.S.) Aug. 14, 1951 changes portion of Federal Blvd. to E St.

(C) Ord. ~~4901~~ 4901 (N.S.) Aug. 21, 1951; C_1 = portions of Alleys named Federal Blvd.; C_2 = portions of G St. changed to Federal Blvd.

(D) Ord. 4902 (N.S.) Aug. 21, 1951 (Ex. area under "overpass")
D_1 = portions of B St. changed to Wabash Boulevard.
D_2 = " " C St. " " Wabash Blvd.
D_3 = " "Broadway " " Wabash Blvd.
D_4 = " " Pickwick St. " " Wabash Blvd.
D_5 = " " Federal Blvd " " Wabash Blvd.
D_6 = " " 35TH St. " " Wabash Blvd.
D_7 = " " 36TH St. " " Wabash Blvd.
D_8 = portion of Alley named Wabash Blvd.
D_9 = Alley named Wabash Blvd.
D_{10} = Alley named Wabash Blvd.

C_3 = " " 33RD St. " " Federal Blvd.
C_4 = " " F St. " " Federal Blvd.
C_5 = " " E St. " " Federal Blvd.
C_6 = " " Pickwick St. " " Federal Blvd.
C_7 = " " 34TH St. " " Federal Blvd.

NOTE: DEEDS NOT CHECKED - WORK TO BE DONE FOR THIS SHEET

41-A

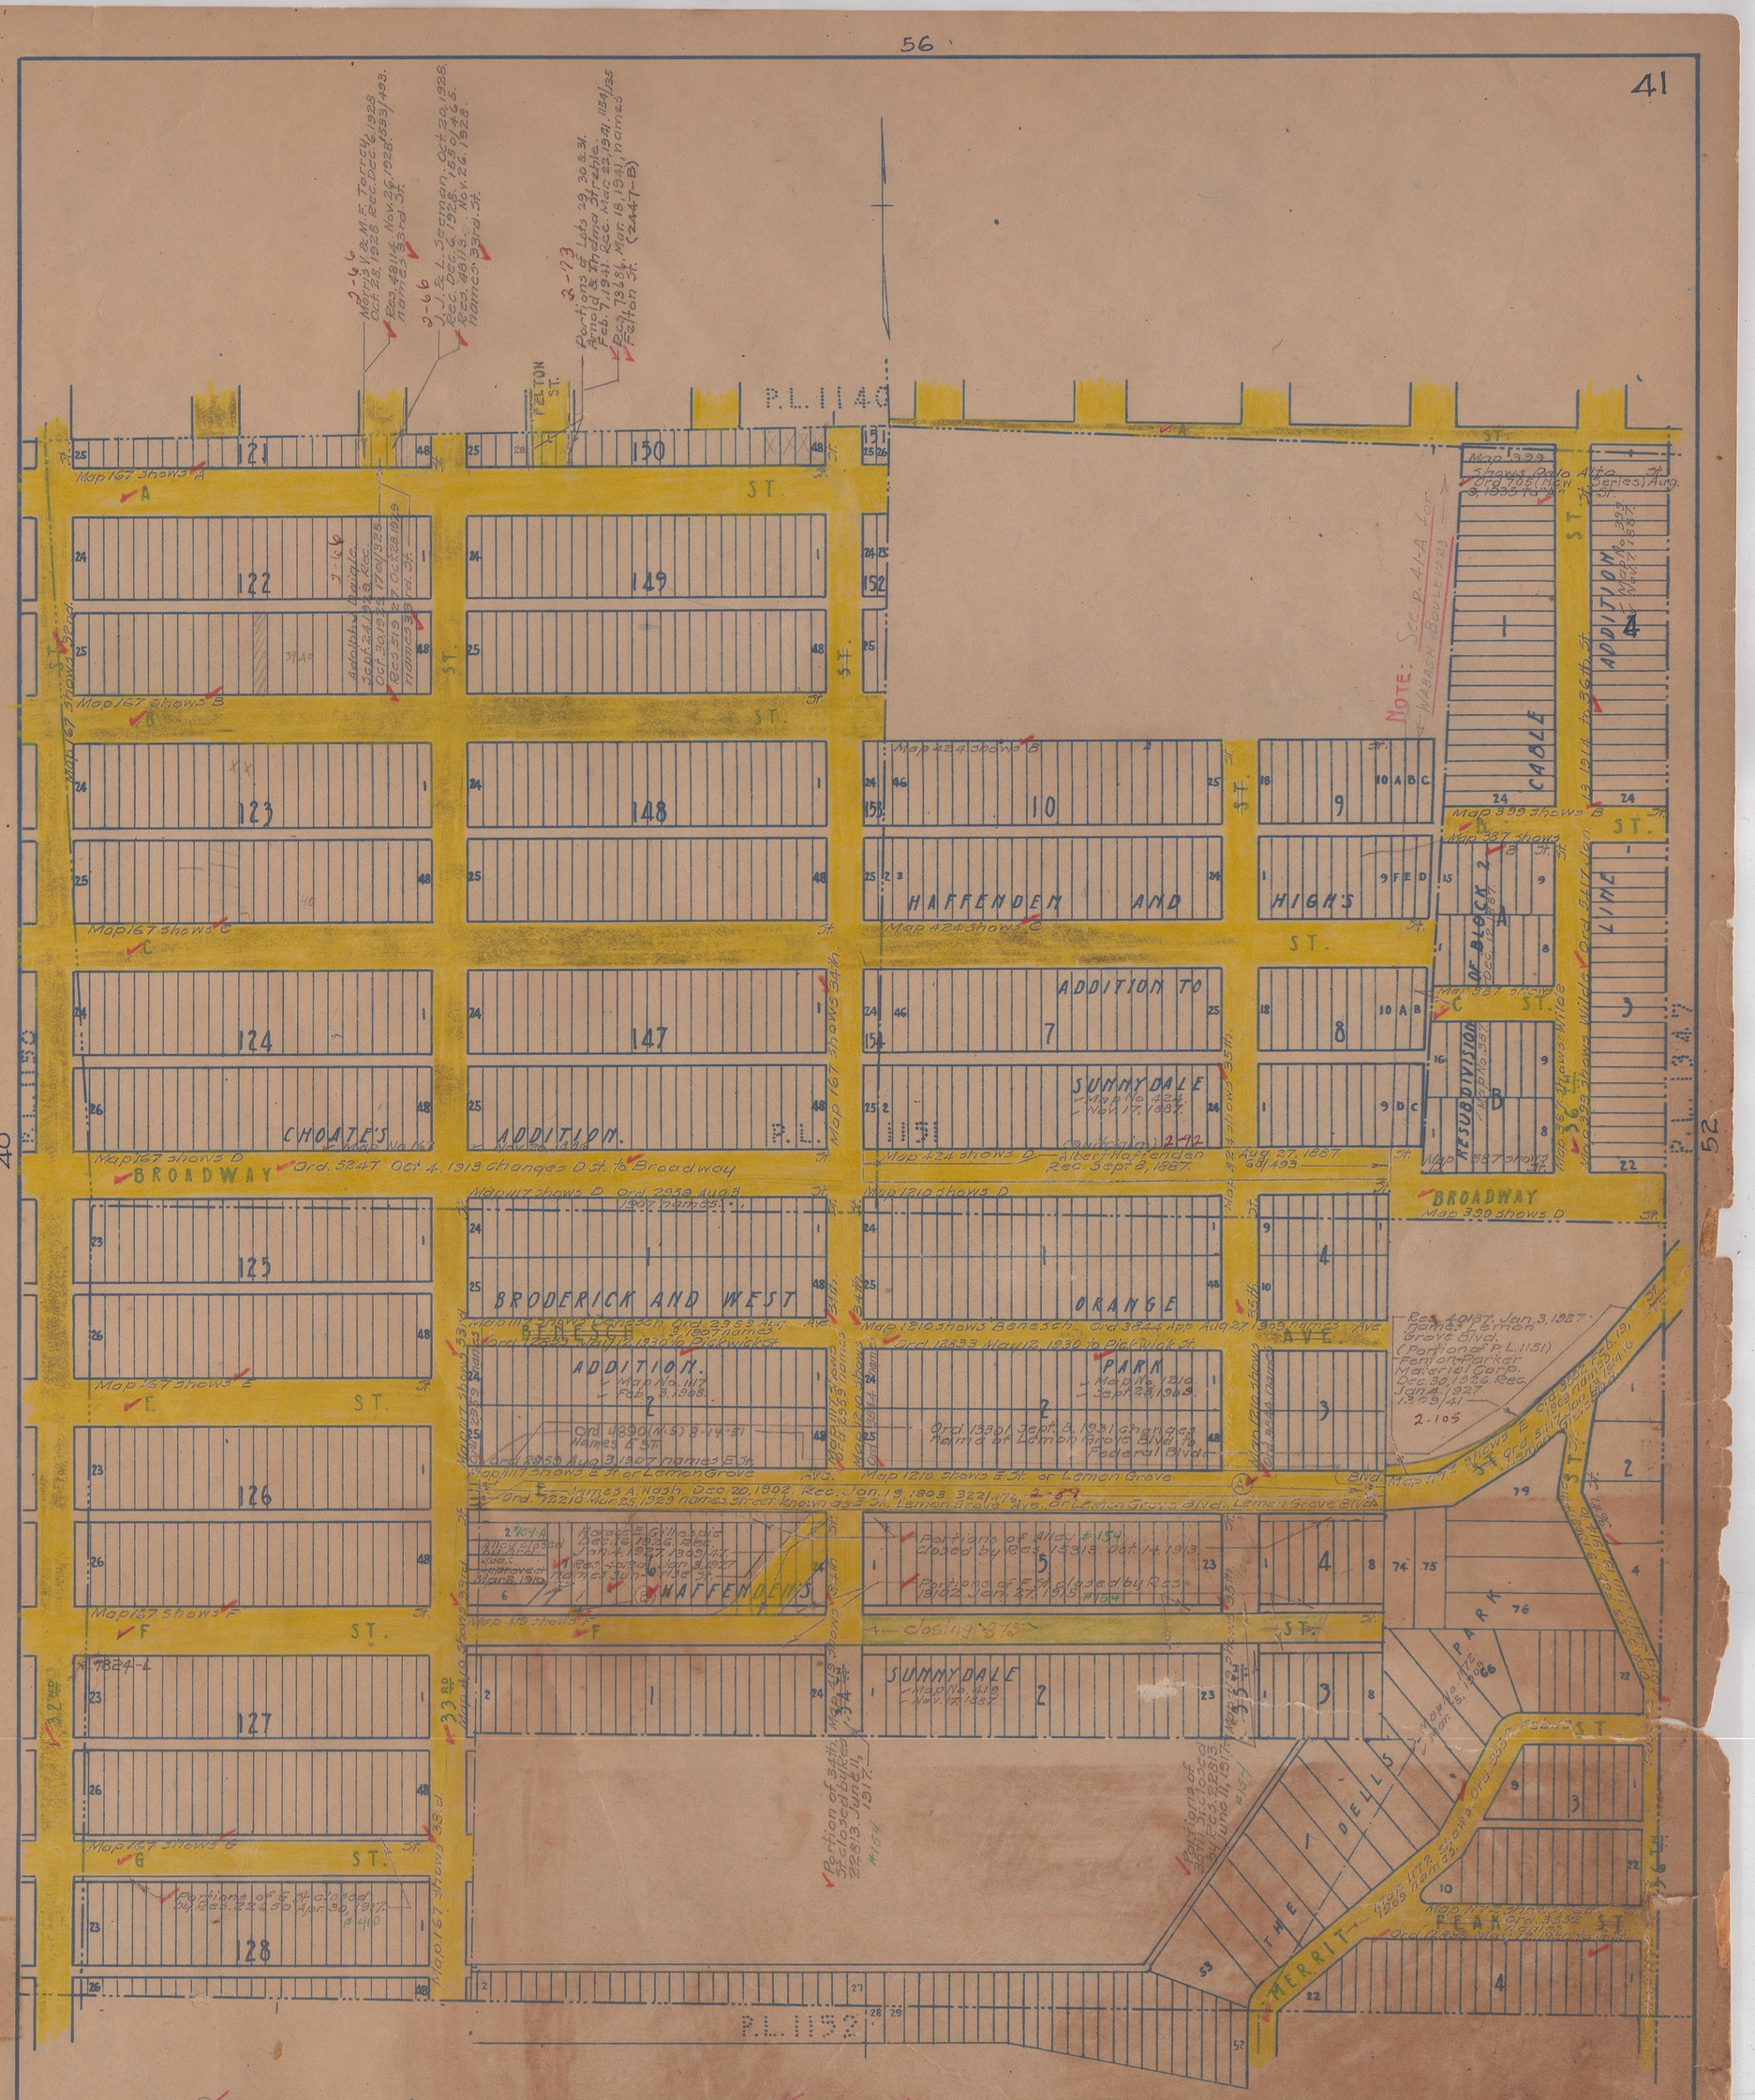
P.L. 1140
ST.
PELTON ST.
Portions of Lots 29, 30 & 31 Arnold & Hyatt's Subdivision Feb. 7, 1941. Rec. Mar. 22, 1941. 1134/135 Rec. 7348, Mar. 18, 1941, names Pelton St. (2447-B)
2-46 Map 123 V. B. & M. E. Torrey Oct. 28, 1928. Rec. Dec. 26, 1928 Rec. 4814, Nov. 26, 1928. 1033/493. Names 33rd St.
2-46 J. J. & L. Jeeman. Oct. 20, 1928. Rec. Dec. 6, 1928. 155 of Maps Rec. 4813, Nov. 26, 1928. Names 33rd. St.
Map 167 shows A
Map 167 shows B
Map 167 shows C
Map 167 shows D
Map 167 shows E
Map 167 shows F
Map 167 shows G
Map 424 shows B
Map 424 shows C
Map 424 shows D
Map 1210 shows D
Map 1210 shows E St. or Lemon Grove
Map 399 shows B
Map 387 shows
Map 399 shows D
Map 399 shows Palo Alto Ord. 705 (N.S.) 9-1935 to A
Map 339 shows Palo Alto Ord. 205 (New Series) Aug. 31, 1887
Map 329 shows Wilde's Addition to Lemon Grove Ord. 3417 Jan. 13, 1914
Map 339 shows Wilde's Addition to Lemon Grove Ord. 3417 Jan. 13, 1914
Note: See P. 41-A for Wabash Boulevard
Map 167 shows Ord. 3247 Oct. 4, 1913 changes D St. to Broadway
Map 1117 shows D Ord. 2939 Aug. 3, 1907 names 35th.
Map 1210 shows Benesch Ord. 3953 Aug. 1907 names Ave.
Map 1210 shows Benesch Ord. 3844 App. Aug. 27, 1909 names Ave.
Map 1117 shows E St. or Lemon Grove Ave.
Map 1210 shows E St. or Lemon Grove Ave.
Map 424 shows Albert Hatfenden Aug. 27, 1887 68/495 Rec. Sept. 3, 1887.
Map 424 shows 35th.
Map 424 shows 34th.
Map 167 shows 33rd.
Map 167 shows 33rd. Rd.
Map 410 shows 33rd. Rd.
Map 167 shows 34th.
Map 167 shows 33rd.
Map 167 shows 33rd. Rd.
Map 167 shows 33.d
Map 167 shows 33.d
Map 167 shows 33.d

~~42~~

42-A

P.L. 1151

THE DELLS

MARKET

ST.

MC LAREN'S

H STREET

34TH

PARK.

ISLAND AVE.

SWAYNE'S PARK

G. H CRIPPEN'S

ADDITION

BANCROFT

J ST.

McLAREN'S LANE

REED

CENTRAL PARK ADDITION

ANNEX NO. 1 TO CENTRAL PARK ADD

SPRING GARDEN PLACE

K ST.

PARK

SPRING GARDEN

L ST.

TRACT

IMPERIAL AVE

IMPERIAL VILLAGE

Res. 94359, July 12, 1949 adopts map.

2476

GILETTE ST.

STEEL SUBDIVISION

MAP NO. 2178

STEEL ST.

DURANT

WEBSTER

P.L.

1160

AVE.

SHAFTER

TOMPKINS

SAN DIEGO MAP AND WETMORE

HOMESTEAD 362 SANBORN'S

UNION ADDITION

FRANCIS

PARDEE

AVE.

33RD

34TH

35TH

36TH

COMMERCIAL ST.

CEMETERY

NOTE: See next sheet for WABASH BLVD. R/W

39

51

43

Ord. 4901 (N.S.) Aug. 21, 1951 changes name from BANCROFT ST. to Federal Blvd.

7495-L Federal Blvd.

P.L. 1151

THE DELLS

MARKET ST.

ISLAND AVE.

J ST.

K ST.

L ST.

34TH ST.

35TH ST.

36TH ST.

BANCROFT

McLAREN'S LANE

SPRING GARDEN PLACE

SHAFTER "L"

TOMPKINS AVE

GILETTE ST.

STEEL ST.

IMPERIAL AVE

COMMERCIAL ST.

DURANT

WEBSTER

FRANCIS

PARDEE AVE.

McLAREN'S ADDITION

H STREET PARK

G. H. CRIPPEN'S ADDITION

SWAYNE'S PARK

REED ANNEX

CENTRAL PARK ADDITION

ANNEX NO. 1 TO CENTRAL PARK ADD.

SPRING GARDEN TRACT

IMPERIAL VILLAGE 2876

STEEL SUBDIVISION

MAP NO. 2178

SAN WETMORE

DIEGO AND

HOMESTEAD NO. 363 SANBORN'S MAP

UNION ADDITION

Res. 94359, July 12, 1949 adopts map.

6314-B

7245-L

STATE HWY XI-SD-283 (11-15-61)

7246-L

P.L. 1152

P.L.

1160

CEMETERY

41

42

See 42-A Also

Ⓐ H.C.& T.G. Kelley, June 15, 1928, Rec. July 26, 1928, Book 1508/49
Res. No. 46444, July 23, 1928 names Market St. 2-60
Ⓑ Acquired and named Market St. by Decree in Superior Court Case - City vs. R.I. Rankin et al No. 53621, Nov. 22, 1927, Rec. Nov. 22, 1927. 2-60
Ⓒ Luberco Ltd., Feb. 2, 1949 (Quit Claim Deed), Rec. Mar. 3, 1949, Book 3128/346 O.R.
Res. 92777, Feb. 15, 1949, names Market St. 2-60

Guy & Vera Karander July 9, 1929, Rec. July 22, 1929, 1666/43 Exc. 36789, July 15, 1929. names Grand St. 2-40

P.L. 1151

THE DELLS

MARKET ST.

Map 231 shows H Ord. 6371 Nov. 27, 1915 changes H St. to Market St.

Map 1172 shows H Ord. 3852 Feb. 19, 1908 names

Map 147 shows H

ST.

Ord. 3852 Feb. 19, 1908 names 5th Ave. Jan. 19, 1914 changes 5th Ave. between the N. line of Dells Park to 35th St. in the

Ord. 1752 Oct. 19 changes

See ⓒ Above
See Ⓐ Above
See Ⓑ Above

McLAREN'S ADDITION
Map No. 231
Jul. 27, 1887

H STREET PARK
Map No. 1172 Mar. 15, 1909

Ord. 704 (New Series) Aug. 2, 1935 names 34th St.

Map 231 shows I Ord. 10208 Nov. 12, 1925 changes I St. for entire length, to Island Ave.

ISLAND AVE.

Map 1172 shows I

Ord. 10208 Nov. 12, 1925 to Island Ave.

G. H. CRIPPEN'S ADDITION
Map No. 147
Oct. 31, 1888

Map 147 shows J

Map 231 shows J

Ord. 1752 Oct. 19 changes 38th St. to Granger St.

Ord. 1863 Oct. 18, 1909 dedicates Terrace

Brodrick, West, Lowndes, Le Terrace Sale Feb. 16, 1889 Rec. Oct. 23, 1909 Ord. 1165, Apr. 5, 1923 476/485 names McLaren Lane

Ord. 1752 Oct. 19, 1914 names Reed St.

Ord. 1752 Oct. 19, 1914 names Park Ave.

Ord. 1752 Oct. 19, 1914 names Central Ave.

Ord. 1752 Oct. 19, 1914 names Trail Ave.

Maps 327 & 382 show J Ord. 1752 Oct. 19, 1914 names

Maps 327 & 382 show K Ord. 1752 Oct. 19, 1914 names

Maps 327 & 382 show L Ord. 1752 Oct. 19, 1914 names

Maps 435 shows K

Maps 435 shows L

Maps 435 shows M

Maps 435 shows N Ord. 11301 Aug. 27, 1928 to Commercial St.

Map 1331 shows K Ord. 5375 Apr. 24, 1911 names

Map 1331 shows L Ord. 5375 Apr. 24, 1911 names

Map 1331 shows unnamed alley 3 Ord. 704 (New Series) Aug. 2, 1935 names alley 4 Spring Garden Place

Ord. 704 (New Series) Aug. 2, 1935 names alley 3 Spring Garden Place

Map 1331 shows M

Ord. 3857 Feb. 14, 1910 changes all of Cemetery Road Ord. 6981 Apr. 15, 1917 changes M St. to Imperial Ave. [See Misc. Drawing No. 3246]

Map 435 shows M

Ord. 704 (New Series) Aug. 2, 1935 names Imperial Ave.

Map 2178 shows

Ord. 704 (New Series) Aug. 2, 1935 names Imperial Ave.

Maps 276 & 363 show Shafter Ord. 3562 Jan. 19, 1922 to L St. (Map 363)

Maps 276 & 363 show Tompkins

Maps 276 & 363 show Hamilton Ord. 3562 Jan. 19, 1922 to Gilette St. (Map 363)

Maps 276 & 363 show Durant

Maps 276 & 363 show Pardee

Maps 276 & 363 show Francis

Maps 276 & 363 show Hoffman Ord. 3417 Jan. 19, 1914 changes 34th St. to 35th St.

Ord. 599 Feb. 7, 1899 (Map 276) changes 34th St. to 35th St.

Ord. 3417 Jan. 19, 1914 changes 35th St. to Pardee St.

Ord. 3417 Jan. 19, 1914 changes 36th St. to Peralta St.

Ord. 3417 Jan. 19, 1914 changes 37th St. to Paseo

Ord. 3417 Jan. 19, 1914 changes 38th St. to Granger St.

Ord. 3417 Jan. 19, 1914 changes 39th St. to Wenrich St.























