386

386

F.B. 386

386

MICROFILMED
DEC 10 1964

Book 3.86

2 246

~~46.5-8~~
Hub 2930 SE Bacon & SE
Stk. 39 40 NW " " "
80 ft Street are 20' SW
60" " " 12 " "

Monuments

12.27	Mon	NE Bacon & Newport
47.00	"	NW Niagara & Elder
48.84	"	N PS 205 (Empire Big Tree Ex & Fireside)
36.73	"	NE Del Monte & De Forest
28.87	"	SW Orchard & De Forest
79.01	"	Mendocino & Voltaire

Benches on Voltaire (Obliterated)

45.00	Spike in Pole	NW Fonda
31.04	"	NW Elder
26.14	"	NW De Forest
17.69	"	" Cable
10.81	"	" Bacon
6.50	Scribed Walk	at Pt & "

217.48	NE Mon	Del Monte & Emerson
2 24 13	SE "	" " "
167.54	Top of Punch in 6x6	Del Monte
28.30	SE Mon	Santa Cruz & Bacon
131.17	Spike in Big Post	Standing Fence Emerson
60.43	" " "	" " near Fonda
195.66	Mon	NE Newport & Santa Barbara

Tie Points for Ocean Beach

Edinburgh Scenic Polygonal

(cut)

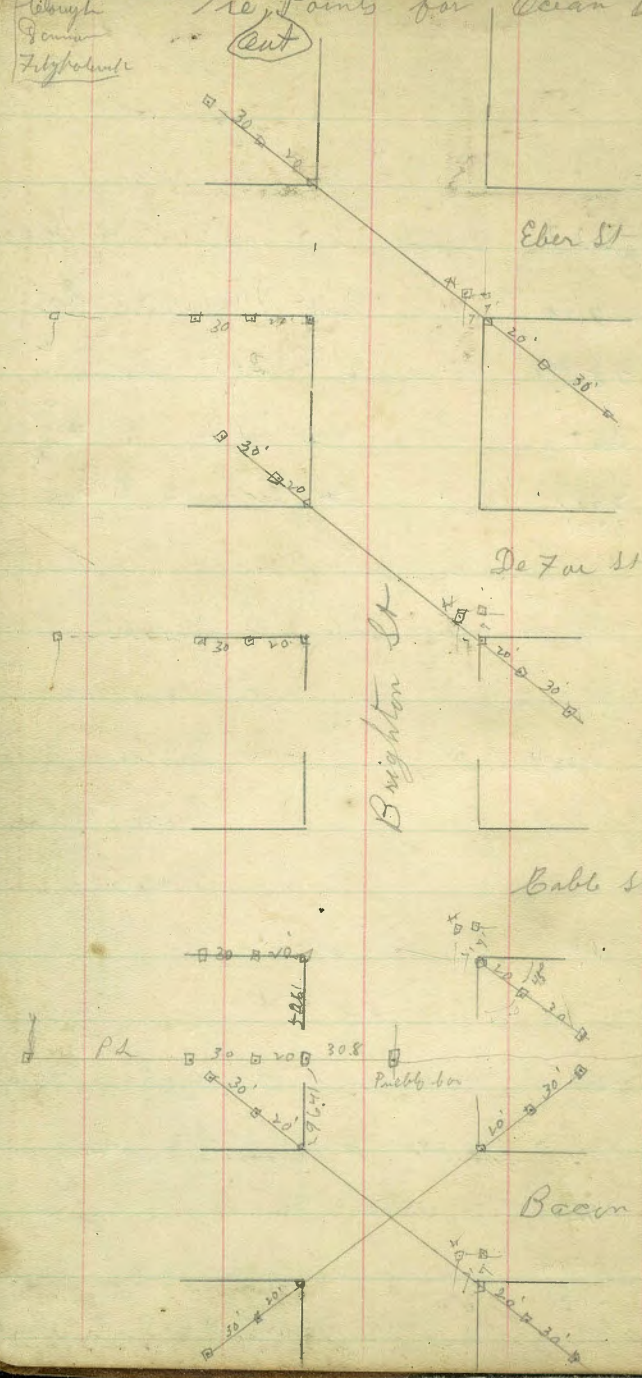

2

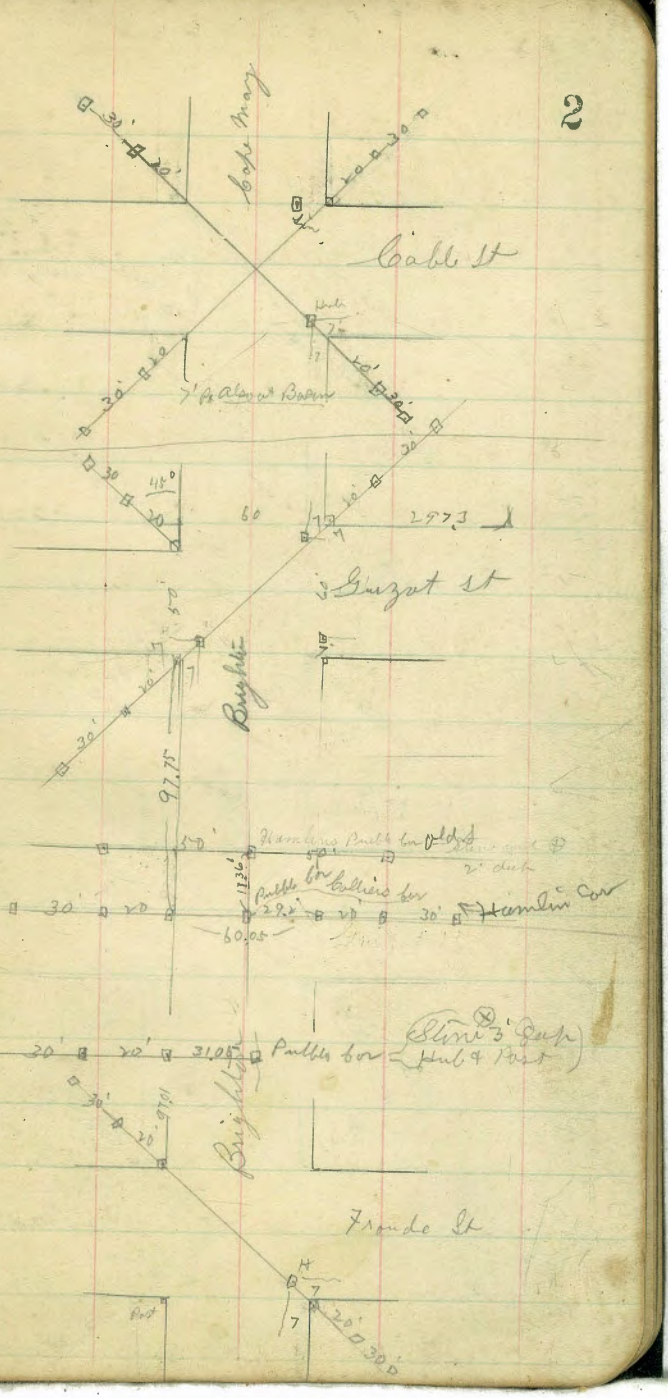

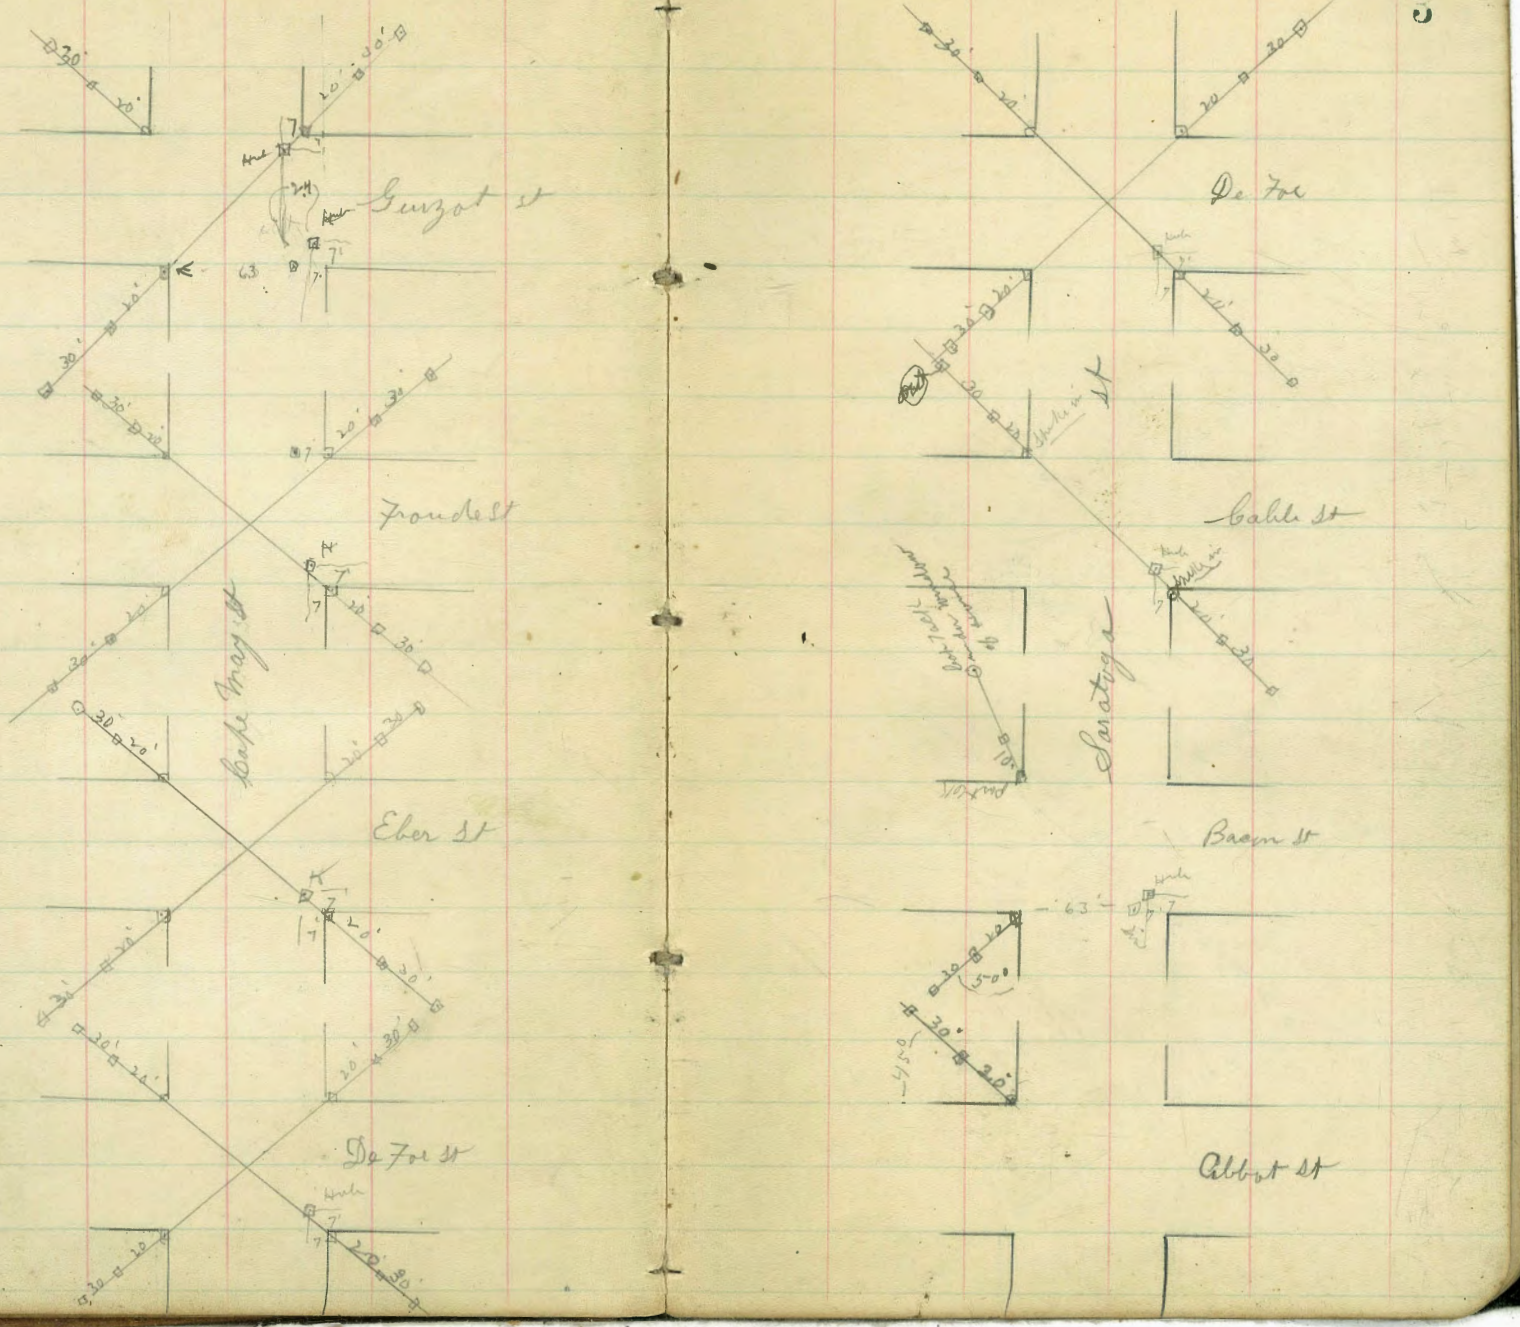
Guizot st
Froude St
Eber St
De Foe St
De Foe
Cable St
Saratoga
Baeon St
Abbot St

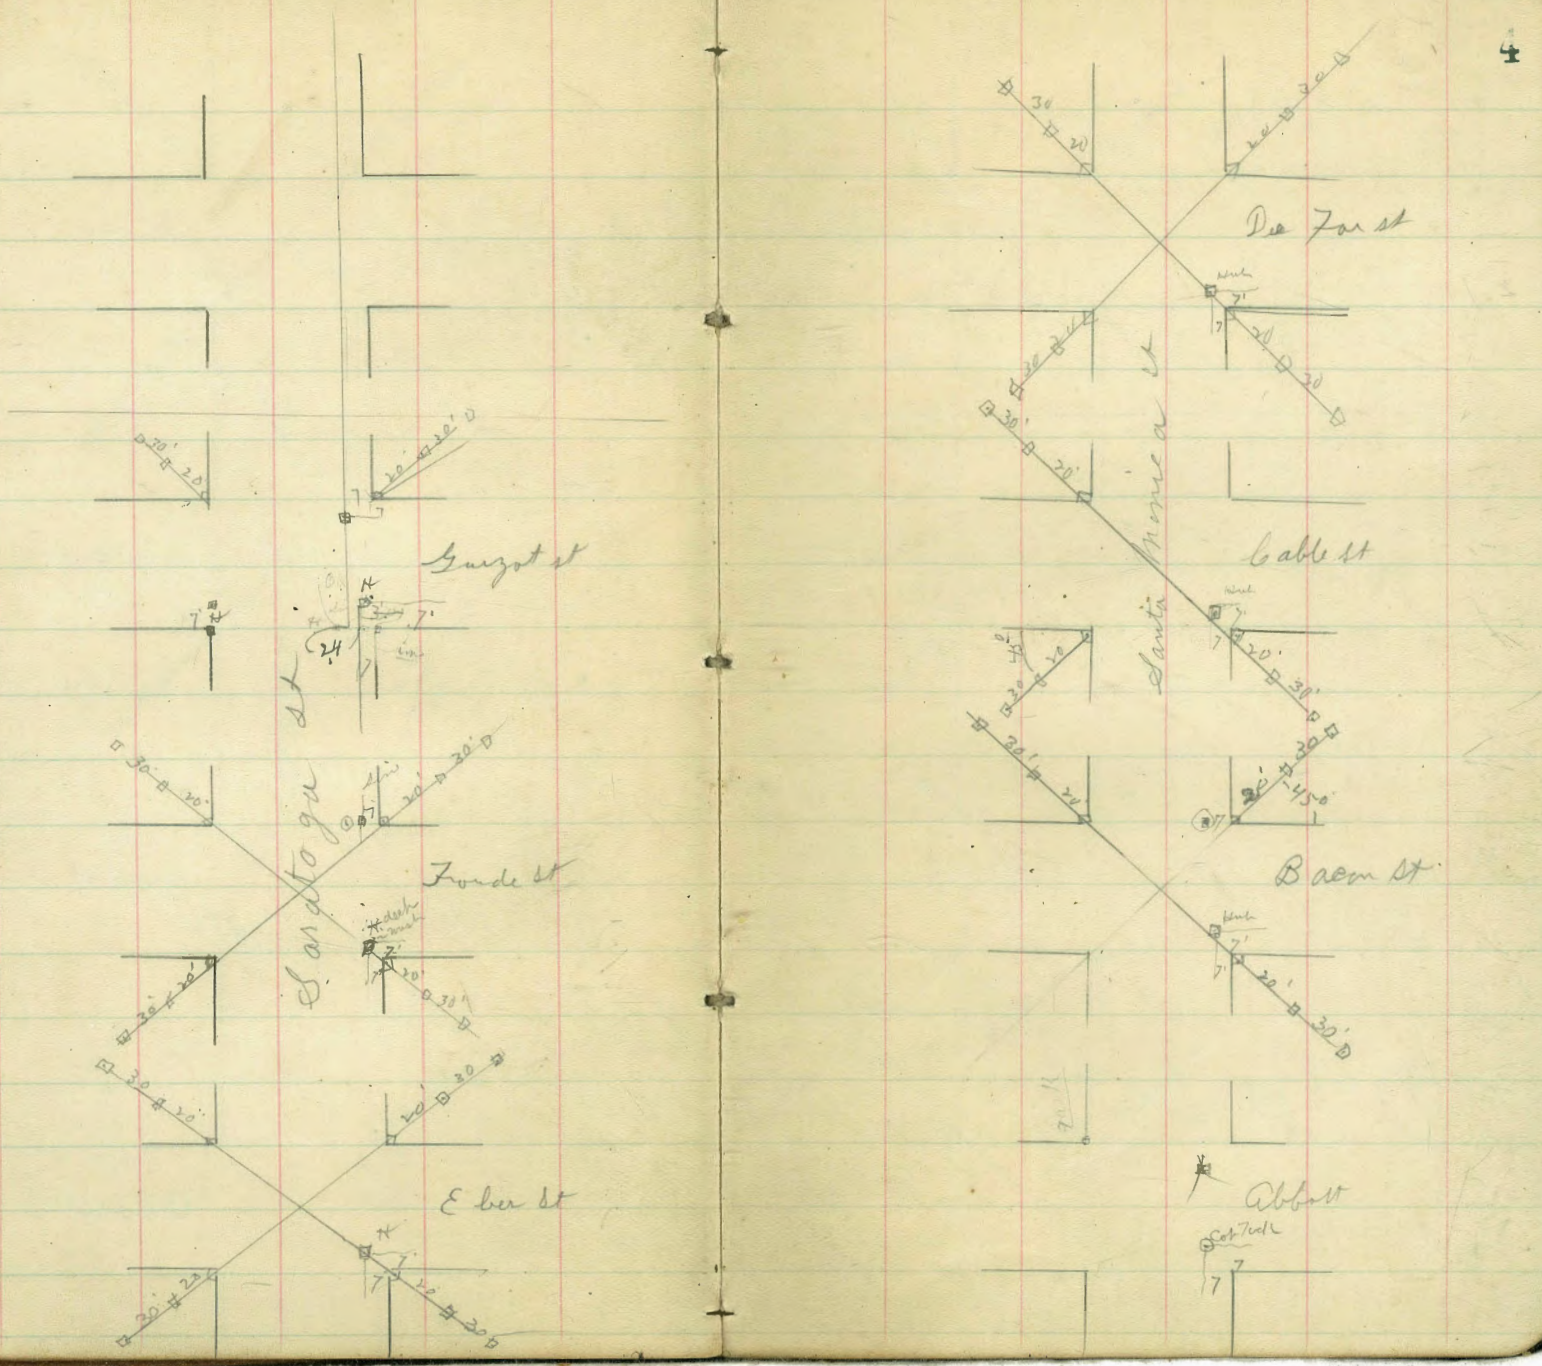
Guizot st
Fonde st
Eber st
Des Forest
Cable st
Baem st
Abbott

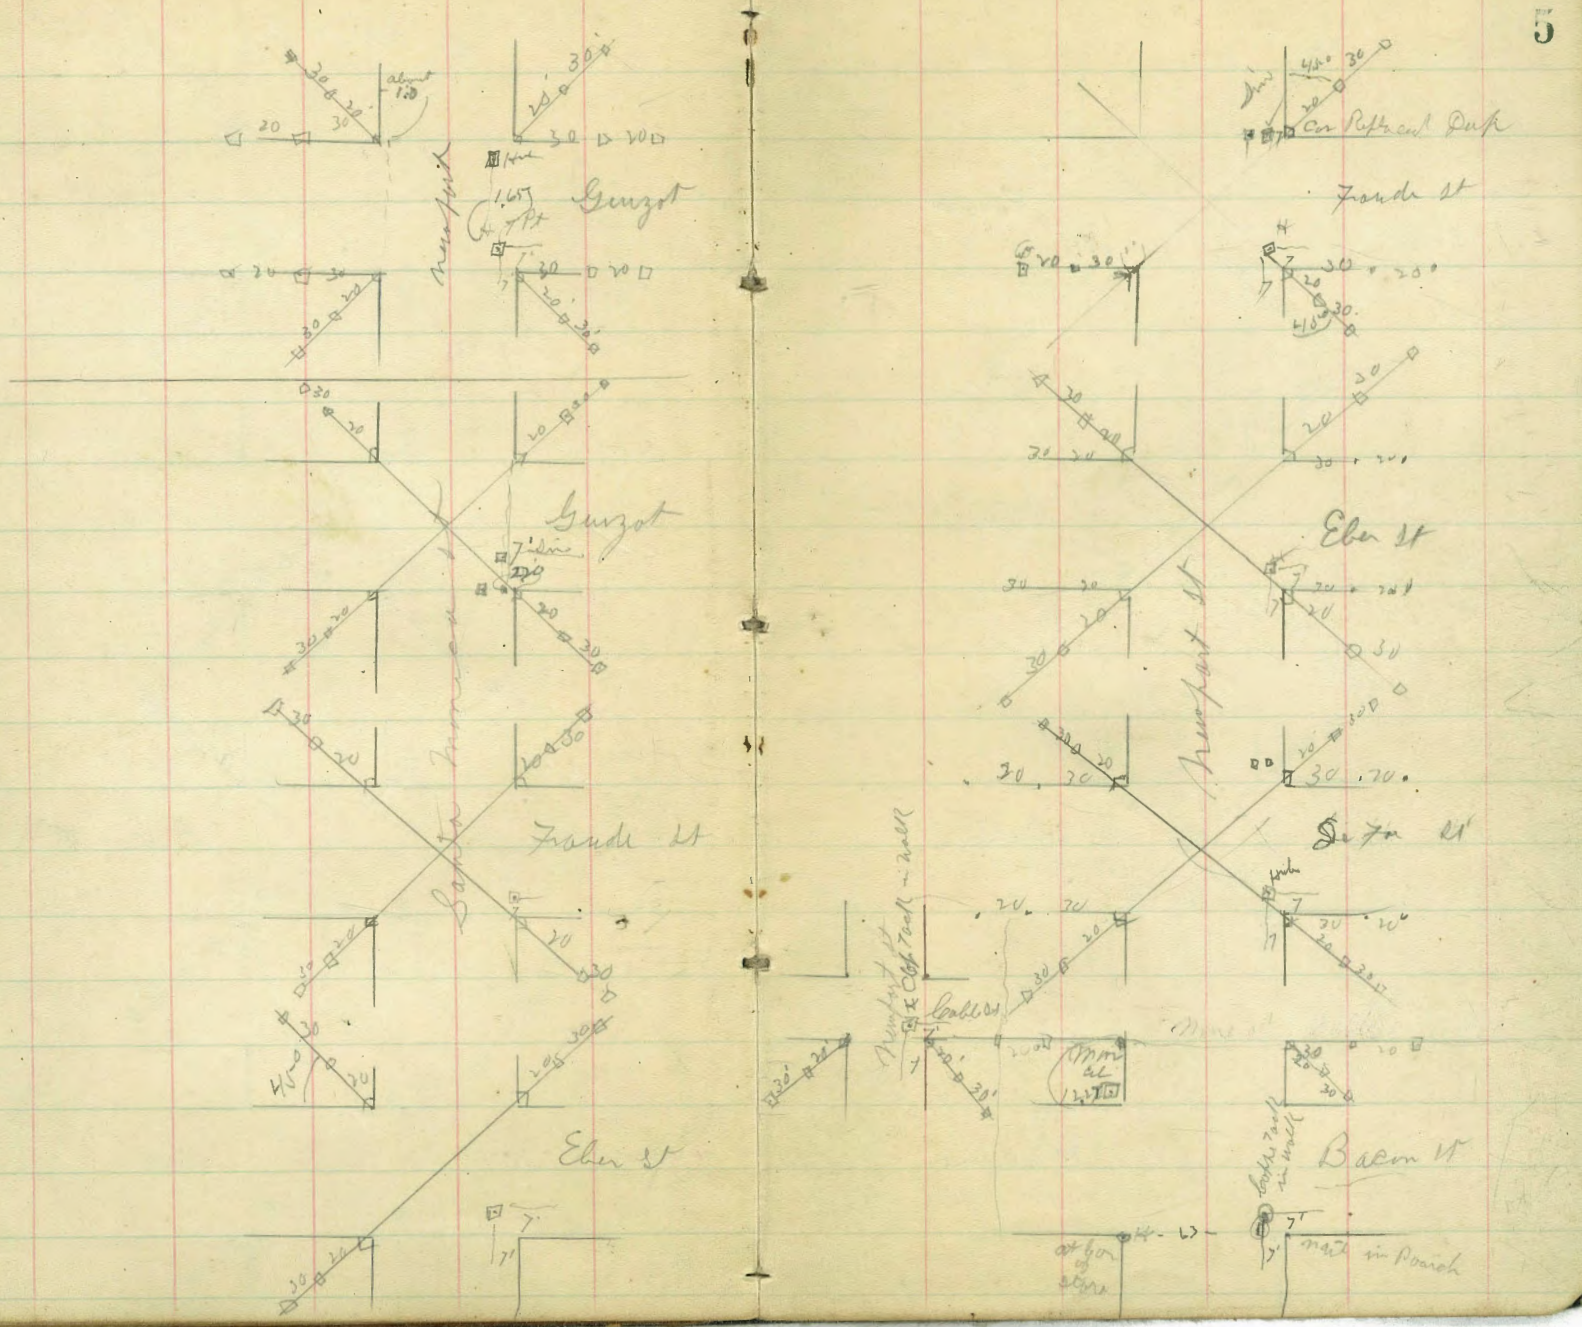
Guzot
Eber St
Baer St

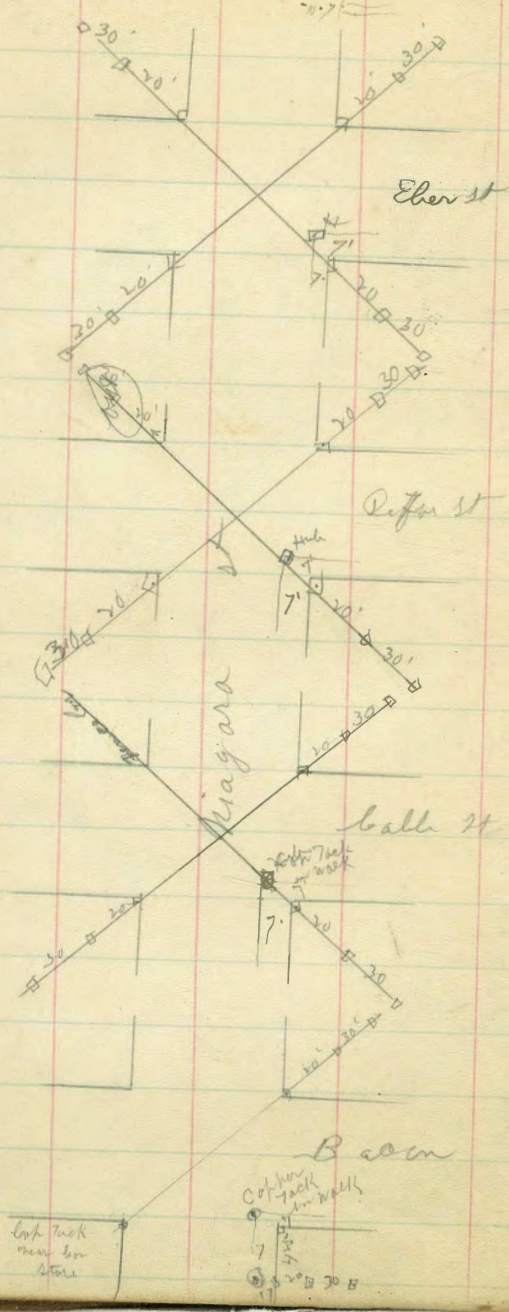
Eben st
Niagara
Cable st
Room

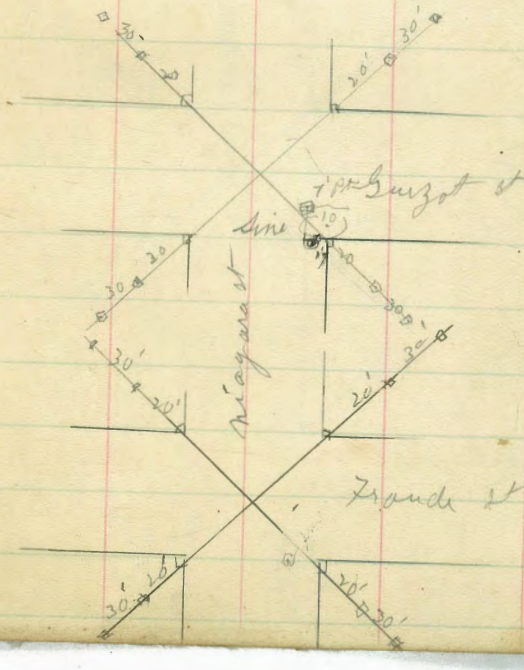
Guizot st
Niagara st

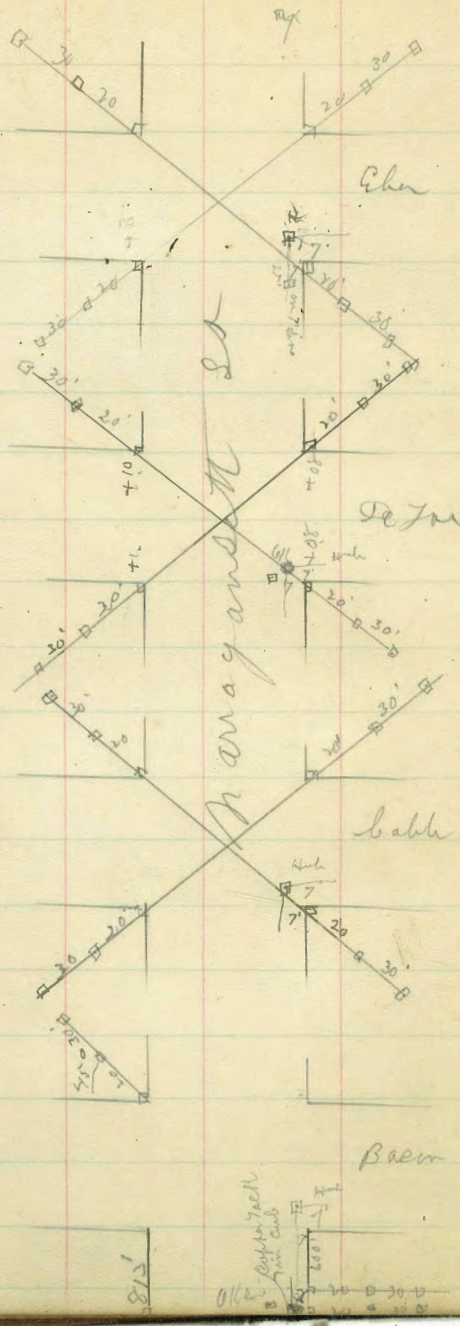
Elm
De Jon
Cable St
Baen

Guizot St
Trouch St

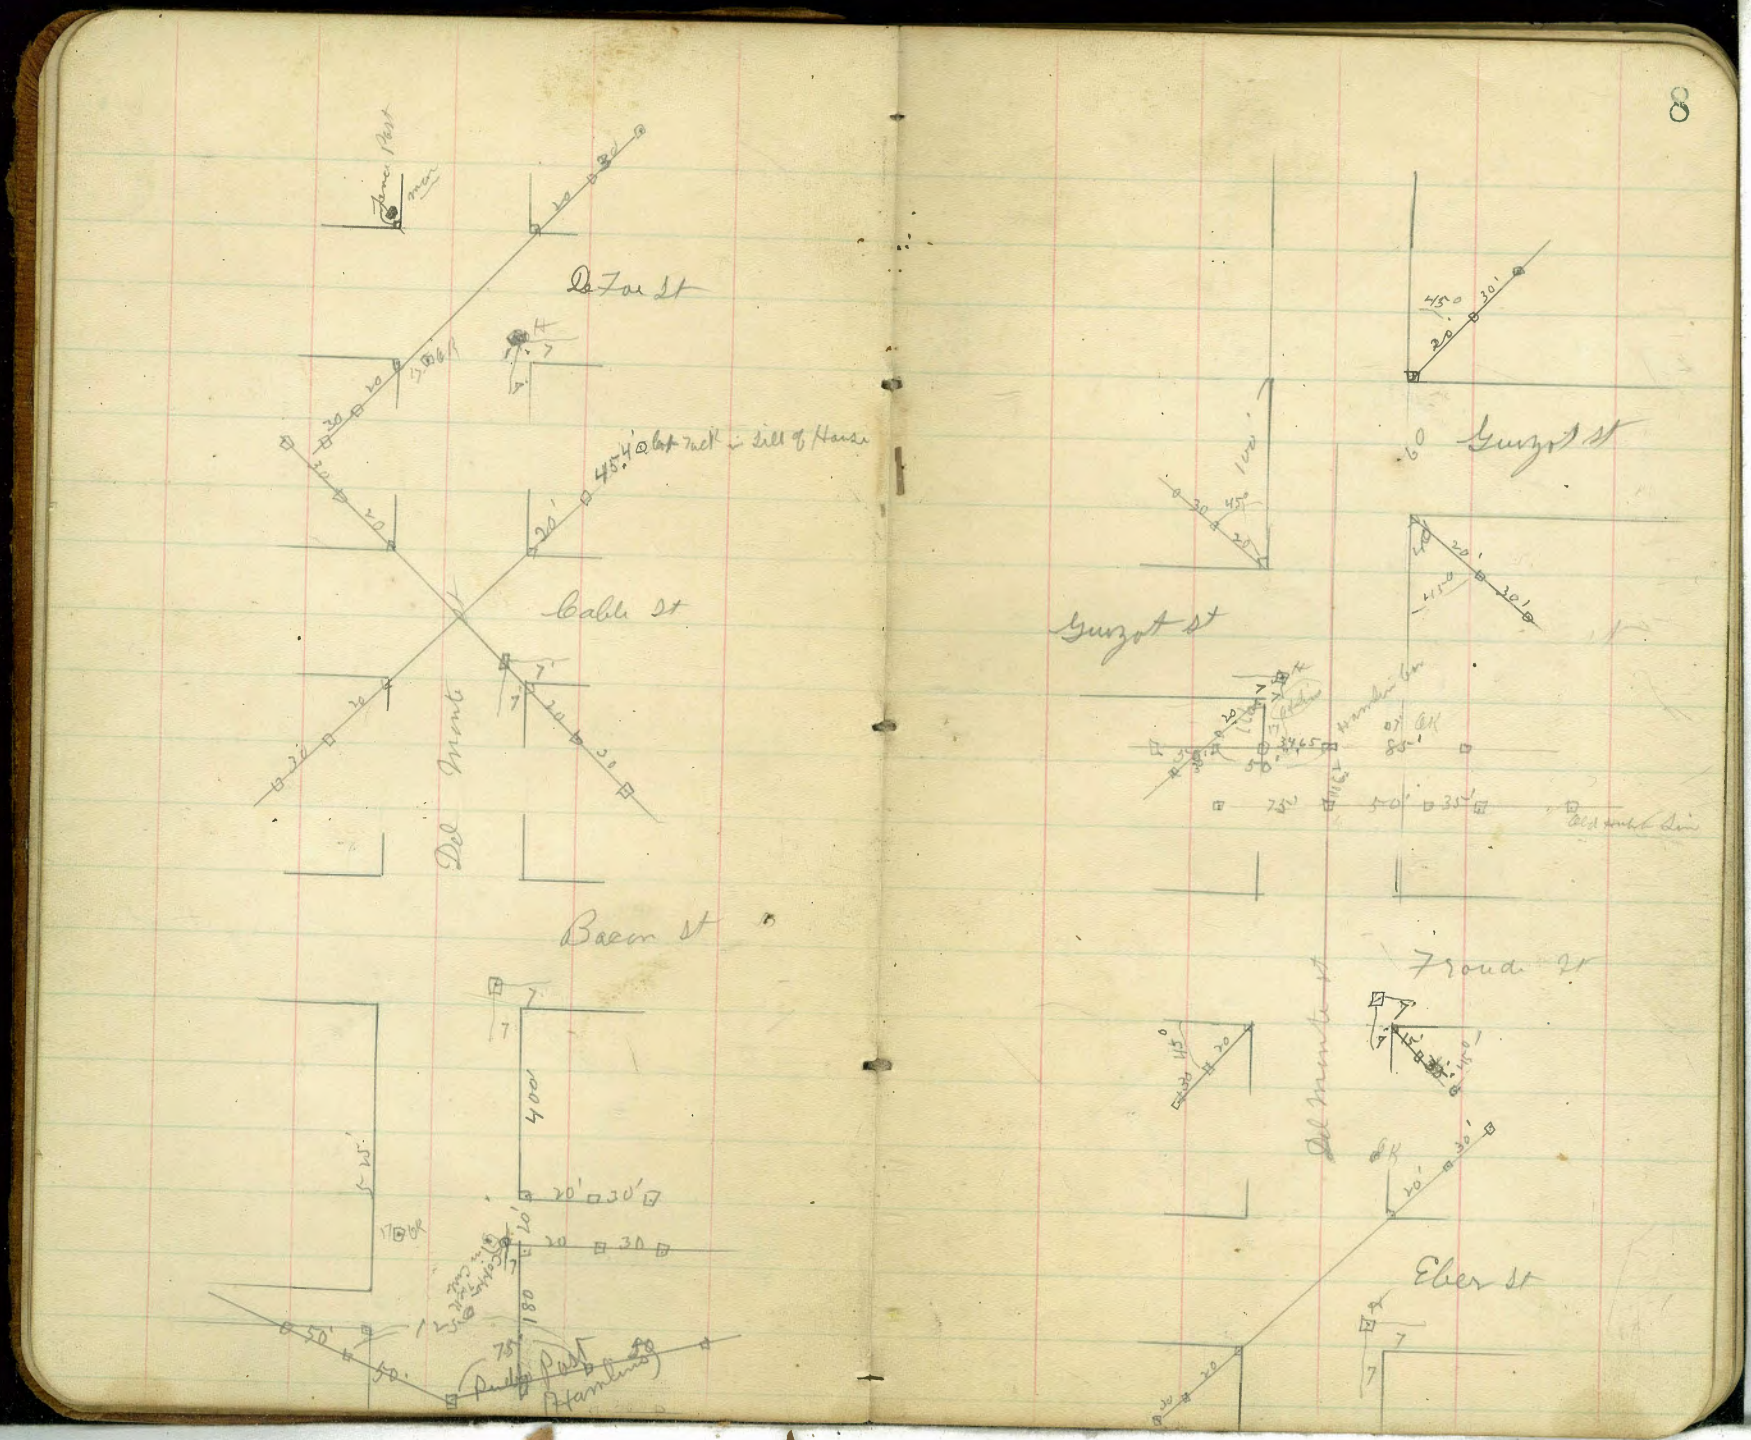
De Fair St
Cable St
Del Monte
Bacon St
Guzzet St
Guzzet St
Del Monte St
Froud St
Elder St
Pueblo Post

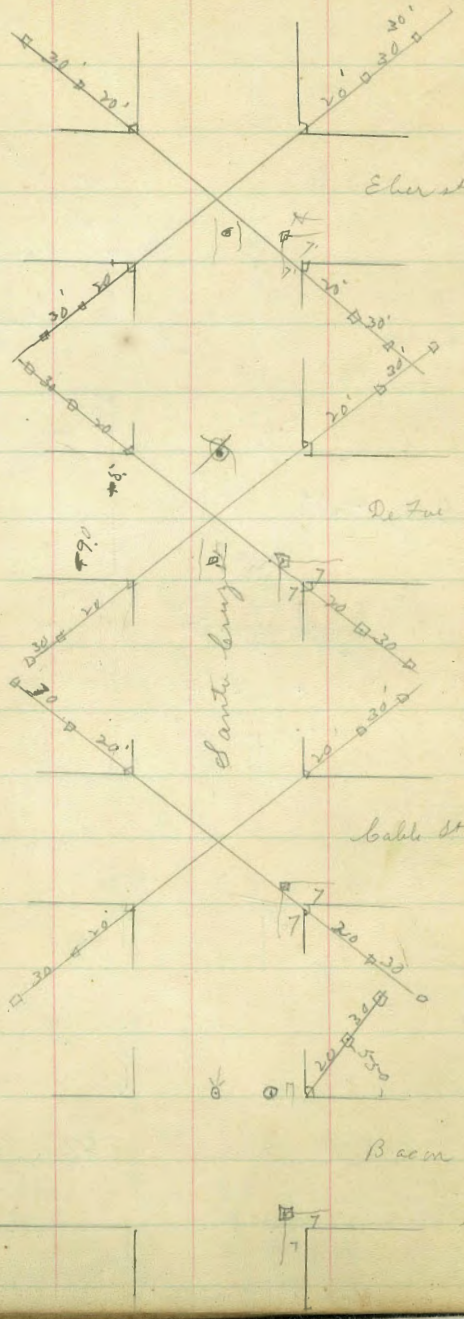
De Fee st
Santa Cruz st
Cable st
Beam st

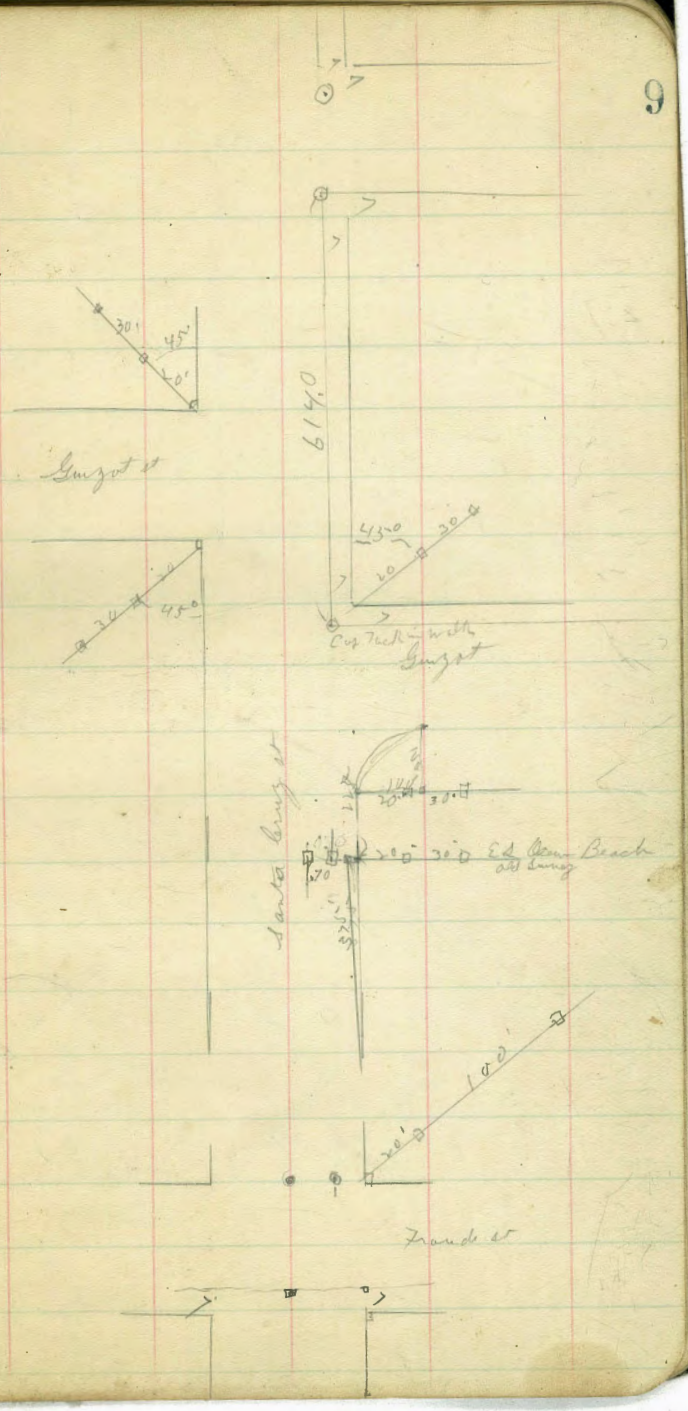
Gurgot st
Santa Cruz st
Ed Ocean Beach

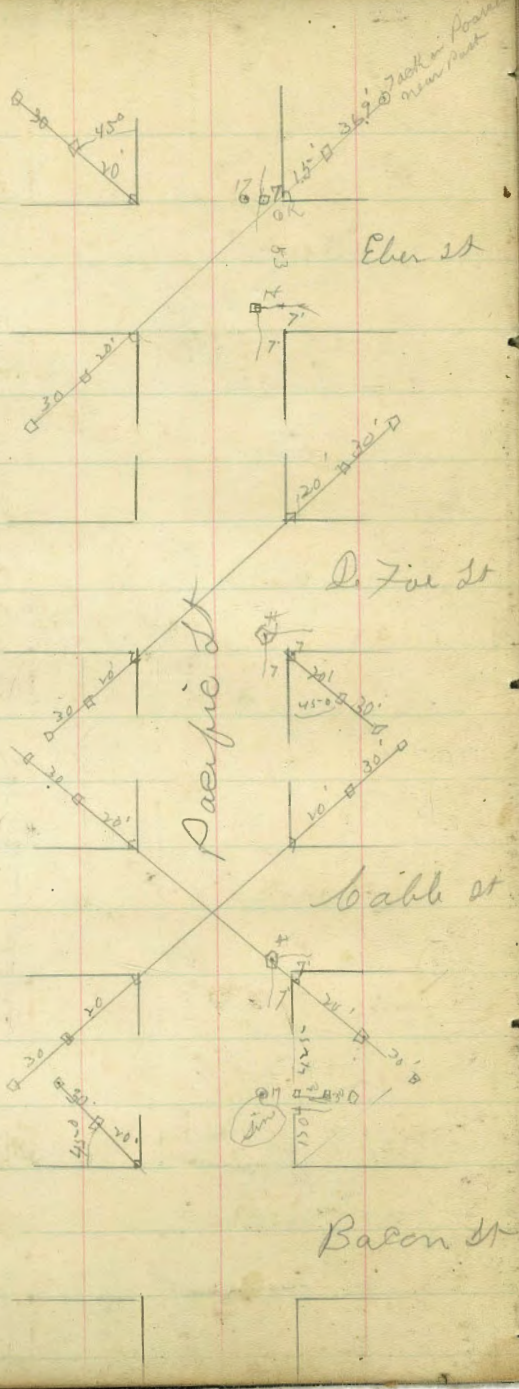
Eber st
D. Fir st
Pacific st
Cable st
Bacon st

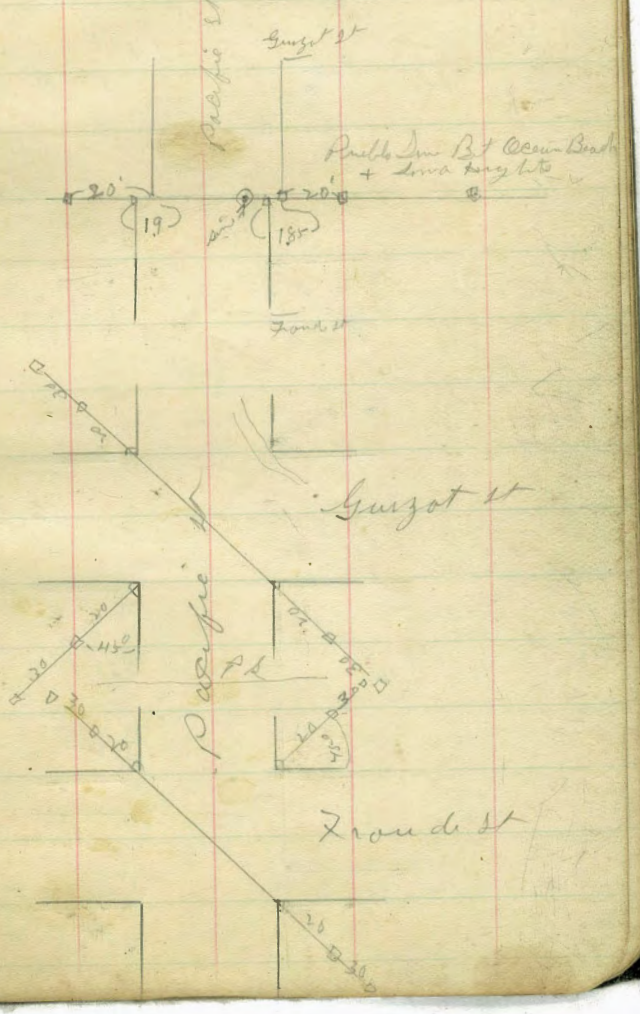
Guyot st
Pacific st
Public Sq. B.t Ocean Beach + Lona Long Lots
Guyot st
Pacific st

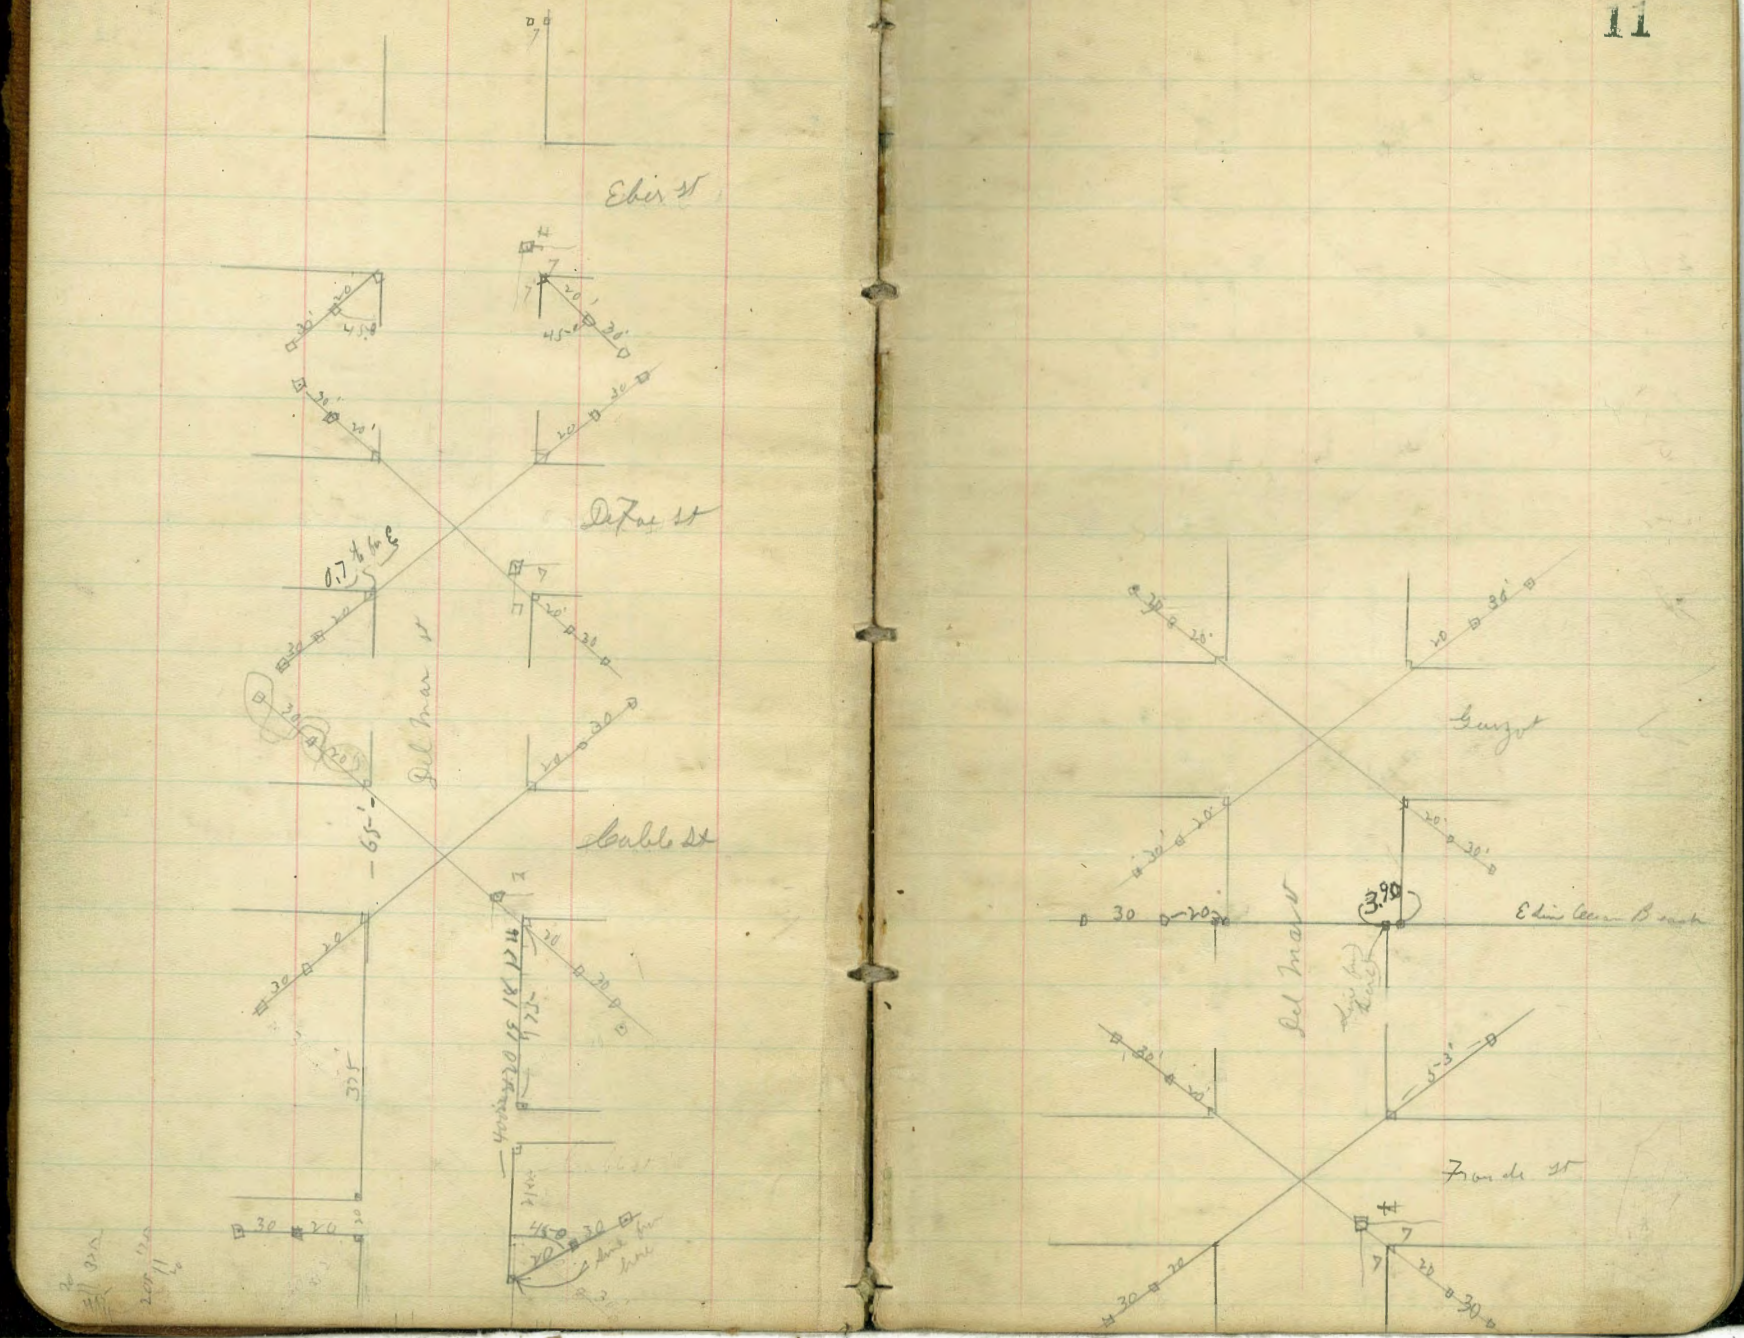
Ebert St

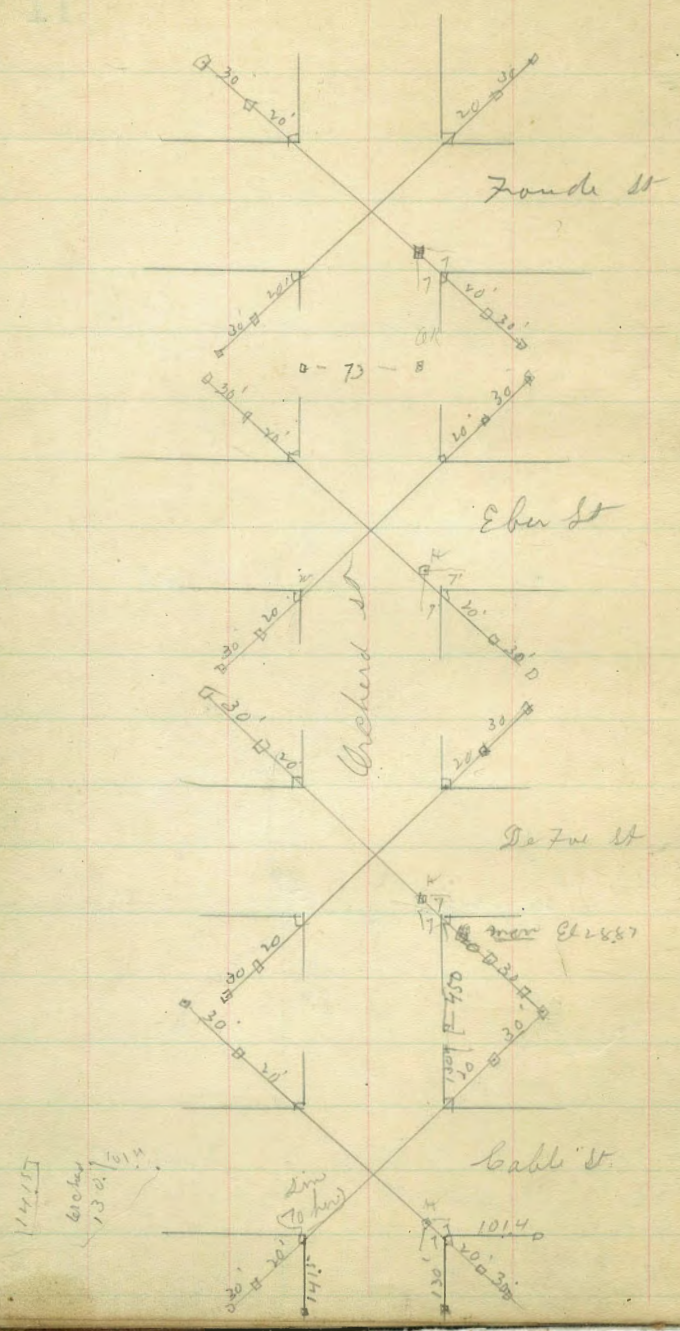
Eber St
Orchard St
De Fur St
Cable St
Elev 1887
101.4
Elev (70 feet)

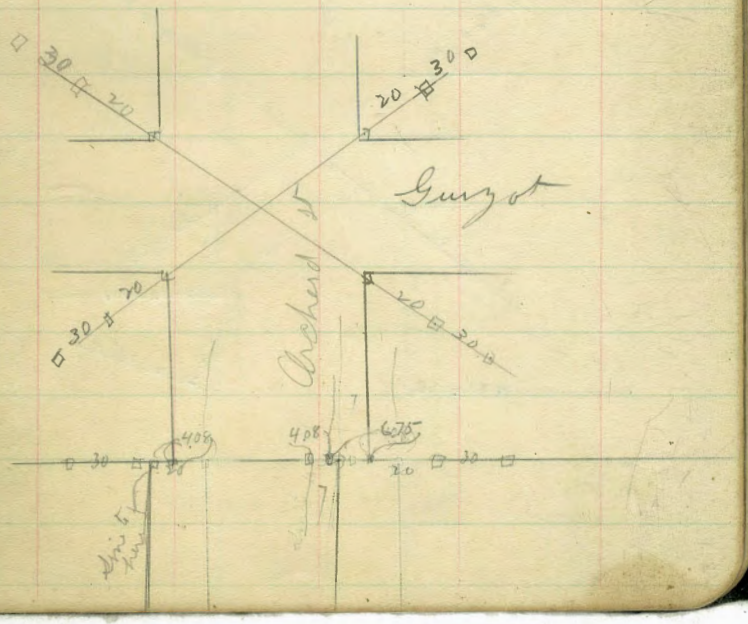
Guizot
Orchard St
4.08
6.75

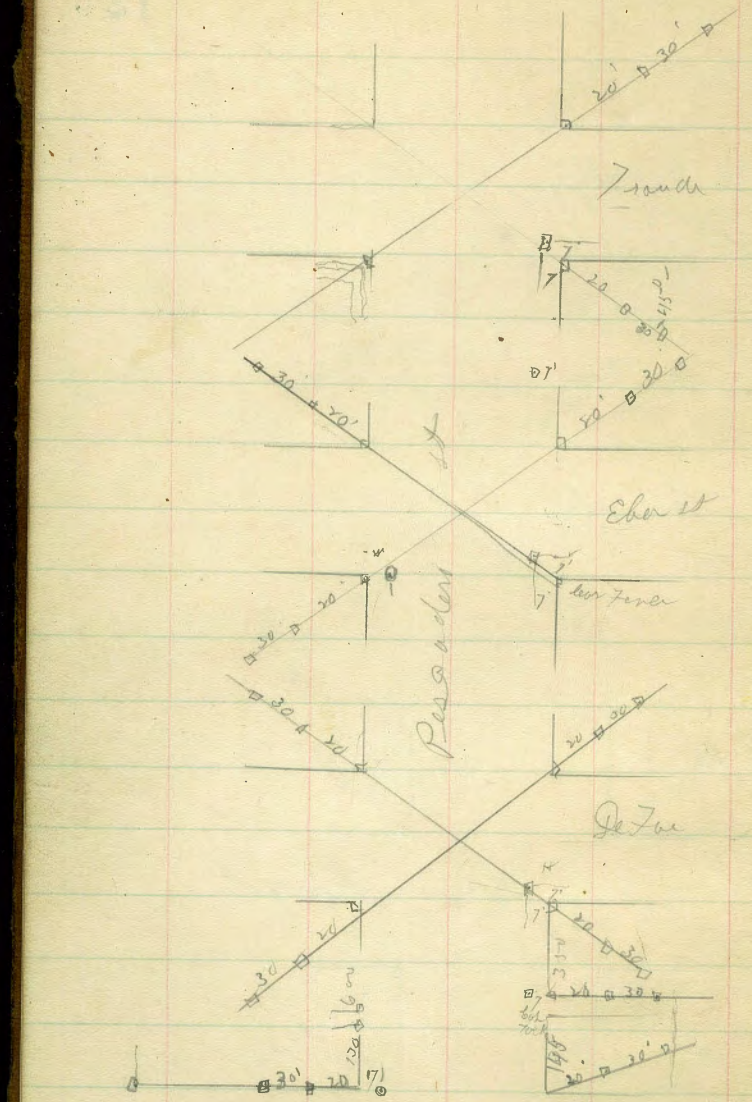

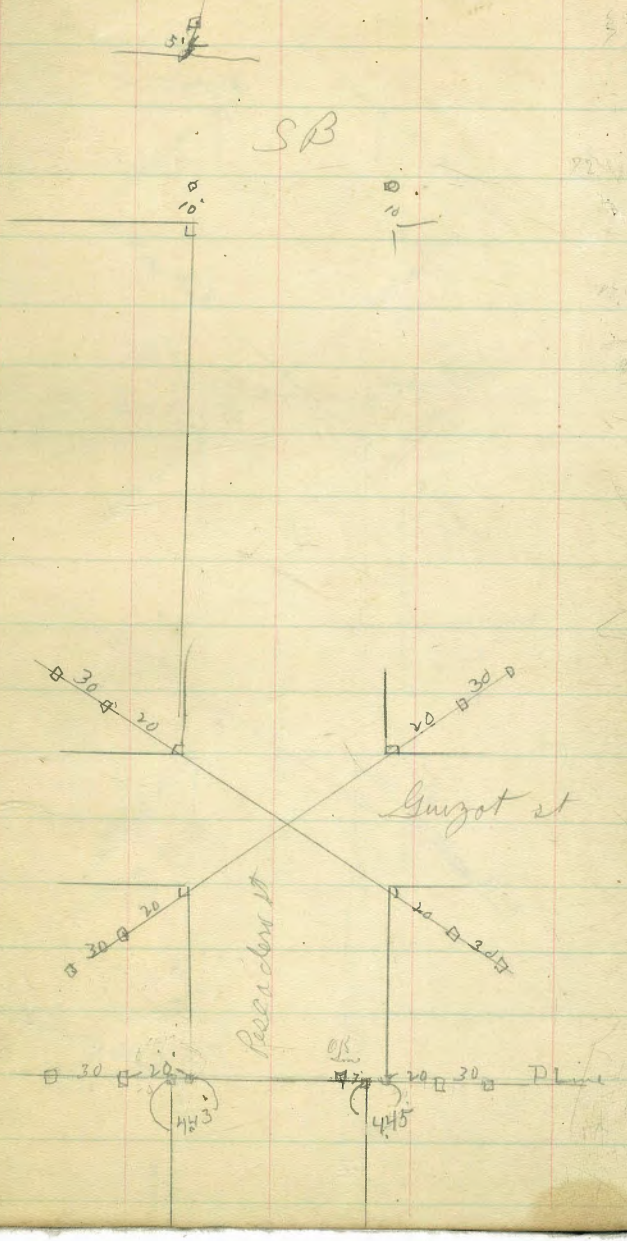
SB
Guizot st
Pl

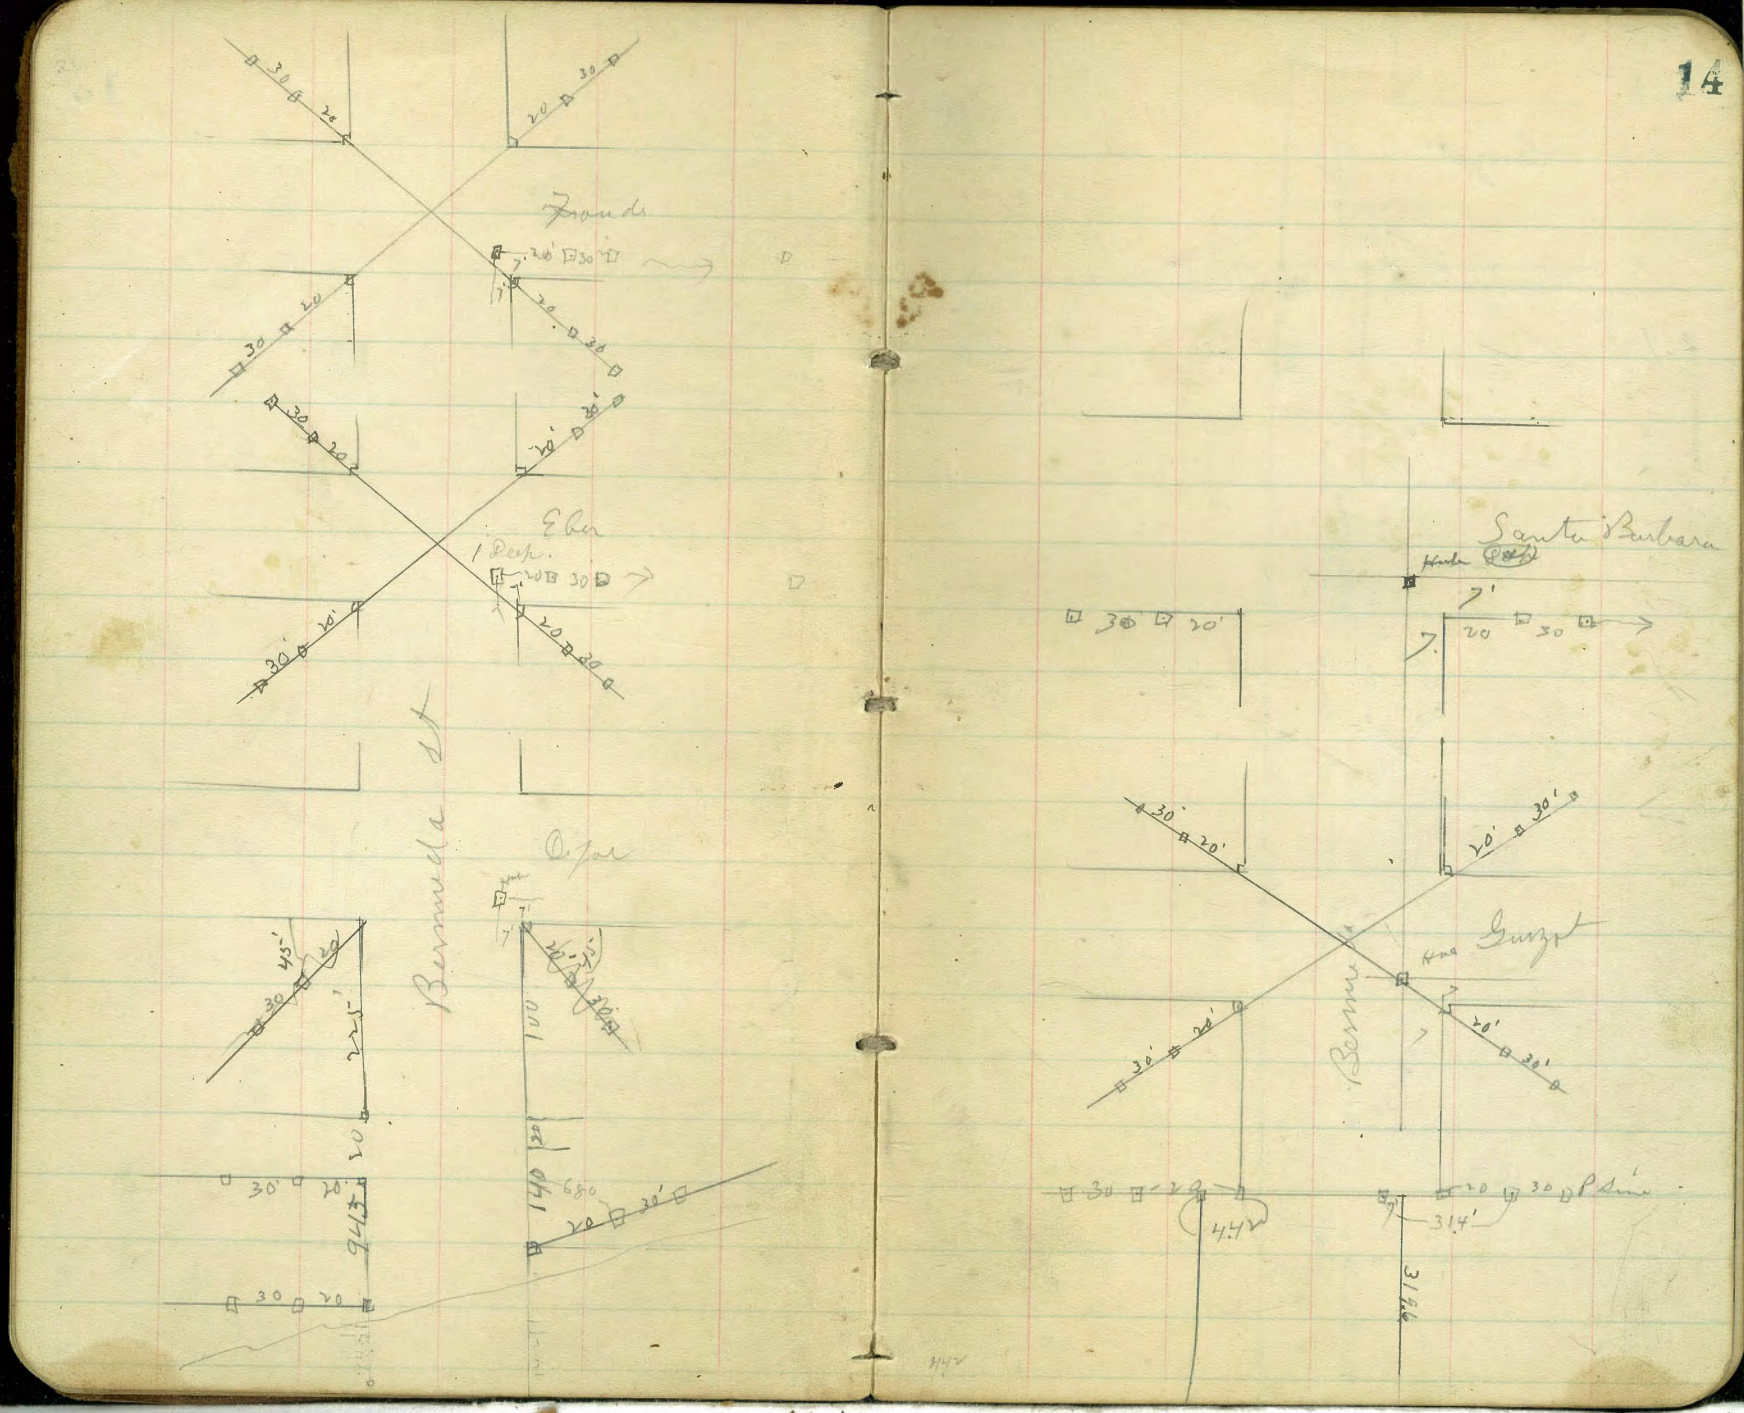
Fronde
Eber
1 Desp.
Bermuda dt
Oyar
Santa Barbara
Gurzt
Bermu
4.42
3.14'
3.14'

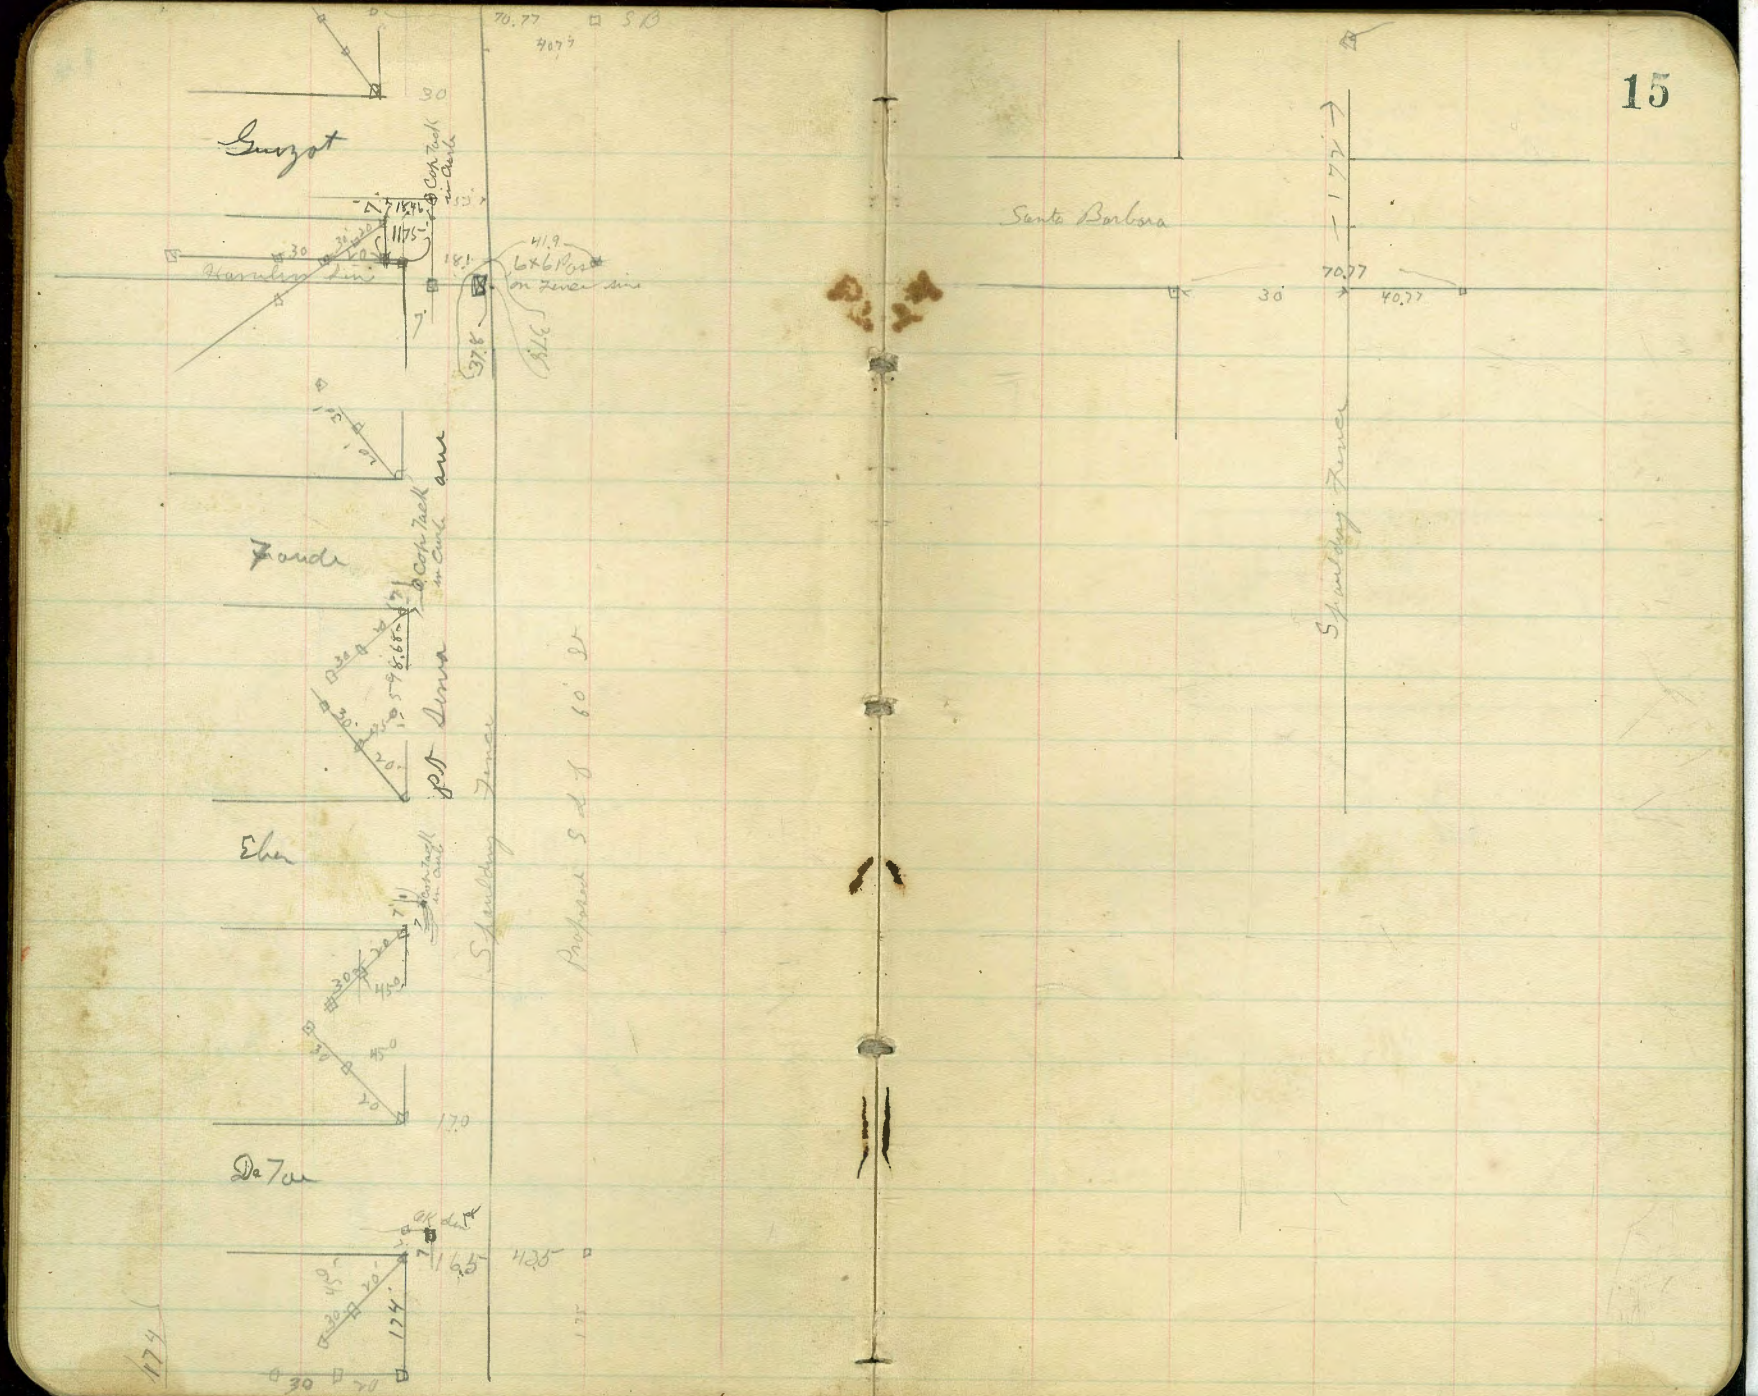
Guizot
Harding Ave
Cor. Tack in Curb
1175'
1496
141
41.9
6x6 Post on Zero line
378'
Zonda
Cor. Tack in Curb
Ave
Lorna
Pl
Schoolboy Terrace
Professor S. Pl
Eber
Cor. Tack in Curb
45°
170
De Zon
Cor. Tack
1165'
1125'
174'
30
Santa Barbara
70.77
40.77
30
Schoolboy Terrace

12/29/11 Clough Demma Fels

Survey for Openny &
Long Beach St through
Ocean Beach No 1

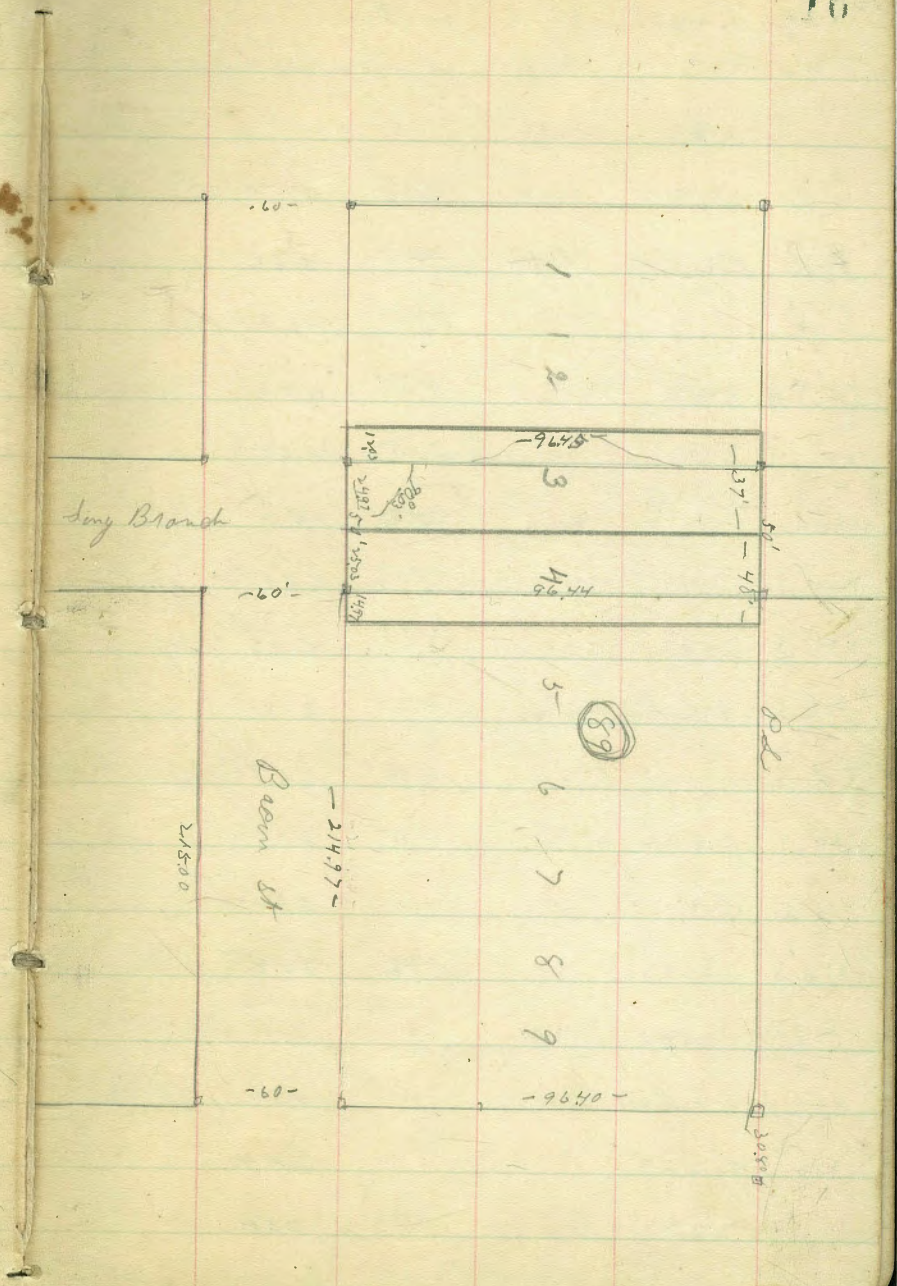

Followed Levels over Street Ry in Ocean Beach
July Brighton St to De Fal

	1.41	12.22		10.81
	5.44	11.06	6.60	5.62
N 2	Brighton St (80)		5.44	5.62
S 2	"	"	5.45	5.61
50' S of	"		5.35	5.71
100' S of	"		5.25	5.81
150' S	"		5.10	5.96
200' S	"		4.95	6.11
250' S	"		4.70	6.36
300 S = N 2 bet. May (80)			4.35	6.71
S 2	"	"	4.38	6.68
50' S of	"	"	4.35	6.71
100' S of	"	"	4.15	6.91
150' S	"	"	3.91	7.15
TP	5.37	12.54	3.91	7.15
200' S of	Cape May		5.30	7.24
250' S of	"	"	5.10	7.44
300' S = N 2 Saratoga (80)			5.00	7.54

12.54

S Lin of	Saratoga		4.75	7.79
50' S of	"		4.55	7.99
100' S of	"		4.30	8.24
150' S of	"		4.15	8.39
200' S of	"		3.91	8.64
250' S of	"		3.75	8.79
300' S = N 2 of Santa Monica (80)			3.55	8.99
TP	6.76	16.96	1.74	10.80
S Lin of	Santa Monica		7.55	9.41
50' S of	"	"	7.10	9.86
100' S of	"	"	6.60	10.36
150' S of	"	"	6.15	10.81
200' S of	"	"	5.70	11.26
250 S of			5.15	11.81
300' S = N 2 of Newport (80)			4.75	12.21
S 2 of	"		4.55	12.41
50' S of	"		4.55	12.41
100' S of	"		4.45	12.51
150 S of	"		4.30	12.66
200' S	"		4.20	12.76
TP	7.57	20.21	4.20	12.76

20.31

250' Sof Newport		7.45	12.86
300' S = h2 of Nragansett (80)		7.40	12.91
S 2 of	"	6.35	13.96
50' Sof	"	5.65	14.66
100' Sof	"	4.90	15.41
150' Sof	"	4.10	16.21
200' Sof	"	3.40	16.91
250' Sof	"	2.70	17.61
300' S = h 2 of Narragansett (80)		1.90	18.41
TP 8.10 26.50		1.91	18.40
S 2 of Naragansett		7.15	19.35
50'	"	6.35	20.15
100' S of	"	5.60	20.90
150' S of	"	4.90	21.60
200' S of	"	4.05	22.45
250' S of	"	3.30	23.20
300' S = h 2 of Del Monte		2.50	24.00
S 2 of	" "	1.50	25.00
TP 7.30 32.28		15.2	24.98
50' S of	"		

32.28

50' S of Del Monte		6.65	25.63
100' S of	" "	6.00	26.28
150' S of	" "	5.30	26.98
200' S of	" "	4.70	27.58
250	"	4.10	28.18
300' S = h 2 of Santa Cruz		3.35	28.93

Rail is 6.5 from Prof Corner
In Center of Track Sec Book —
X sec of Bacon St

50' E of Bacon		3.3	28.98
100' E of "		3.5	28.78
TP 3.59 32.39		3.48	28.80
150' E of Bacon		3.95	28.44
200' E "	"	4.20	28.19
250' E "		4.45	27.94
300' E "		4.70	27.69
350' E "		4.95	27.44
400' E "		5.20	27.19
450' E "		5.10	27.29
500' E "		5.00	27.39

3239

530'	E of Basin		4.50	27.89
600'	E = W 2 bolts W (60)		3.90	28.49
	E 2 of bolt W		2.90	29.49
TP	11.62	4.14	2.87	29.52
50'	E of bolt N		10.3	30.84
100'	E " "		9.0	32.14
150'	E		7.5	33.49
200'	E of "		6.30	34.84
250'	E "		4.90	36.24
300'	E "		3.60	37.54
350'	E "		2.10	39.04
400'	E "		0.50	40.64
TP	13.08	5.32	0.50	40.64
450'	E of bolt		11.30	42.42
500'	E " "		9.0	44.72
530'	E of "		5.25	48.47
600'	E = W 2 of Dia Tree N		1.20	52.52
	6.46	5.9.46	.72	53.00
	E Line N Dia Tree W		27	57.26

5/13/13 Contd Survey for Street inside Standley Fence
Tuesday
Feby 5. Line of Ocean Beach

20

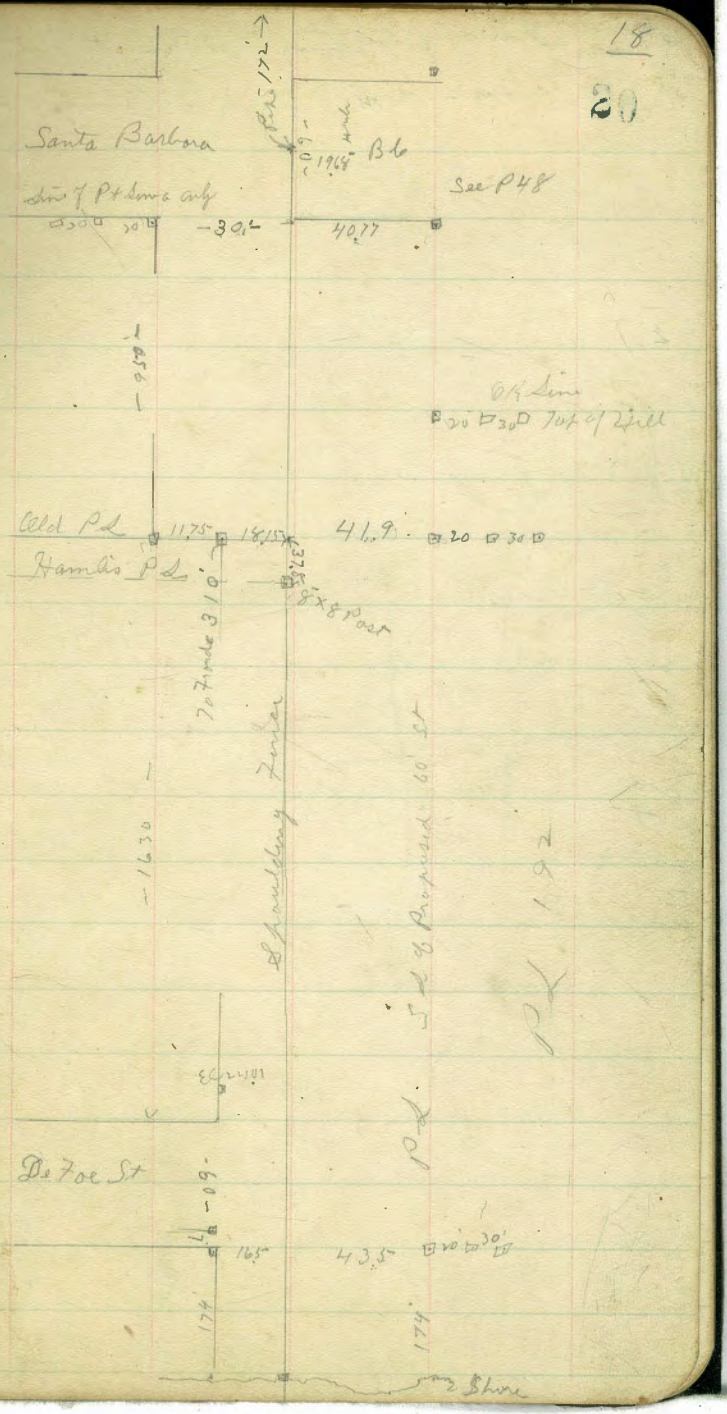

8/11/13 Chas Taylor Esq

Survey for opening Voltaire St through Loma Villas to Chatsworth Blvd

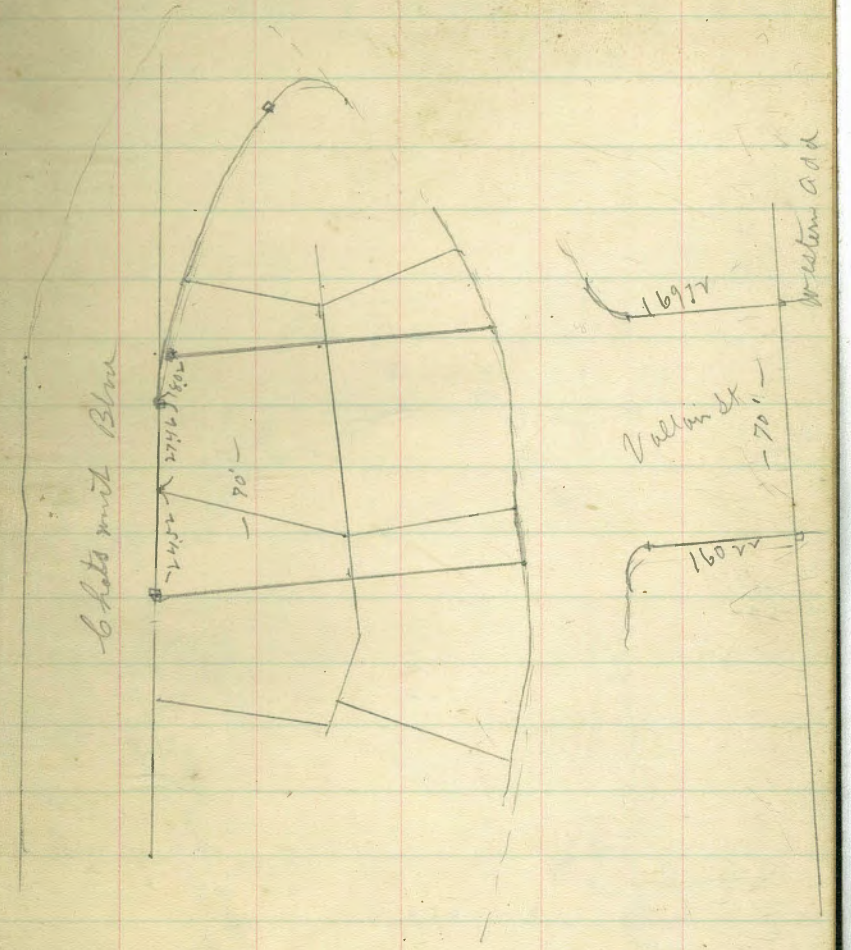

Survey of a part of Pd 106 (20)

for Mr Noble

9-26-13 Colonel Taylor Atty

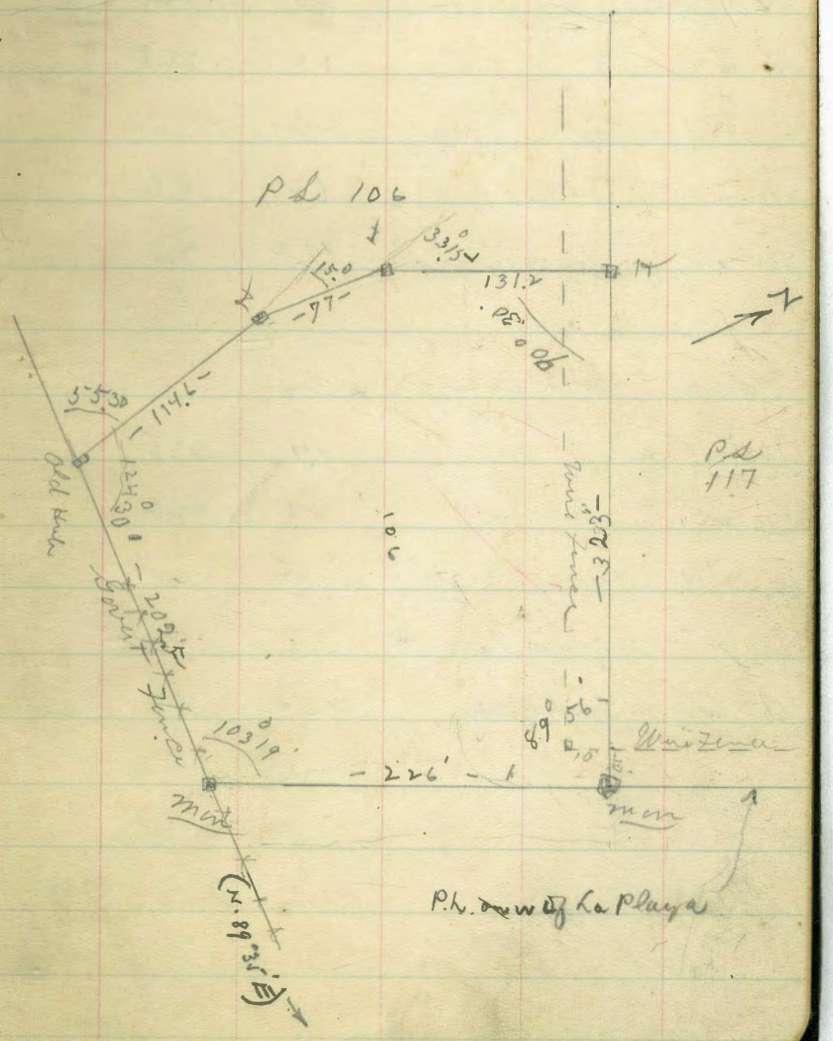

9/29/13 Clough Taylor Ely

Levels for Drains at End of Point Loma Ave

28

	0.80	24.81		24.01
North Catch Basin (end Line)				
171' W of D Tm			2.9	22.0
185' W "			2.1	22.8
TP	0.0	13.41	11.50	13.41
200' W of D Tm (on Sand Rock) ⊗			6.8	6.6
205' " " (on Lower side of rock)			11.2	2.2
		24.81		
S Catch Basin (end Line)				
165' W of D Tm			1.4	23.5
170 W "			2.0	22.0
TP	0.0	13.41	11.50	13.41
180 W " (on Sand Rock) ⊗			9.0	4.4
185' W " on Sand Bank			13.04	0.4

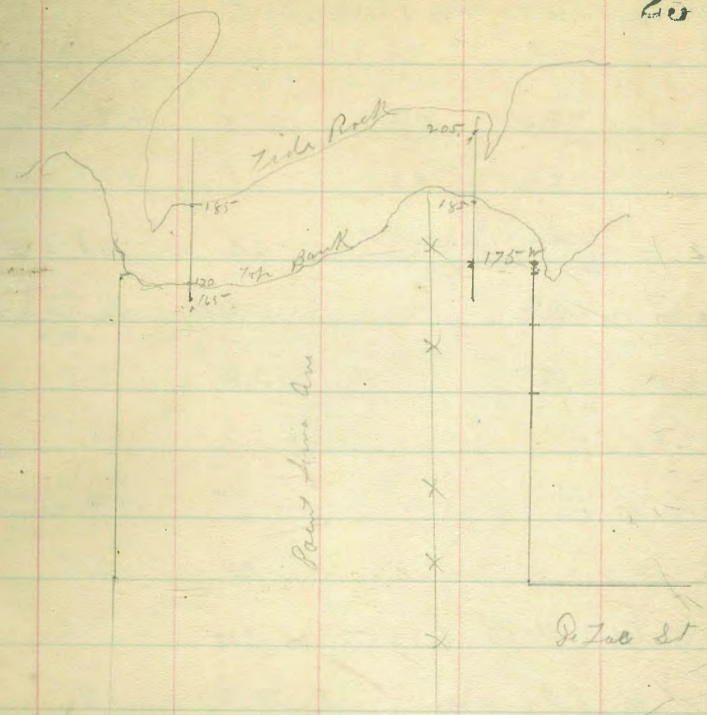

9/29/30 | Clough / Taylor / Lutz | Levels on Strut Bar Track (Macauley Rosecrans to Evergreen

		7.10	13.21		6.11
		6.95	16.11	4.05	9.14
00' =	W Lin of Rosecrans St / Center Macauley St Rail			6.0	10.1
50' W on N Rail				5.0	11.1
100' W	"			3.8	12.3
150' W	"			2.6	13.5
200' W	"			1.5	14.6
250' W	"			0.3	15.8
TP		10.08	25.91	0.8	15.83
300' W = E L Locust St (70')				8.8	17.1
W L of Locust				7.0	18.9
50' W of Locust				5.5	20.4
100' W	"			4.0	21.9
150' W	"			2.6	23.3
200' W	"			1.0	24.9
TP		10.16	36.07	0.0	25.91
250' W	"			9.6	26.5
300' W = E L Evergreen (70)				8.2	27.9

RR curves to N about Center of Evergreen St

Bm NE Newell & Rosecrans

36.07

W Lin Evergreen St	6.4	29.7
50' W "	5.2	30.9
100' W "	3.9	32.2
150' W	2.7	33.4
200' W of Evergreen St on rail X on N Lin of Macauley	1.4	34.7

10/21/15 Closing levels for Elevation of Track at Del Mar St

Small Gump

	4.81	23300		22.19
EE bk of Pacific (Rubber)			2.75	
N L Pacific Rail			5.35	
S L " "			2.10	
SE bk "			0.25	
TP	11.21	24.94	0.27	23.73
TP	7.92	25.06 / 25.06	0.80	24.14
N L Del Mar Rail			6.20	24.86
N bank "			5.40	24.66
S bank "			3.70	24.34
S L	Rail		3.10	24.94

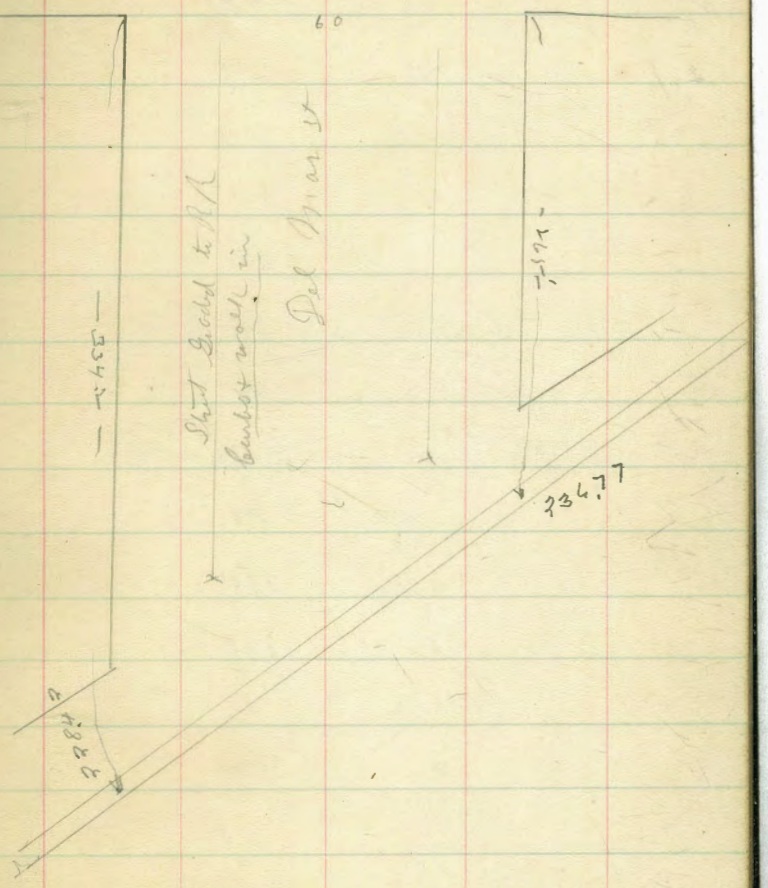

11/5/15 Clayton Re X Sec of Willow'd St (704)
Curtiss to Dumas
N line of Curtiss St

Bm 20.7
Swops

	068	1.27.45	12.677		
W			4.8		
			5.0		
			5.0		
b			5.4		
			6.0		
			7.0		
E			6.6		
	50	N to	Curtiss		
E			9.6		
			10.4		
			10.4		
b			9.6		
			9.4		
			8.9		
W			8.3		
TP	0.37	115.48	12.34	115.11	

115.48

	100	N to	Curtiss		12.677
W			2.4		427.05
			3.8		12.24
			5.2		115.11
b			6.0		37
			6.0		115.48
			6.0		12.10
	+5'		5.5		103.38
E			0.8		172
	150	N to	Curtiss		105.10
E			6.1		
	+5'		13.0		
			13.8		
			13.6		
b			13.4		
			13.3		
	+5		(13.0) 10.4		
			9.8		
W			8.2		
TP	1.72	105.10	12.10	103.38	

105.10

105.10
2.62
86.48

200' n = S 2 of Dumas st

W

38 101.3

37
(5.9)
(8.2)
8.5

75'

6

8.9

9.1

9.2
9.0

75'

E

1057

Bm

86.2 96.48

or Lard Post

Measurements but Monuments
Rosecrans & Talbot st

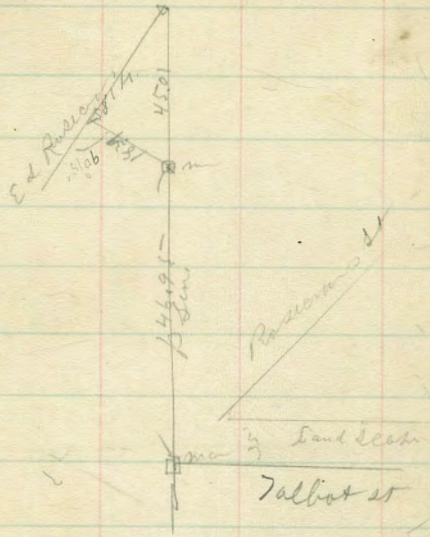

Location of New Main St (70)
Riverside & Gabrillo

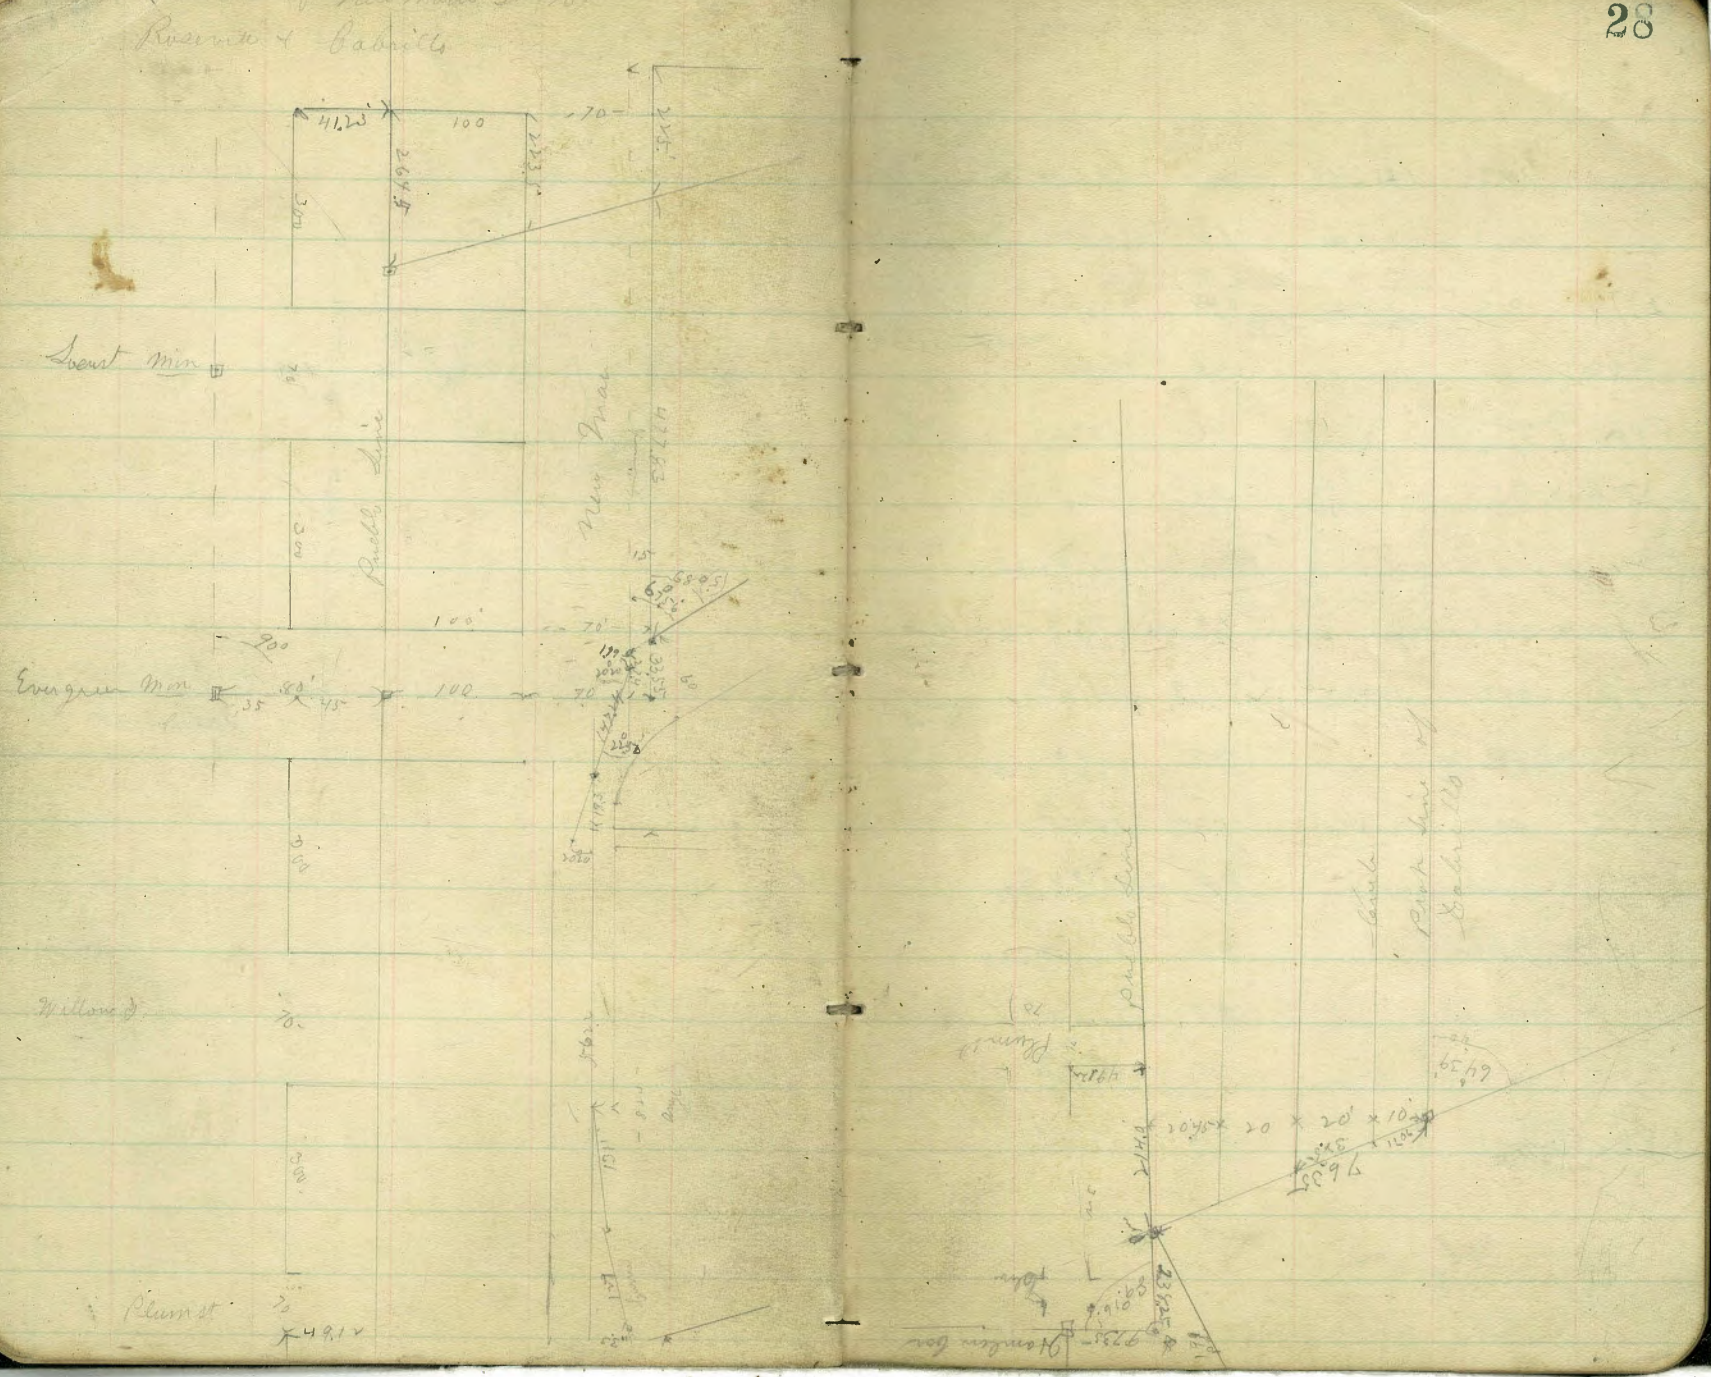

Grades at Wells & Elsmore

	17.35	185.40		153.05	153.05 / 1.20 / 154.25
	17.13	176.44	1.09	164.31	1.20 / 164.31
	7.18	183.34	0.48	176.16	17.13 / 176.40 / .28 / Top wall 176.16
Bm			2.48	180.86	7.18 / 183.34 / 2.48 / 180.86
S w bor	Elsmore + La Cresta Driv		8.6	174.8	
W d of	Cresta Driv		9.8	173.15	
50	W		3.0	180.3 / 169.7	10.6 G
100	W		9.4	174.0 / 165.9	C 8.1 / 18334 / 11.59 / 171.75
TP	0.57	172.34	11.59	171.75	.57 / 172.32
150	W		8.0	164.3 / 162.1	Curv 160.38 / 11.94
TP	00	160.38	11.94	160.38	
200	W		3.0	157.4 / 158.3	7.10
250	W = Main		9.0	151.4 / 154.3	7.30
310	= Bor Track		9.7	1507	
Trv	00	180.86		180.86	Bm
N w bor	Elsmore + La Cresta		10.16	170.75	

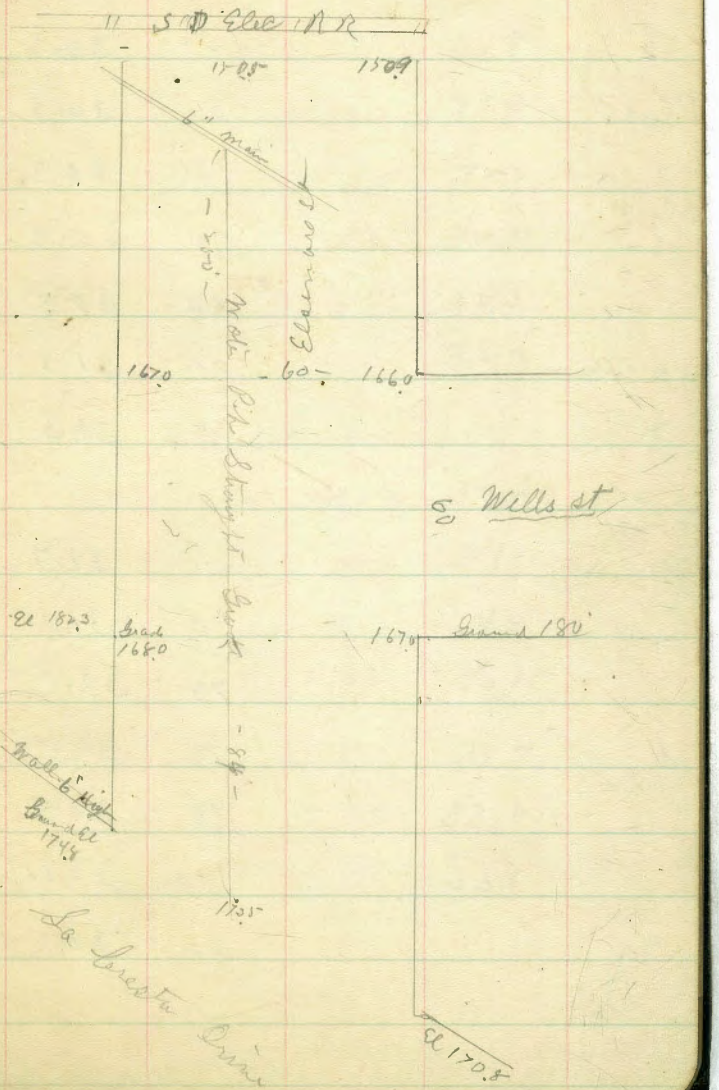

12/17/13 Clear 70's Re X sec of Orchard St (80') 20'-4 sts
765 De Foe to Eber St

9x6 38.13 28.87 Bm Mon Orchard & De Foe

E L of De Foe St

S		7.9	30.2
on Curb		8.1	30.0
		7.8	30.3
b		7.8	30.3
		7.6	30.5
on Curb		7.1	31.0
n		6.8	31.3

50 E of De Foe

n		6.4	31.7
		7.0	31.1
		7.4	30.7
b		7.6	30.5
		7.8	30.3
		8.0	30.1
S		8.0	30.1

28.87
9x6
38.13

38.13

100 E of De Foe

S		6.2	31.9
		6.3	31.8
		6.2	31.9
b		5.9	32.2
		5.7	32.4
		5.8	32.3
n		5.8	32.3

150 E of De Foe

n		3.8	34.3
		4.0	34.1
		4.1	34.0
b		4.7	33.4
		4.7	33.4
		4.9	33.2
S		5.0	33.1

3813

200' E of Q Zac

S		3.7	34.9
		3.0	35.1
		3.0	35.1
		2.8	35.3
		2.7	35.4
		2.6	35.5
N		2.7	35.4

250' E of Q Zac

N		0.0	38.1
		0.5	37.6
		0.5	37.6
		0.7	37.4
		1.0	37.1
		1.1	37.0
		1.4	36.7
S			

Tp 13.07 50.54 0.66 37.47

5054

Orchard

300' E of Q Zac

S	10.1	40.4
	9.6	40.8
	9.3	41.2
	9.3	41.2
	9.3	41.2
	9.1	41.4
N	8.5	42.0

350' E of Q Zac

N	4.5	46.0
+2'	6.2	44.3
	6.8	40.7
	7.2	43.3
	7.3	43.2
	7.8	42.7
	8.3	42.2
+18'	8.7	41.8
S	5.3	45.2

3813
cc
37.47
13.07
5054

50.54

	400	E of	D. Tot	
S			1.3	49.2
+4'			5.3	45.2
			5.1	45.4
			4.6	45.9
b			4.5	46.0
			4.3	46.2
			4.0	46.5-
+17			3.0	47.5
R			0.2	50.3
TP	13.01	6355	0.0	50.54

	450	E of	D. Tot	
R			8.6	55.0
+4'			12.4	51.2
			13.0	50.6
			13.2	50.4
b			13.6	50.0
			13.9	49.7
			13.8	49.8
+16			14.0	49.6
S			10.8	52.8

6355

	500	E of	D. Tot		
S			6.5-	57.1	5054 1301 6355- 550 6305- 11.86 74.91
+4'			8.6		
			9.6	54.0	
			9.3	54.3	
b			9.1	54.5-	
			8.6	55.0	
			8.7	54.9	
+18			8.7	54.9	
R			4.3	59.3	

	550	E of	D. Tot	
			+0.9	64.5-
R			3.2	60.4
+2'			3.6	60.0
			4.0	59.6
			4.4	58.2
			5.0	58.6
			5.0	58.6
+17'			5.4	58.2
			2.2	61.4
TP	11.81	7491	0.50	62.05-

Bmark 7'12"S W Edge Orchard

600' E. Wd of Eber St (60) 12 marks

S		9.2	65.7
	+5'	12.2	62.7
		11.8	63.1
		11.4	63.5
b		11.1	63.8
		10.9	64.0
		10.6	64.3
	+15'	10.2	64.7
n		6.1	68.8

W Limit of Eber St

n		5.0	69.9
	+3'	7.9	67.0
		9.3	65.6
		9.7	65.2
b		9.7	65.2
		10.4	64.5
		10.6	64.3
	+16'	10.7	64.2
s		8.1	66.8

7491

Archive

W 1/4 of Eber St

S		7.6	67.3
	+3'	9.4	65.5
		9.4	65.5
		9.5	65.4
b		9.0	65.9
		8.5	66.4
		7.8	67.1
	+16'	6.6	68.3
n		4.2	70.7

Center of Eber St

n		3.3	71.6
		5.2	69.6
		6.0	68.9
b		6.7	68.2
		7.0	67.9
		7.0	67.9
s		7.0	67.9

74.91

E 1/4 of Eber St

S	6,3	68.6
	4,8	70.1
	4,6	70.3
	4,3	70.6
b	3,8	71.1
	3,3	71.6
	2,7	72.2
n		

E Center of Eber St

n	2,0	72.9
	2,9	72.0
	3,3	71.6
	3,9	71.0
b	4,1	70.8
	4,5-	70.4
S	5,8	69.1

7491

Orchard 34

E Line of Eber St

S			4,5-	70.4
			4,0	70.9
			3,4	71.5
			3,2	71.7
b			2,6	72.3
			1,9	73.0
n			1,3	73.6
TP	11,06	84.34	1,63	73.28
	12.30	96.18	0,46	83.84
	12.91	108.52	0.54	95.64
			2,33	106.32

7491
1.63
73.28
11.06
84.34
.46
83.88
12.30
96.18
.54
95.64
12.91
108.55
2
106.32

7' East S.W. Pacific Eber

12/12/13 Laborers Table Left — Re X-ses of Pacific St (80') 20 chains Eben St to De Fon

9.983

3.02 — 10.724 — 10.672 — 9' from Sidewalk Eben & Pacific

W Line of Eben St

S		4.3	
		2.4	
		2.4	
b		2.3	
		2.6	
		2.9	
n		3.8	
	5.0'	W of	Eben St
n		6.8	
		6.4	
		6.8	
b		7.3	
		8.0	
		8.4	
S		10.1	
TP	1.23	9.983	11.34 — 9.790

	100	W of	Eben St	106.12
S			6.3	362
			4.8	107.14
			4.4	11.34
b			3.3	97.80
			2.4	1.93
			1.7	95.87
n			0.7	
	150	W of	Eben	
n			4.0	
			5.9	
			7.8	
b			8.0	
			9.1	
			10.2	
S			12.4	

9283

	175'	W f	Elev	
S			13.6	
			11.7	
			11.3	
b			10.6	
			9.4	
			8.0	
N			5.1	
	201	W f	Elev	
n			10.7	
TP	1.26	88.34	12.75	87.08
			2.4	
			3.0	
b			4.2	
			4.8	
			5.2	
S			4.8	

88.34

	250	W f	Elev	9.13
				1.24
				88.38
S	+4'		7.4	1.24
			8.0	87.14
			8.8	
			8.3	
b			7.5	
			6.7	
			5.7	
N			3.6	
	340	W f	Elev	
N	+1'		3.0	
			5.9	
			7.8	
			9.20	
b			9.5	
			10.3	
	+18'		10.7	
			-10.7	
S			9.2	

88.34

	350	W f	Elev	
S			11,5	
	+2'		14.2	
			14,0	
			13,0	
			11,8	
			11,3	
			10,4	
	+17		9,0	
N			4.0	
	400	W f	Elev	
N			7,0	
	+4'		12,4	
			13.0	
TP	0,18	75.41	13.11	75.23
			14	
b			1,7	
			2,5	
			3,5	
S			4,0	

75.41

	450	W f	Elev	
S			7,6	
			6,0	
			5.2	
b			4.6	
			4,0	
			3.7	
	+18'		3.1	
N			0.4	
	500	W f	Elev	
N			6.8	68.6
			9.2	66.2
			2,8	65.6
b			10,4	65.0
			11.2	64.2
			12,0	63.4
S			14,0	61.0
TP	0,20	62.53	13.04	62.33

87.64
13.11
74.53
74.78
13.04
61.63
61.83

6253

550 W of Elev

S	6.8	557
	5.2	573
	5.0	575
	4.4	581
	4.0	585
	3.7	588
+10	2.6	599
N	0.2	623

575 W of Elev

N	3.3	
+2'	5.8	
	8.1	
	8.0	
	8.0	
b		
	7.5	
	7.7	
S	9.0	

6253

600 W-E of Defiance Grade

S			12.1	504
on Return			12.6	499
			12.2	503
			11.6	509
			11.6	509
on Return			(19.6)	526 509
N			(8.4 10.5)	541 510
TP	0.81	5070	12.64	4989
	3.28	4738	11.60	3840
	3.73	3793	8.18	3420
			9.14	2879 BM Defiance Factory

12 / 12 / 13

Re X Lee of "Del Monte" St 80' 20 Mills
De For to Ebey St

11.85 4854 3673

E Line of De For

2		12,0
or Return		12,5
		12,7
6		12,7
		12,1
or Return		11,8
S		11,0

50' E of De For

S.		10,0
		11,2
		11,3
6		11,7
		11,4
		11,6
+16'		11,1
N		9,7

Man
St Fac of
Del Monte

4854

100 E of De Fac

N		7,0
+3'		9,0
		9,4
		9,6
6		9,4
		9,4
		8,6
S		7,6

150' E of De Fac

S		3,7
+2		5,5
		6,1
		6,9
6		7,0
		7,1
		7,5
N +15'		7,6
		3,2

3673
1154
4854

4858

	200'	E of	De Jan	
N			+1.2	
+4'			4.5	
			4.7	
			3.5	
b			3.4	
			3.2	
			3.6	
+19'			3.1	
S			0.0	
TP	1295	6077	0.76	4782

	2501	E of	De Jan
S			9.5
+2'			12.7
			12.8
			12.0
b			11.9
			12.2
			12.6
+16'			12.4
N			8.6

6077

	300'	E of	De Jan	
N			7.5	4858
+4'			8.4	25
			8.5	4782
			8.2	1295
			7.8	6077
			8.3	
			8.9	
+15'			9.1	
S			3.0	

	350	E of	De Jan
S			0.0
+6'			3.7
			4.1
			3.7
b			4.2
			4.4
			4.5
N			3.5
			3.1

6077

1400 E f De Zor

h	1,0
	1,1
	1,2
	0,7
	0,6
a	0,6
TP 11,63	7239 0,01 6076
+16	11,0
S	7,5

450 E f De Zor

S	4,8
74	7,0
	7,2
	8,4
b	8,5
	9,2
	9,0
n	10,5

7239

1500 E f De Zor

n	7,2
	7,2
	6,7
b	6,2
	5,6
	5,5
+16	5,0
S	3,6

550 E fe De Zor

S	3,0
	4,0
	3,7
b	3,7
	4,5
	3,0
h	5,0

6076
11,63
7239

7239

600 E f De Zw

R			1,7		7239
			1,5		71.55
			1.1		75.70
b			0,9		64.38
			1,0		3 1 6
			1,1		67.54
S			1,0		
FP	4,55	75.70	1,24	7115	7 Hvl SW Eben
	3,16	67.54	1132	6438	
Check			6.53	61,01	Genk

12 / 12 / 13 along Re X sec of Narragansett (80') 20 lbs
7x24 Eben to Fronde st

11x3 7x24 .61.40 Curb P 42

W Line of Eben st (60') 12 lbs

S		10,9
bb. on bank Gut		11.23
		12.23
		12,4
b		12,3
		12,6
Gutter		13,2
		12,3
n		12,2

W bank of Eben

n		13,4
		12,5
		12,2
b		11,8
		11,8
		12,0
S		11,4

7x24 Narragansett

W 1/4 of Eben 61.64 11.23 72.64

S		11,2
		11,4
		11,5
b		11,5
		11,8
		12,3
n		13,0

Center of Eben

n		12,2
		11,7
		11,2
b		11,1
		10,9
		10,6
S		10,6

7224

	E	Surf	Elev
S			9.7
			8.6
			10.4
h			10.2
			10.5
			10.2
n			10.7

	E	Surf of	Elev
n			9.2
			9.1
			9.2
h			9.2
			9.1
			8.7
S			8.6
			7.2

7053

Page 50

7224

Narayanan

	E	Line of	Elev	at
R			7.3	
			7.3	
			7.6	
b			7.8	
			7.7	
			7.8	
S			7.8	
TP	1233	82.81	1.71	7053

Dep = 50

		E of	Elev
	10		
S			12.3
			12.1
			11.7
b			11.3
			11.0
			10.2
n			10.2

7224
1.71
7053
1233
82.81

82.86

	100	E of	Elev
n			1,9
+8'			4,2
			5,4
			5,2
b			5,2
			5,2
			5,4
S			5,3

TP	12.63	95.09	0.40	82.46

	150	E of	Elev
S			10,7
			11,4
			11,6
b			11,5
			11,4
			11,3
			10,6
n	+14		5,6

95.09

	200	E of	Elev	St
S			3,8	
			5,0	
T			4,7	
b			4,1	
			4,1	
			3,8	
b	+12'		3,3	

TP	12.18	106.44	0.83	94.26

n.2			8,8

	250	E of	Elev
n			0,8
+8'			6,3
			7,3
			8,2
b			8,0
			8,0
			8,4
S			7,6

TP	12.62	118.26	0.80	105.64

82.86
40
82.46
12.63
95.09
83
94.26
12.18
106.44
80
105.64
12.62
118.26

11846

	300	E f	Eben	
S			12,6	
			13,0	
			12,6	
b			12,6	
			12,4	
			11,5	
	+12		10,3	
n			6,2	

	350	E f	Eben	
S			5,3	
			5,8	
			5,0	
b			4,7	
			4,7	
			3,8	
	+12		2,8	
TP	12,30	12,949	10,7	117,19
n 2			9,8	

12,949

Narayanan

	400	E f	Eben	
n			4,6	118,26
	+5		5,6	1,07
			6,6	117,19
T			6,2	12,30
				129,49
b			7,0	85
			7,2	128,64
			7,7	11,68
			8,7	140,32
S				1,81
				139,41

	450	E f	Eben	
S			4,1	
			3,0	
			2,5	
			1,7	
			1,6	
th			0,8	
TP	11,68	140,32	085	128,64
n			10,6	
check			2,8	139,46

12/14 Clouds Taylor Ley

Levels over the curbs on West Point Terrace Bet Sea Side st + Castello st

	5.35	3375	28.40
	S of Sea Side St		
E w Curb	5.35		28.40
W "	6.5		27.25
	50 S of Sea Side		
W	5.1		28.65
E	4.5		29.25
	100 S of Sea Side		
E	4.0		29.75
W	4.4		29.35
	150 S of Sea Side		
W	4.4		29.35
E	3.5		30.25
	174 S = P.C. to R (OK)		
E	3.5		30.25
W	4.4		29.35
	26 W S of E 270 S of N } S of Pl		
W	4.4		29.35
E	3.5		30.25

Bm on Pole Sea Side

28.40
3.35
33.75
4.48
29.27
3.10
32.37

Chalk + Wash all in on Both Lines of 40' N & S of Sea Side on West Side

33.75

	76 S on E 425 S on N } S of Pl		
E		3.8	29.95
W		4.6	29.15
	126 S on E 119 S on N } S of Pl		
N		5.0	28.75
E		4.4	29.35
TP	310	3237	4.48 29.27
	176 S on E 166 S on N } = End of curve (S) = 350 S of Sea Side on E Curb		
E		3.6	28.77
W		4.4	27.97
	50 S of E 6 = 400 S of Sea Side on E Curb		
W		5.3	27.07
E		4.0	28.37
	100 S of E 6 { 5 / E } = 450 S of Sea Side on E Curb = N Return of Castello		
E		4.7	24.17
W		5.6	26.77
	80 S = S Return of Castello on E		
W		5.3	27.07
E		4.4	27.97

Sea Side St is on Lots 17 + 18 Blk 27

Survey for Right of way across Barnes
Santa Barbara & Point Sierra ave

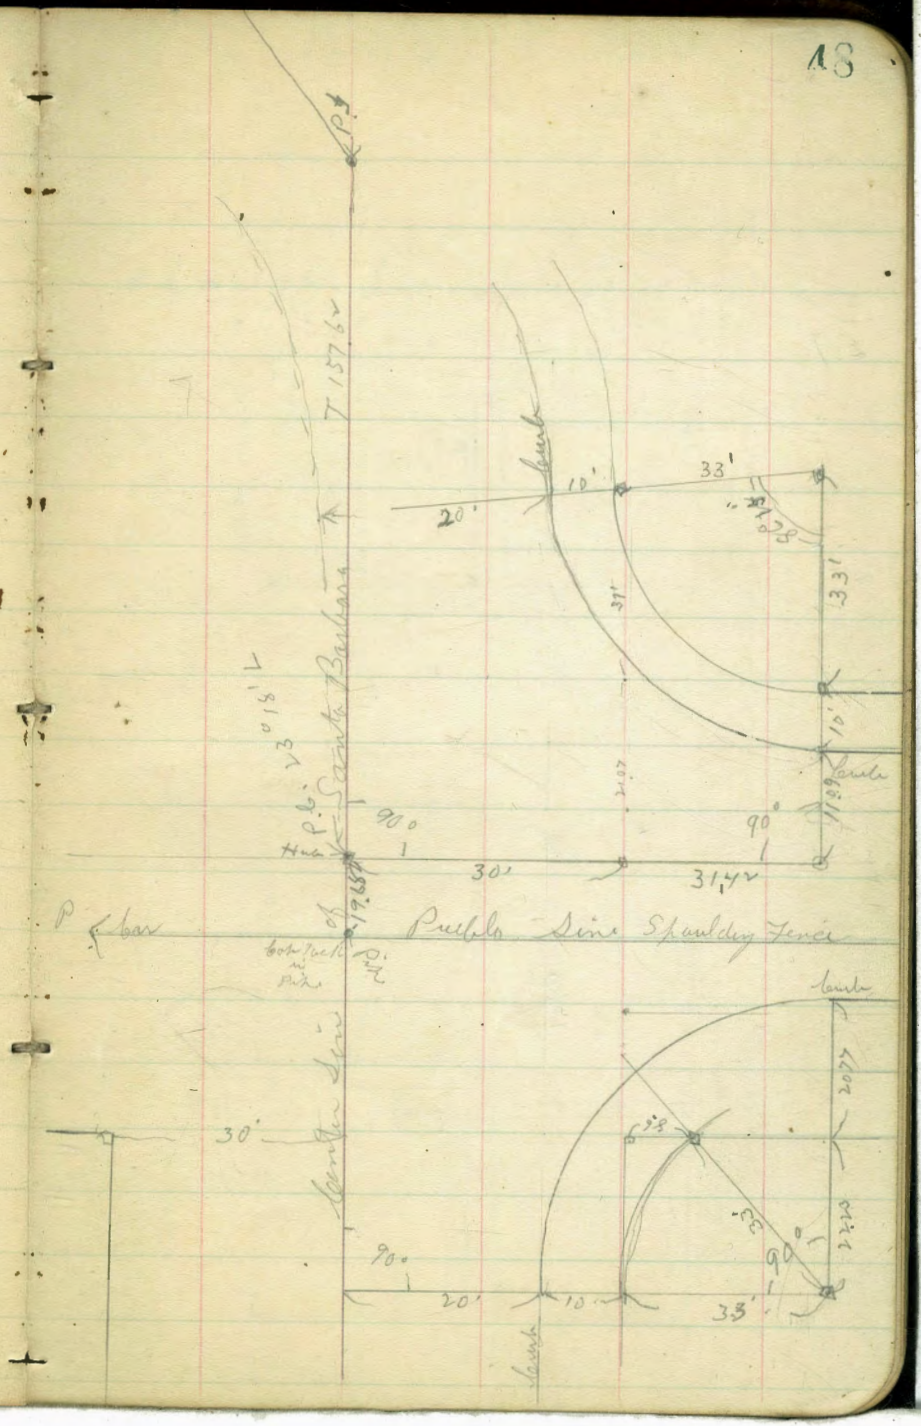

Location of Bluff Line at Ocean Beach

Location of Bluff Line
Moore
Rand
Survey
Present Meas. = Red
Nov. 1-41.

Clough Survey

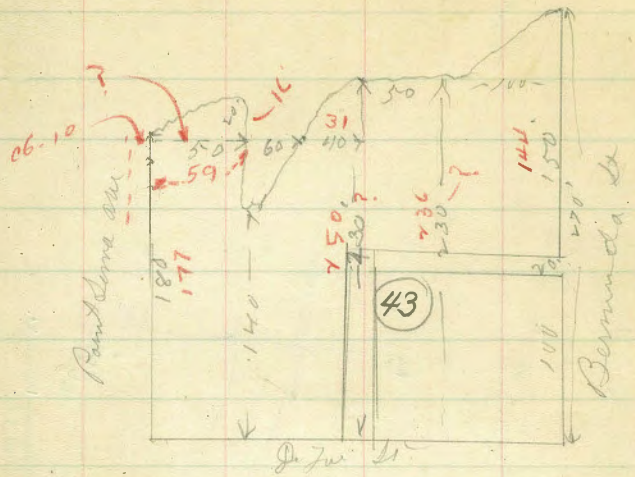

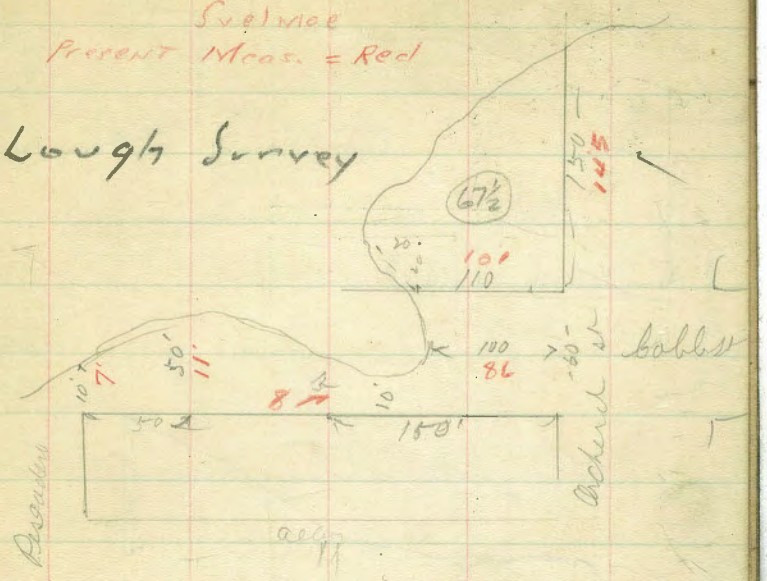

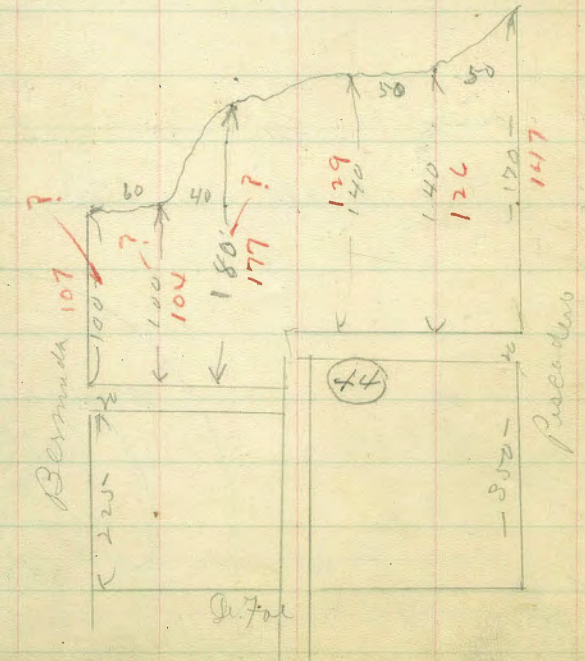

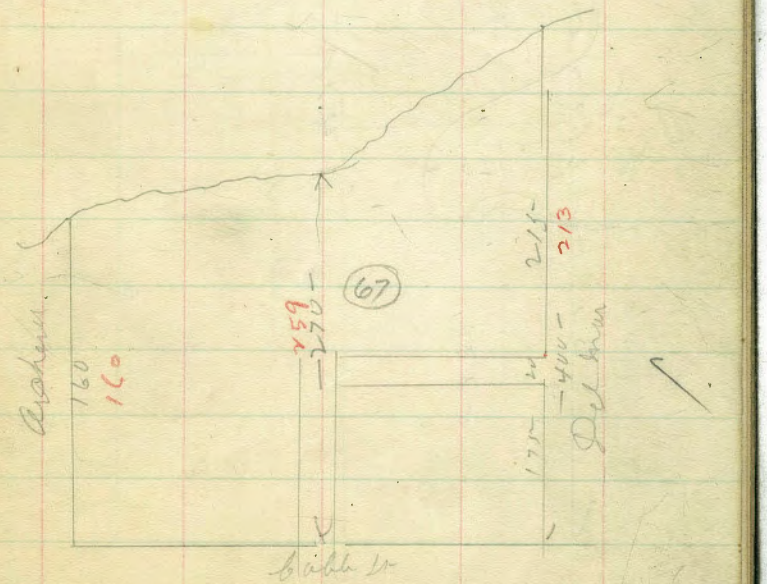

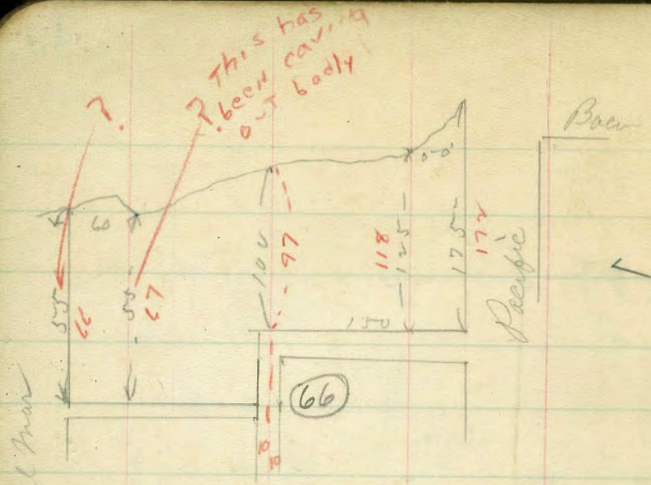
?
? This has been caving out badly
Baer
Pacific
Del Mar
66

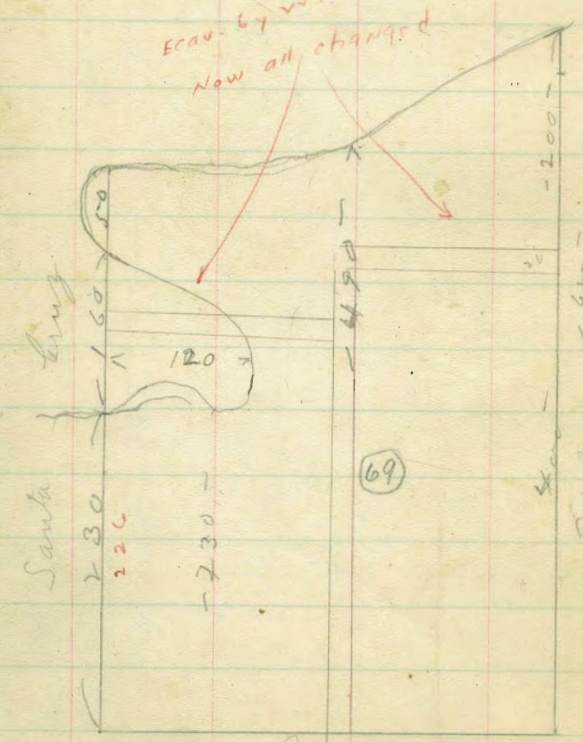
Excav. by WPA
Now all changed
Santa Cruz
Del Mar
Baer
69

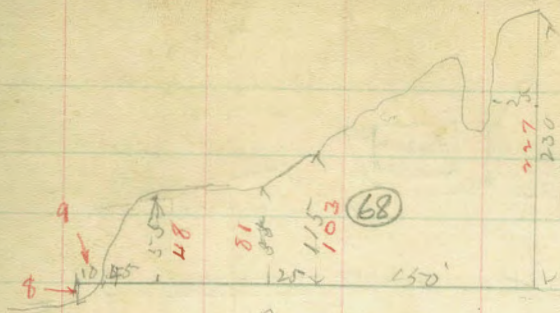
68
Baer
Pacific
Santa Cruz

70
Baer
Del Mar
Santa Cruz

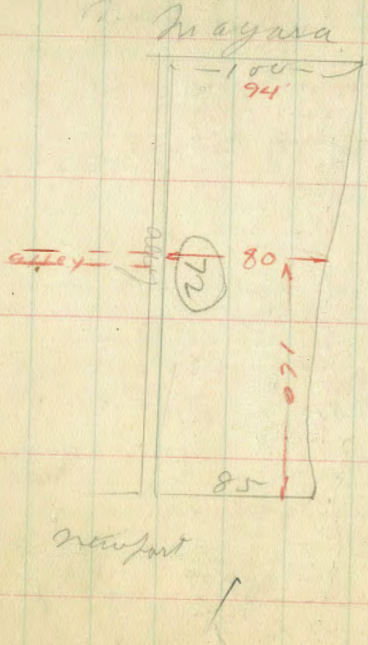
Nagara
100
94
80
72
85
Newport

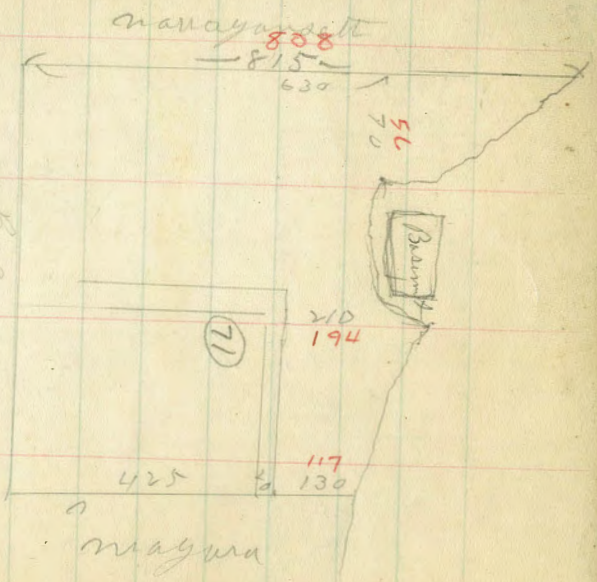
Nanayasht
808
815
630
55
70
Basin
210
194
71
117
130
425
Nagara


Cuts for Water Pipe in Anna St
E San Diego from Swift Ave to Highland Ave

Botm grade 5.6 below ctr st grade

Sta		Rod	Ground	Grade	Cut
	490	375.02		370.12 BM S.W. Pacific Spk	
0+00 = E.L. Swift		5.52	69.50	63.70	5.8
	+50	5.34	69.68	63.85	5.83
	1	5.04	69.98	64.00	5.98
	+50	5.47	69.55	64.15	5.40
	Y	5.23	69.79	64.30	5.49
	+50	5.10	69.92	64.45	5.47
3 = W.L. Pacific		5.13	69.89	64.60	5.29
	5.76	375.37		370.12 BM	
0+00 E.L. Pacific		4.82	70.55	65.10	5.45
	+50	5.06	70.31	64.95	5.36
	1	5.01	70.36	64.80	5.56
	+50	5.13	70.24	64.65	5.59
	Y	4.98	70.42	64.50	5.92
	+50	5.22	70.15	64.35	5.80
3 = W.L. Wilson		5.35	70.02	64.20	5.82
T.P	3.87	379.70	5.54	369.83	

Sta		Rod	Ground	Grade	Cut
		HI 373.70			
0+00 = E.L. Wilson		3.87	69.83	6.280	6.03
	+50	4.09	69.61	63.65	5.96
	1	4.04	69.66	63.50	6.16
	+50	4.78	68.92	63.35	5.57
	Y	5.16	68.54	63.20	5.34
	+50	5.25	68.45	63.05	5.40
3 = W.L. Story.		5.22	68.48	62.90	5.58
T.P	3.35	HI 371.11	5.94	367.76	
0+00 = E.L. Story		3.35	67.76	62.40	5.36
	+50	3.93	67.18	61.75	5.43
	1	4.44	66.67	61.10	5.57
	+50	5.27	65.84	60.45	5.39
	Y	5.99	65.12	59.80	5.32
	+50	6.50	64.61	59.15	5.46
3 = W.L. Bradt		7.10	64.01	58.50	5.51
T.P	2.71	366.30	7.62	363.59	

Sta	Rod 366.20	Ground	Grade	Cut
0+00 = E.L. Bradt	2.71	63.49	58.20	5.29
+50	3.10	63.10	57.58	5.52
1	3.77	62.43	56.97	5.46
+50	4.41	61.79	56.35	5.44
2	5.14	61.06	55.73	5.33
+50	5.68	60.52	55.12	5.40
3 = W.L. Reed St.	6.25	59.95	54.50	5.45
T.P. 4..	363.30	6.90	359.30	
0+00 = E.L. Reed	4.00	59.30	54.00	5.30
+50	4.25	59.05	53.70	5.35
1	4.52	58.78	53.40	5.38
+50	5.07	58.23	53.10	5.13
2	6.44	56.86	52.80	4.06
+50	6.78	57.52	52.50	5.02
3 = W.L. Thomas	6.20	58.10	52.20	5.90
✓ B.M. Alley E of Road 357.05 Elev	6.29	357.01 ✓		
T.P. 5.68	363.78	5.20	358.10	

Sta	Rod 363.78	Ground	Grade	Cut
0+00 = E.L. Thomas	5.64	58.14	52.20	5.94
+50	5.61	58.17	52.82	5.65
1	5.37	58.41	52.83	5.58
+50	5.57	58.21	53.15	5.06
2	4.74	59.04	53.47	5.57
+50	4.50	59.28	5378	5.50
3 = W.L. Daly	4.39	59.39	54.10	5.29
T.P. 4.72	364.15	4.35	359 43	
0+00 = E.L. Daly	4.72	59.43	54.10	5.33
+50	4.87	59.28	5393	5.35
1	4.61	59.54	5378	5.79
+50	4.97	59.18	5357	5.61
2	5.12	59.03	53.40	5.63
+50	5.33	58.82	53.22	5.60
3 = W.L. Sisson	5.64	58.51	53.05	5.46
T.P. 4.39	362.37	6.17	357.98	

Sta	Rod (367.37)	Ground	Grade	Cut
0+00 E.L. Sisson	4.39	57.98	52.98	5.73
+50	4.71	57.66	52.53	5.13
1	4.92	57.45	52.32	5.13
+50	5.00	57.37	52.10	5.27
2	5.06	57.31	51.88	5.43
+50	5.69	56.78	51.67	5.11
3 W.L. Hugo	5.20	57.17	51.45	5.72
T.P. 5.18	362.24	357.06		
0+00 E.L. Hugo	5.18	57.06	51.45	5.61
+50	5.36	56.88	51.35	5.53
1	5.52	56.72	51.25	5.47
+50	5.16	57.08	51.15	5.93
2	6.36	55.88	51.05	4.83
+50	6.57	55.67	50.95	4.72
3 W.L. Conklin	6.55	55.69	50.85	4.84
T.P. 6.68	362.55	355.87		

Sta	Rod (362.55)	Ground	Grade	Cut
E.L. Conklin	6.68	55.87	51.15	4.72
+50	6.29	56.26	51.47	5.00
1	6.43	56.12	51.38	4.74
+50	5.80	56.75	51.50	5.25
2	5.52	57.03	51.62	5.40
+50	5.40	57.15	51.72	5.42
3 W.L. Stockton	5.10	57.45	51.85	5.60
T.P. BM Spk in pole Alley bet Stkn & Conklin	3.99		358.54	358.62
460	363.22		358.62	
E.L. Stockton	5.40	57.82	52.35	5.47
+50	5.18	58.04	52.60	5.44
1	5.08	58.14	52.85	5.29
+50	5.08	58.14	53.10	5.04
2	4.72	58.50	53.35	5.15
+50	4.22	59.00	53.60	5.40
3 W.L. Copeland	3.95	59.27	53.85	5.42
T.P. 6.01	365.28	395	359.27	

Sta	Rod	Ground	Grade	Cut
	365.28			
0+00 E.L Copeland	5.70	59.58	54.15	5.43
+50	5.19	60.09	54.64	5.45
1	4.68	60.60	55.13	5.47
+50	4.24	61.04	55.62	5.42
2	3.75	61.53	56.12	5.41
+50	3.36	61.93	56.61	5.32
3 W.L Van Dyke	2.95	62.33	57.10	5.23
T.P 3.51	365.84	2.95	362.33	
0+00 E.L Van Dyke	3.61	62.23	57.10	5.13
+50	3.84	62.00	56.64	5.36
1	4.26	61.58	56.18	5.40
+50	4.78	61.06	55.72	5.34
2	5.04	60.80	55.27	5.53
+50	5.78	60.06	54.81	5.25
3 W.L Pauly	6.03	59.81	54.36	5.45
T.P 4.18	364.46	6.03	359.81	

Sta	Rod	Ground	Grade	Cut
	364.46			
0+00 E.L Pauly	4.77	59.69	54.20	5.49
0+69	5.01	59.45	54.08	5.37
1+19	5.15	59.31	54.01	5.31
+69	5.01	59.45	53.92	5.53
2+19	5.24	59.22	5383	5.39
+69 W.L Fairmount	5.48	58.98	5375	5.20
				Bkd SpK SW
T.P 2.44	HI 362.10	4.79	359.67	359.61
0+00 E.L Fairmount	3.19	58.91	5370	5.21
+50	3.97	58.13	52.80	5.33
1	4.98	57.12	51.90	5.22
+50	5.91	56.19	51.01	5.18
2	7.01	55.09	50.11	4.98
+76 W.L Colonial	8.27	53.83	48.75	5.08
T.P 4.63	359.46	8.27	353.83	
0+00 E.L Colonial	4.80	53.66	48.50	5.16
	4.98	53.48	48.36	5.12
+77				
1+27	5.07	53.39	48.27	5.12
+77	5.12	53.34	48.18	5.16
2+27	5.13	53.33	48.09	5.24
+77 W.L Highland	5.18	53.28	48.00	5.28

Sta		Rod	Ground	Grade	Cut
T.P	4.11	357.35	5.22	353.24	
0+00 = S.L. Anna		4.11	53.24	48.90	5.24
+50		4.26	53.09	47.92	5.17
1		4.40	52.95	47.85	5.10
+50		4.45	52.90	47.77	5.13
2		4.60	52.75	47.70	5.05
+50		4.80	52.55	47.62	4.93
3		4.96	52.39	47.55	4.84
T.P.	4.41	356.80	4.96	352.39	
+50		4.39	52.41	47.47	4.94
4		4.46	52.34	47.41	4.94
+50		4.56	52.25	47.32	4.93
5		4.80	52.00	47.25	4.75
+50		4.84	51.96	47.17	4.79
6+00 = N.L. Univ Ave.		5.07	51.73	47.10	4.63
Chk. Cl. NW Univ & Highland		4.61	352.19	352.2	

Survey for Apentry Sea Side St.

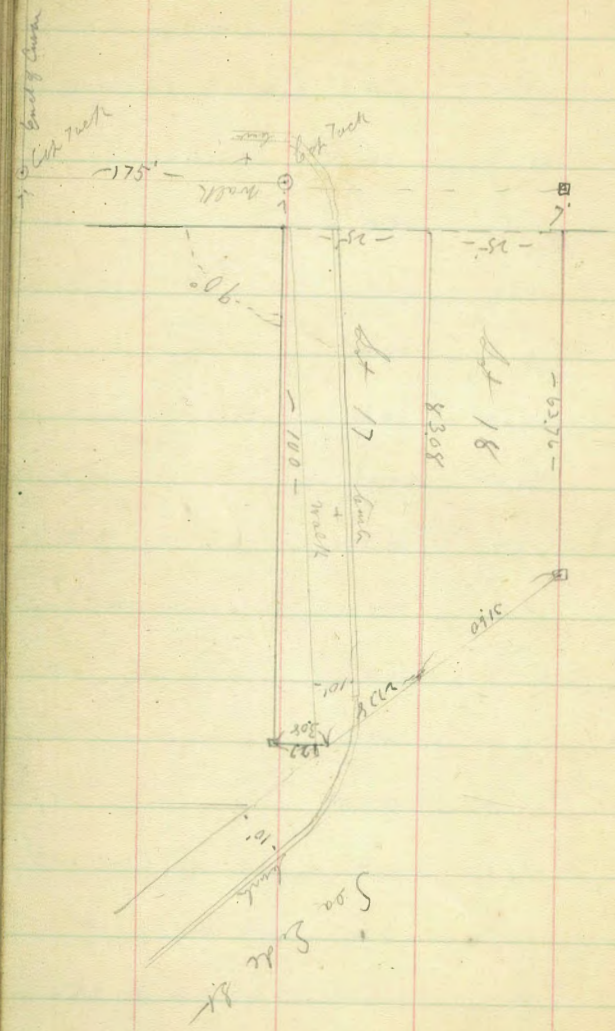
175'
35'
35'
90°
100'
Lot 17
Lot 18
8308
6372
Mark
Stake
10'
Stake
Stake
Stake

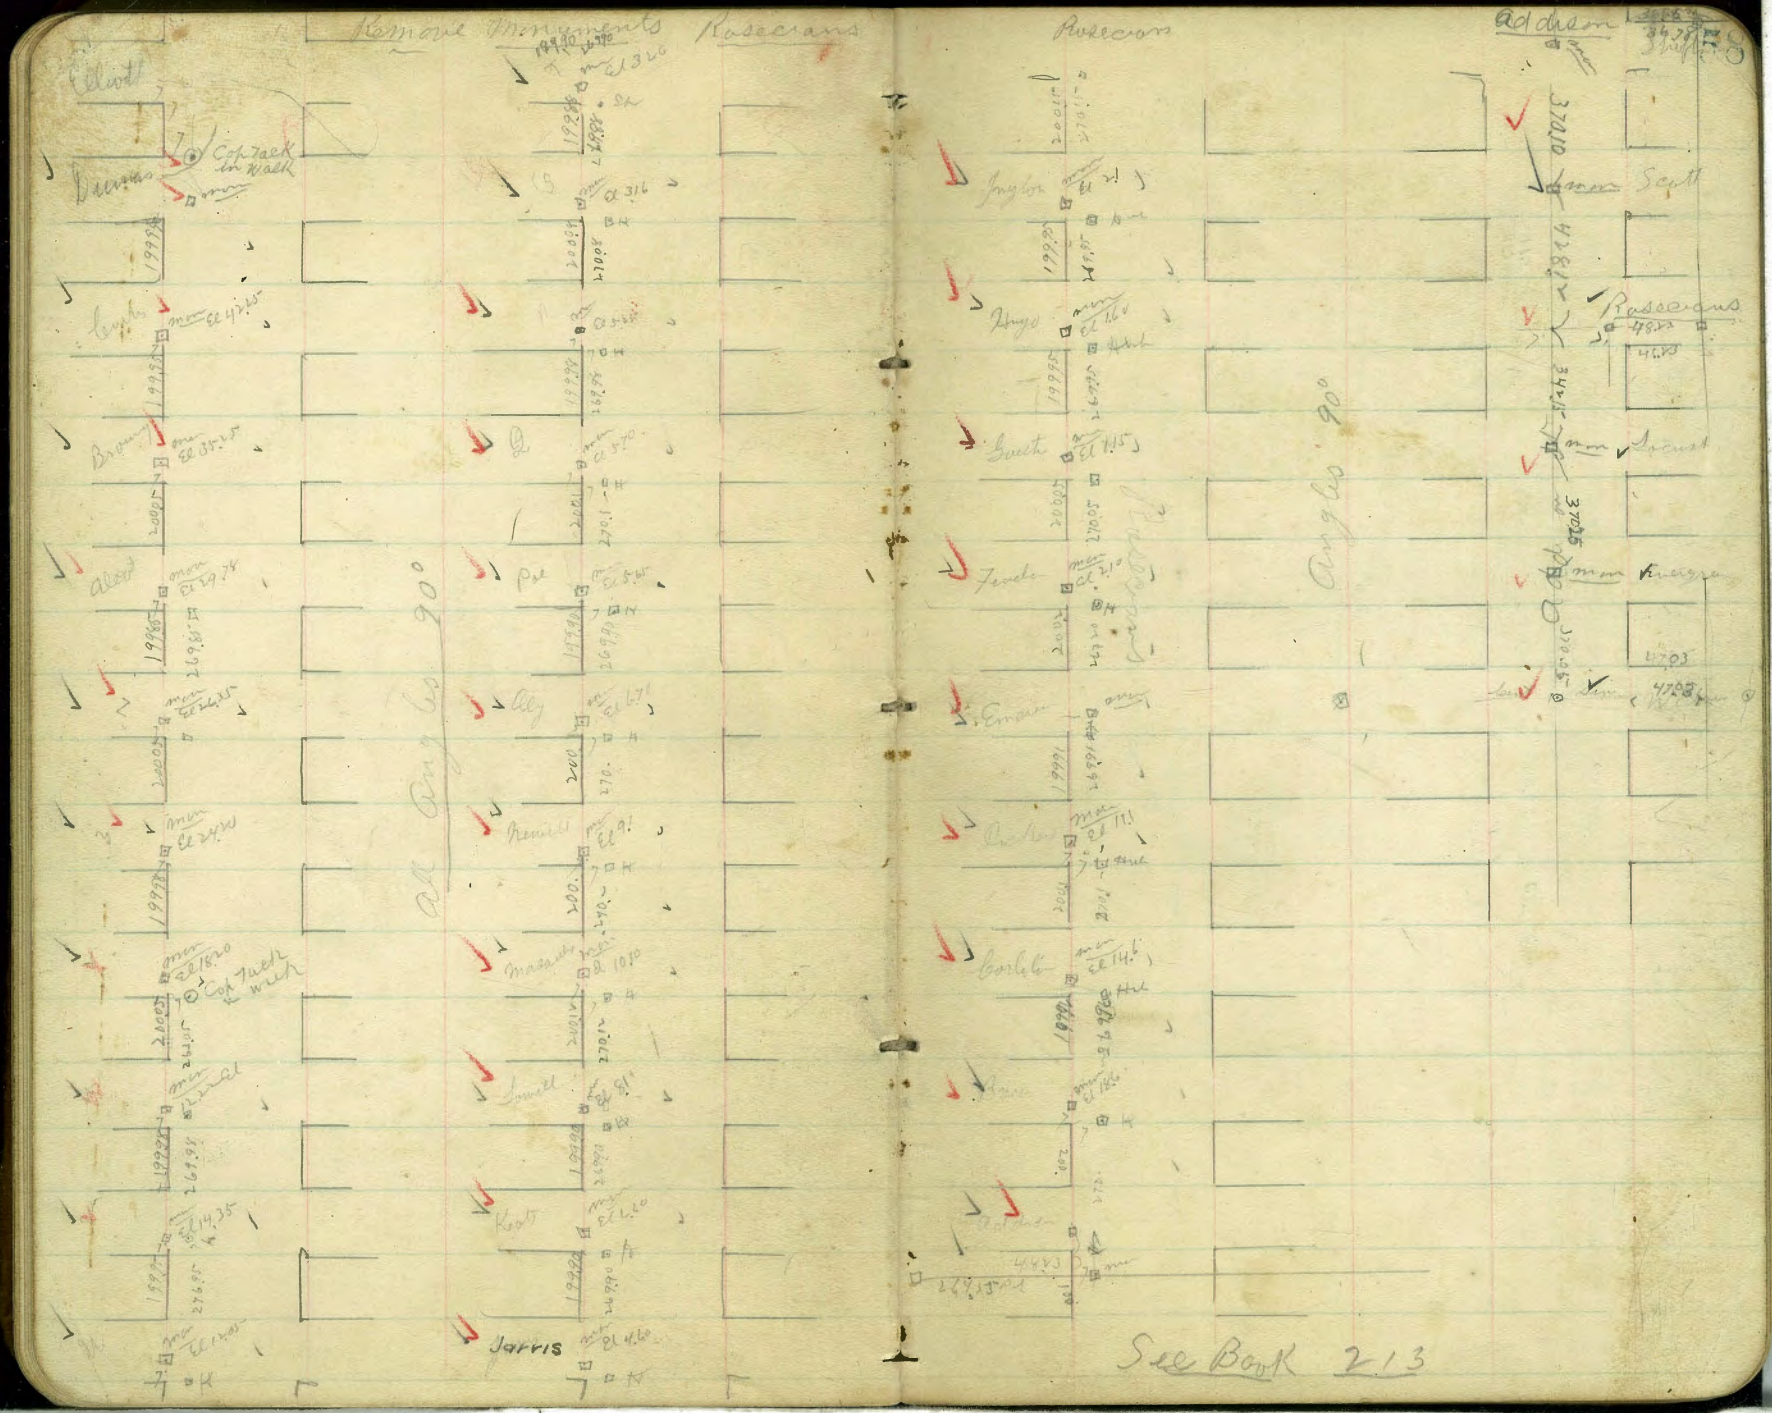
Rosecrans
Addison
Elliott
Drew
Boyle
Brown
Albert
Pol
Lily
Bennett
Masonic
Jewell
Knott
Jarvis
Ingleton
Hugo
Smith
Jewett
Emerson
Corbett
Kane
Scott
Rosecrans
Locust
90°
See Book 213

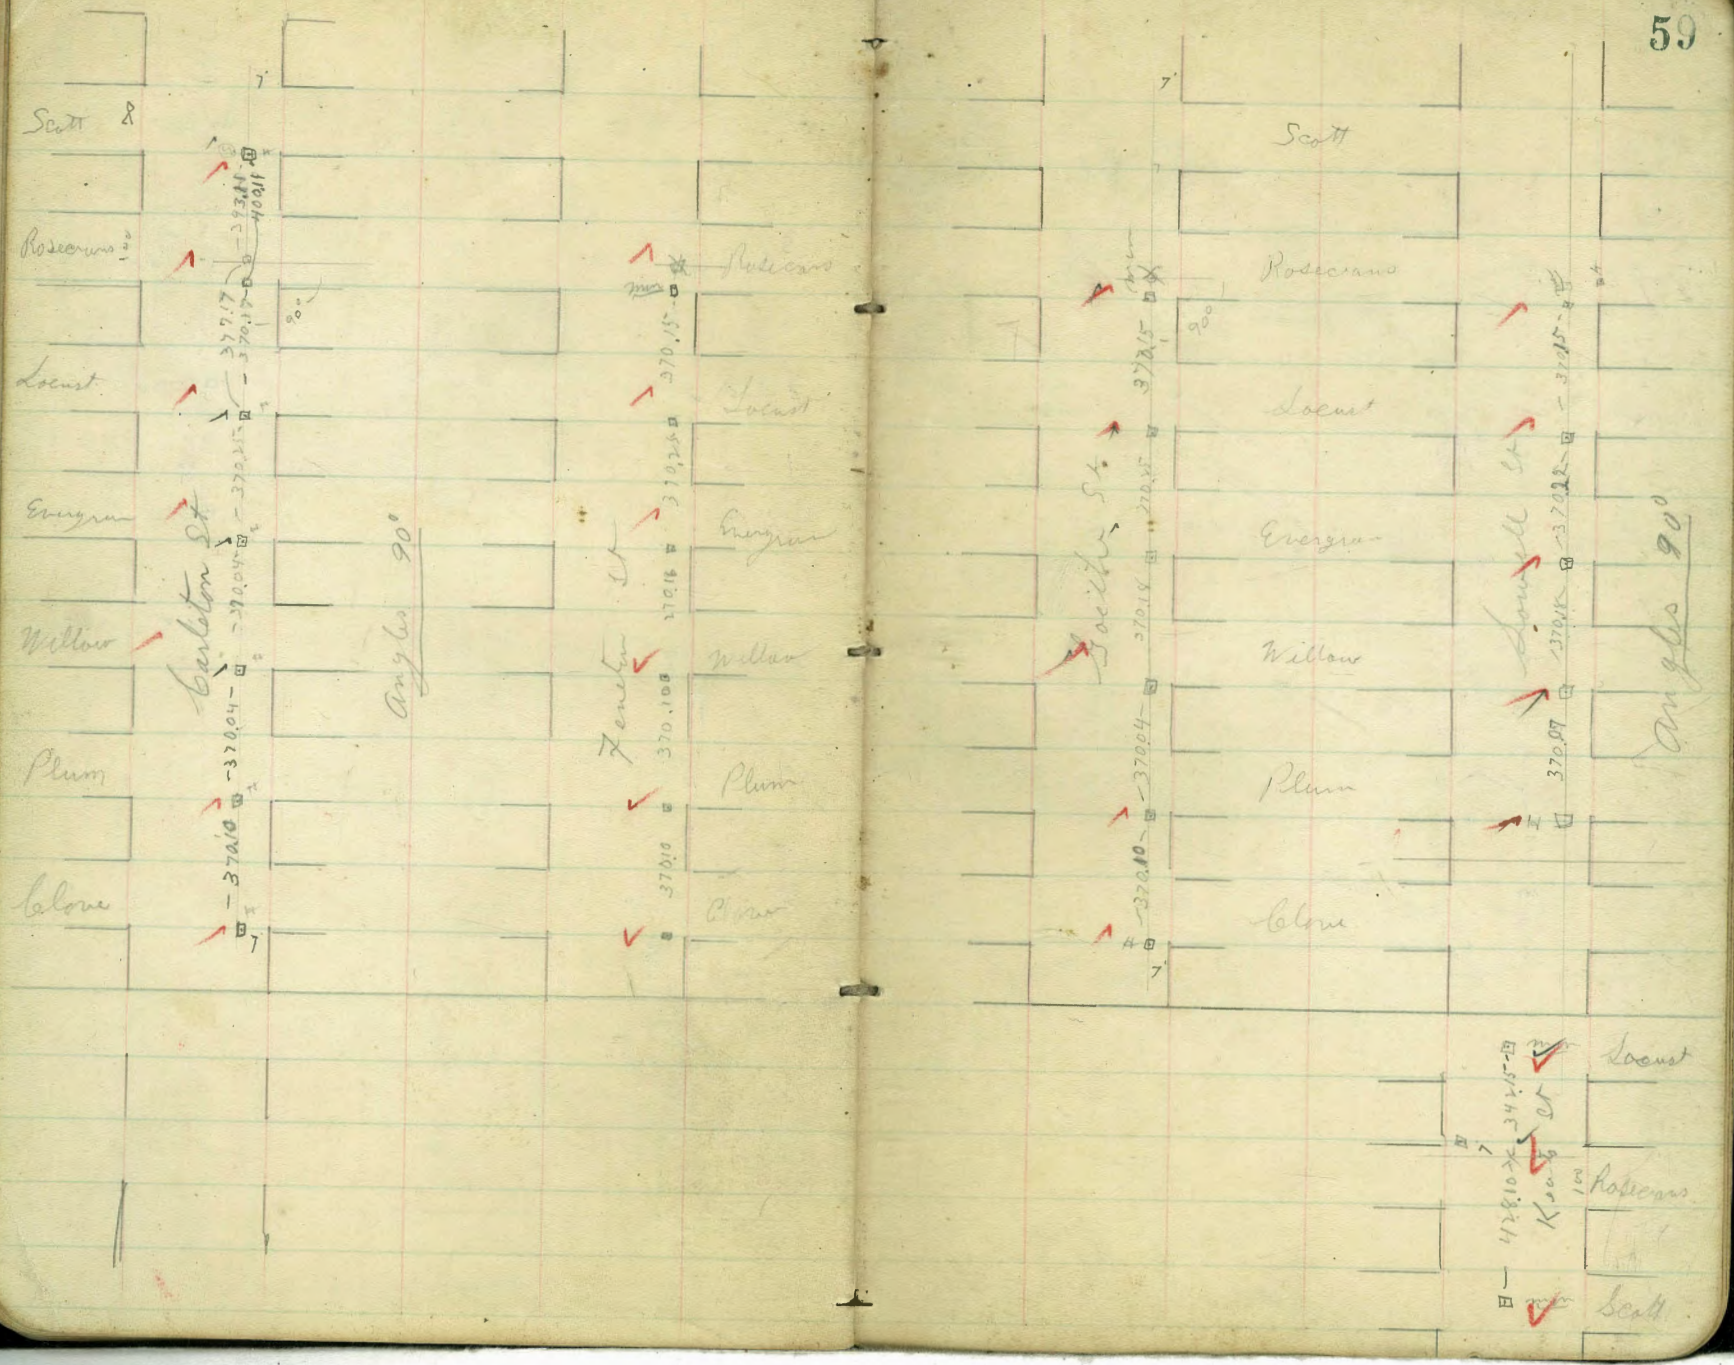
Scott
Rosecrans
Locust
Evergreen
Willow
Plum
Olive
Carleton St.
Angles 90°

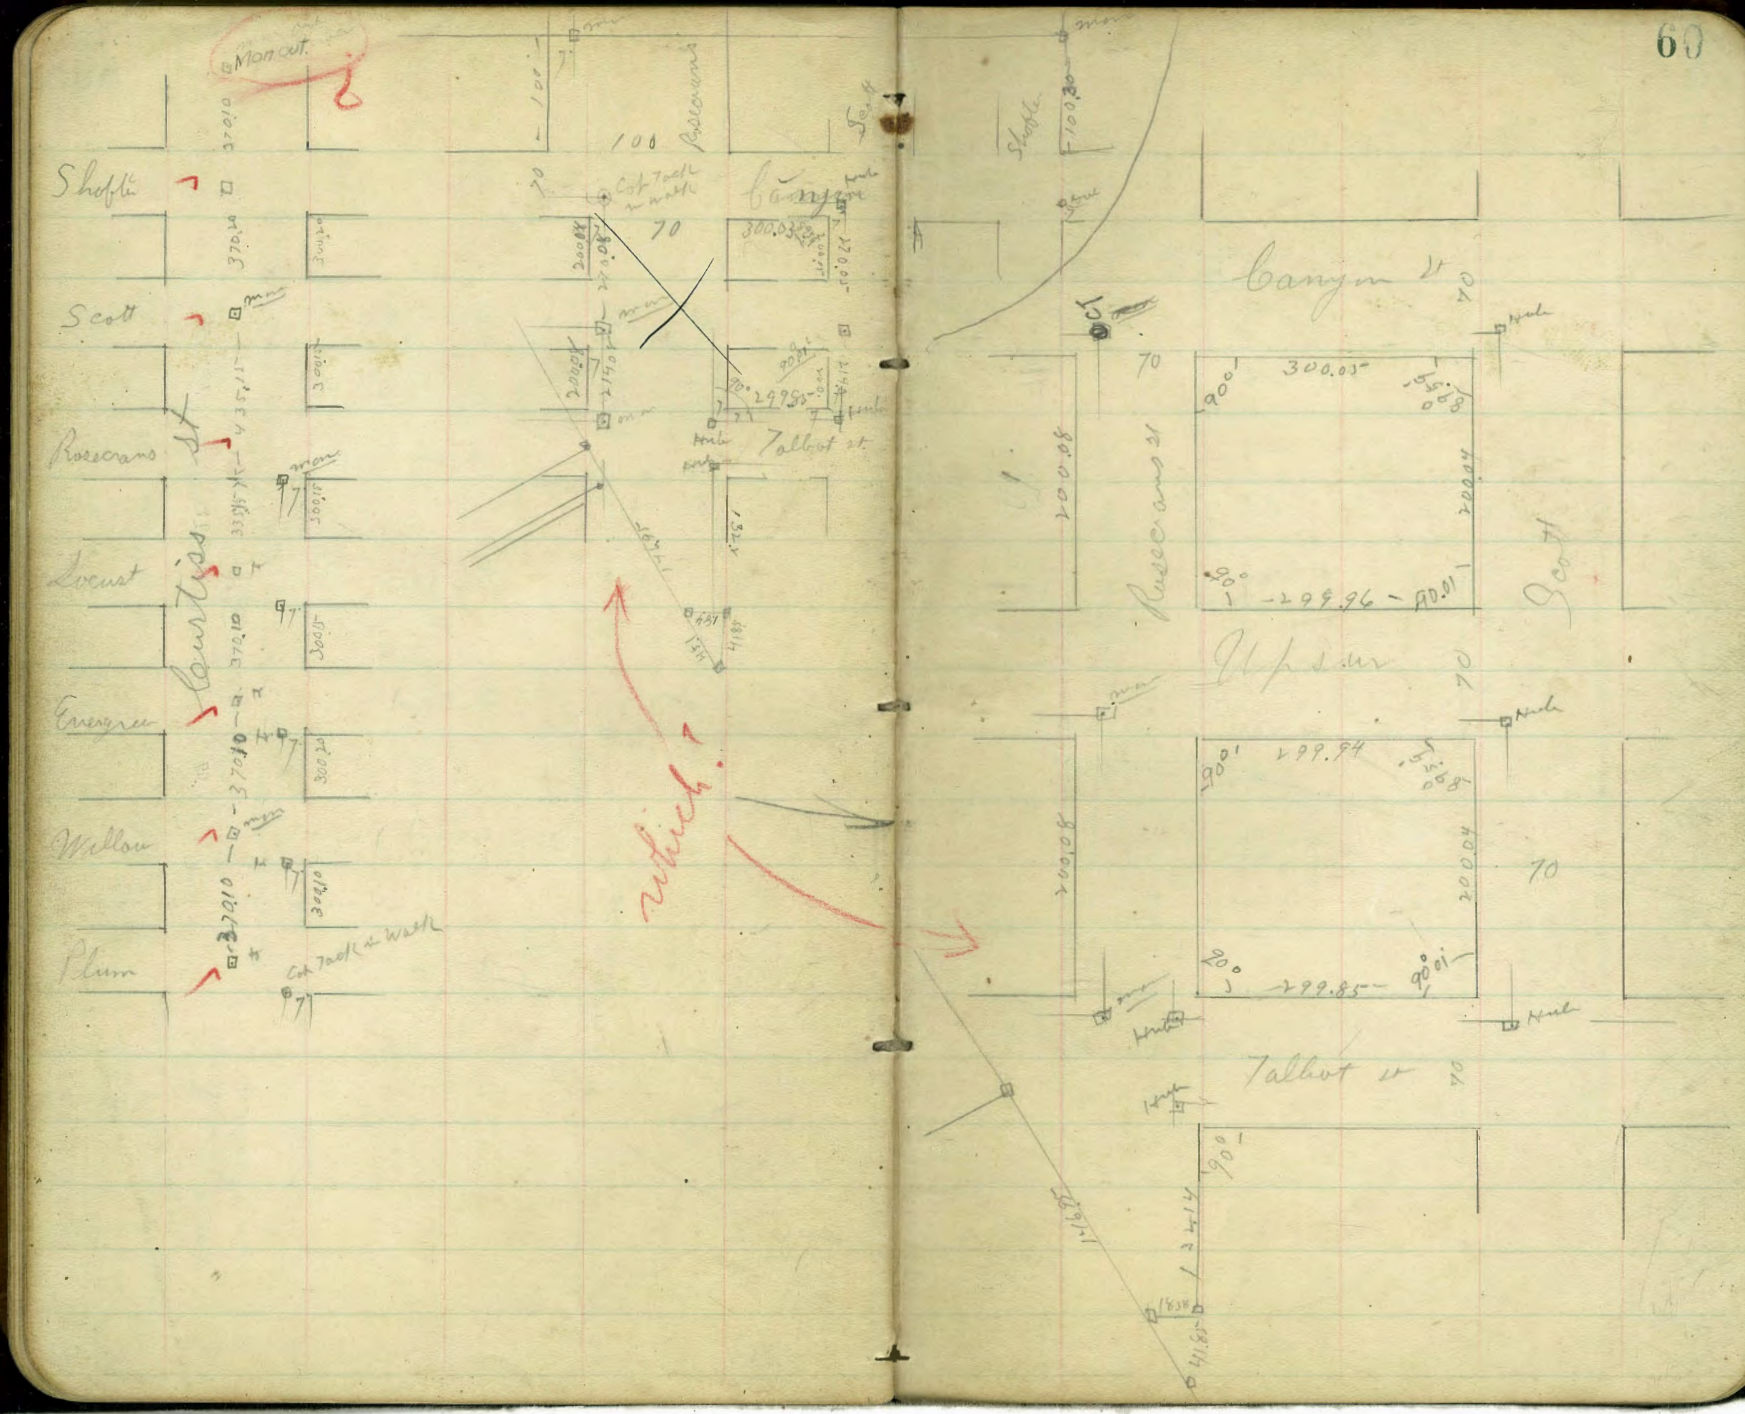
Mon cut.
Shotfle
Scott
Rosecrans St
Locust
Evergreen
Willow
Plum
Court Ave
Cor Tack in Walk
Rosecrans
Talbot st
Canyon St
Scott
Talbot st
which?

1
19
15


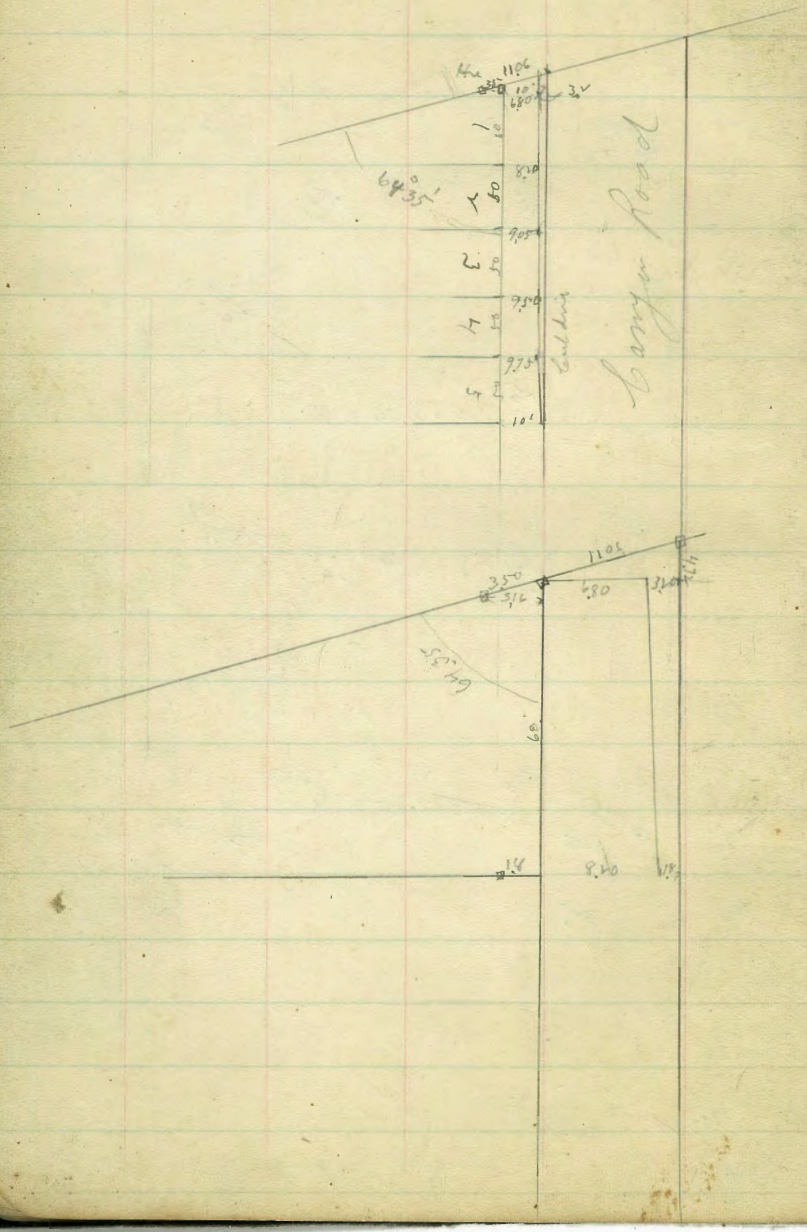

Ave Bermuda & Point Lena

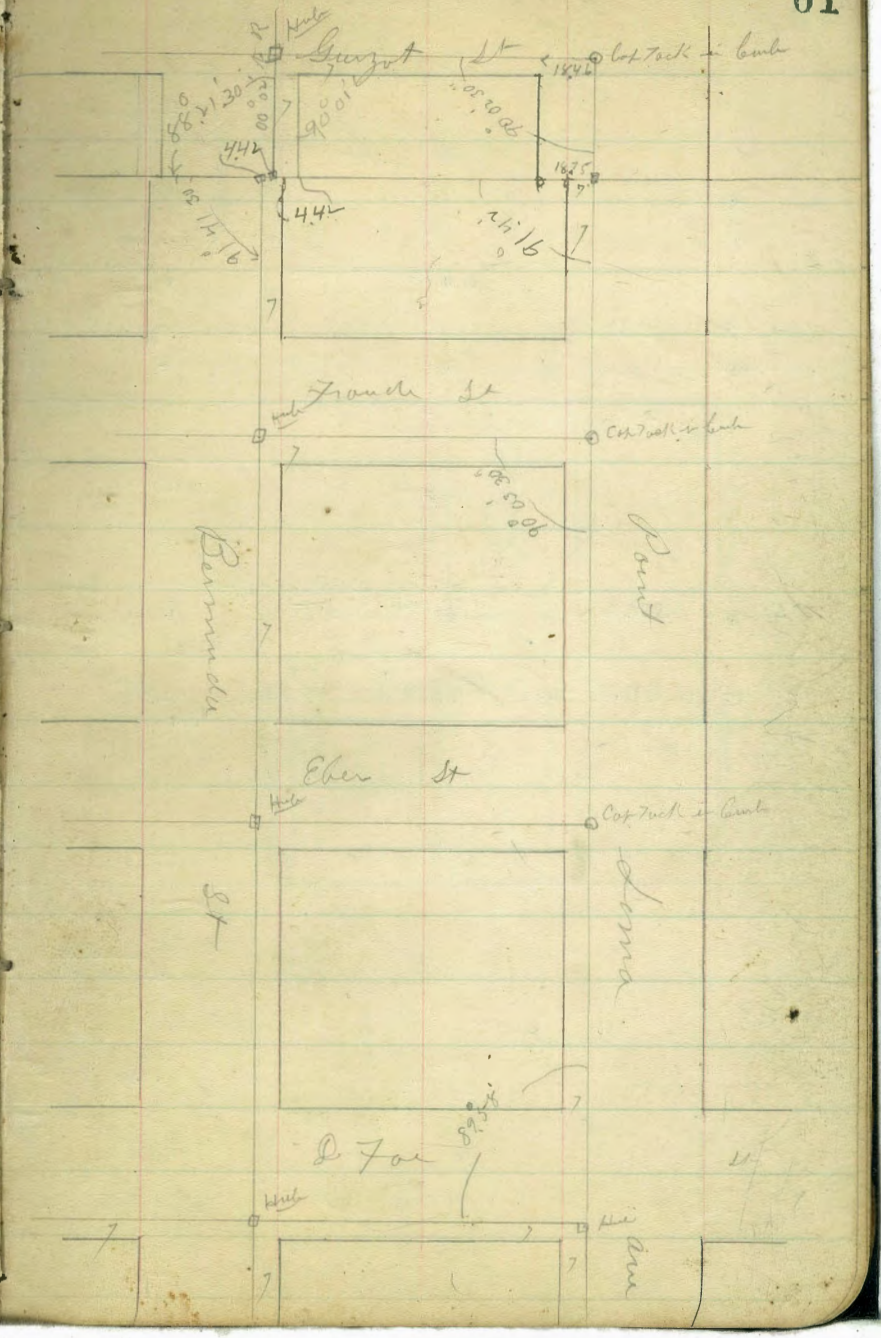

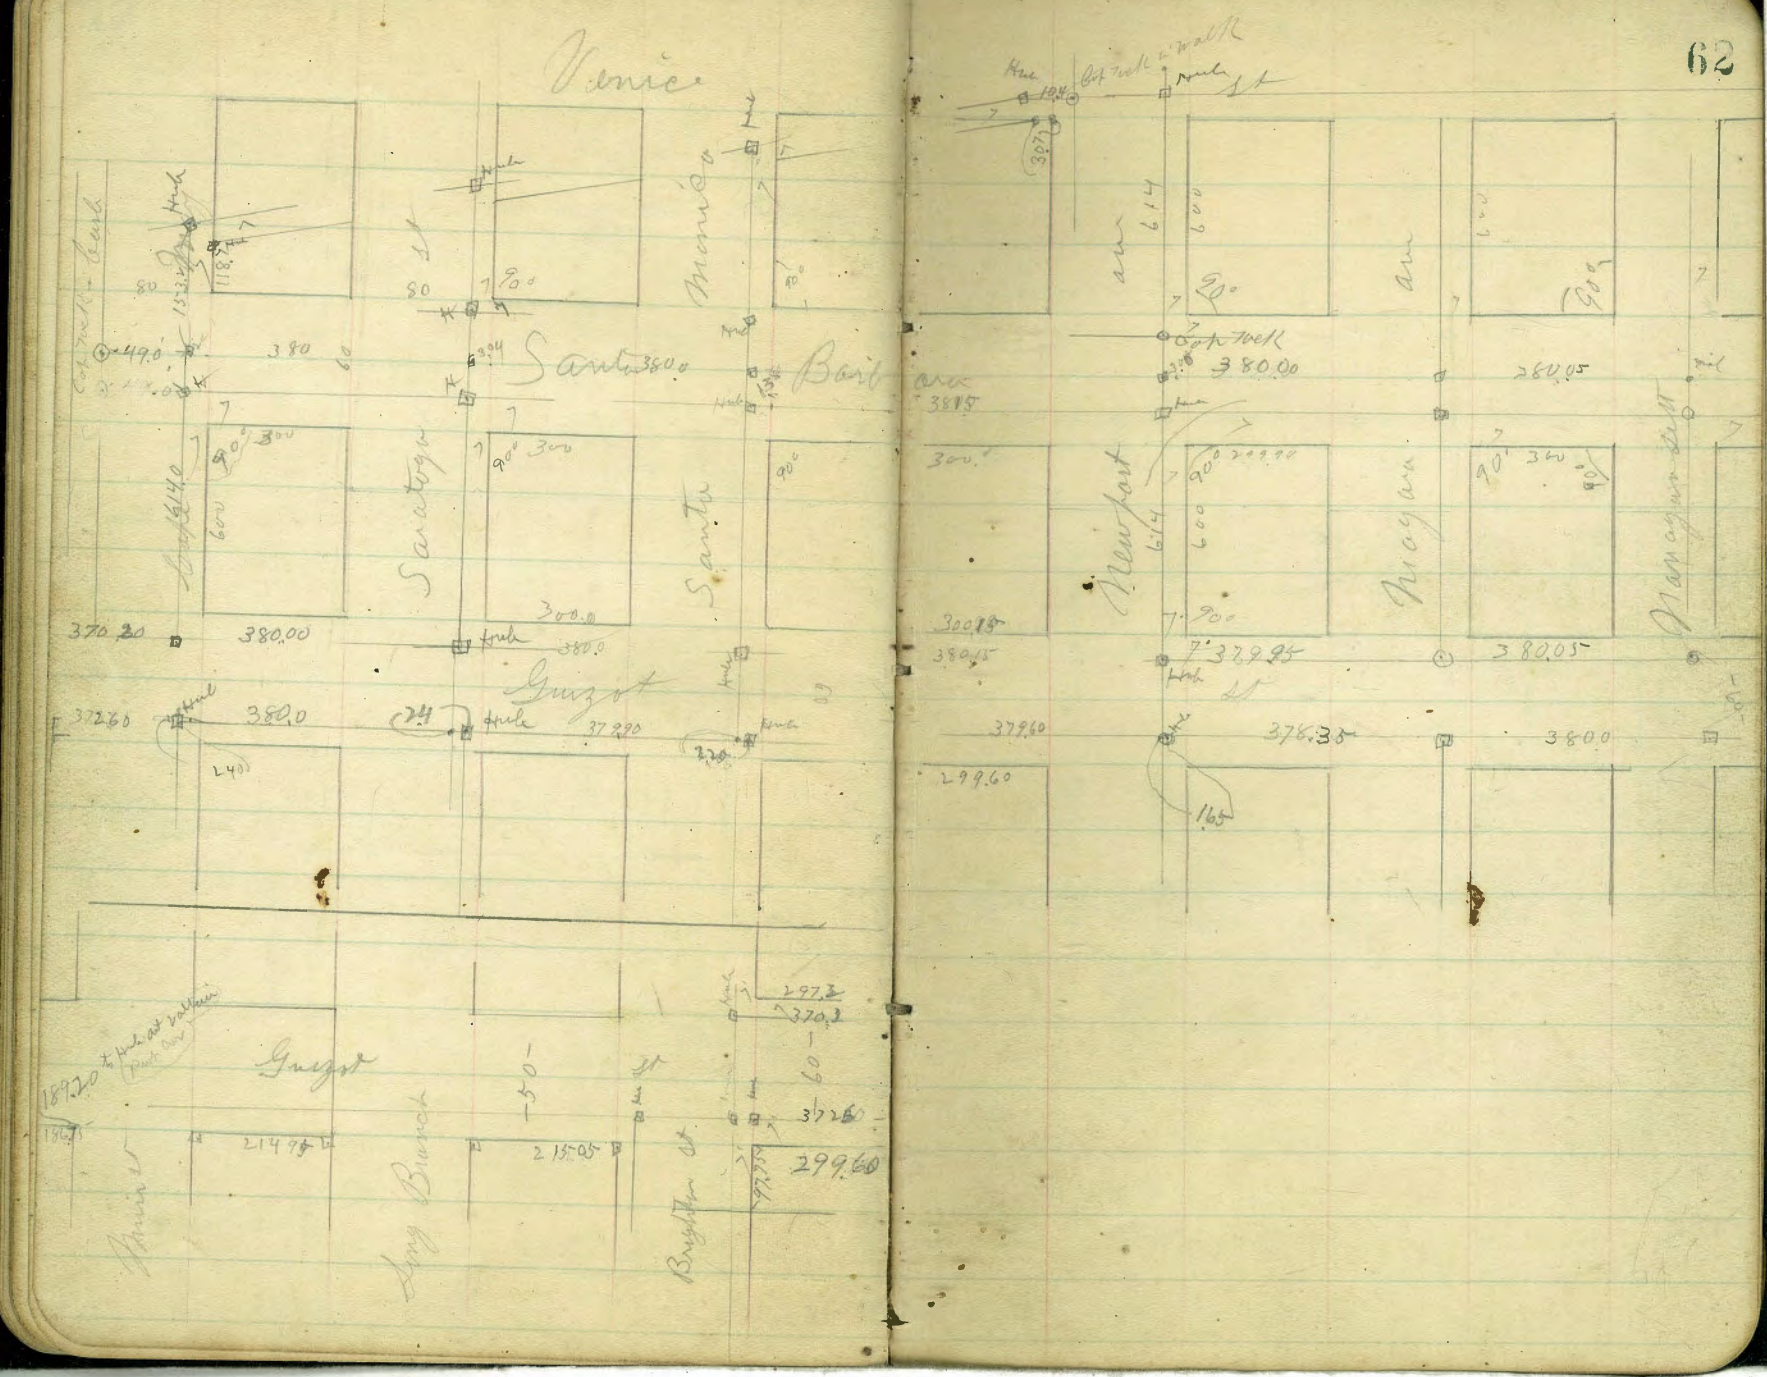
Venice
Santa Barb
Guzot
Newport
Aragon
Long Beach
Corner Land
380.00
300.0
299.60
380.05

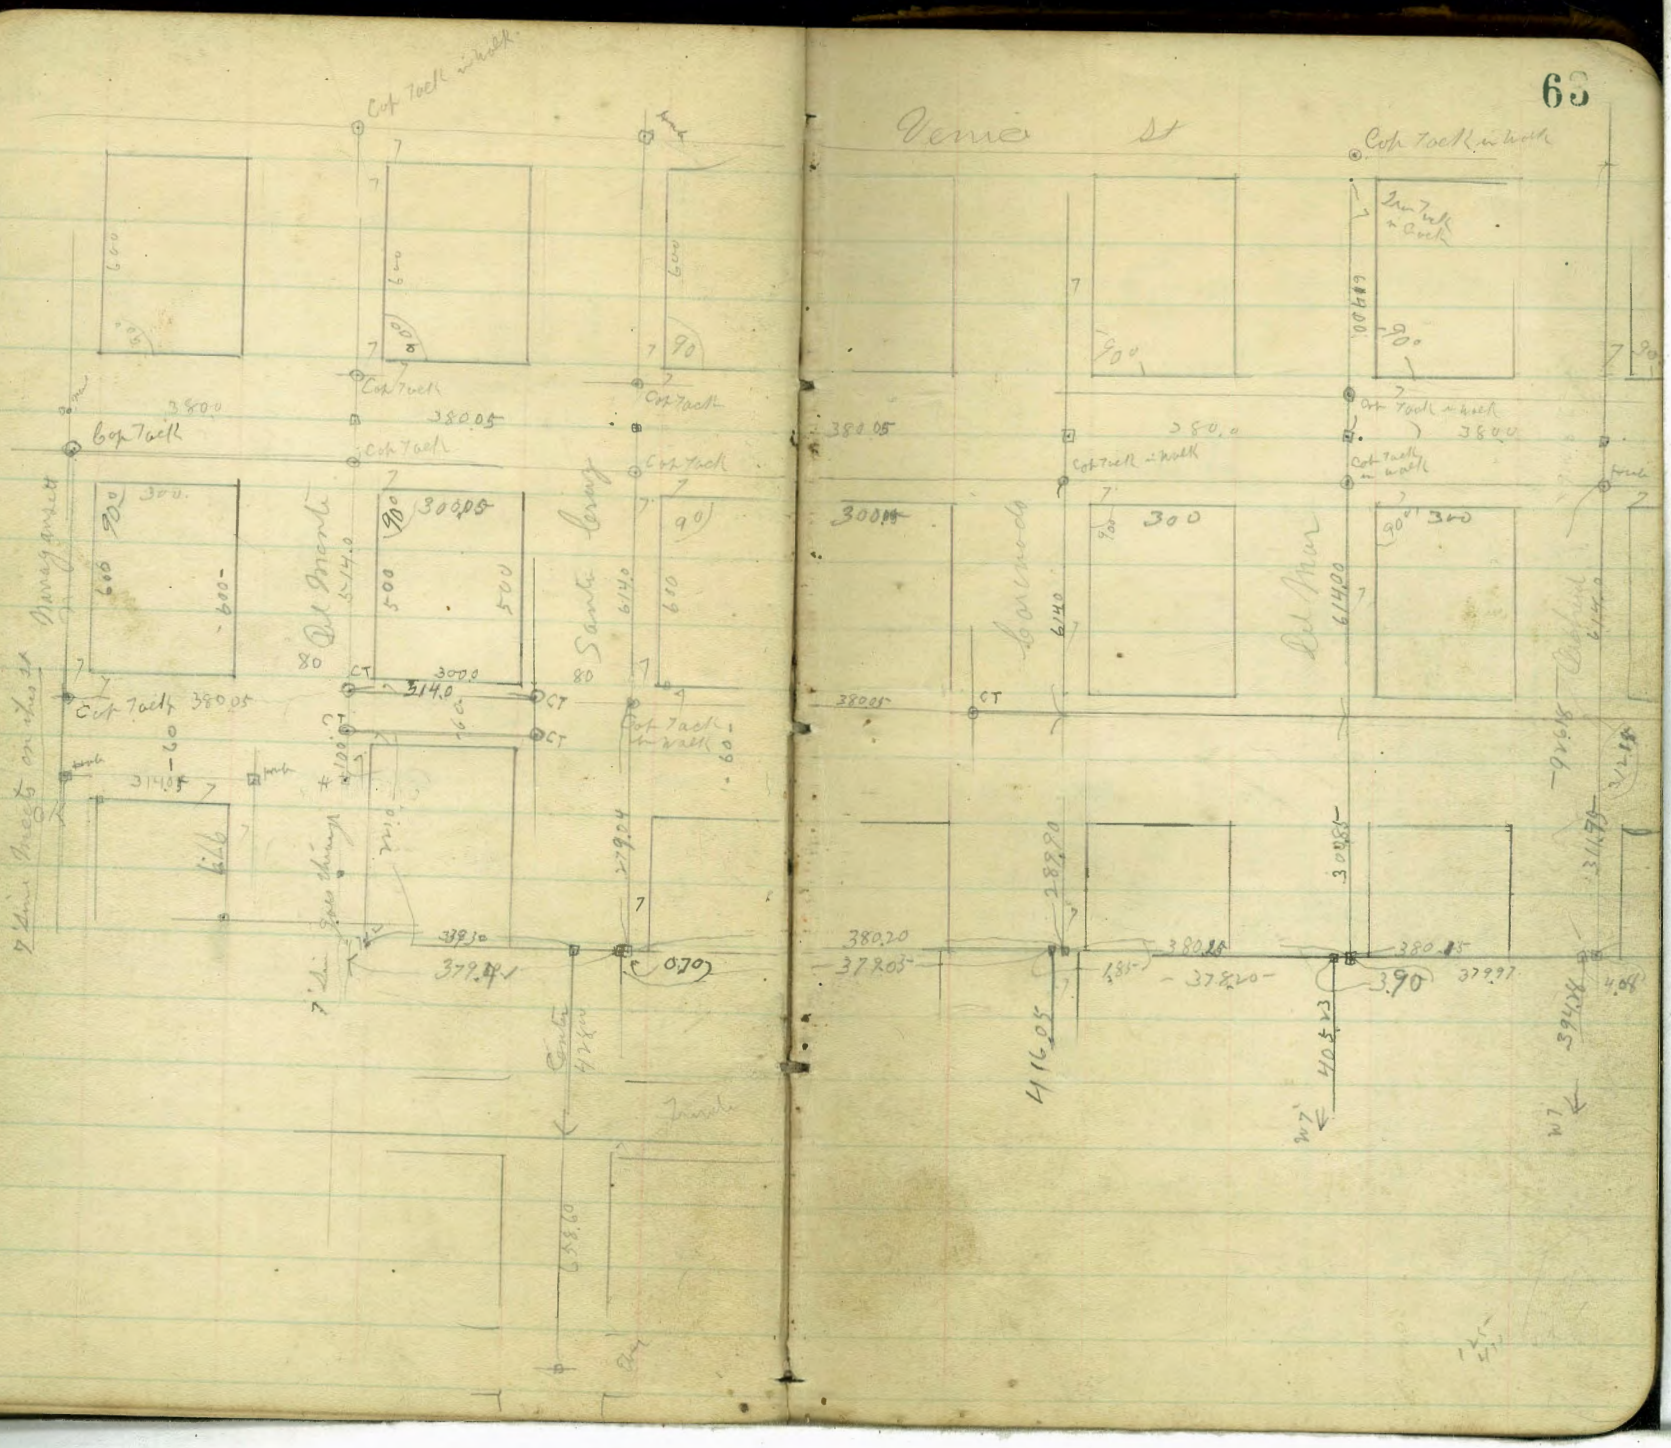
Venice St
Del Monte
Santa Lucia
Del Mar
Cut Track in Walk
380.05
380.0
300.05
300
314.0
379.04
379.91
380.20
380.15
378.20
378.05
379.97
288.20
416.05
404.23
6140
6000
5140
5000
90°
CT

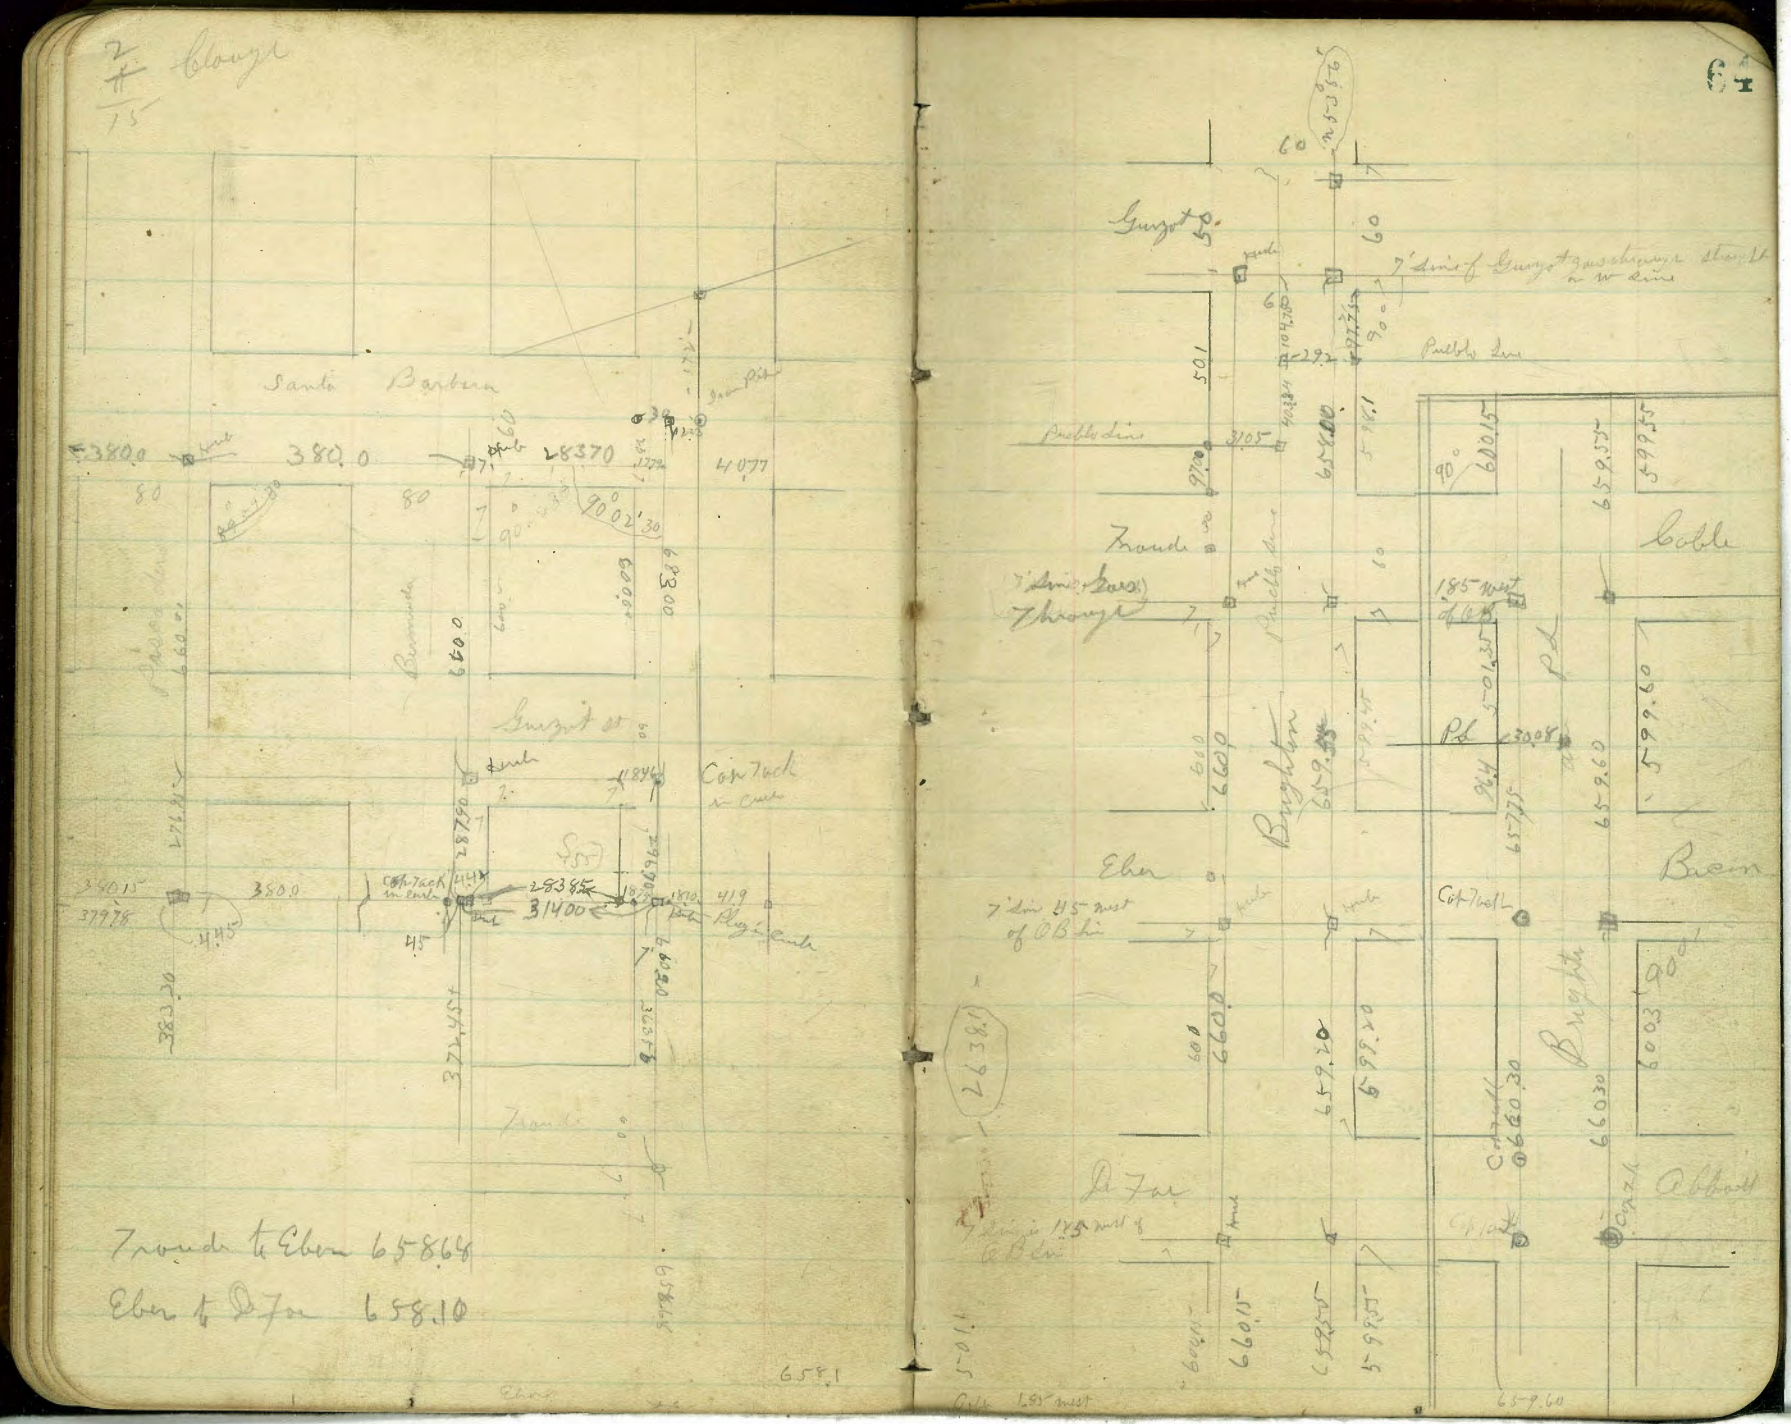
Santa Barbara
Guyot st
Cow Track
Eben
Brighton
Cable
Brown
Abbott
Pueblo line
7 ronde to Eben 65-86.4
Eben to De Foe 658.10

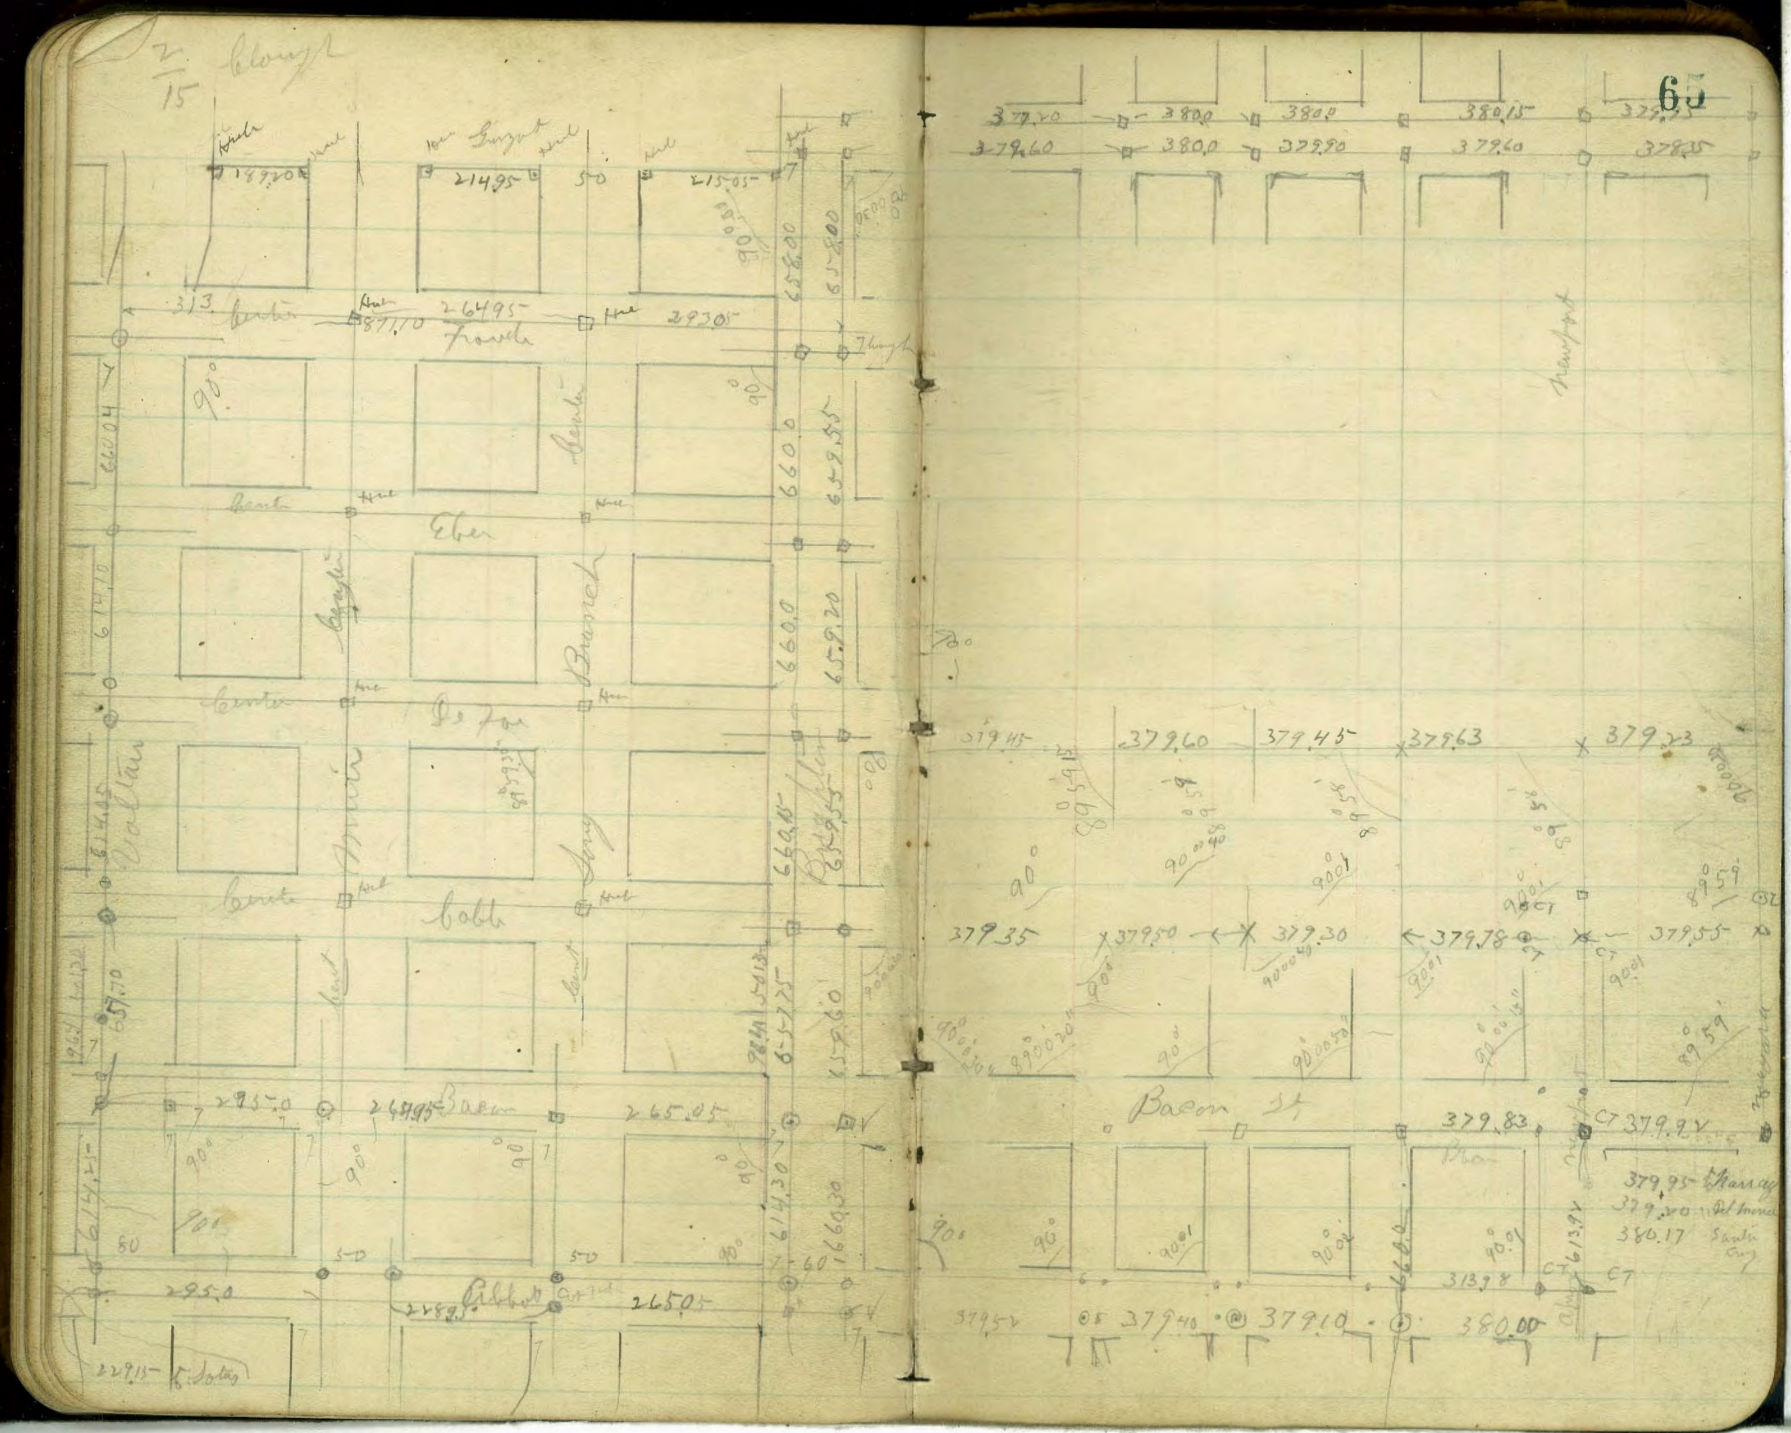
Eber
Basin St
379.83
380.17 Santa Cruz

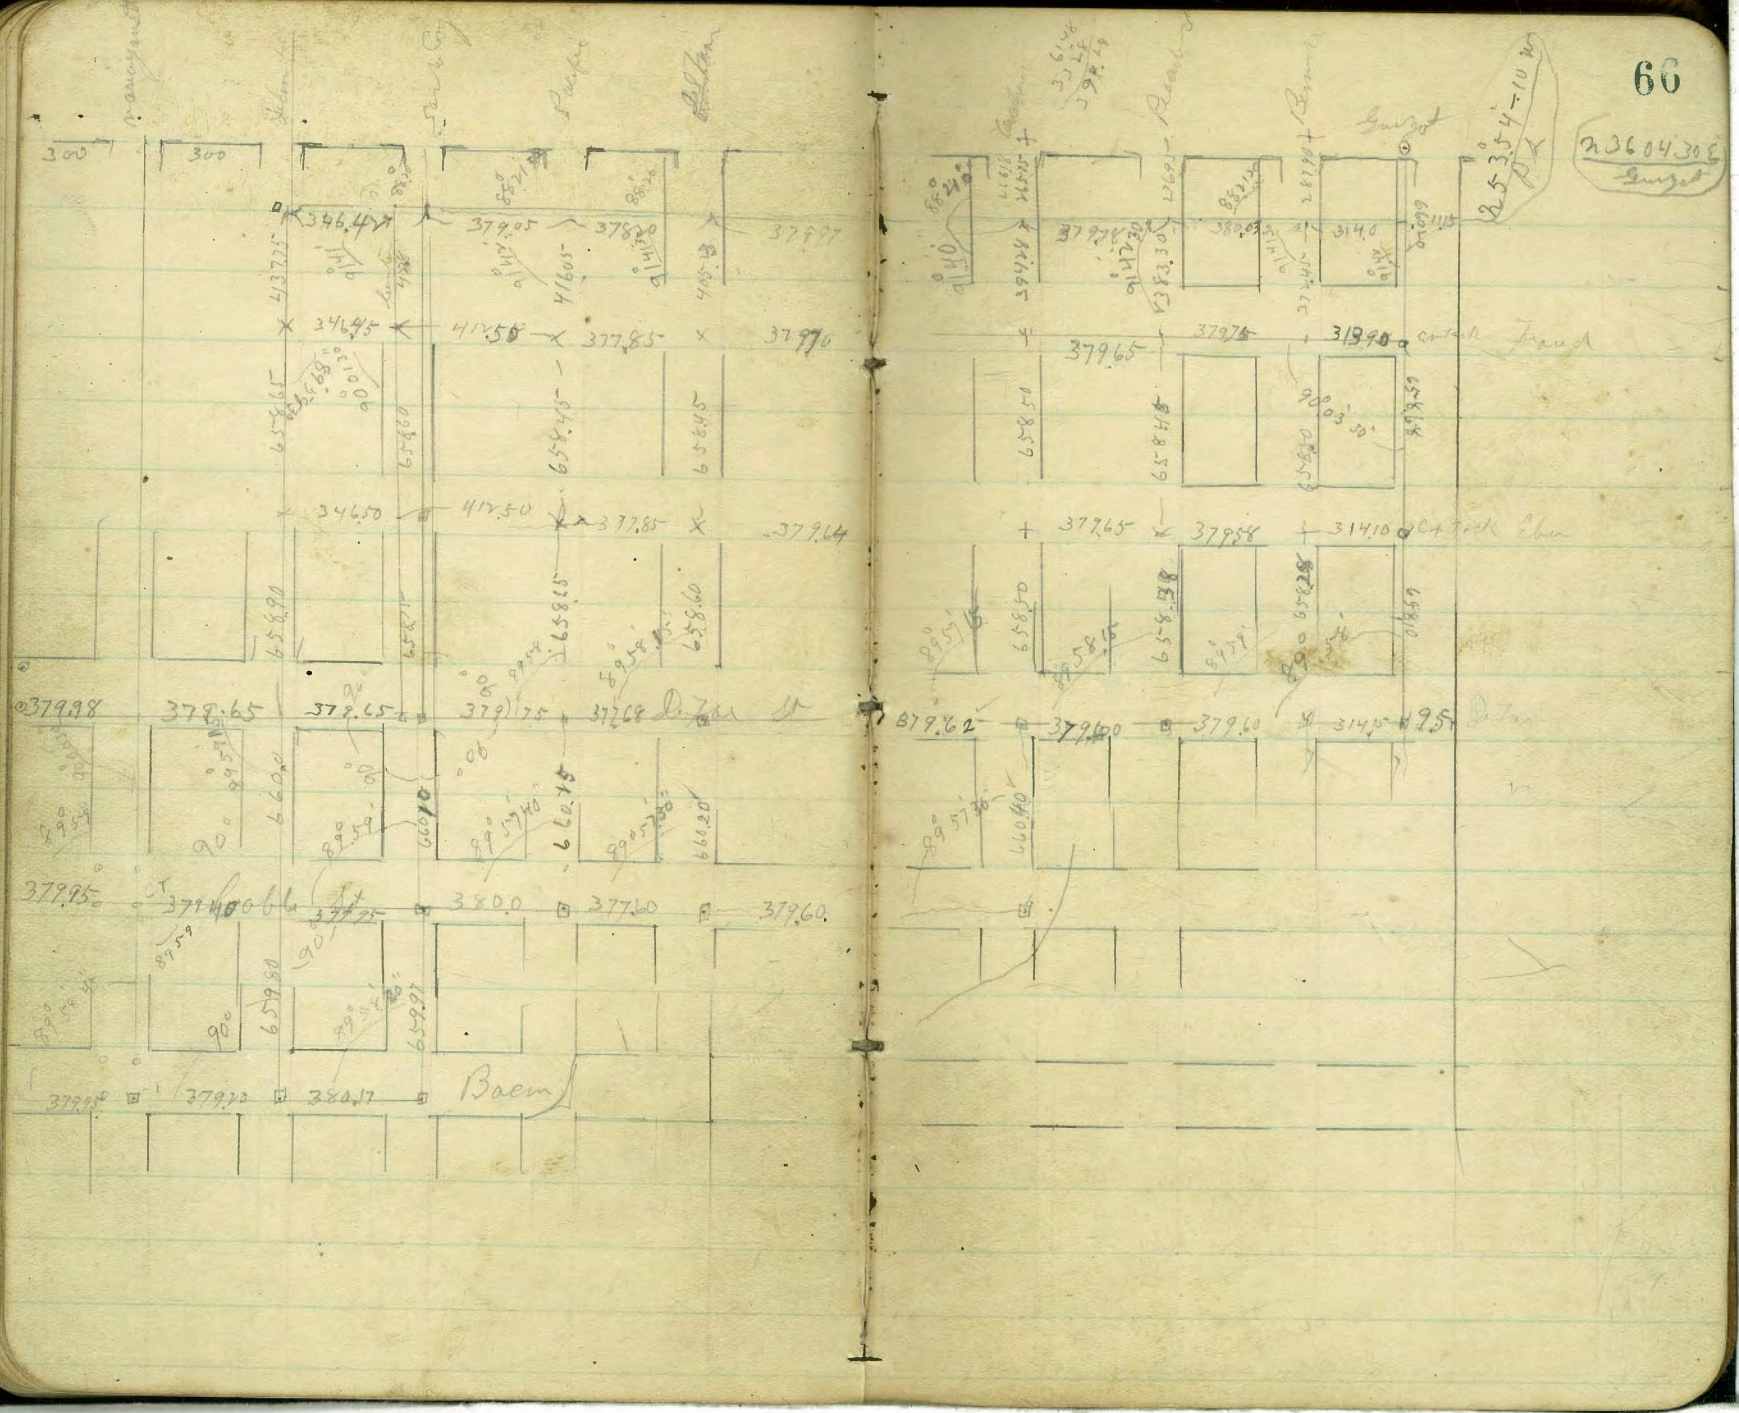
300
300
346.47
379.05
378.20
346.45
417.50
377.85
346.50
417.50
377.85
379.98
378.65
379.65
379.75
379.95
379.40
380.0
379.60
379.99
379.72
380.17
Baum
Garzot
379.65
379.78
379.65
379.62
379.60
379.60
314.0
314.10
Dr Zan

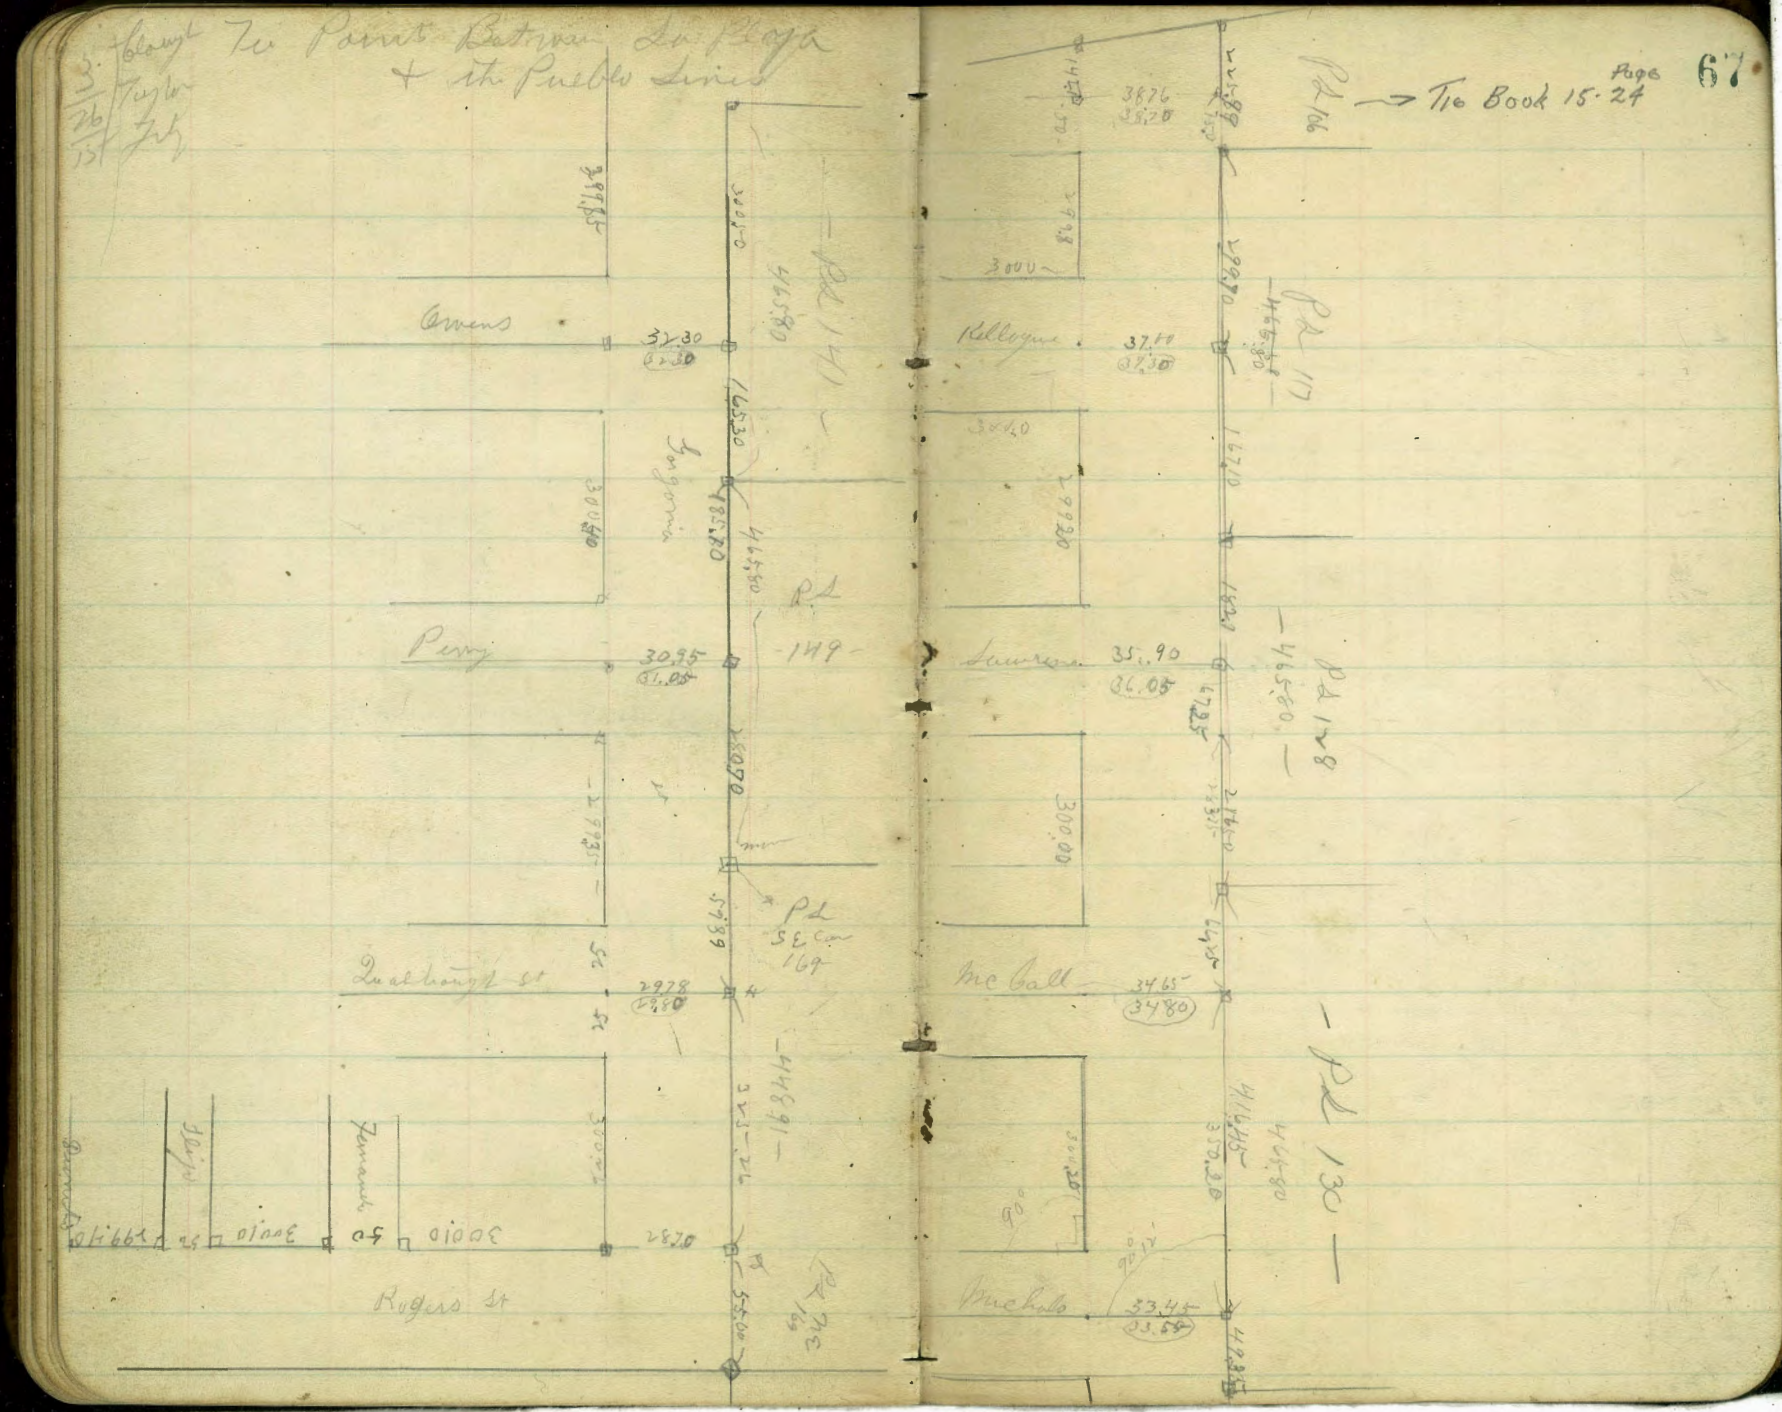
Clough
Taylor
Tie Point Between La Plaza & the Pueblo Lines
Owens
Perry
Longmire
Pd 149
Pd 147
Pd 148
Pd 117
Pd 130
Pd 106
→ Tie Book 15-24
Kellogue
Lawrence
Mc Call
Buchalo
Quathoupt St
Rogers St
Tamarack
Pine


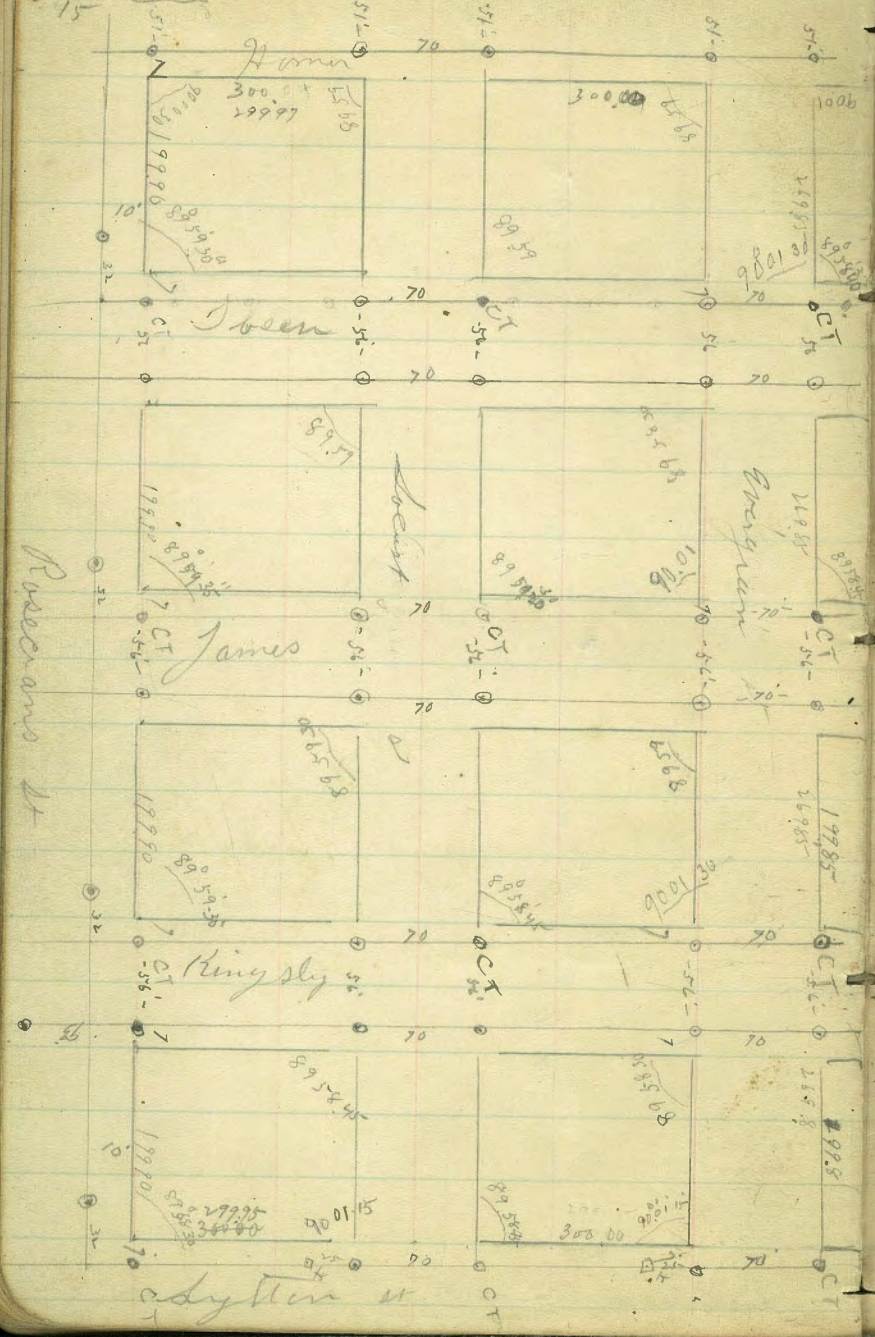

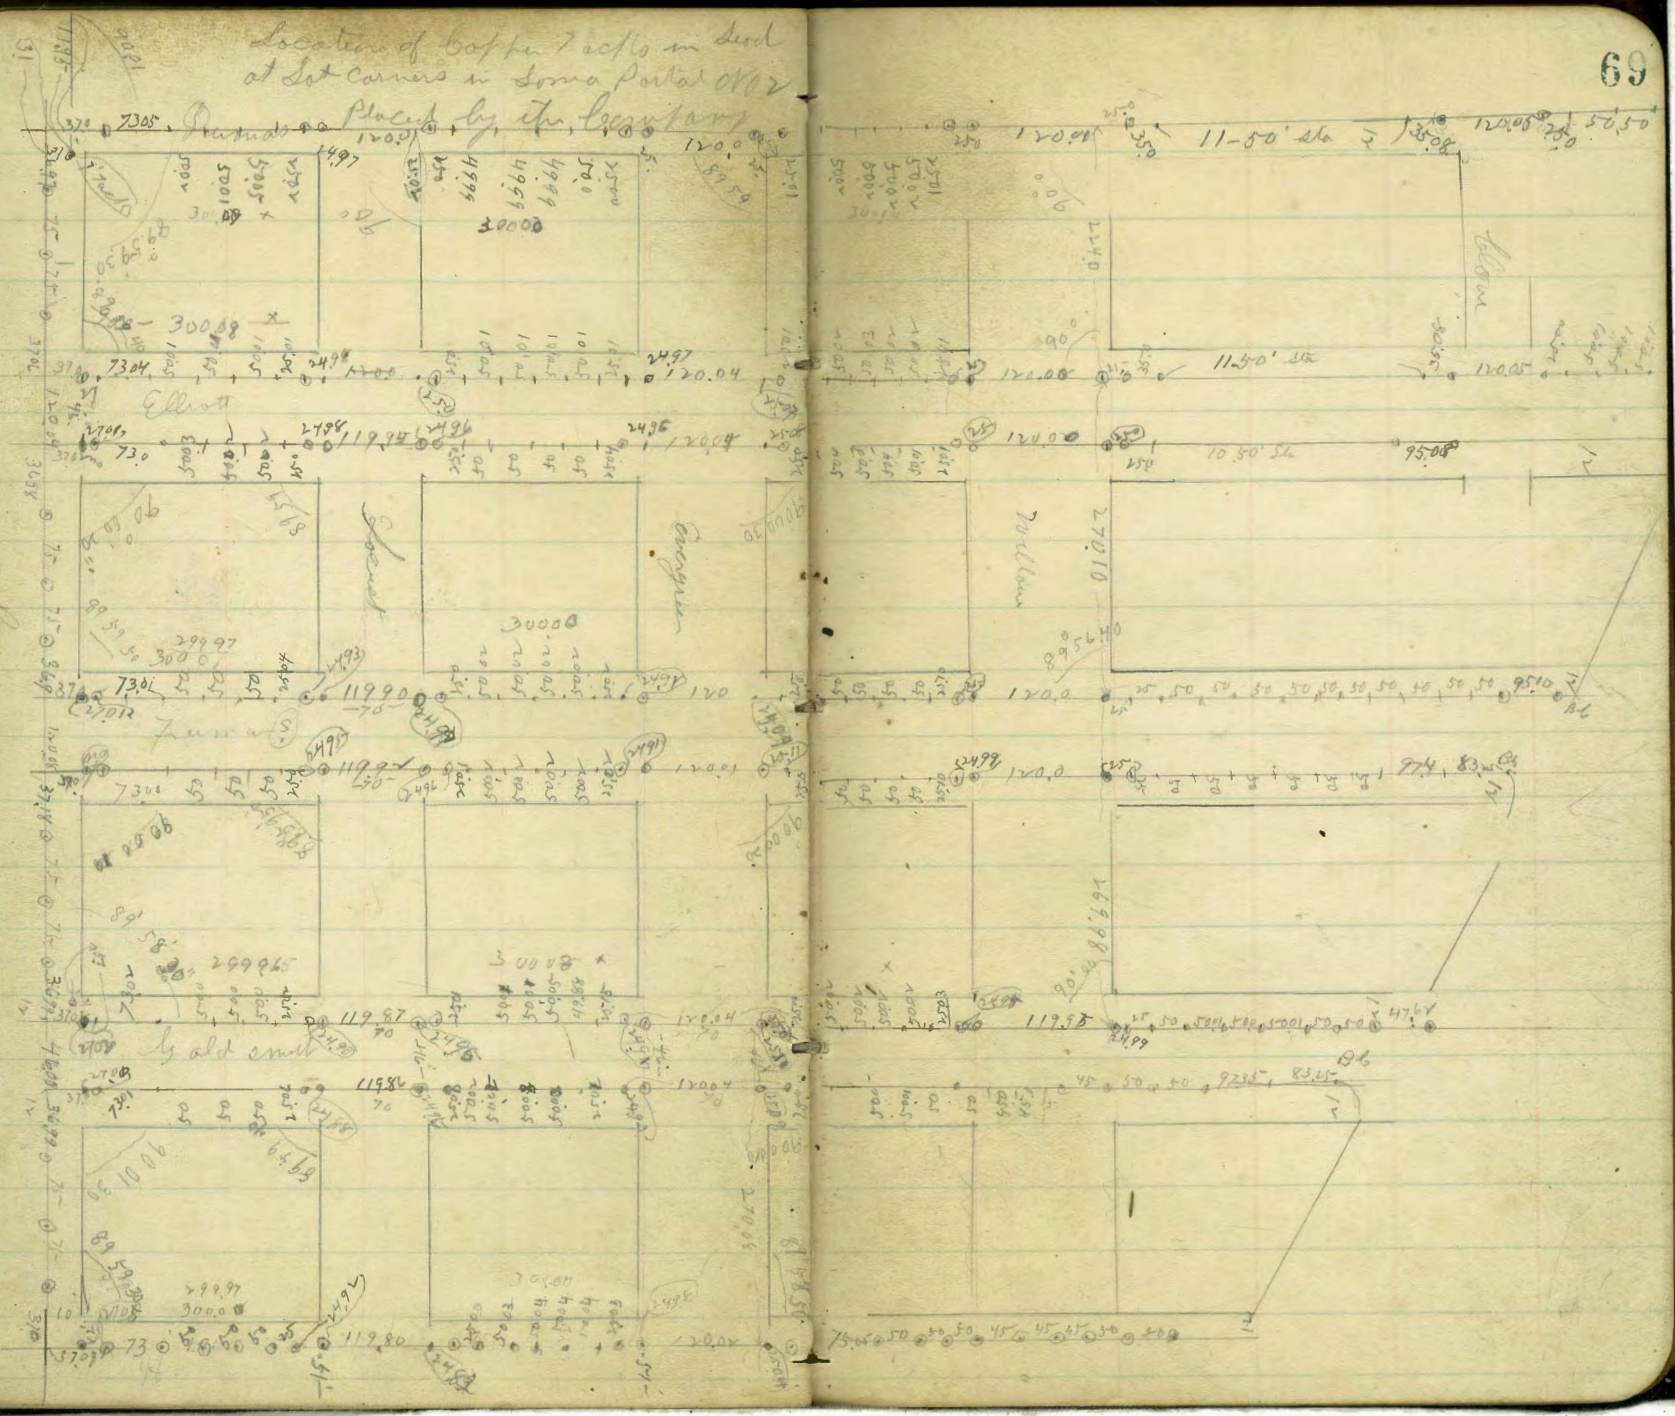
Location of copper tacks in lead at lot corners in stone portal
Placed by the Surveyor
Ramona
Elliott
Locust
Talbot
11-50' sta
10-50' sta

	NW 369	SW 368.6	
Swift	NE 369.5	SE 369.1	
	NW 370.4	SW 370.0	SW Spk pole 370.1 ±
Pacific	NE 370.9	SE 370.5	
	NW 370.0	SW 369.6	
Union	NE 369.6	SE 369.2	
	NW 368.7	SW 368.3	
Story	NE 368.2	SE 367.8	
	NW 364.3	SW 363.9	
Bradt	NE 364.3	SE 363.6	
	NW 360.1	SW 360.1	Spk in green tel pole in alley E of Road No 1 NW. 357.05
Reed	NE 359.6	SE 359.6	
	358.0	357.6	
Thomas	NE 358.0	SE 357.6	
	359.7	359.3	
Daly	359.7	359.3	
	358.6	358.3	
Sisson	358.3	358.0	
	357.0	356.7	
Hugo	357.0	356.7	
	356.4	356.1	
Conklin	356.7	356.4	
	357.5	357.0	Spk tel pole in Alley bet Stockton & Conklin 25' N. of Hugo 358.6 ±
Stockton	358.0	357.5	
	359.4	359.1	
Copeland	359.7	359.4	
	NW 362.5	362.5	
Van Dyke	NE 362.5	362.5	
	359.5	360.0	
Pantey	359.4	359.8	
	359.0	359.3	Spk pole S.W. cor 359.6
Fairmount	359.1	359.1	
	354.3	354.0	
Colonial	354.0	353.8	
	353.5	353.3	Spk pole S.W. 354.9
Highland	353.2	353.1	
Highland	352.2	352.6	
University	361.6	361.0	

	NW 319.8	SW 359.0	
Unit 9 Fairmount	NE 359.8	SE 359.5	

13170
13193
20.
283.63

13160
13175
201
183.35
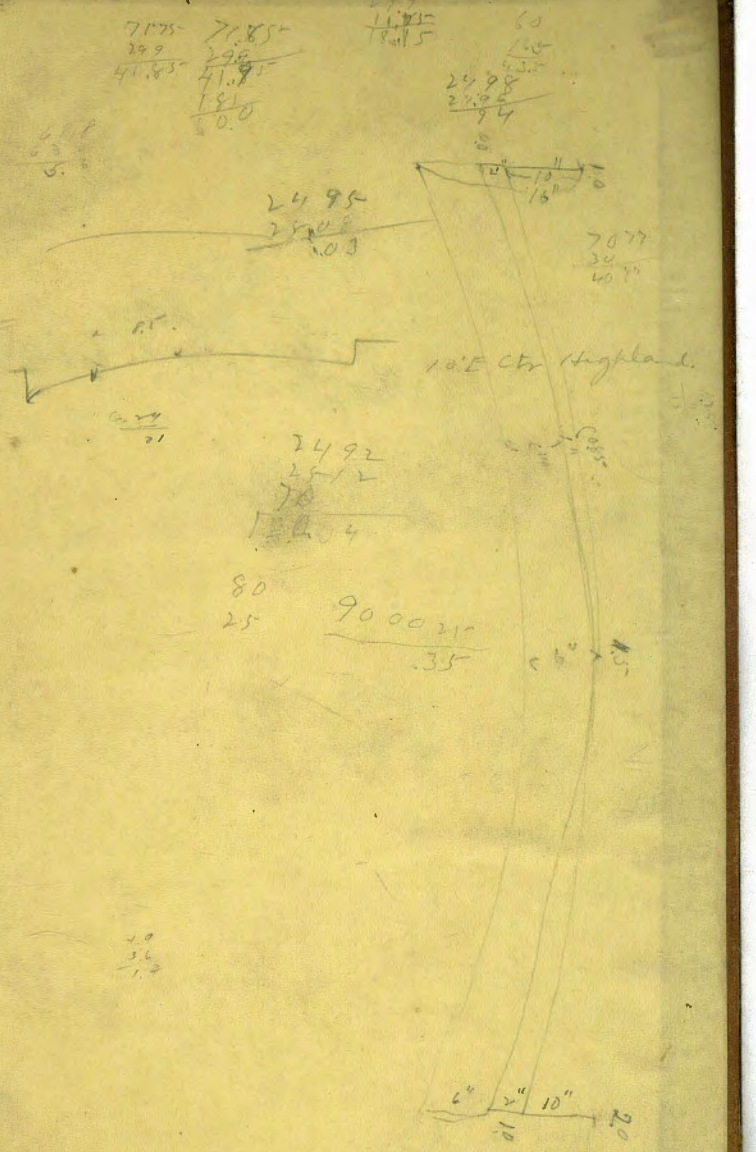
30
11.75
18.25