TIE POINT 27

PACIFIC BEACH

BASTA

FIELD BOOK

T. P. 27

No. 385F

W.O. 20008

430
94°40

16+60.76
48.32
17+09.08

Our Leather Bound Engineers Note Books are carried in the following rulings:

No. 380 LEVEL BOOK. Left and Right Hand Page the same as Left Hand Page of this Book.

No. 382 FIELD BOOK. Left Hand Page as in this Book, Right Hand Page 4 x 4 to the inch, Center Line Red.

No. 384 MINING TRANSIT BOOK. Left Hand Page as in this Book, Right Hand Page 8x8 to the inch, Center Line Red.

No. 385 FIELD BOOK. Left Hand Page as in this Book, Right Hand Page 8 vertical and 4 horizontal lines to the inch, Center Line Red.

We also carry the Note Books listed above, bound in extra strong Fabri-Hide (otherwise the same quality of book), which can be furnished at a somewhat lower price.

In ordering Fabri-Hide covered books, add the letter *"F"* to catalog number.

THE FREDERICK POST CO.
ENGINEERING and DRAFTING SUPPLIES
IRVING PARK STATION
CHICAGO, ILL.

INDEXED
W.R.
JUN 22 1950

to page # 13 & pages 60 to 69
& pages 75, 76

INDEX - T. P. 27

STREET	PAGES
— SOLEDAD TERRACE —	
LOS ALTOS RD.	2-9
COLLINGWOOD DR.	2-3, 13
SOLEDAD RD.	2-3, 5
LORING ST.	2-3
COLINA ST.	2, 6
ALTA VISTA ST.	5, 9-10
JEWELL ST.	8
— CROWN POINT —	
MOORLAND DR.	60-61, 65-66
FRONTERA ST.	60, 62
RIVIERA DR.	60, 62-65
CROWN POINT DR.	61, 66-69
JEWELL ST.	61-62, 66-69
LA PLAYA AVE.	61
INGRAHAM ST.	62-63, 66-67
BEACH PROMENADE	62
EDGECLIFF DR.	62
BUENA VISTA	62-65
BAYONNE ST.	62-65
YOSEMITE	62, 66-69
LA CIMA	63, 68
PROMONTORY	63-65
LA MANCHA	64, 67
EDEN DR.	69

STREET	PAGES
— HOMELAND VILLA —	
ALBUQUERQUE	75-76
DE SOTO	75
DEL REY	75
ALLESSANDRO	75-76
PASADENA ST.	75-76
BALBOA AVE.	75-76
SANTA FE AVE.	76
PACIFIC BLVD.	76
Soledad Road & Tank	Pg 14
Los Altos Road	18 & 19

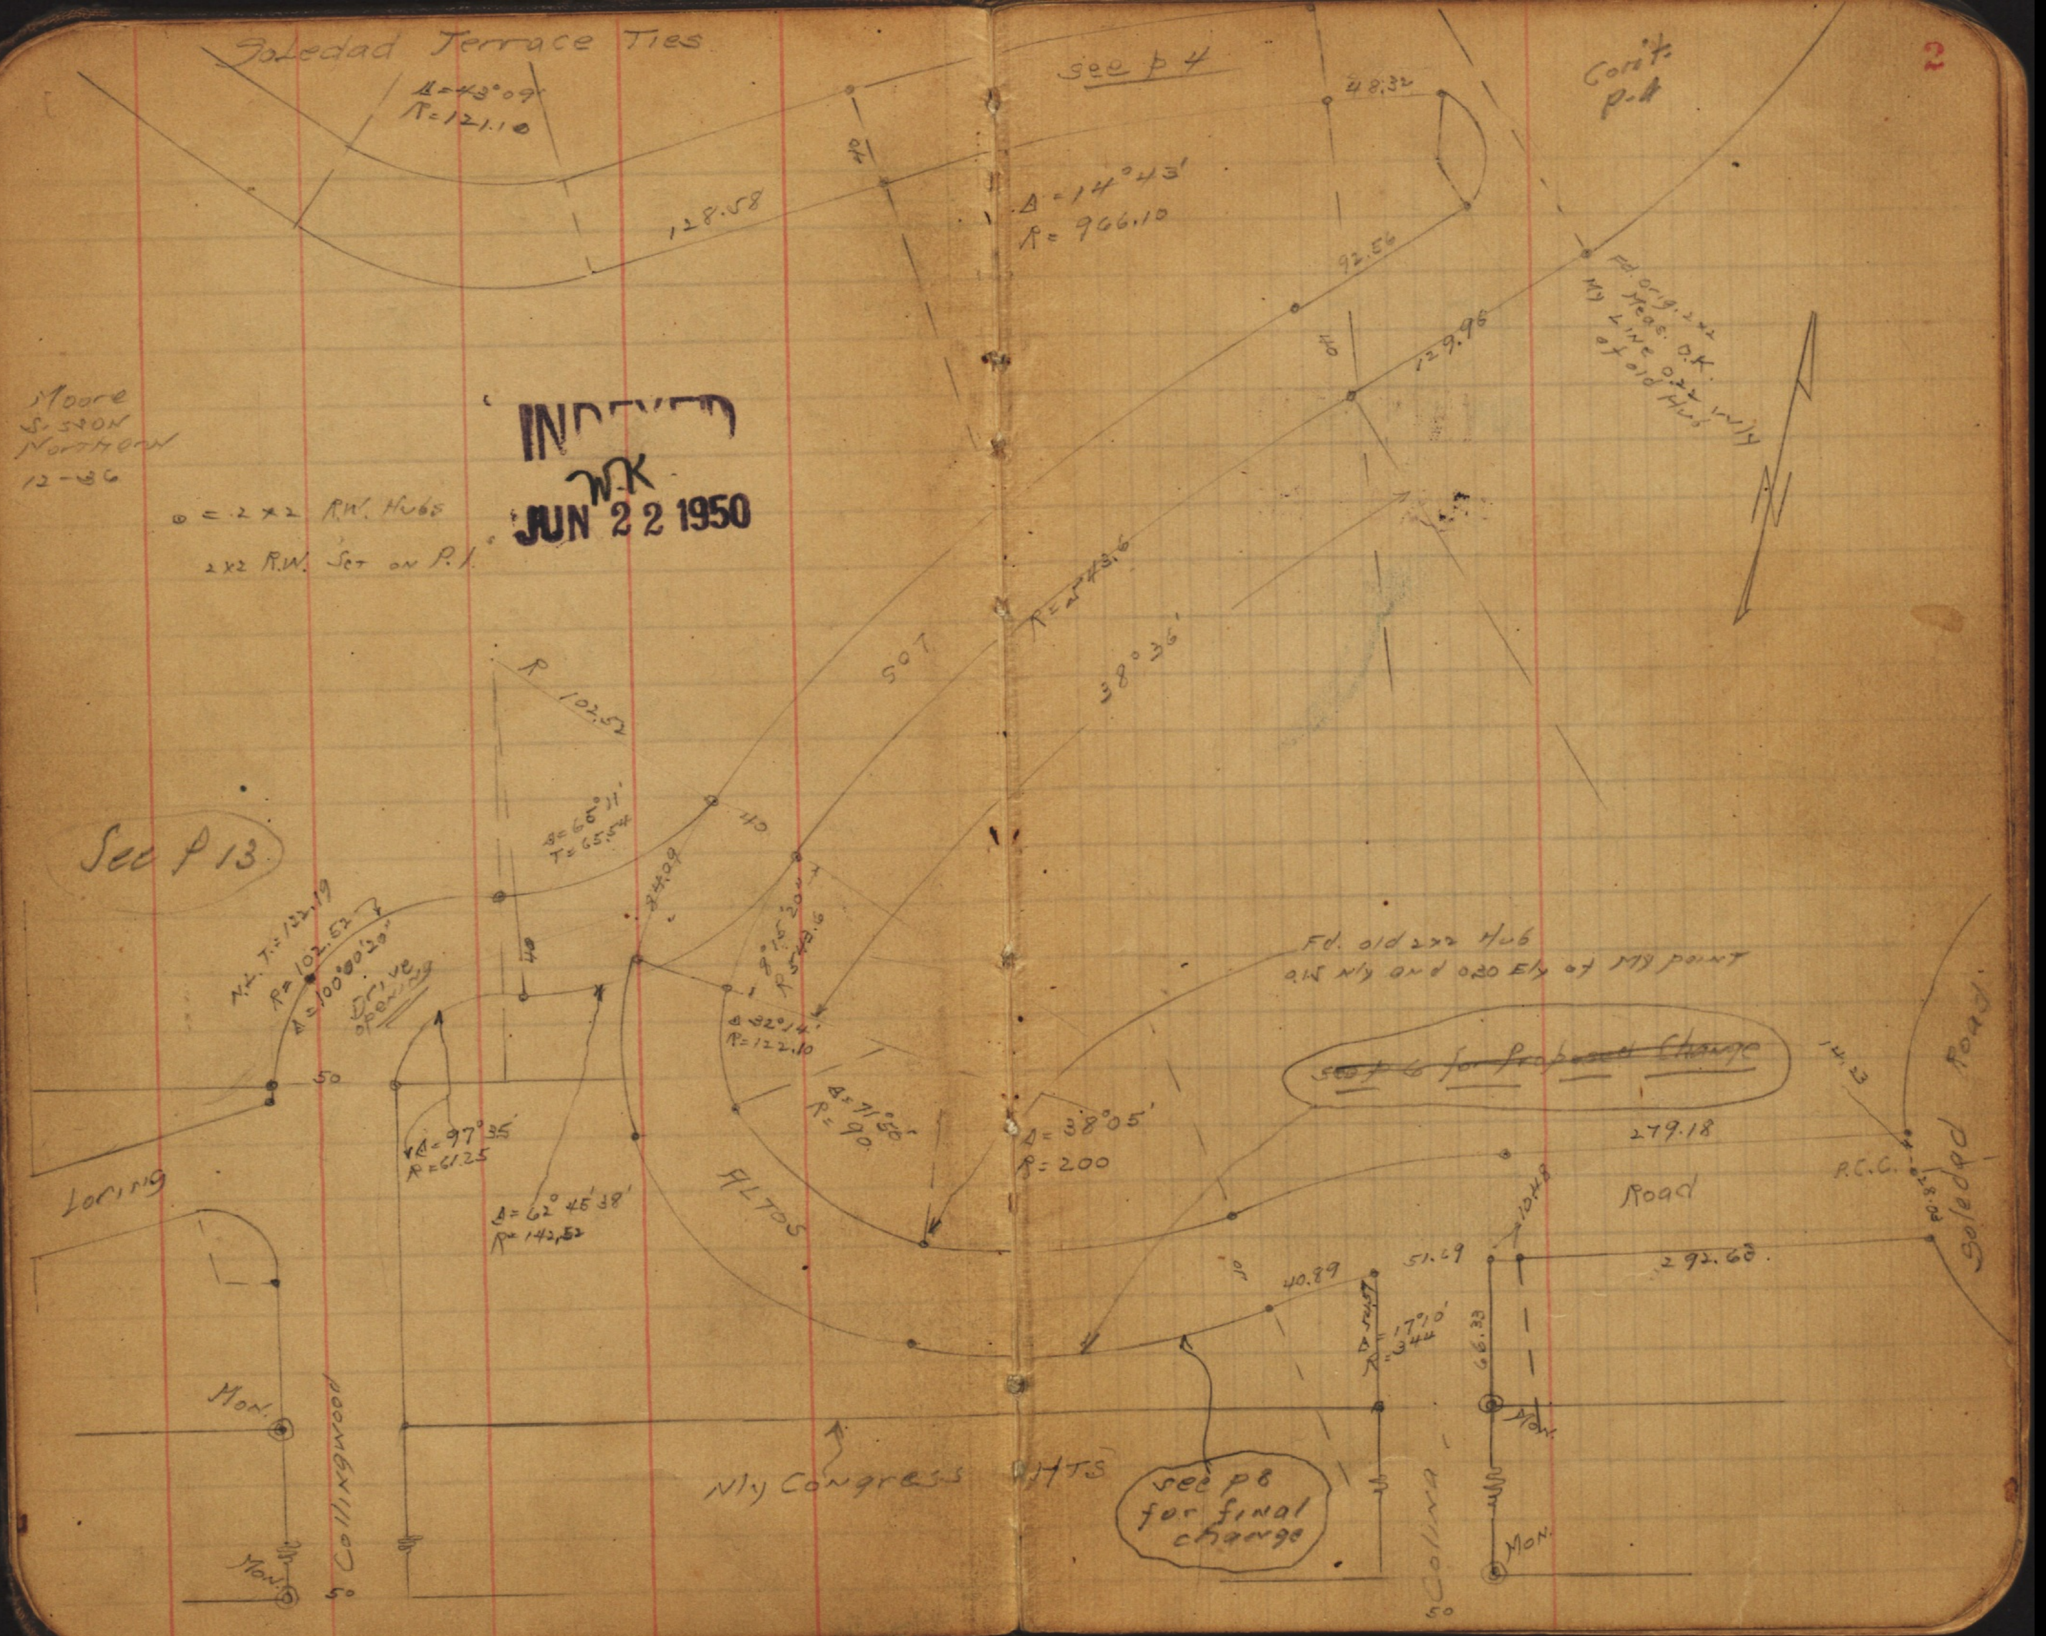
Soledad Terrace Ties
Δ=43°09'
R=121.10
128.58
see p 4
Δ=14°43'
R=966.10
48.32
92.56
129.96
Cont. p.4
Fd. orig. 2x2 Meas. O.K. My Line 0.22 Wly of old Hub
Moore Sisson Northern 12-36
⊙ = 2x2 R.W. Hubs
2x2 R.W. Set on P.I.
INDEXED
W.K.
JUN 22 1950
R=543.6
38°36'
R 102.52
See P 13
Δ=65°11'
T=65.54
84.09
N.L. T.=122.19
R=102.52
Δ=100°00'20"
Drive opening
Δ=97°35'
R=61.25
Δ=62°45'38'
R=142.52
Δ=32°14'
R=122.10
Δ=71°50'
R=90
Δ=38°05'
R=200
Fd. old 2x2 Hub
0.15 Nly and 0.30 Ely of My point
see p 6 for Proposed Change
279.18
Road
P.C.C.
Soledad Road
Loring
ALTOS
Mon.
Collingwood
Nly Congress HTS
see p 8 for final change
Δ=17°10'
R=344
40.89
51.69
292.68
66.33
Colina
50

Soledad Terrace Tits

3

⊙ = 2×2 R.M. Hubs

2×2 RW " set on P.I.'s

INDEXED
JUN 22 1950

See p 13

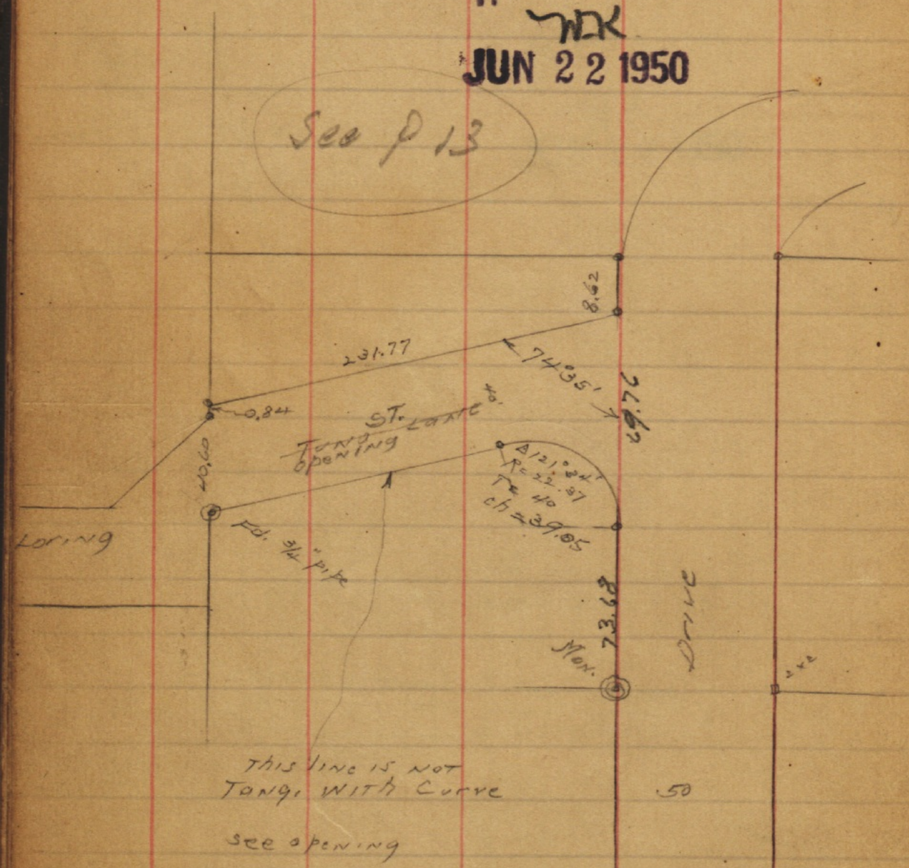

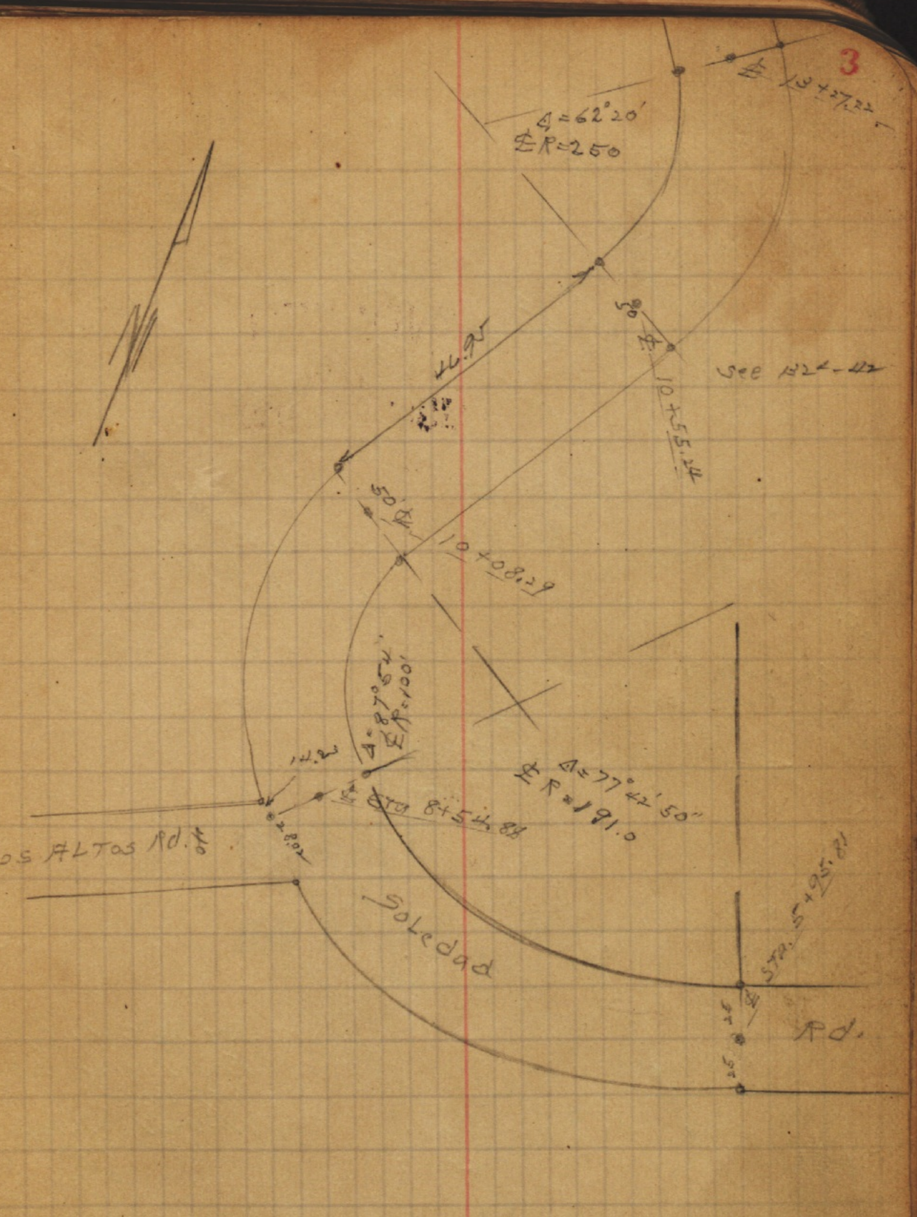

to Yajo Rd.

Map 37

Fd. H.-b 11-1-51 C.N.
Set 3/4" x 7" Galv. Pipe in Hard Pan

Fd. P.I. Hub 11-1-51 C&WS.

3/4" x 18" Pipe

369.99

P.I.

351.82

127.09

256.79

P.I.

127.09

205

250.27

℄ R=1556.40'

Δ = 26° 02'
R = 774.30
T = 179.0

Δ = 9° 20'
R = 1536.40
T = 125.40

3/4" x 12" Galv. Pipe in Conc.

Set Mon.

See P7 for Proposed Change of Alignt.

o = 2x2 RW Hubs

= 2x2 RW set on P.I.

180.10

Set ℄ P.I. 3/4" x 18" Pipe

Δ = 101° 32'
f = 127.50
T = 155.68

For Ties This Portion See P-17

Δ = 13° 30'
R = 893.30

℄ R = 913.30
℄ T = 108.09

210.41

60.80

P.I.

60.80

R = 913.30

o = Set 3/4" Galv. Pipe Filled with Ld. City Disc. 11-1-51 Walker Pope Clark

Fd. Pipe RE 5212

N 14° 17' 45" E

Ext. Line

Identical

℄ R = 913.30
℄ T = 55.79

Δ = 43° 09'
R = 121.10

71.20

55.79

P.I.

55.79

128.58

(3/4" x 7" Pipe 10" Deep)

50.25

Δ = 26° 32'
R = 108.94
T = 25.68

Fd. H-b 11-1-51

Δ = 9° 36'
R = 1069.67
T = 89.82

Soledad Terrace

Set Mon. Ties

• = Set 3/4" x 18" Galv. Iron Pipe Filled with Ld. Cap Disc. 11-1-51 C.B. Walker Pope Allen

1857.93 Road

Cont. p-18

231.74

Δ = 39° 30'
R = 294.74

Fd. old 2" Hub 1/2 Line 0.5' N'ly 2.89 N'ly of old hub

INDEXED
WK
JUN 22 1950

198.85

Δ = 15° 01'
R = 81.11
T = 146.46

48.32

Cont. p-18

Cont. p-2

92.56

Δ = 141° 43'
R = 966.10
℄ R = 986.10
℄ T = 127.34

248.14

Fd. 1x2 Orig. Hub 1/2 Line 0.3' N'ly of Hub Steam O.K.

129.96

Δ = 81° 35' 20"
R = 856.65

Soledad Terrace Ties

o = Set 2"x2" R/W Hubs

INDEXED
JUN 22 1950

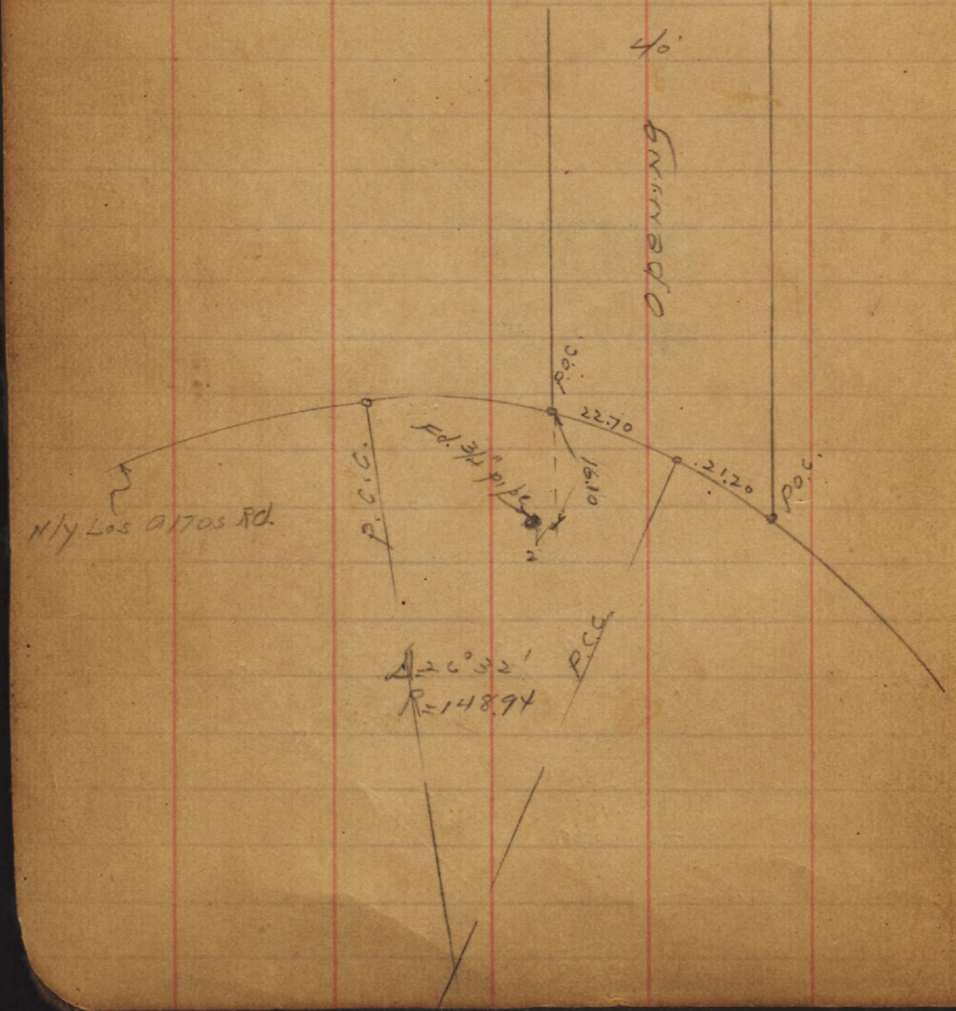

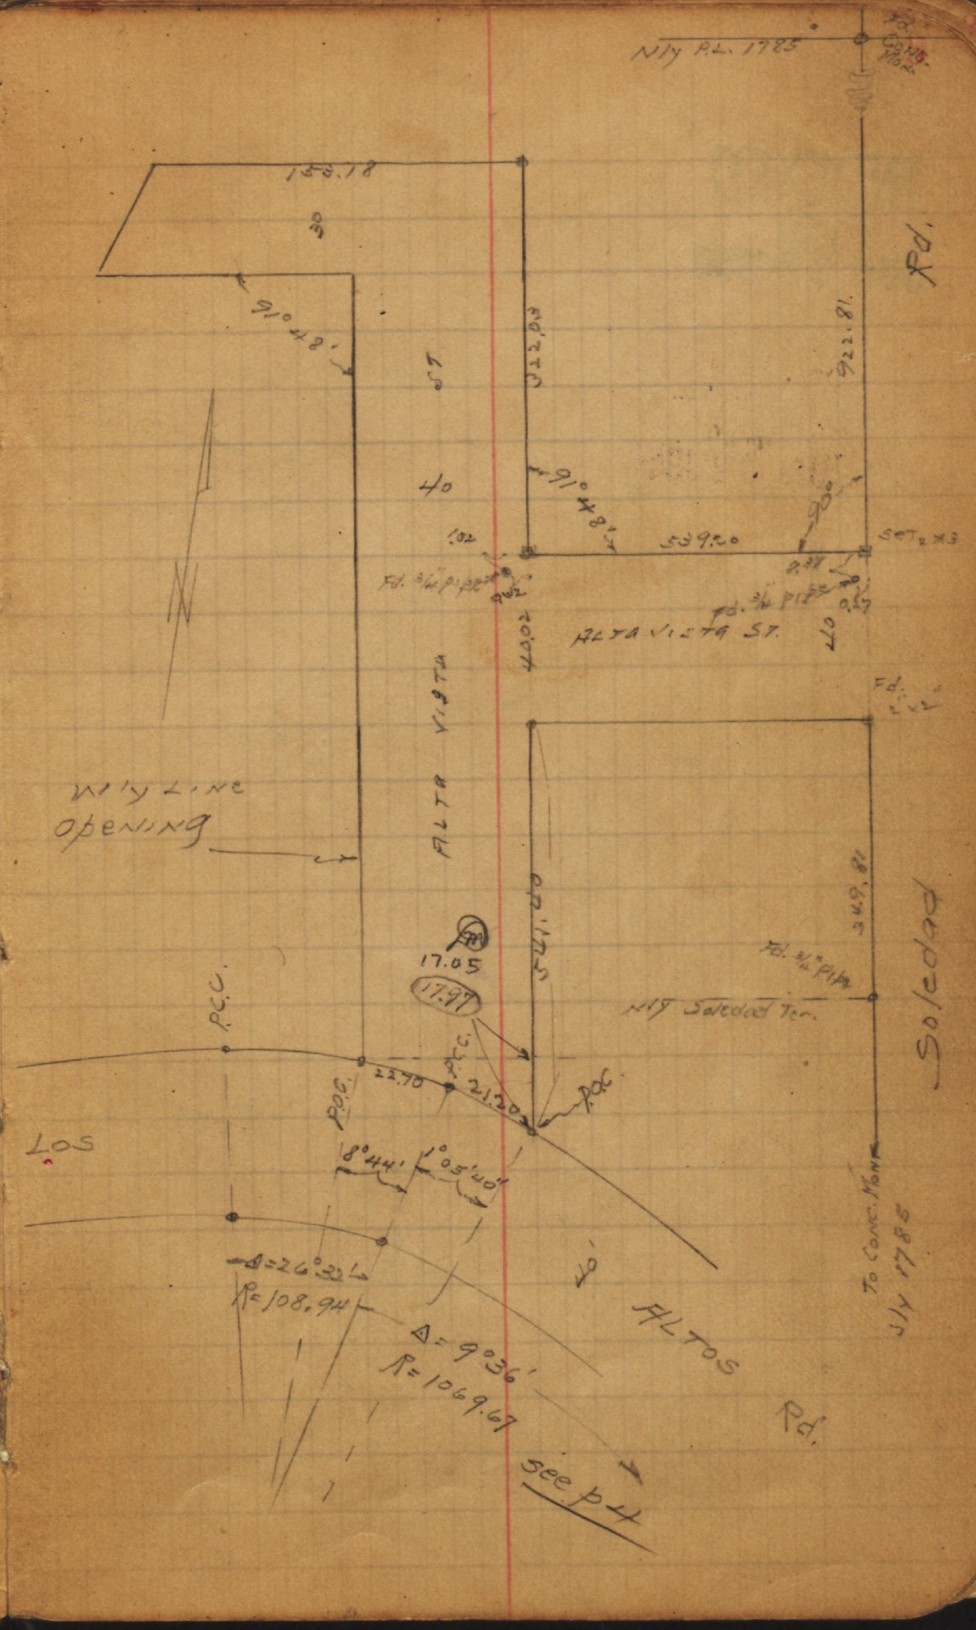

INDEXED
JUN 22 1950

Prop. change of Align.
of Los Altos Rd. Colina: wly
according to Miss K.O. Sessions wishes

Set 2x2 RW Moore 2-4-37

Note! see page 8
for 2nd change & Final

See p2 for Map Ties
Prop. change Sly of Los Altos Rd.

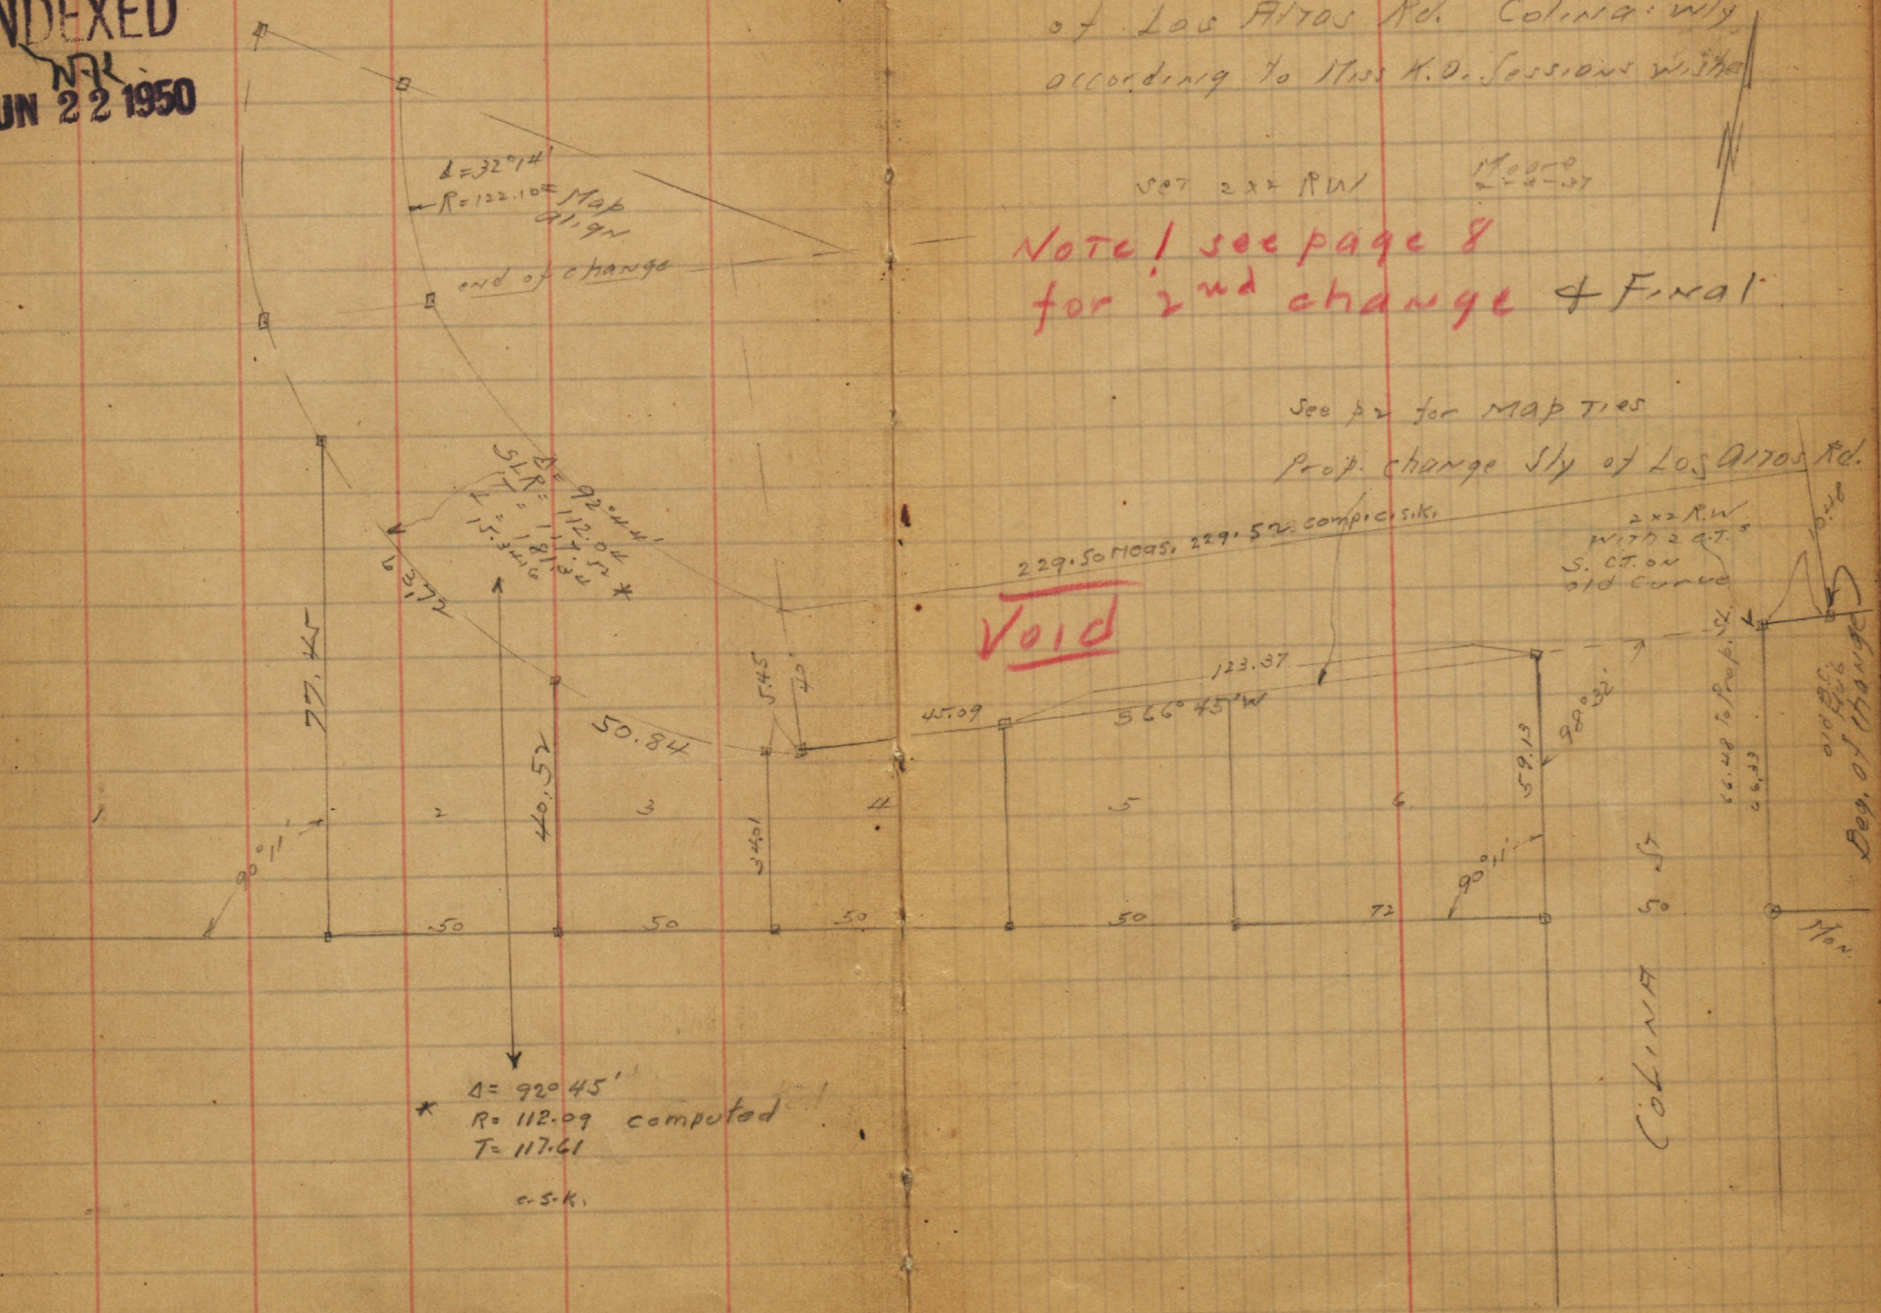

* Δ= 92° 45'
R= 112.09 computed
T= 117.61

c.s.k.

Proposed change of align. of Los Altos Rd. in Nwly section
according to wishes of Miss K.O. Sessions of Soledad Ter.

See p 4 for Map Ties

Set 2x2 R.W. Moore 2-3-37

INDEXED
NK
JUN 22 1950

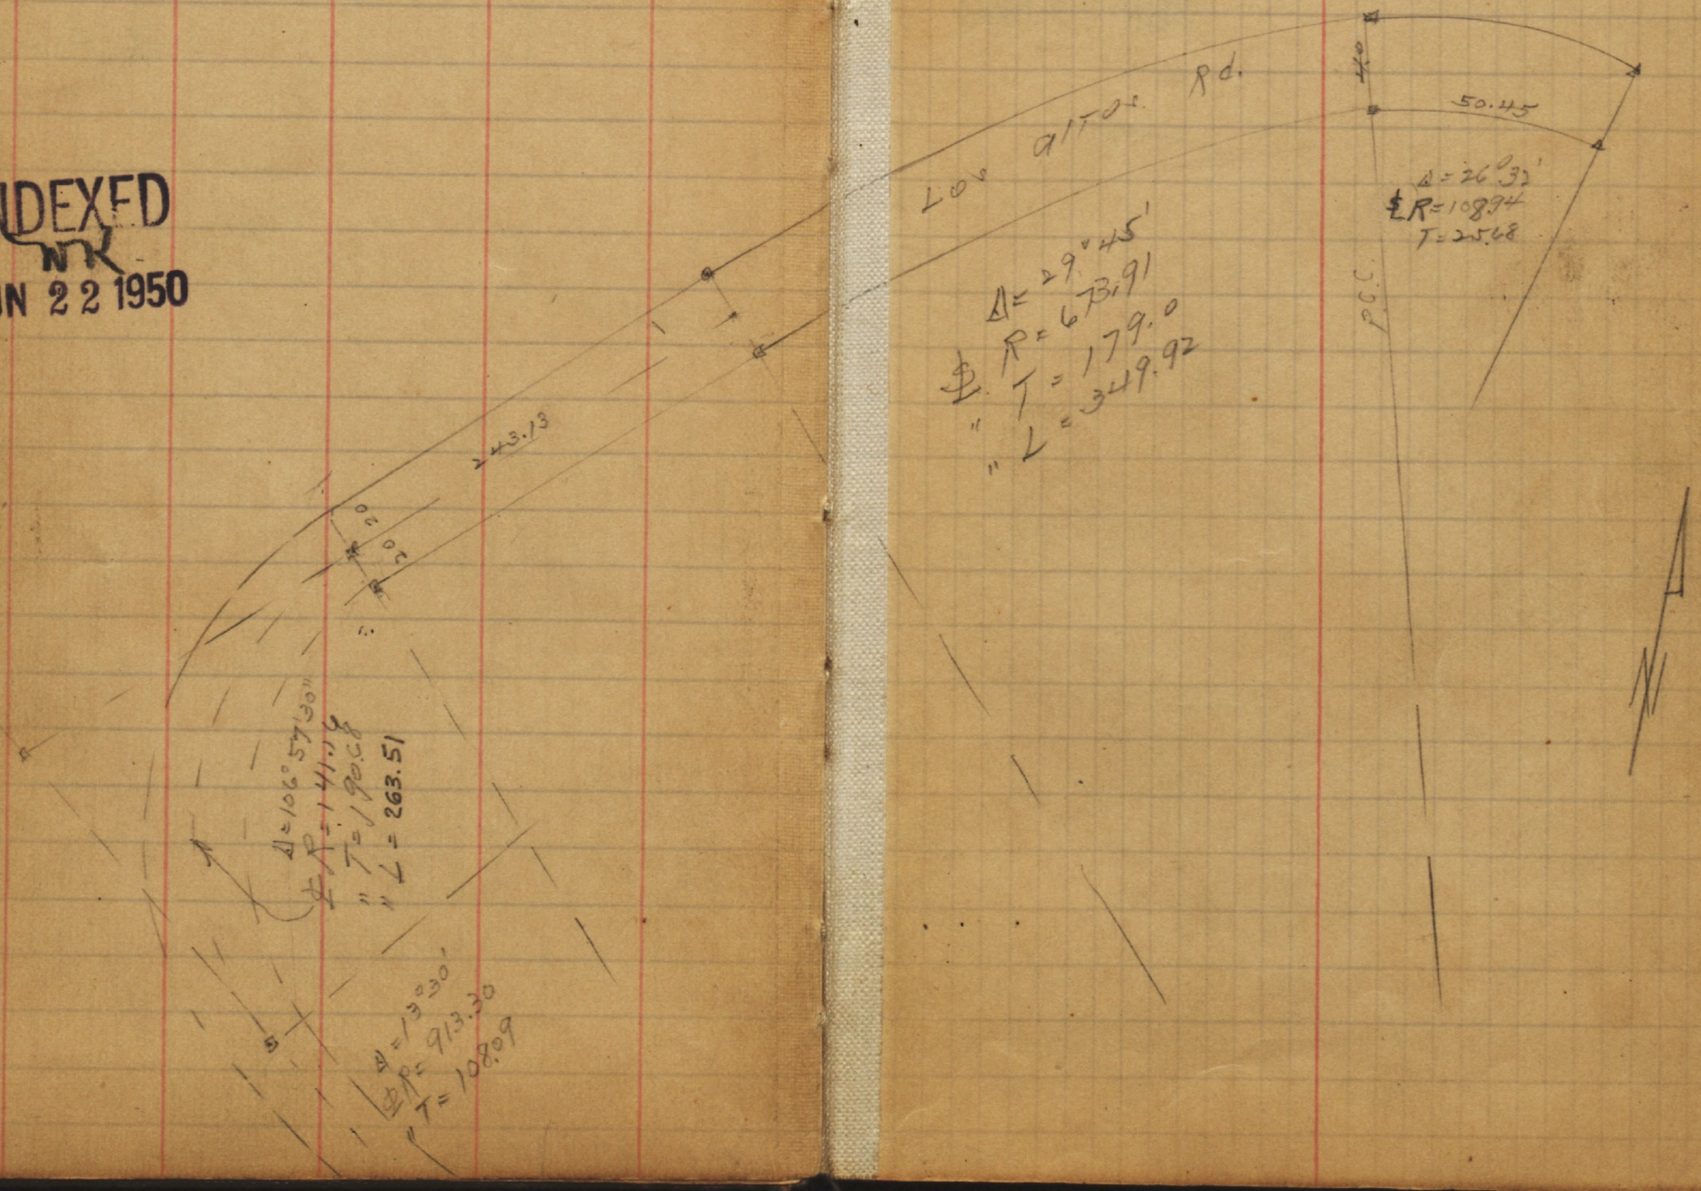

Indexed
C.S.K.

d Final

Proposed change of Alignt. on
Los Altos Road Wly of Colima St.
see Plat # 2162-B

INDEXED
JUN 22 1950

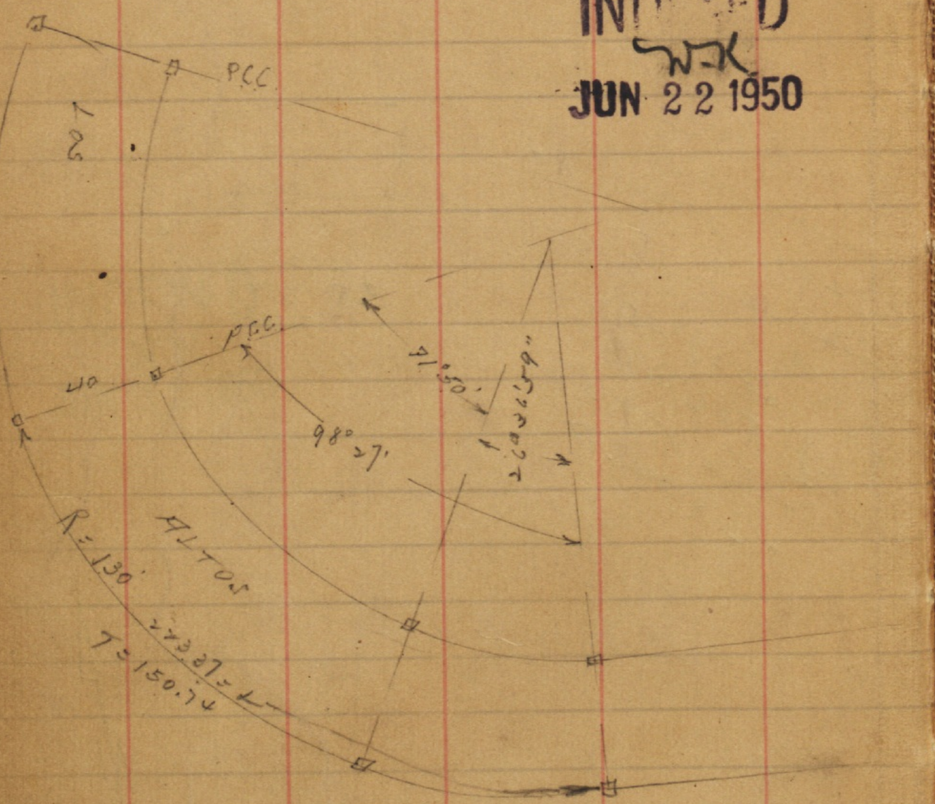

Moore
5-18-37

Set 2 xx RW Hubs
also set 4' Lath Line Stakes
for Prop. Curves

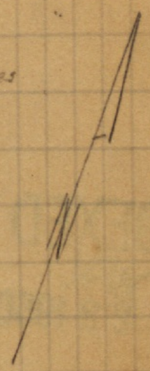

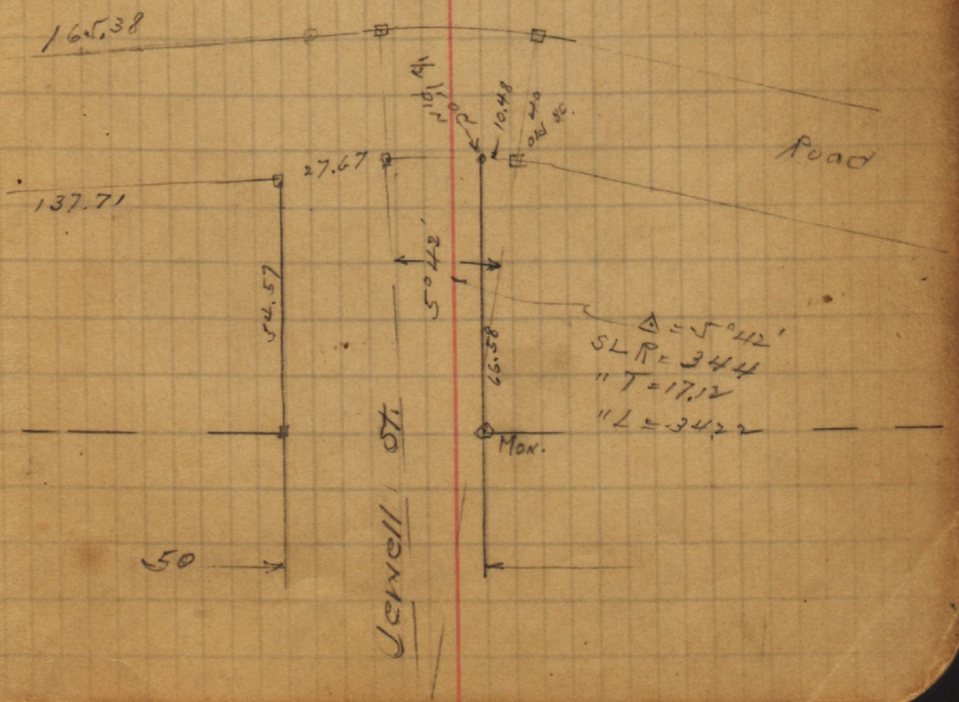

Location of 4" Water Lines in
Soledad Ter. P.L. 1785

Moore 4-11-39.
Sisson
Northern

INDEXED
JUN 22 1950

Indexed
C.S.K.

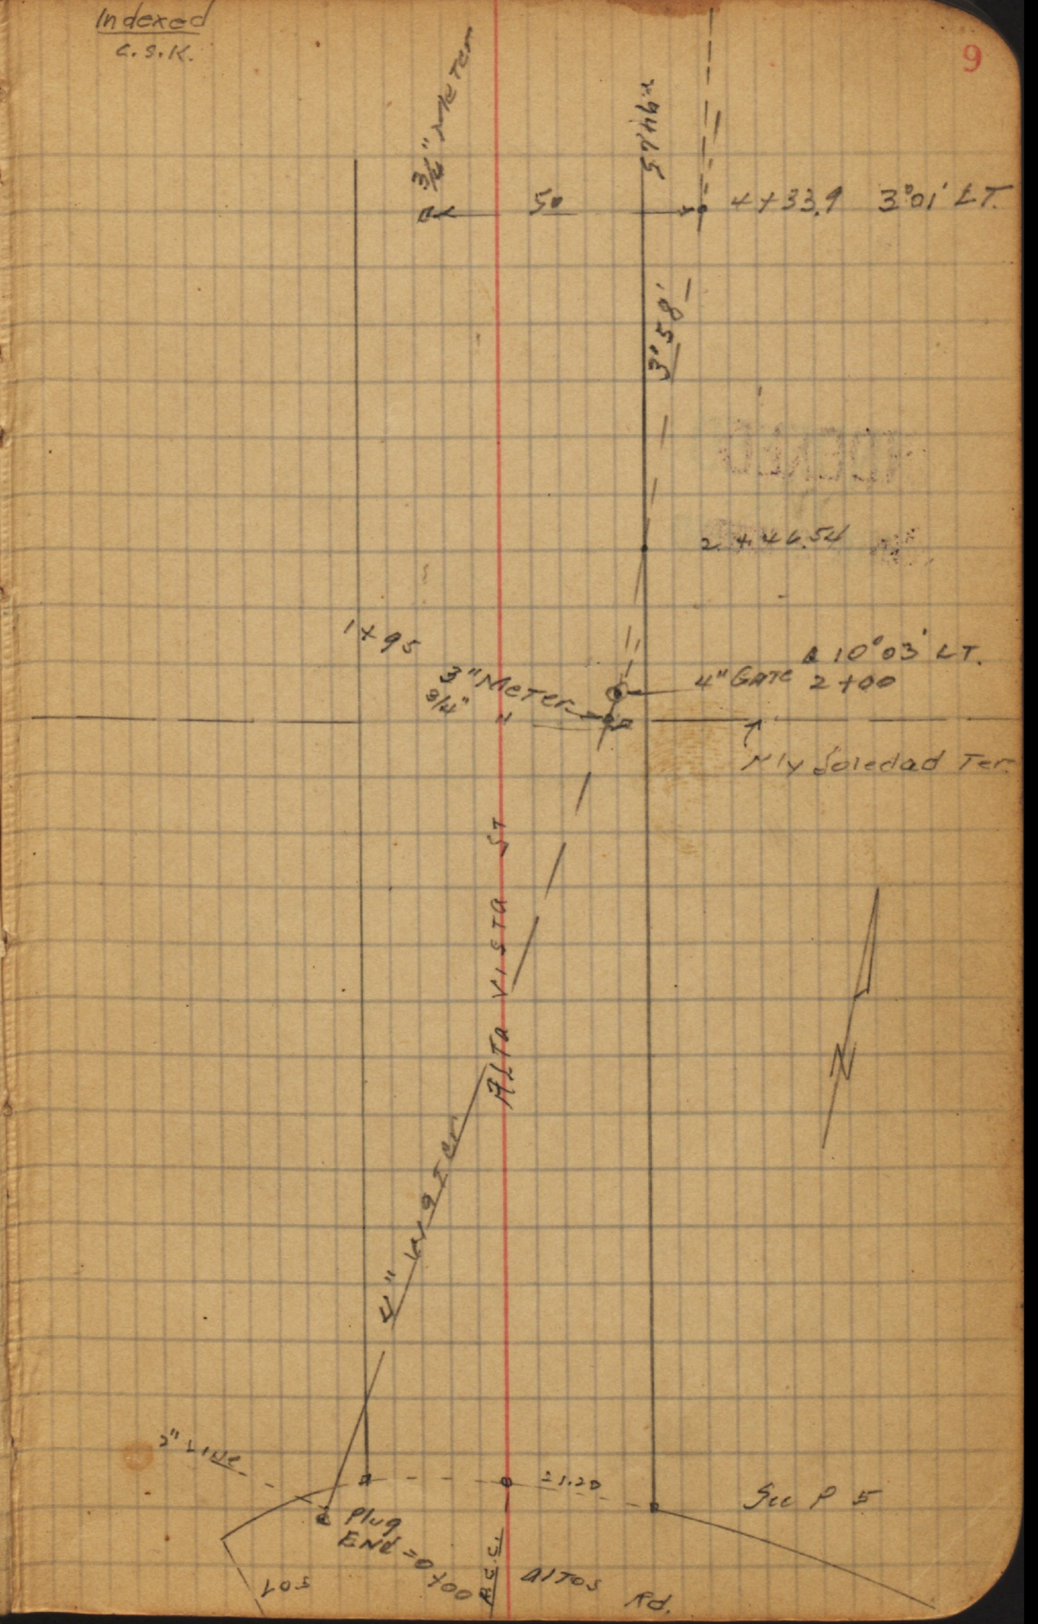

4" Water Location
Soledad Ter.

INDEXED
WR
JUN 22 1950

4" Water Location
Soledad Ter.

INDEXED
W.K.
JUN 22 1950

11"

10 + 54.8 = "Y" Junction of 4" 5°58' Lt.
10 + 53 4" Gate
10 + 08 20°41' Lt
9 + 27 11°08' Lt
7 + 00 2° 53' Rt
5 + 08 5°46' Rt
3 + 31.75 1°26' Rt
4" Pipe Line

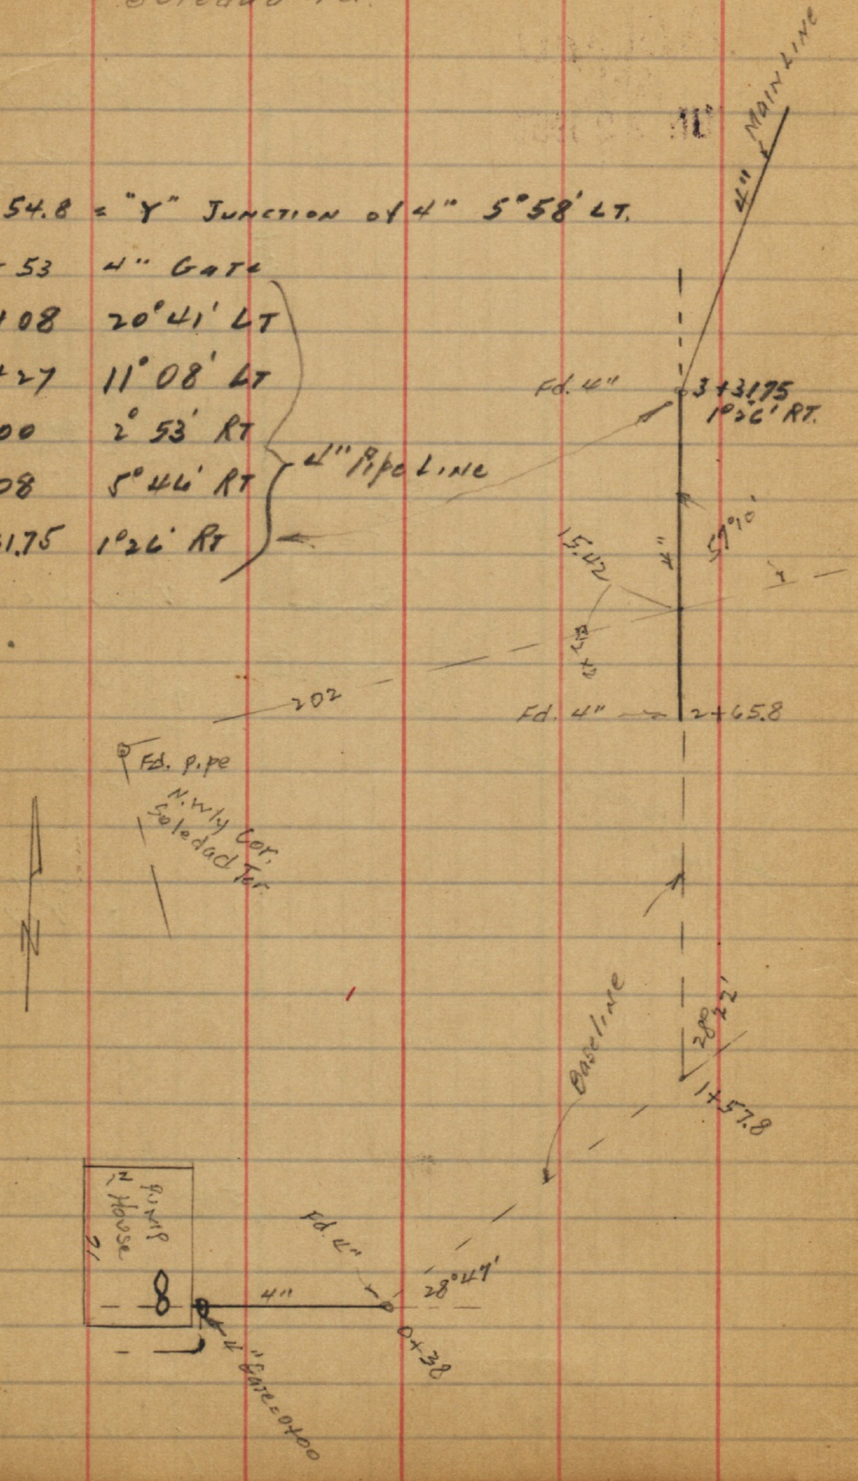

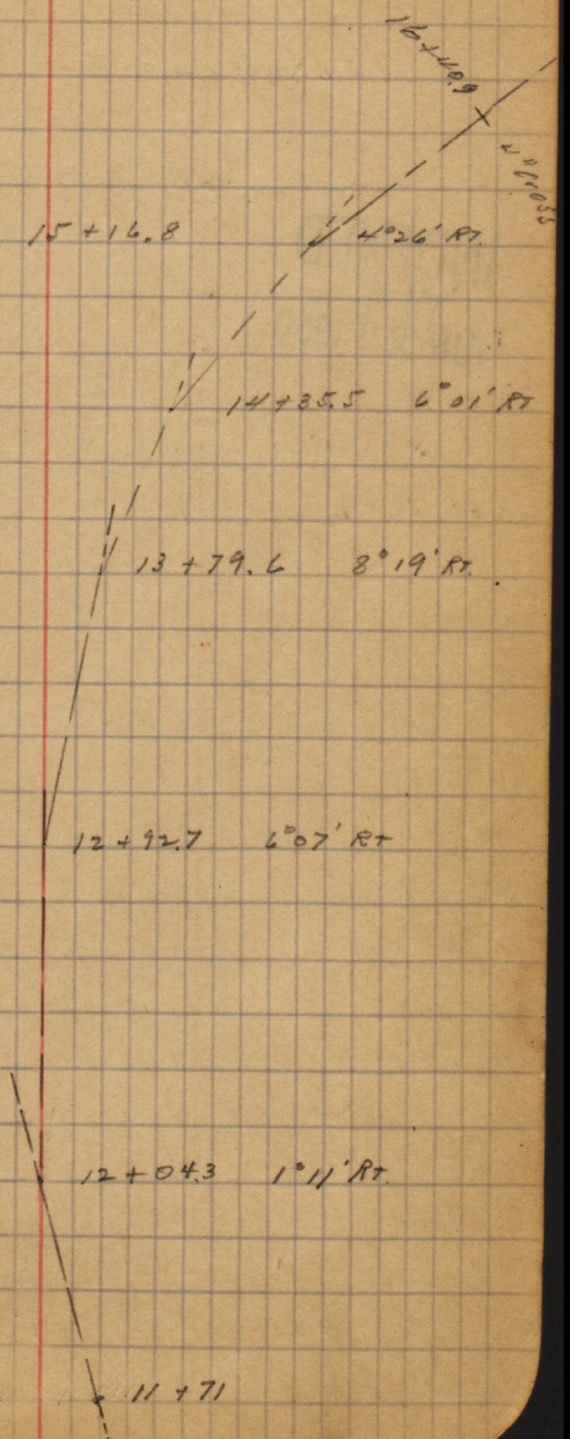

4" Water
Soledad Ter.

INDEXED
W.Y.
JUN 22 1950

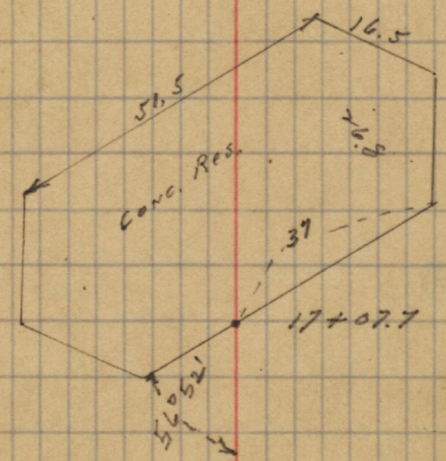

16+82.5 4" Gate

16+72.5 Clean out

16+40.9 4" cross

Proposed Opening of
Tuna Lake

See P 243

INDEXED
W.K
JUN 22 1950

Moore
1-23-40.

INDEXED
E.F.B.

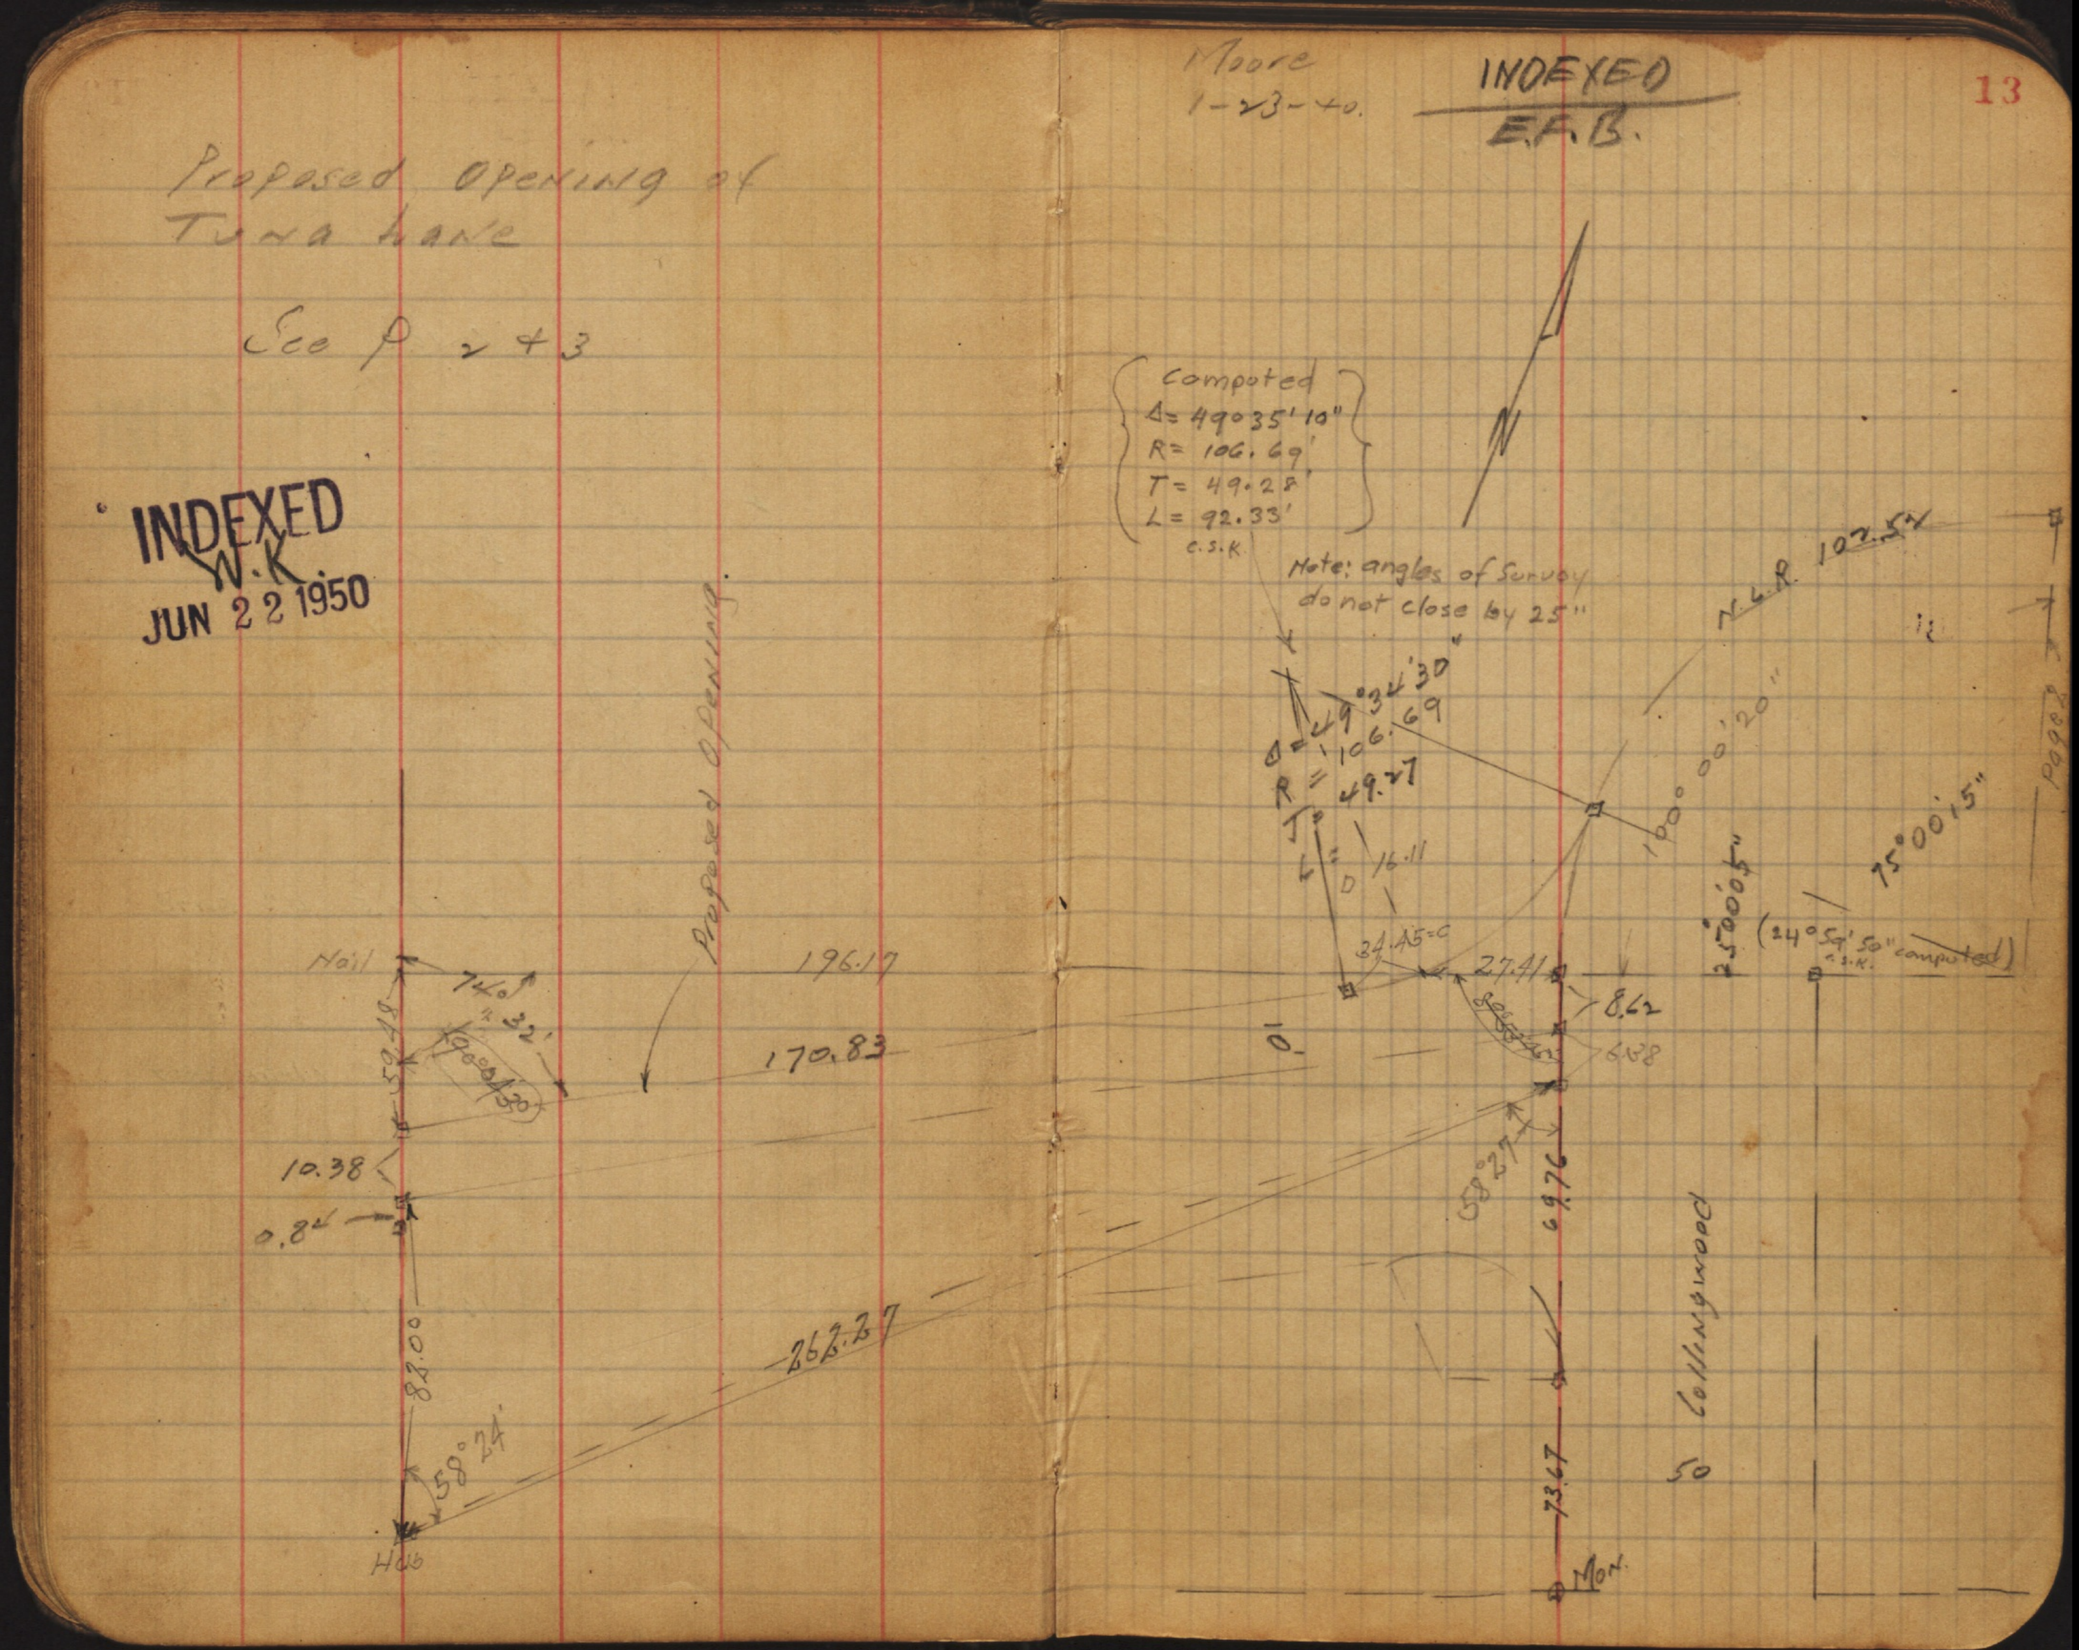

Location & Ties W'ly. line Easement
of Road To Reservoir
In Pueblo Lot #1779 - Pacific Beach

W.O. 20006

Walker
Pope
Huffman
Kellio
10-2-51

INDEXED
Law
OCT 3 1951

INDEXED
Law
OCT 3 1951

Ties - Road to Reservoir in PL 1779 - Pacific Beach and Portion of Soledad Road

Walker
Pope
Hoffmann
10-29-51

● = Set 3/4" x 18" Galv. Iron Pipe Filled With Lead. Cap. Disc.

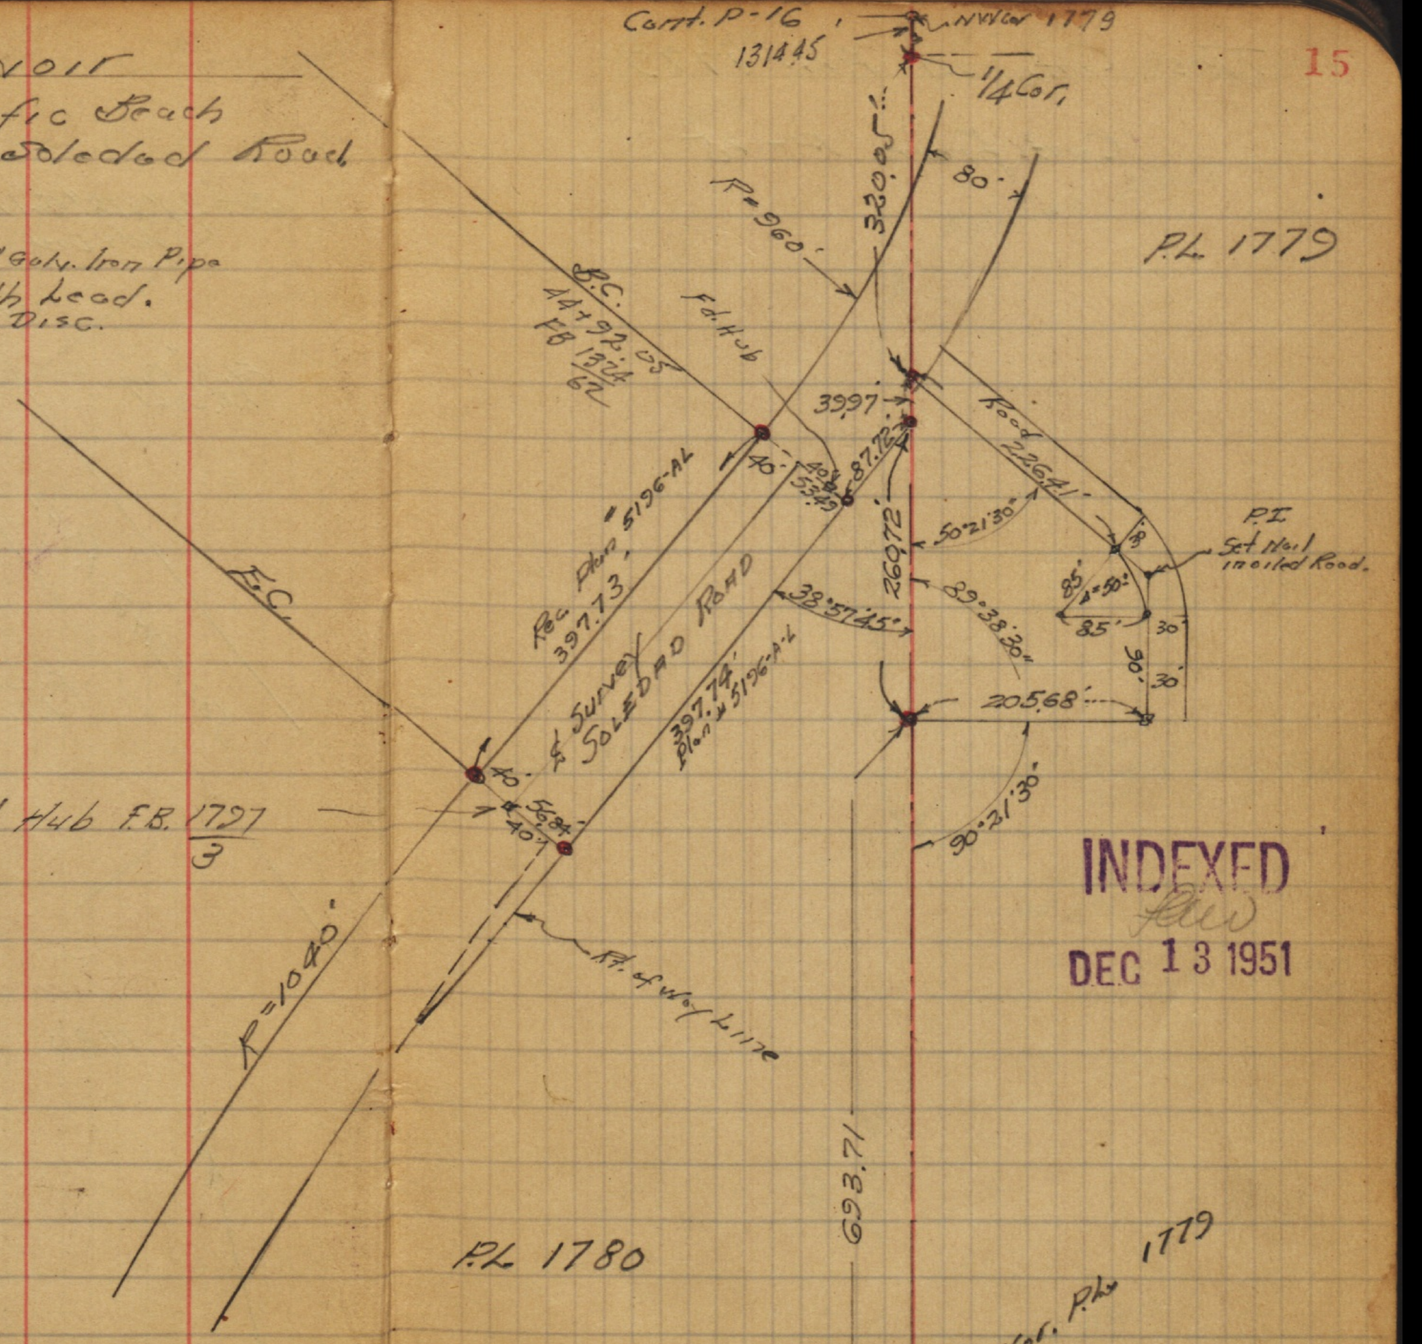

Ties Cont. in P.L. 1779

Cont. from P-15

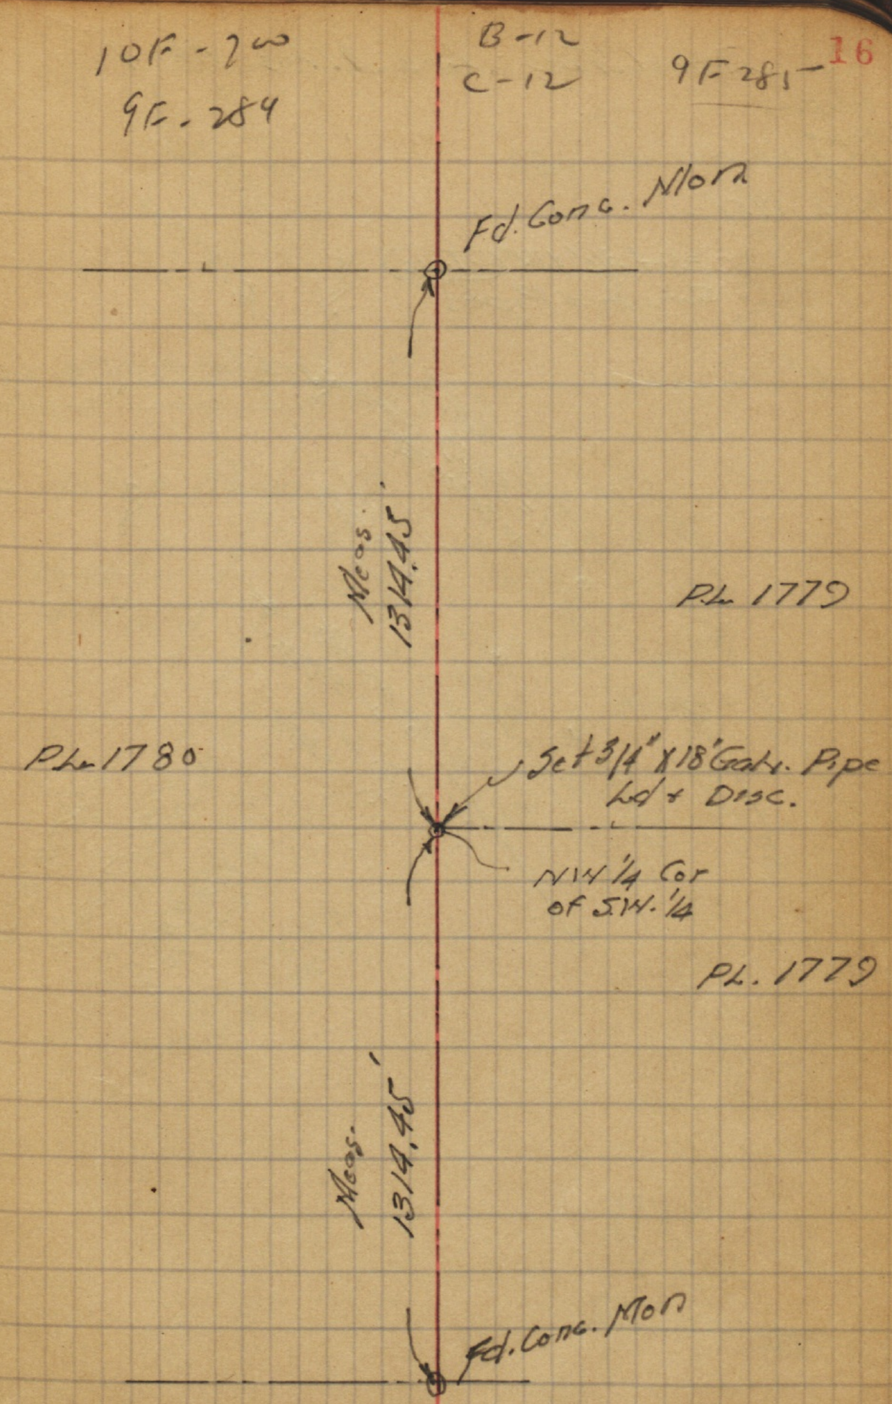

Detail Ties - Los Altos Road

Walker
Pope
Huffman
Nov. 1951

○ = Set 3/4" X 18" (or Less) Galv. Iron Pipes

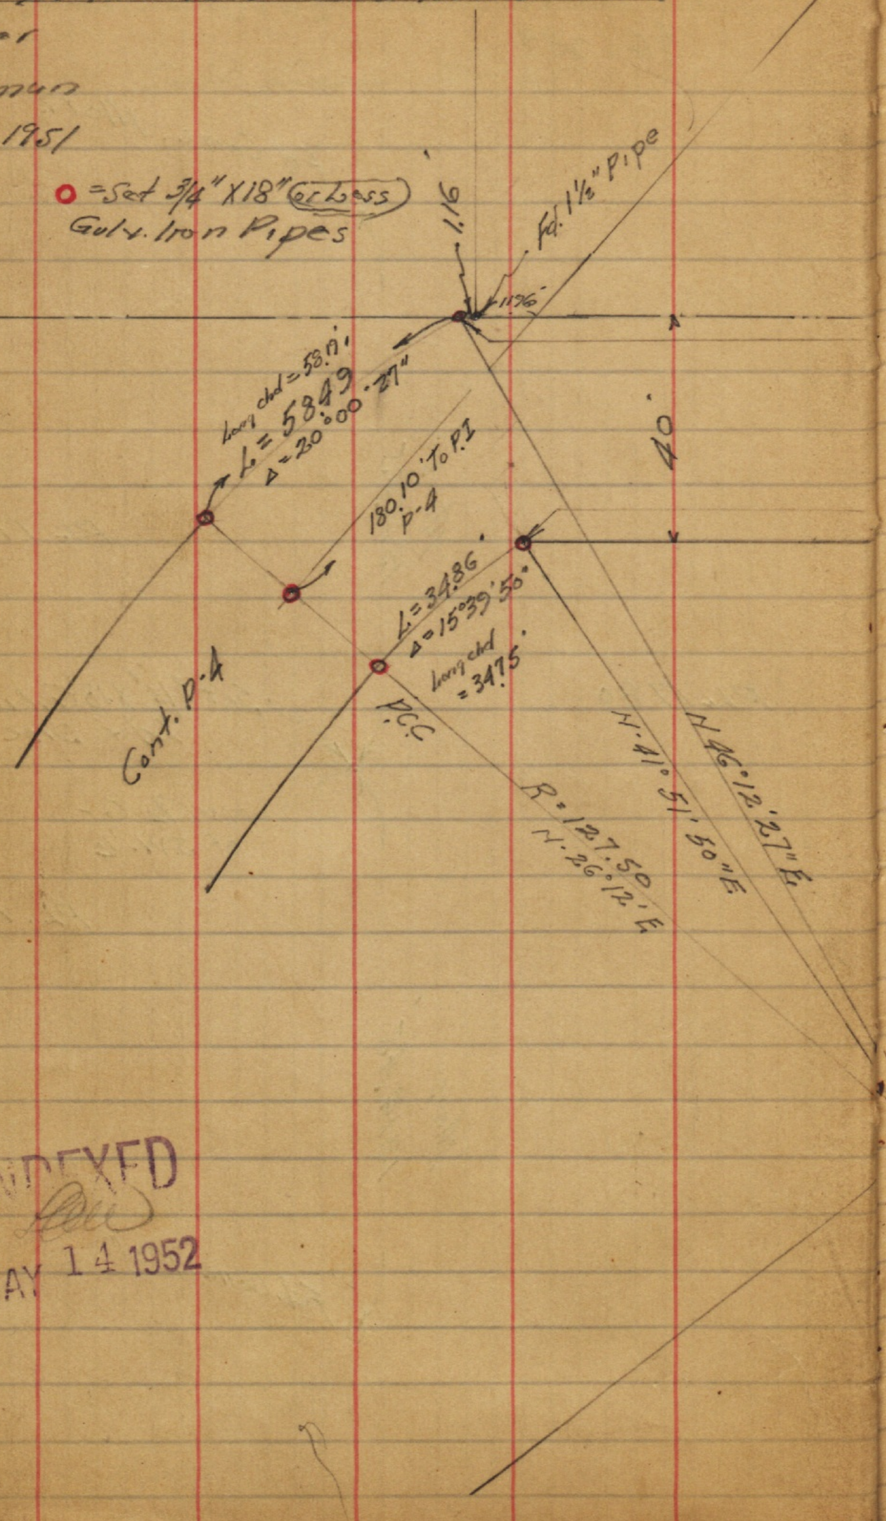

INDEXED
Los
MAY 14 1952

INDEXED
Road
May 14 1952

17

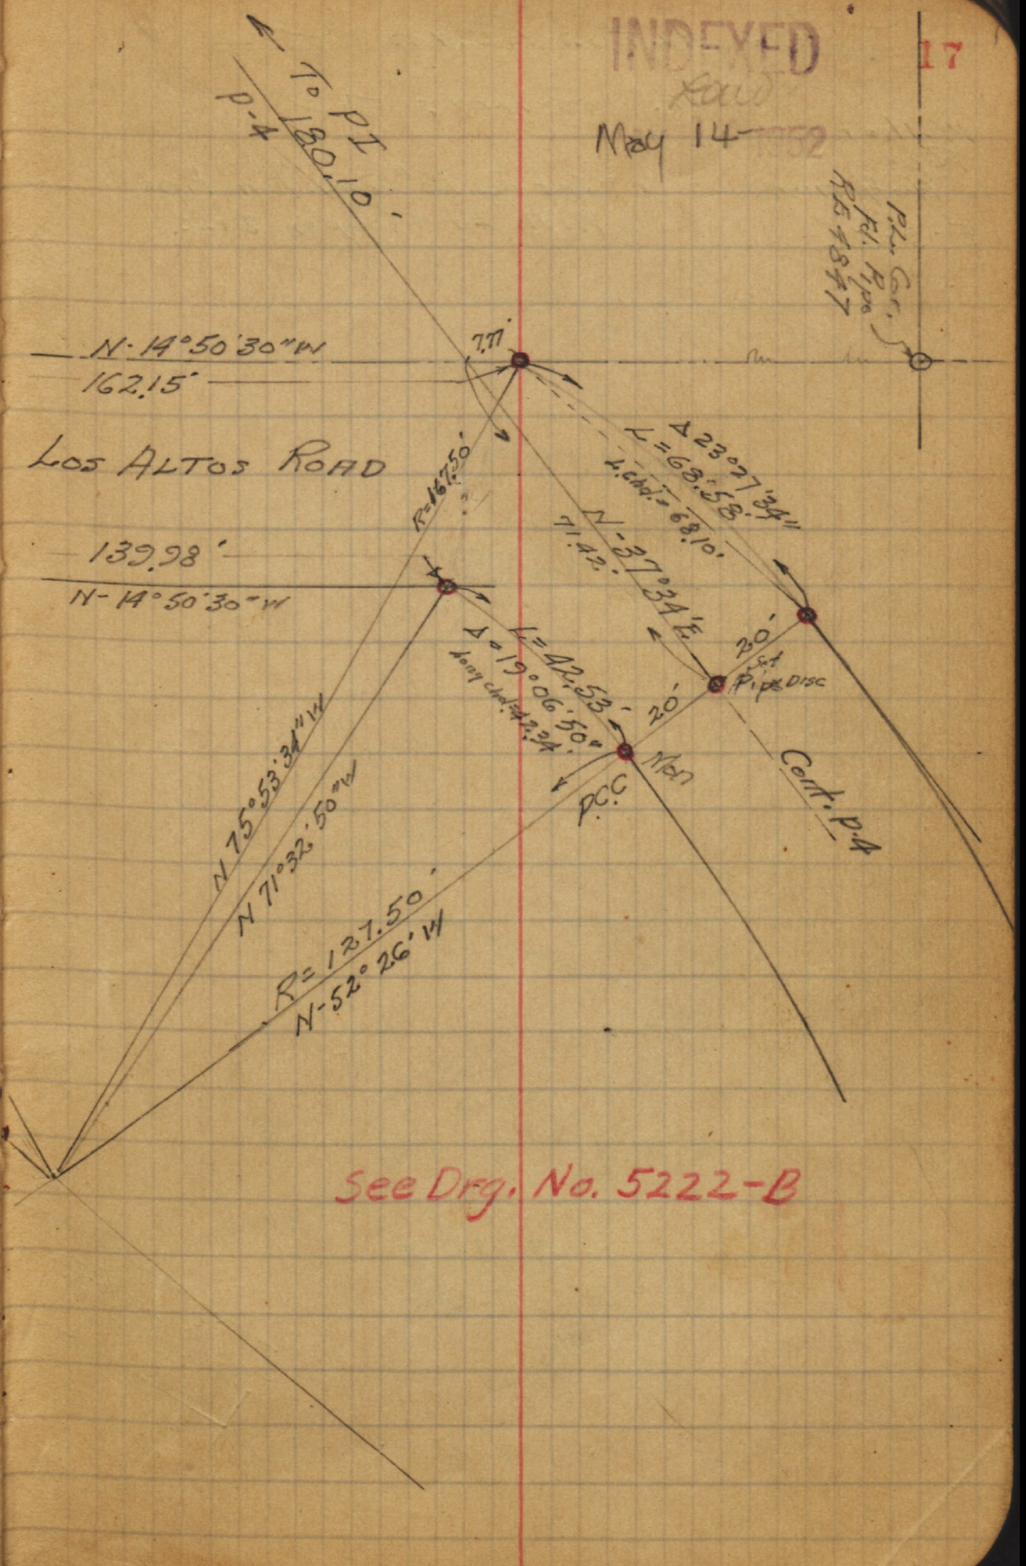

See Drg. No. 5222-B

Los Altos Road

Tie Points

Walker
Popo
Huffman
5-9-52

● = Set 3/4" x 18" Galv. Iron Pipe
With Ld & Copper Disc.

INDEXED
law
MAY 14 1952

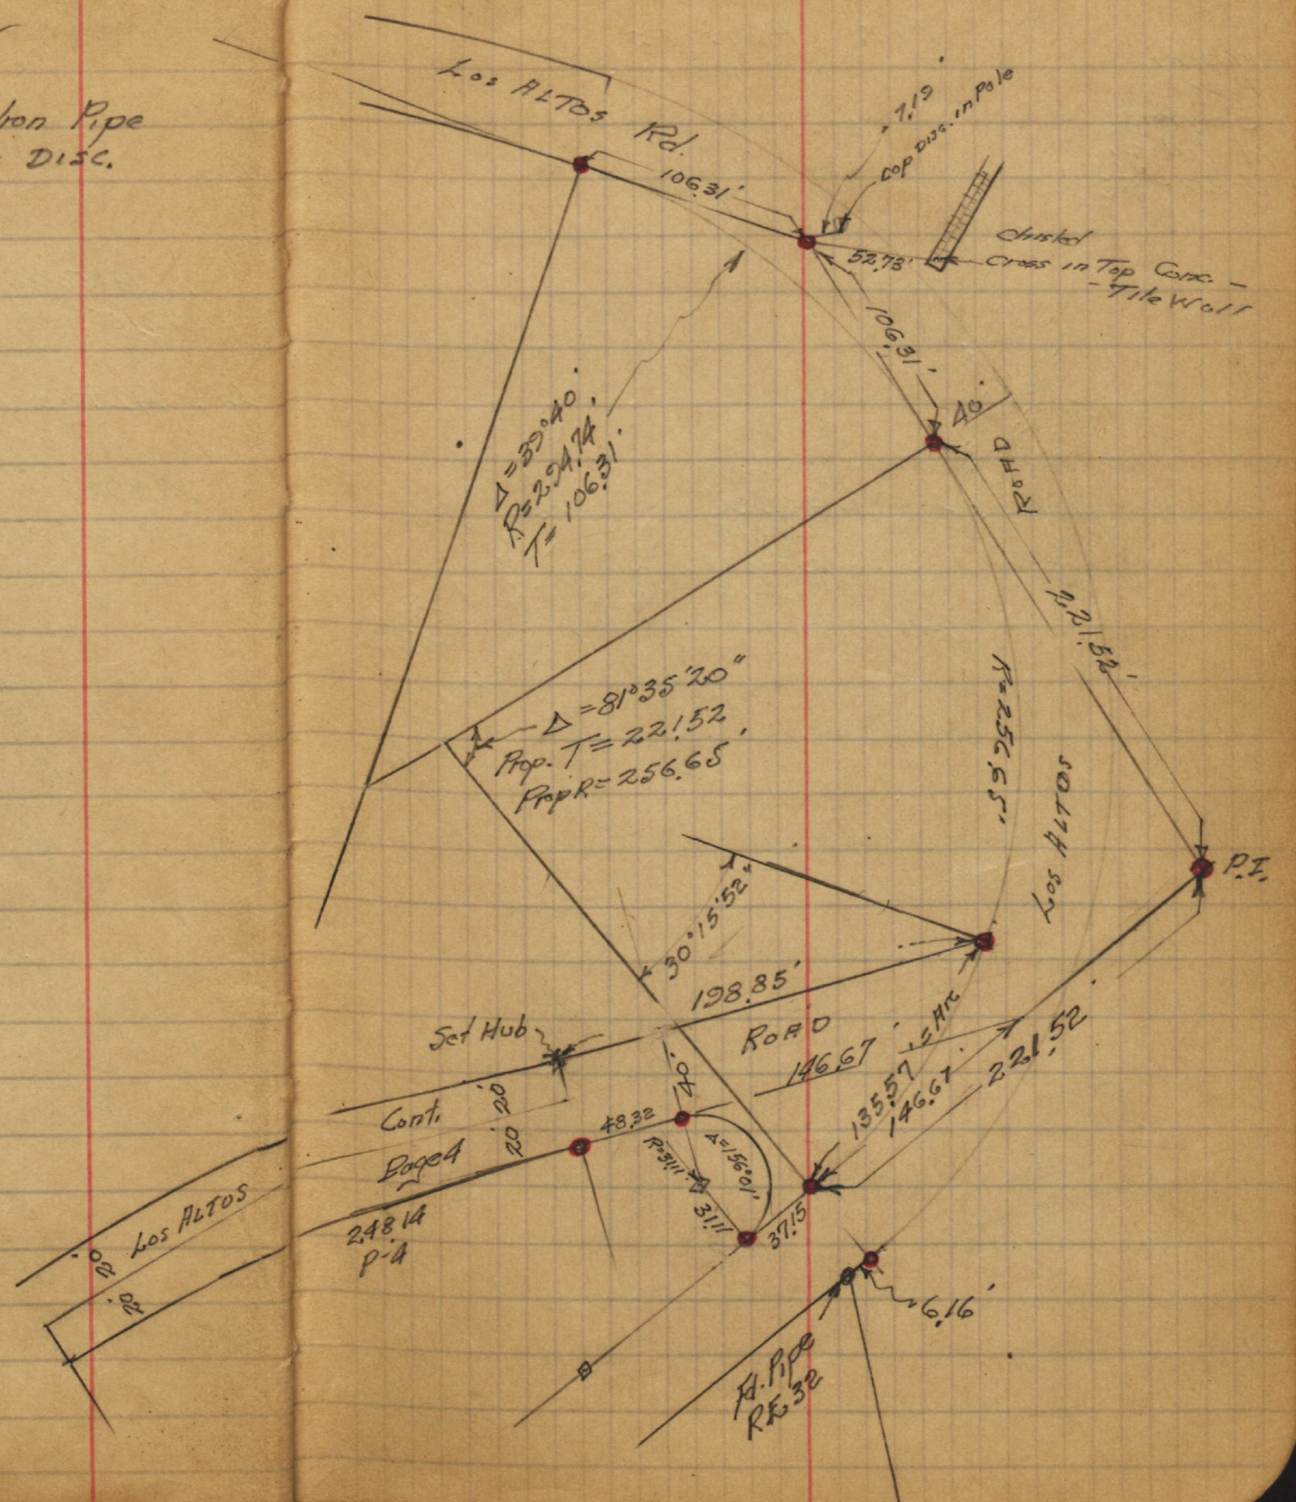

SOLEDAD TERRACE MAP #1618

~ TIE POINTS ~

Walker
Popo
Brayton
Matalog.
4-22-53

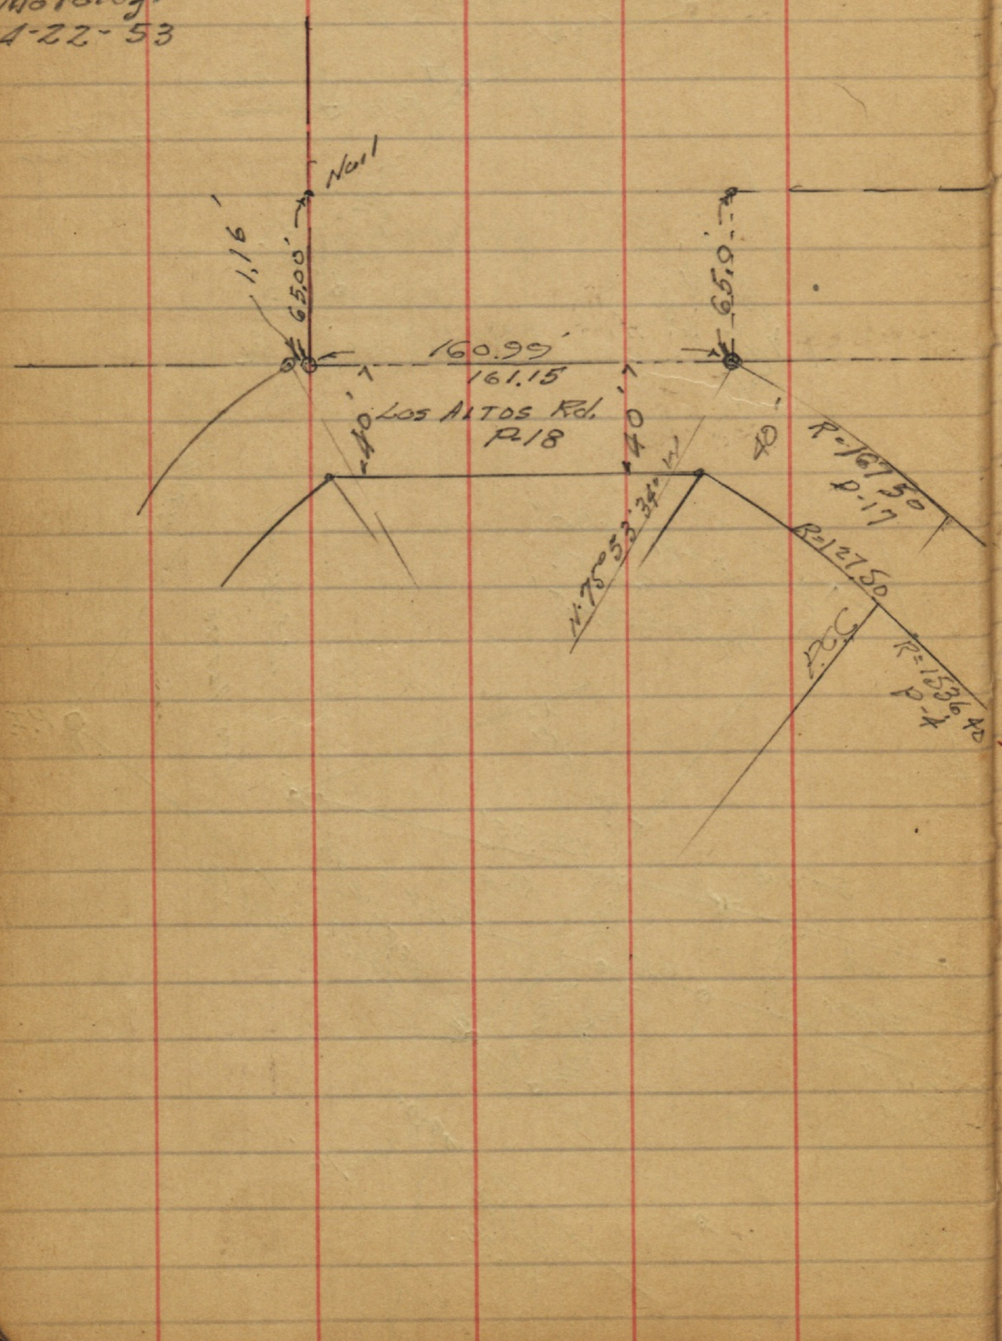

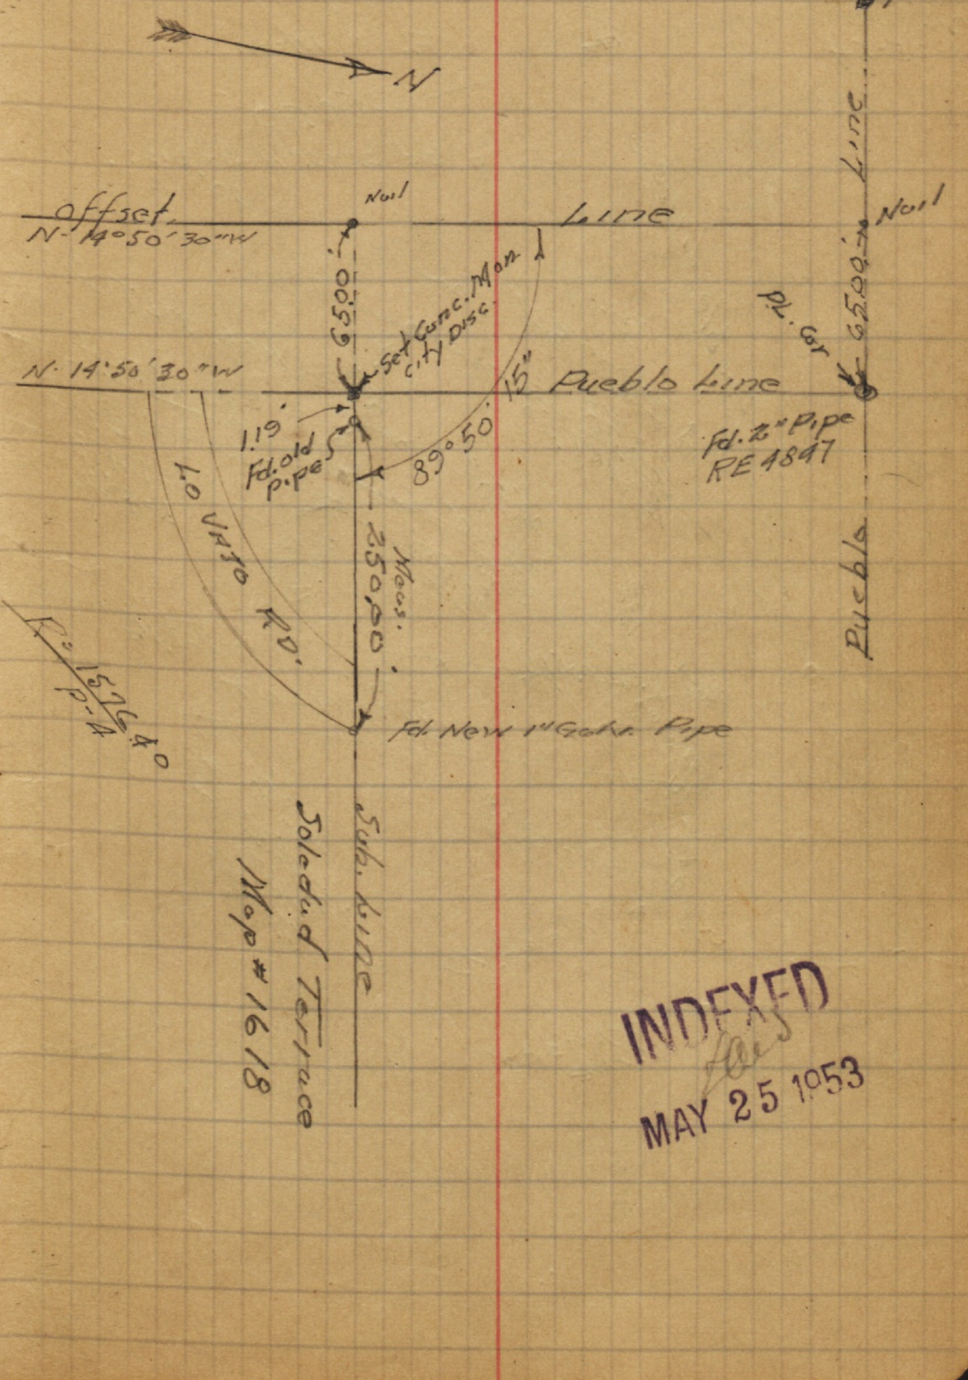

INDEXED
MAY 25 1053

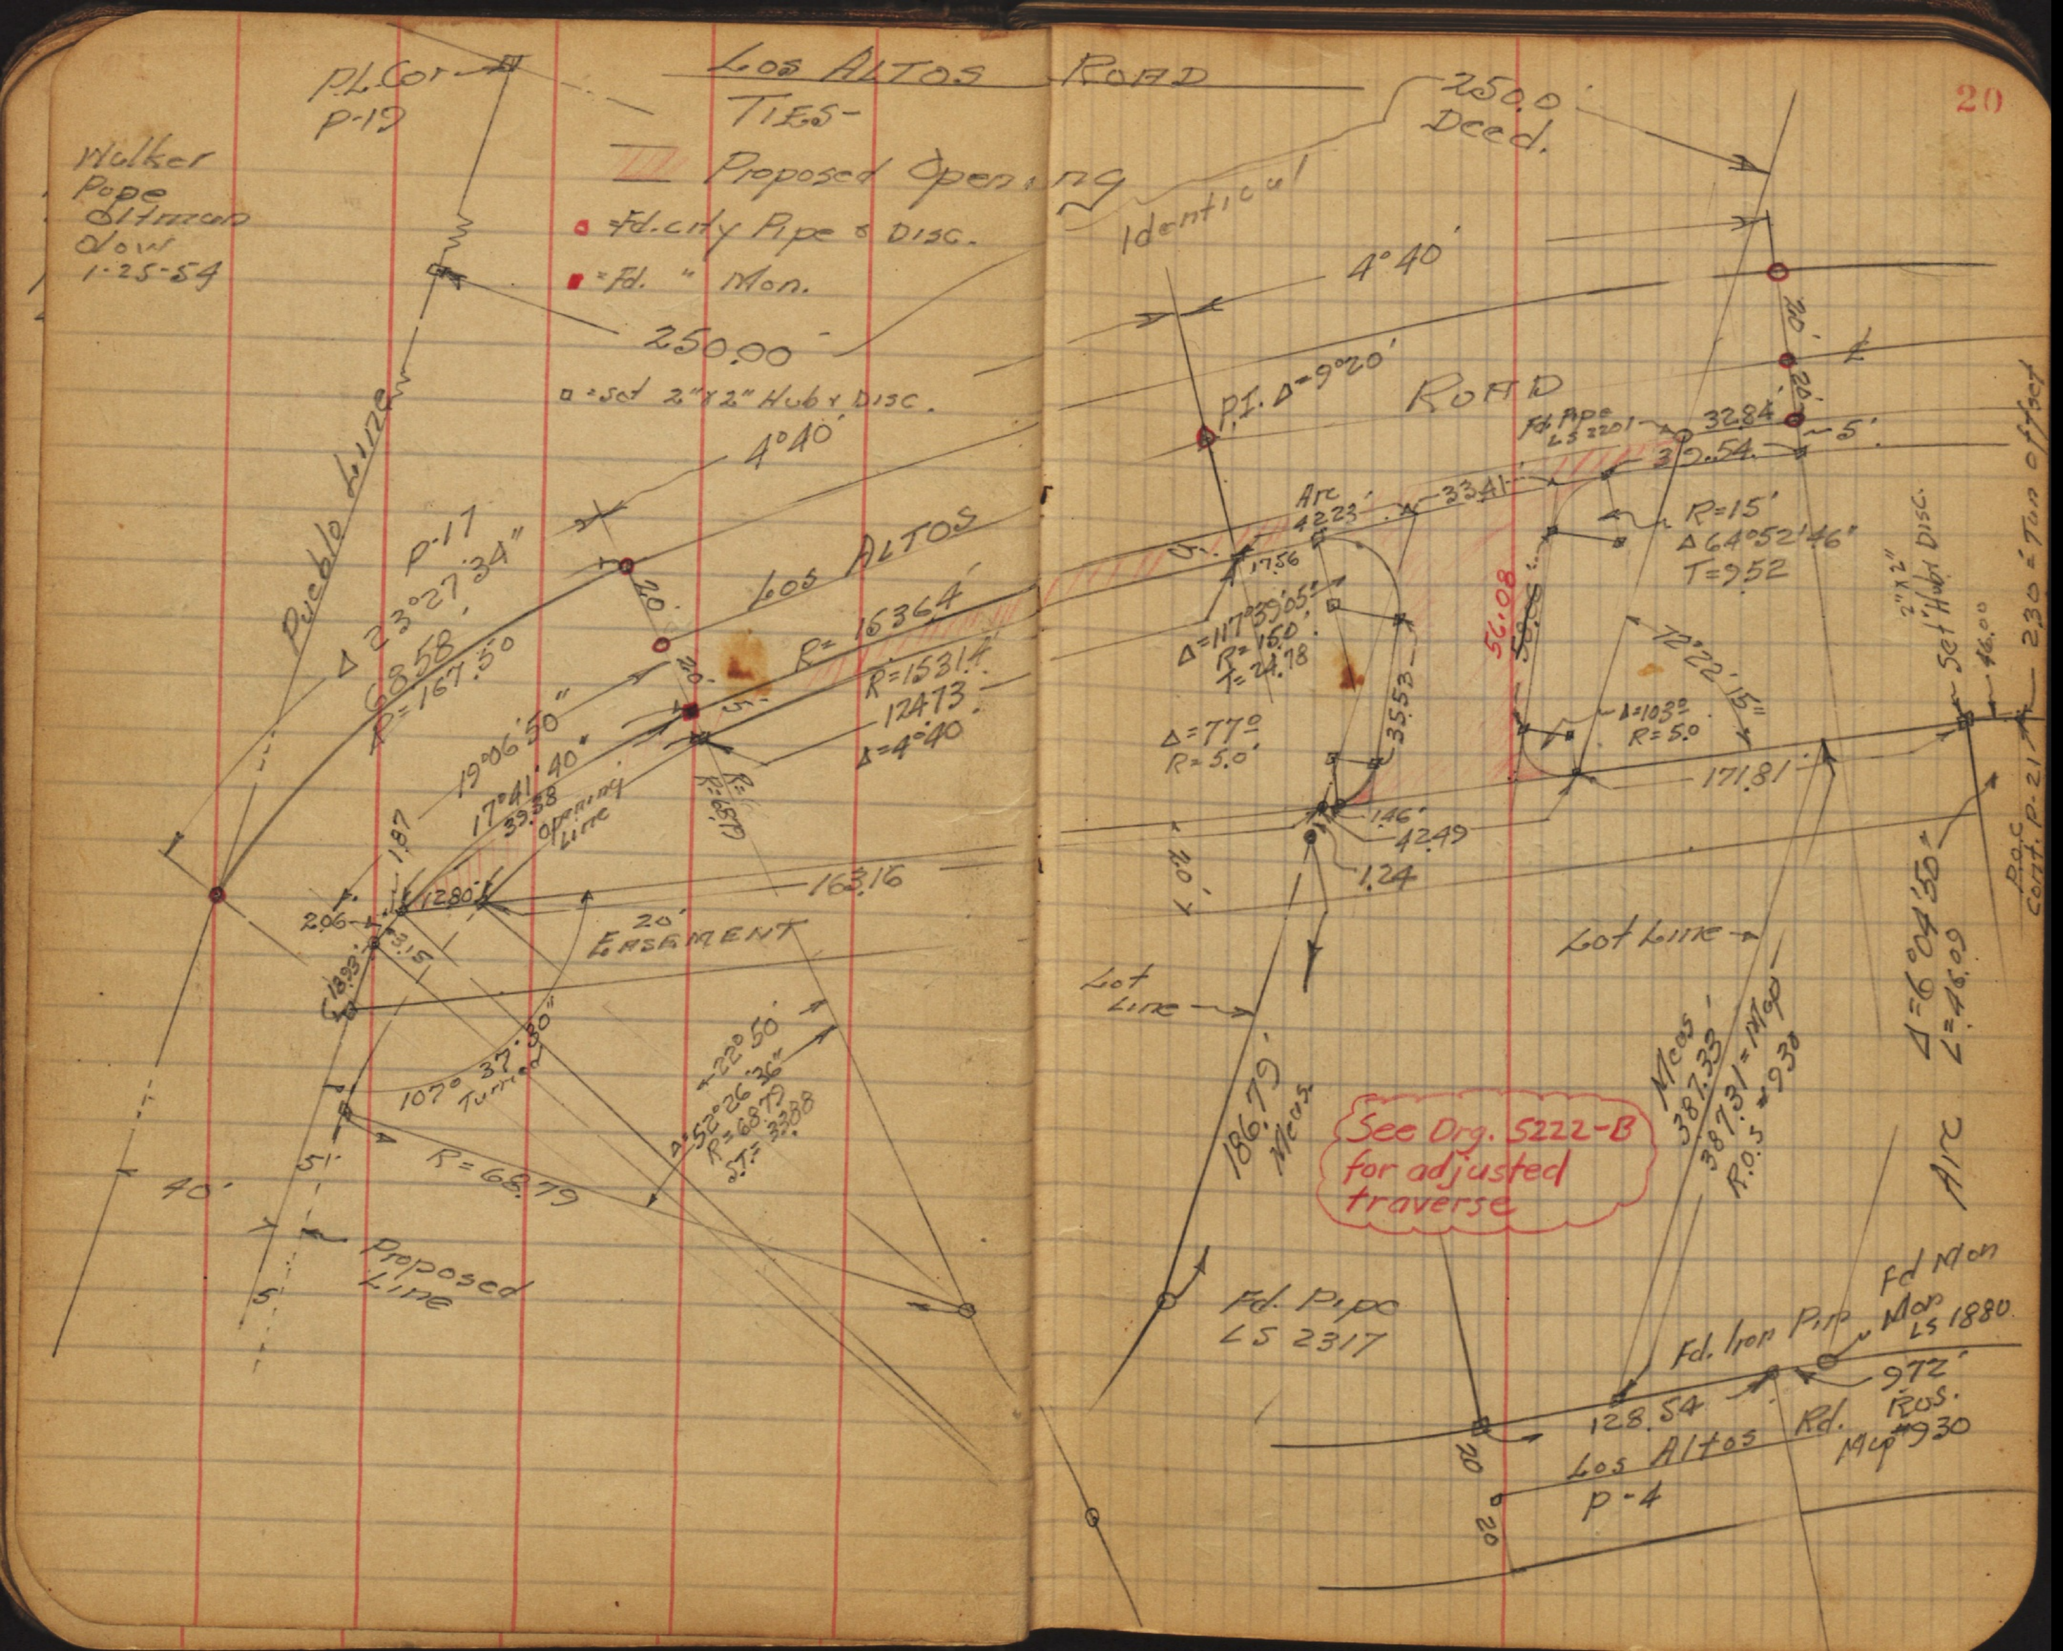
LOS ALTOS ROAD
TIES-
Proposed Opening
Fd. city Pipe & Disc.
Fd. " Mon.
Set 2"x2" Hub & Disc.
Walker Pope Oltman Dow 1-25-54
P.L. Cor P-19
250.00'
4°40'
Pueblo Line
P-17
Δ 23°27'34"
68.58
R=167.50
Los Altos
R=16364
R=15314
12473
Δ=4°40'
19°06'50"
17°41'40"
39.58
Opening Line
163.16
20' EASEMENT
107°37'30" Turned
R=68.79
40'
Proposed Line
Identical
250.0' Deed.
4°40'
P.I. Δ=9°20'
ROAD
Fd. Pipe LS 2201
32.84
39.54
5'
Arc 42.23'
33.41
R=15'
Δ 64°52'46"
T=9.52
Δ=117°39'05"
R=15.0
T=24.78
Δ=77°
R=5.0
35.53
56.08
72°22'15"
Δ=103°
R=5.0
171.81
42.49
1.24
Set 2"x2" Hub & Disc.
46.00
230' Tan offset
P.O.C. Cont. P-21
Lot Line
Lot Line
186.79' Meas.
Meas. 387.33
387.31 = Map
R.O.S. #930
Δ=6°04'50"
L=46.09
Arc
See Drg. 5222-B for adjusted traverse
Fd. Pipe LS 2317
Fd. Iron Pipe
Fd Mon
Mon LS 1880
128.54
972'
Los Altos Rd.
R.O.S. Map #930
P-4

Los Altos Rd - Tics To Easement

Walker Pope Othman Olow 1-27-54

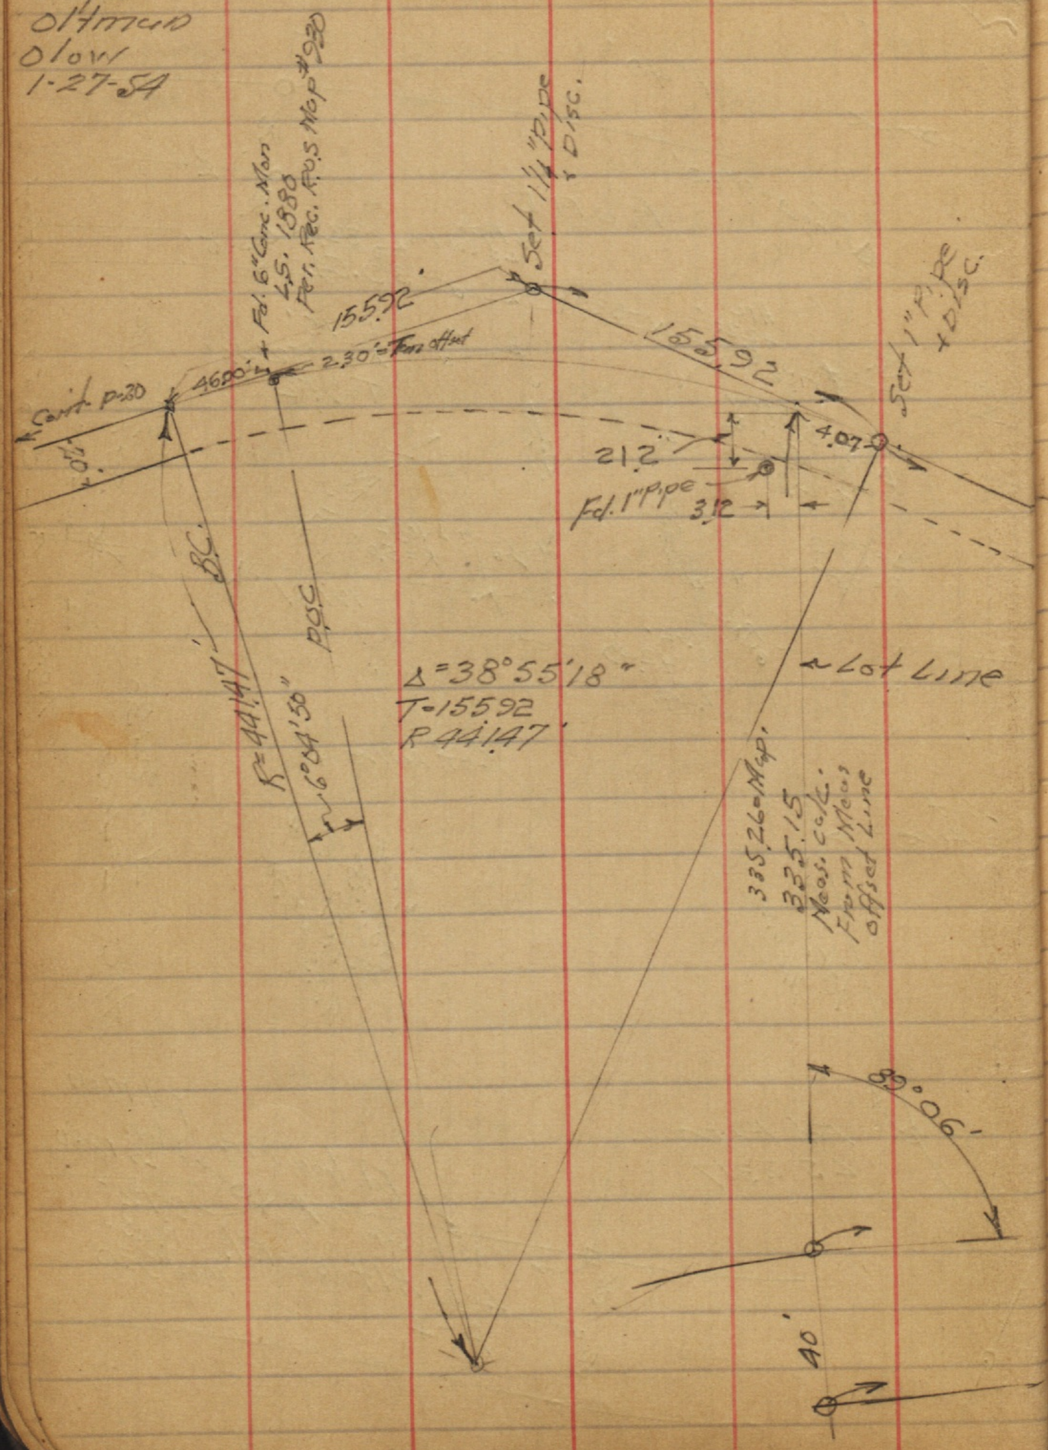

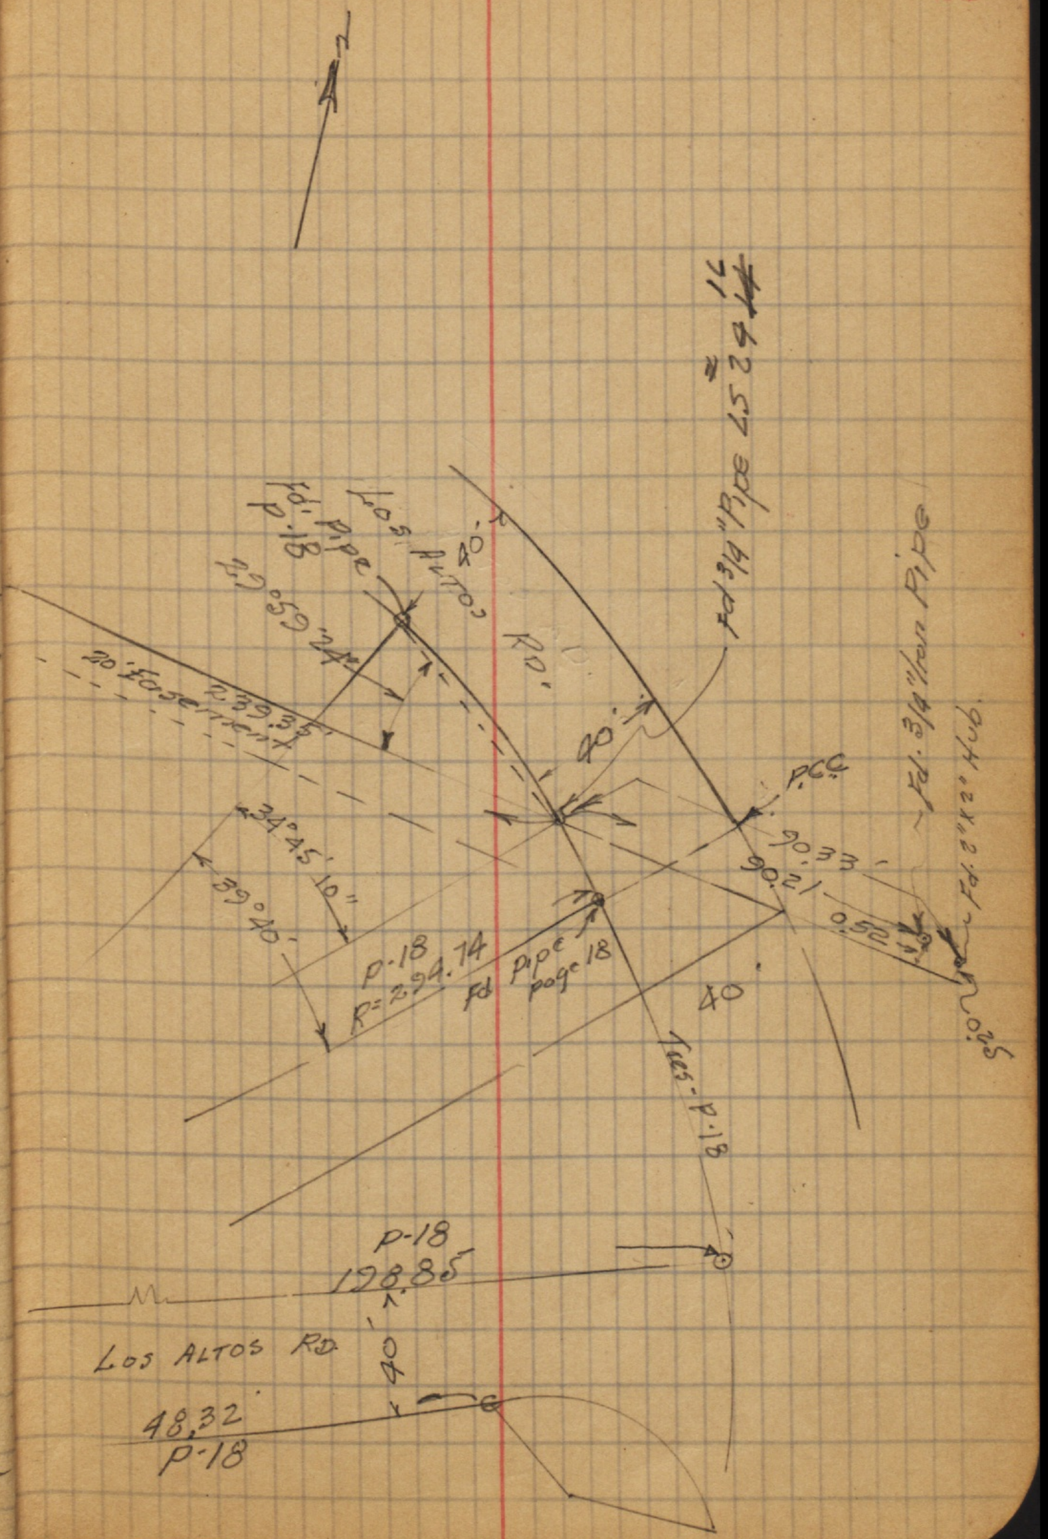

Tie Pts. for Street Openings on the N.W. & S.E. Cor's. of Moorland Dr. and the Riviera or Frontera St.

C.S. Moore
Surveyor
W. Moore
9-7-45.

• = Id. Cor. Tks.

INDEXED
JUN 22 1950

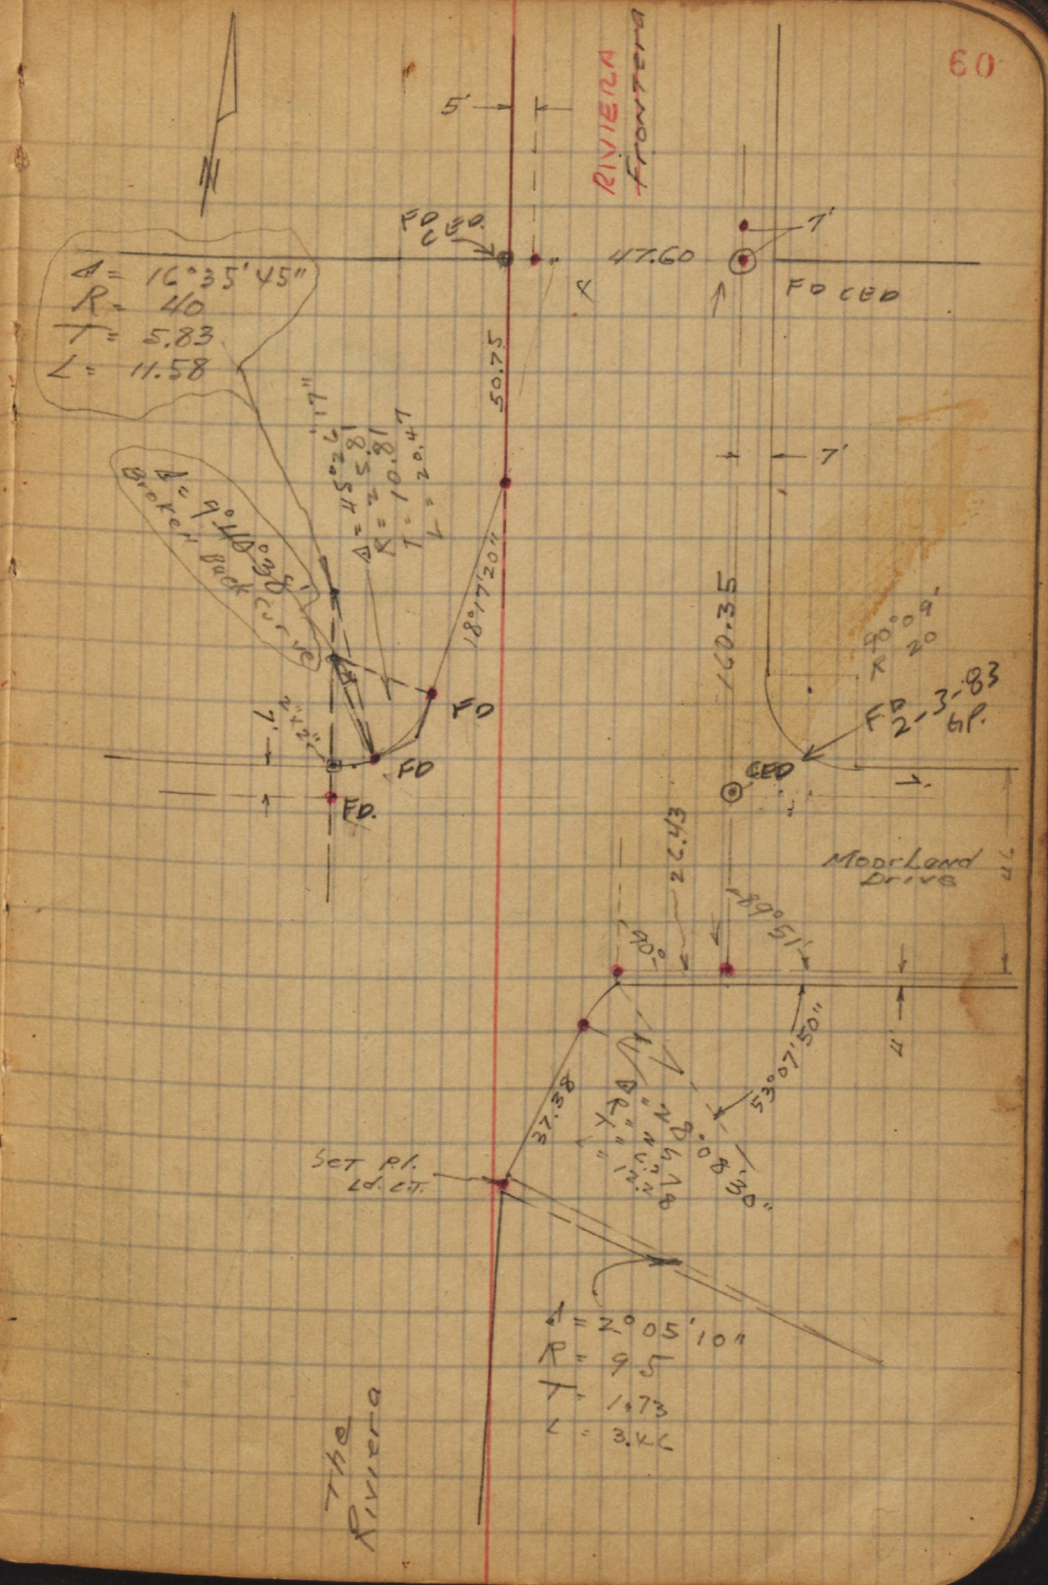

Survey of Lots 469 and 470
Crown Point
According to Curbs Constructed

C. Moore
[illegible]
W.F.M.
3-14-45

Indexed
C.S.K.

INDEXED
W.K.
JUN 22 1950

Crown Point

MM 10-22-45

March 1941

Sisson
Northern
Moore

• = Copper Disc + Lead

+ = Chisel Cross

⊕ = RR Spike

▪ = Ld. C.T.

INDEXED
W.K.
JUN 22 1950

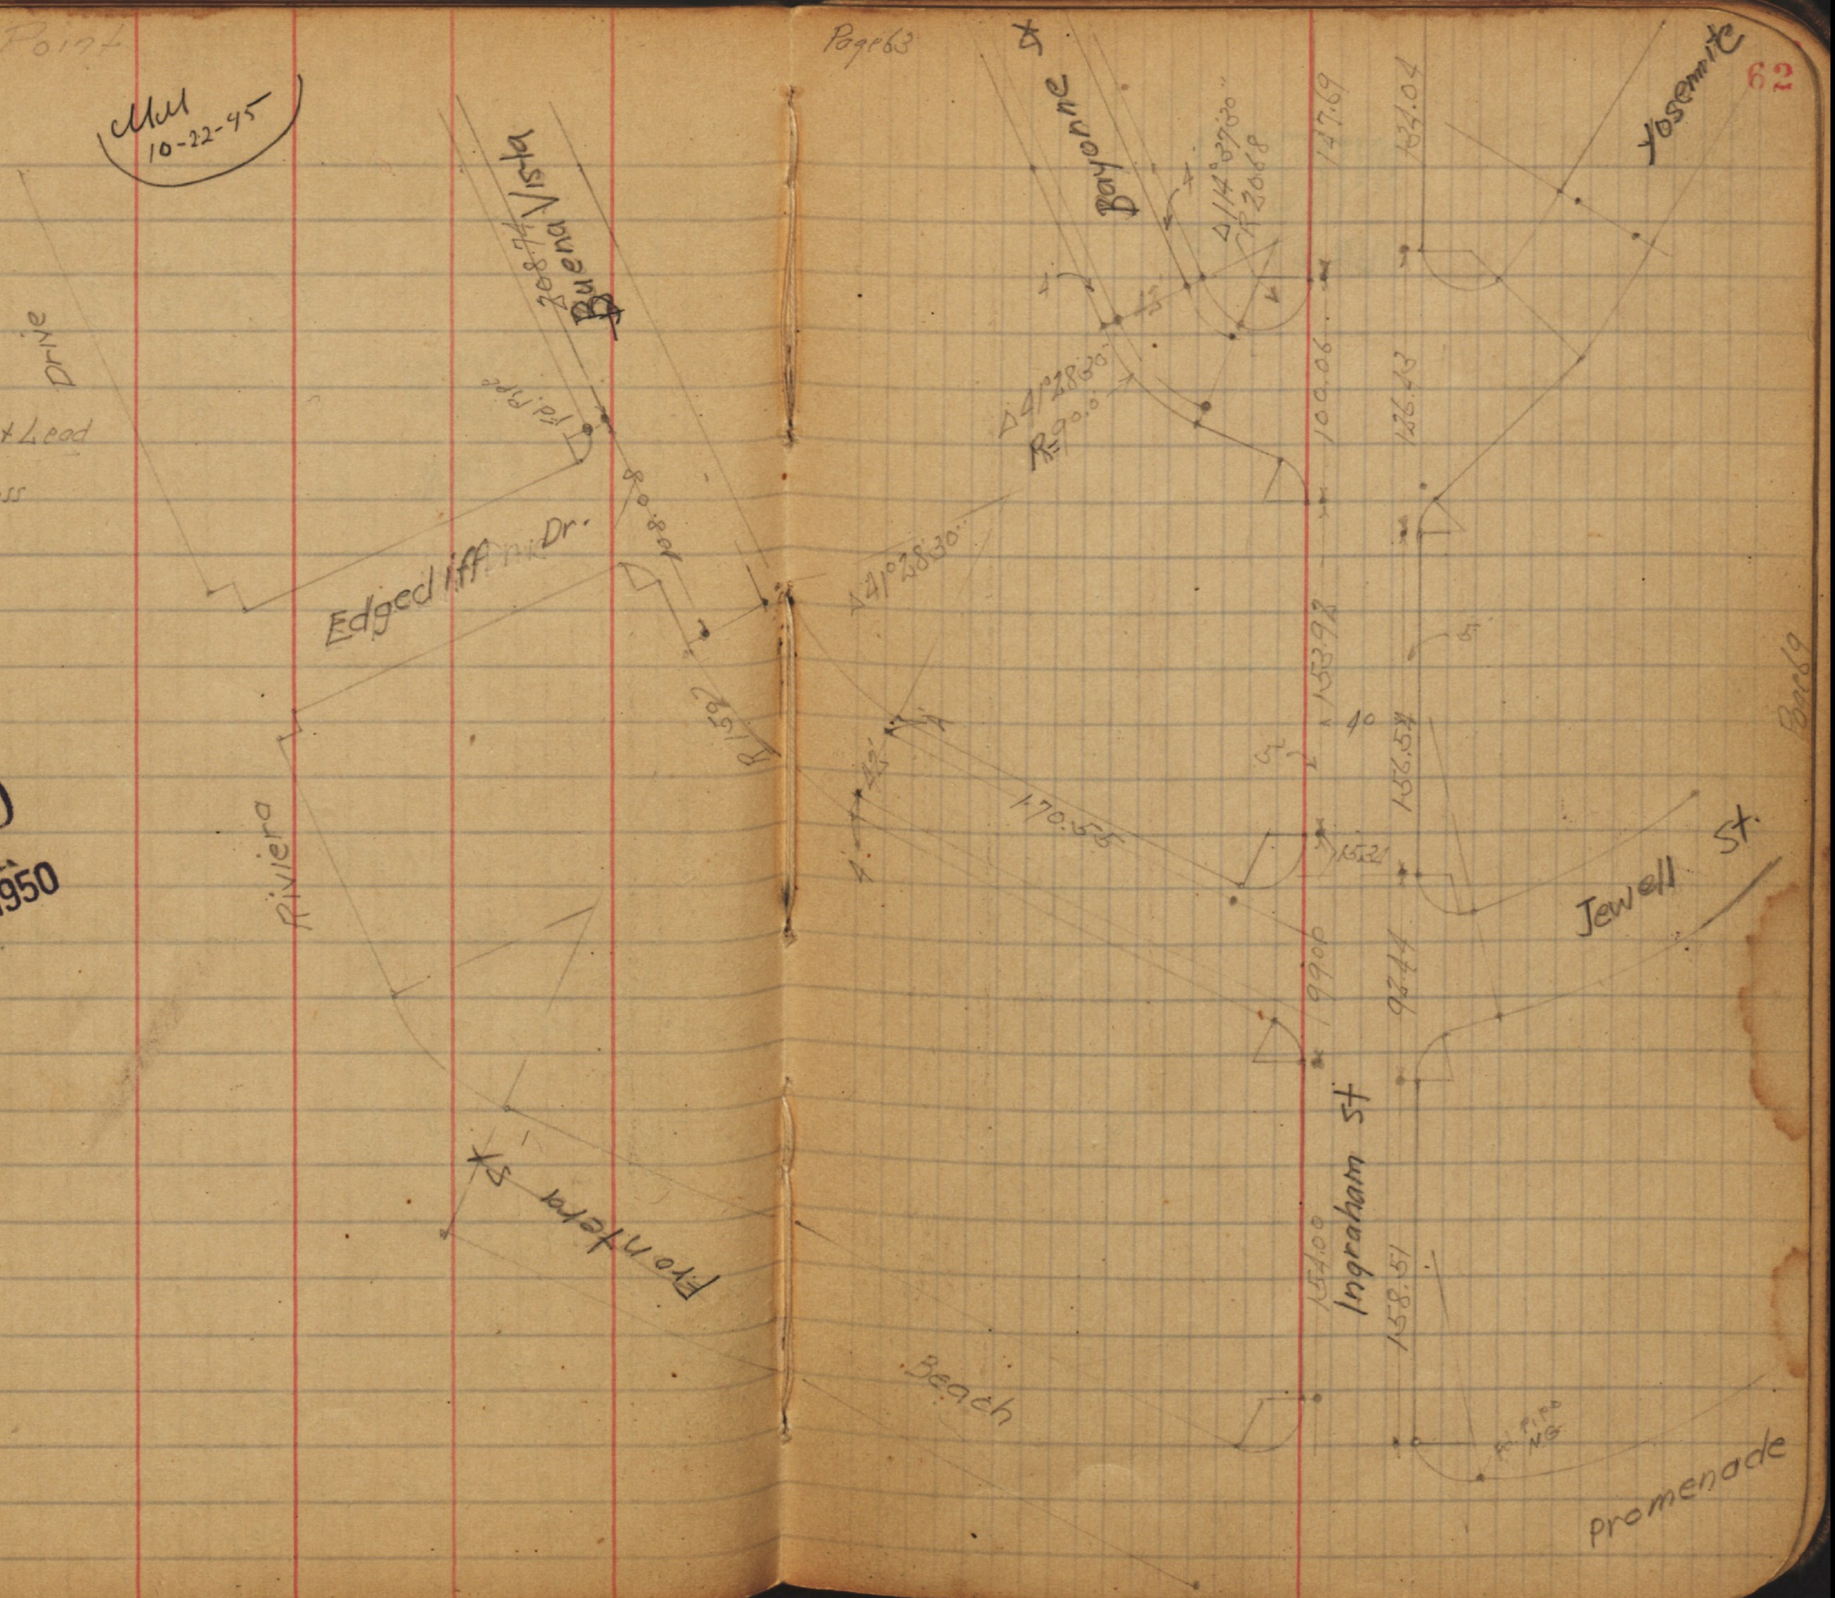

Page 64

MM
10-22-45

INDEXED
W.N.
JUN 22 1950

Page 58

Page 62

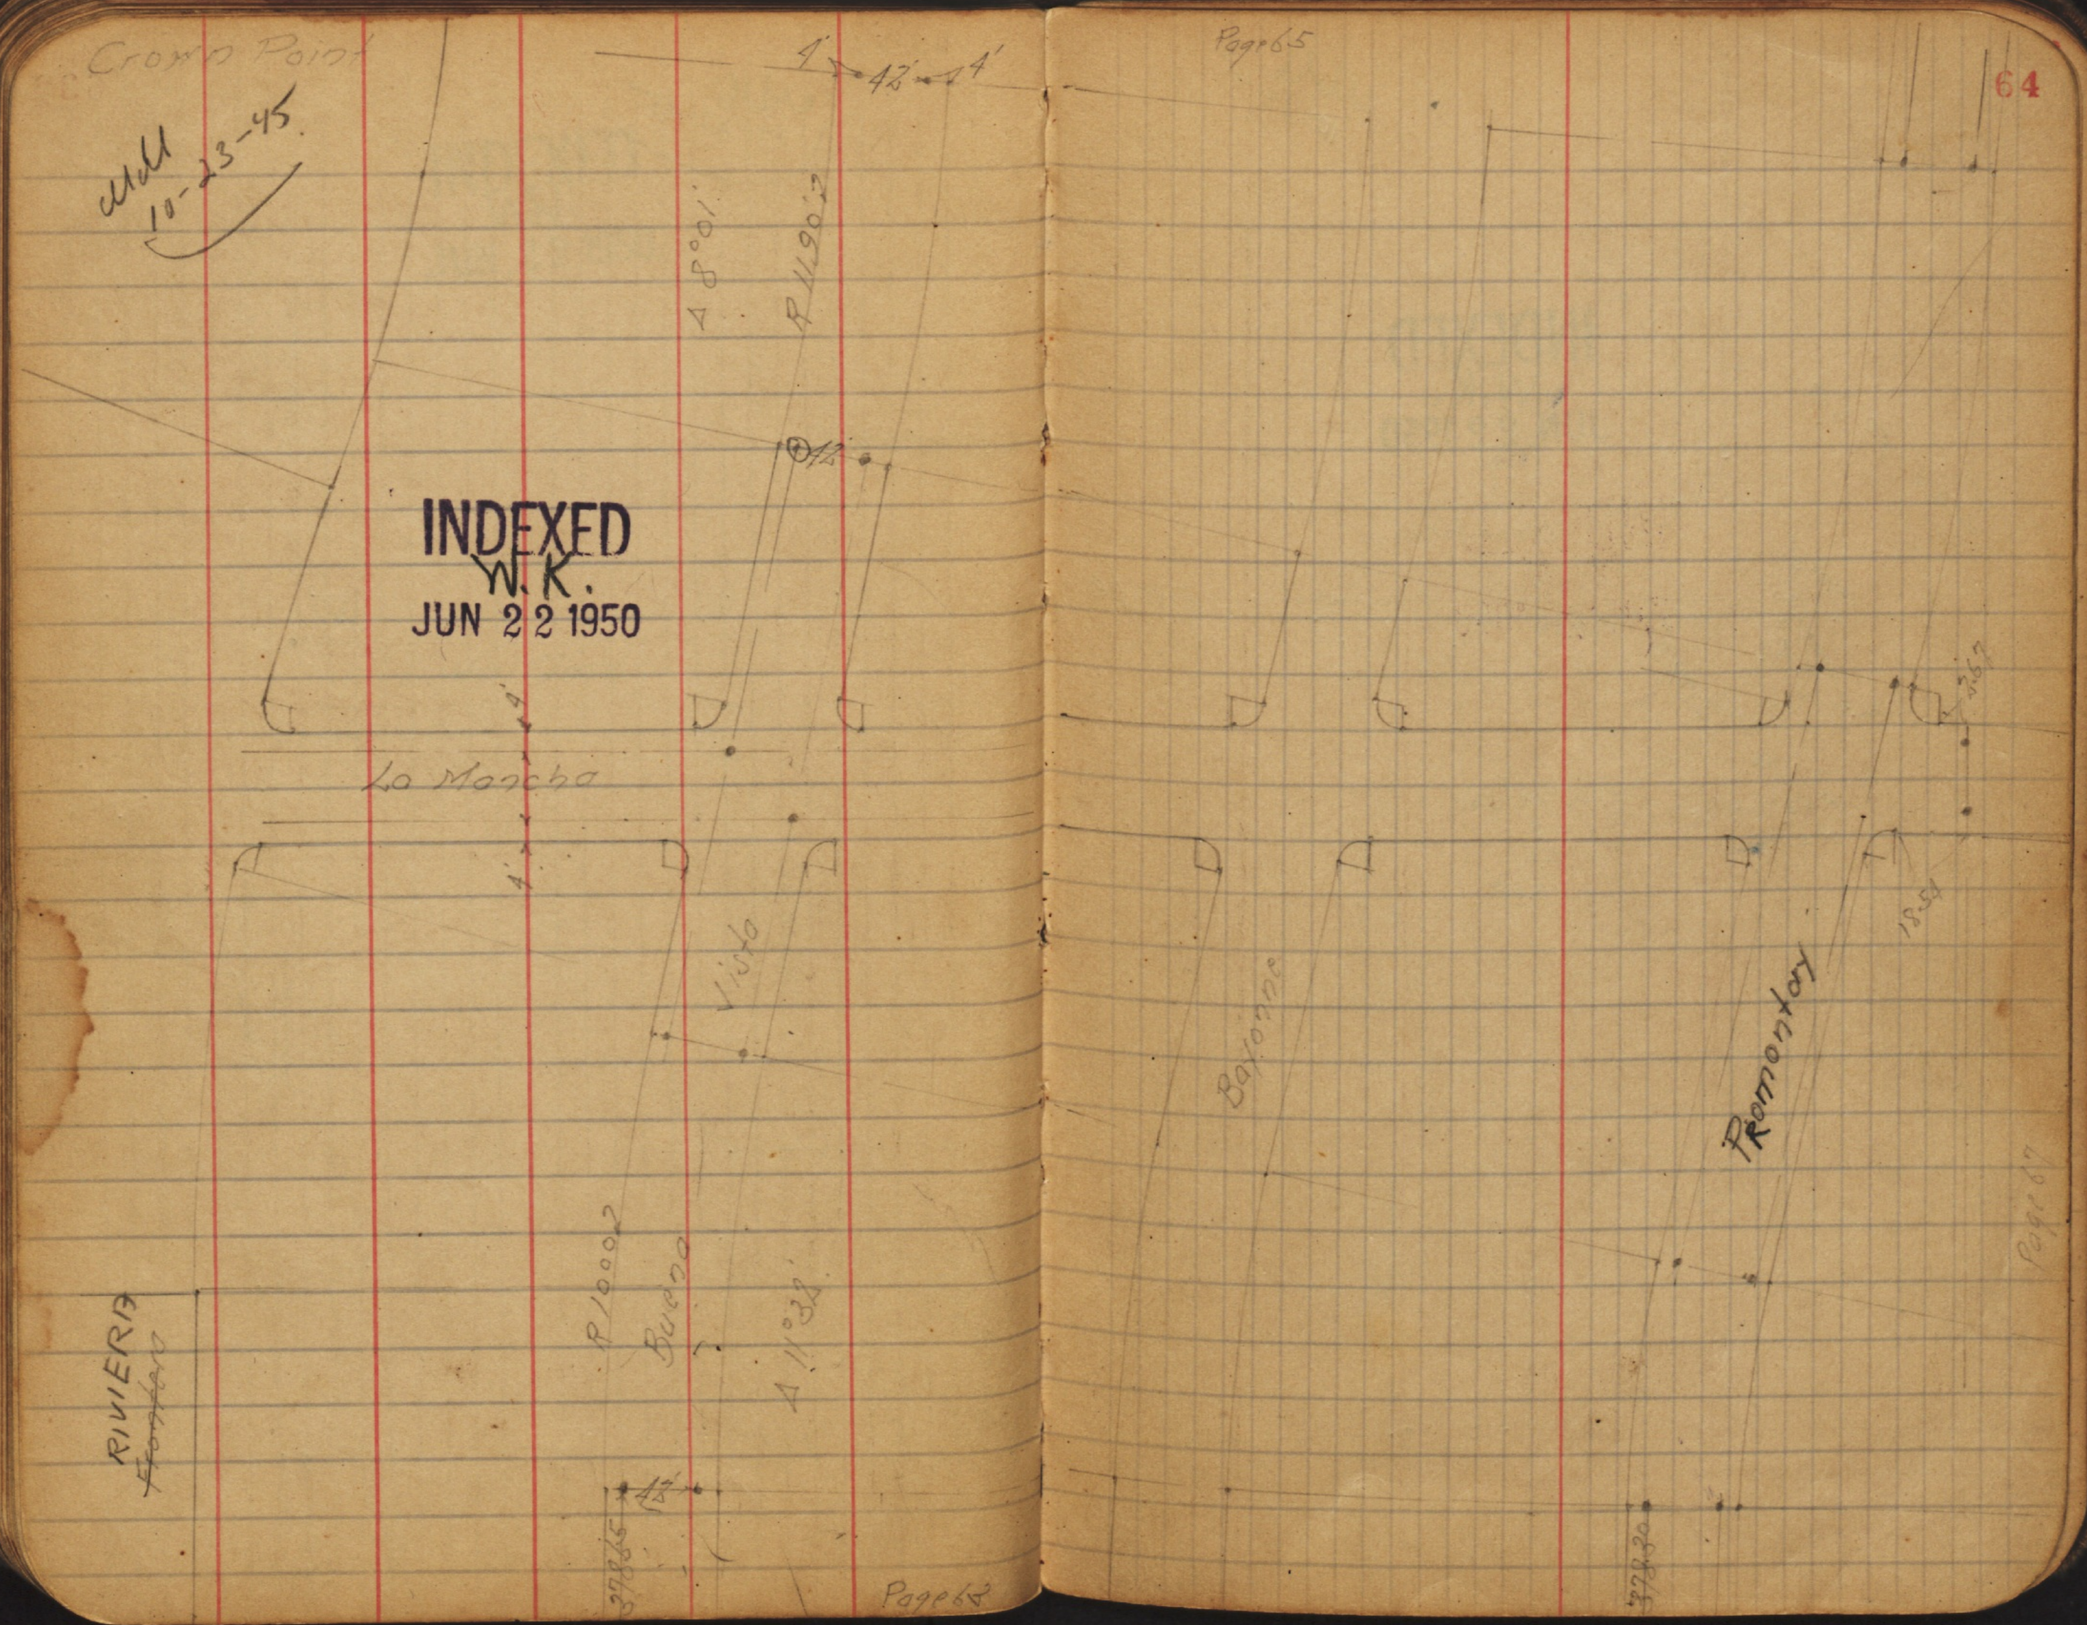

INDEXED
W.K.
JUN 22 1950

10-23-45

INDEXED
W.R.
JUN 22 1950

See P. 60

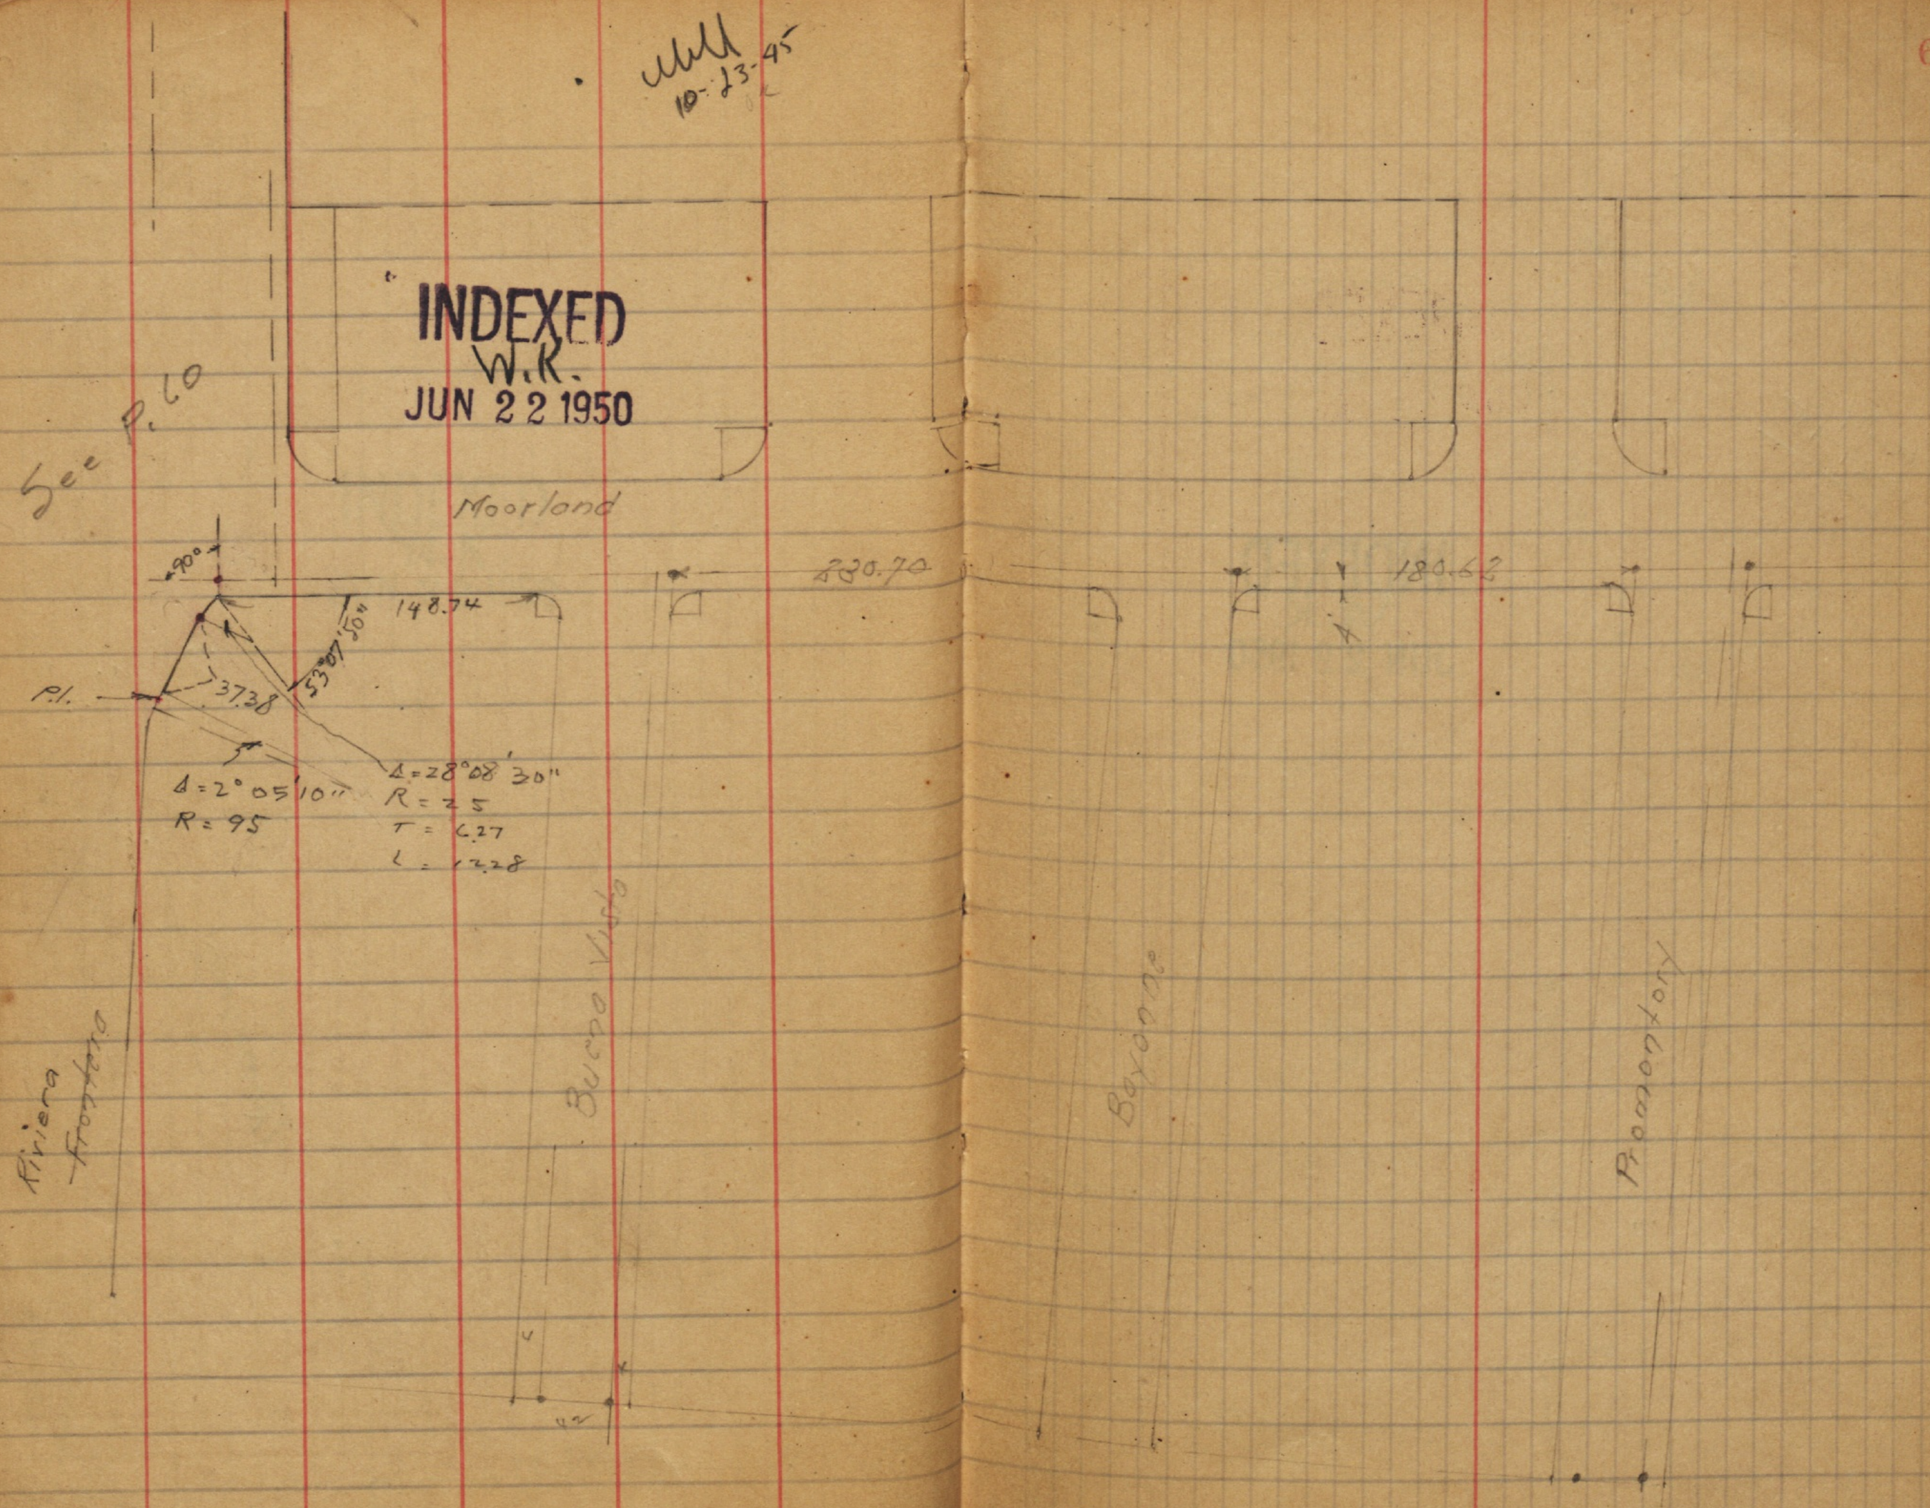

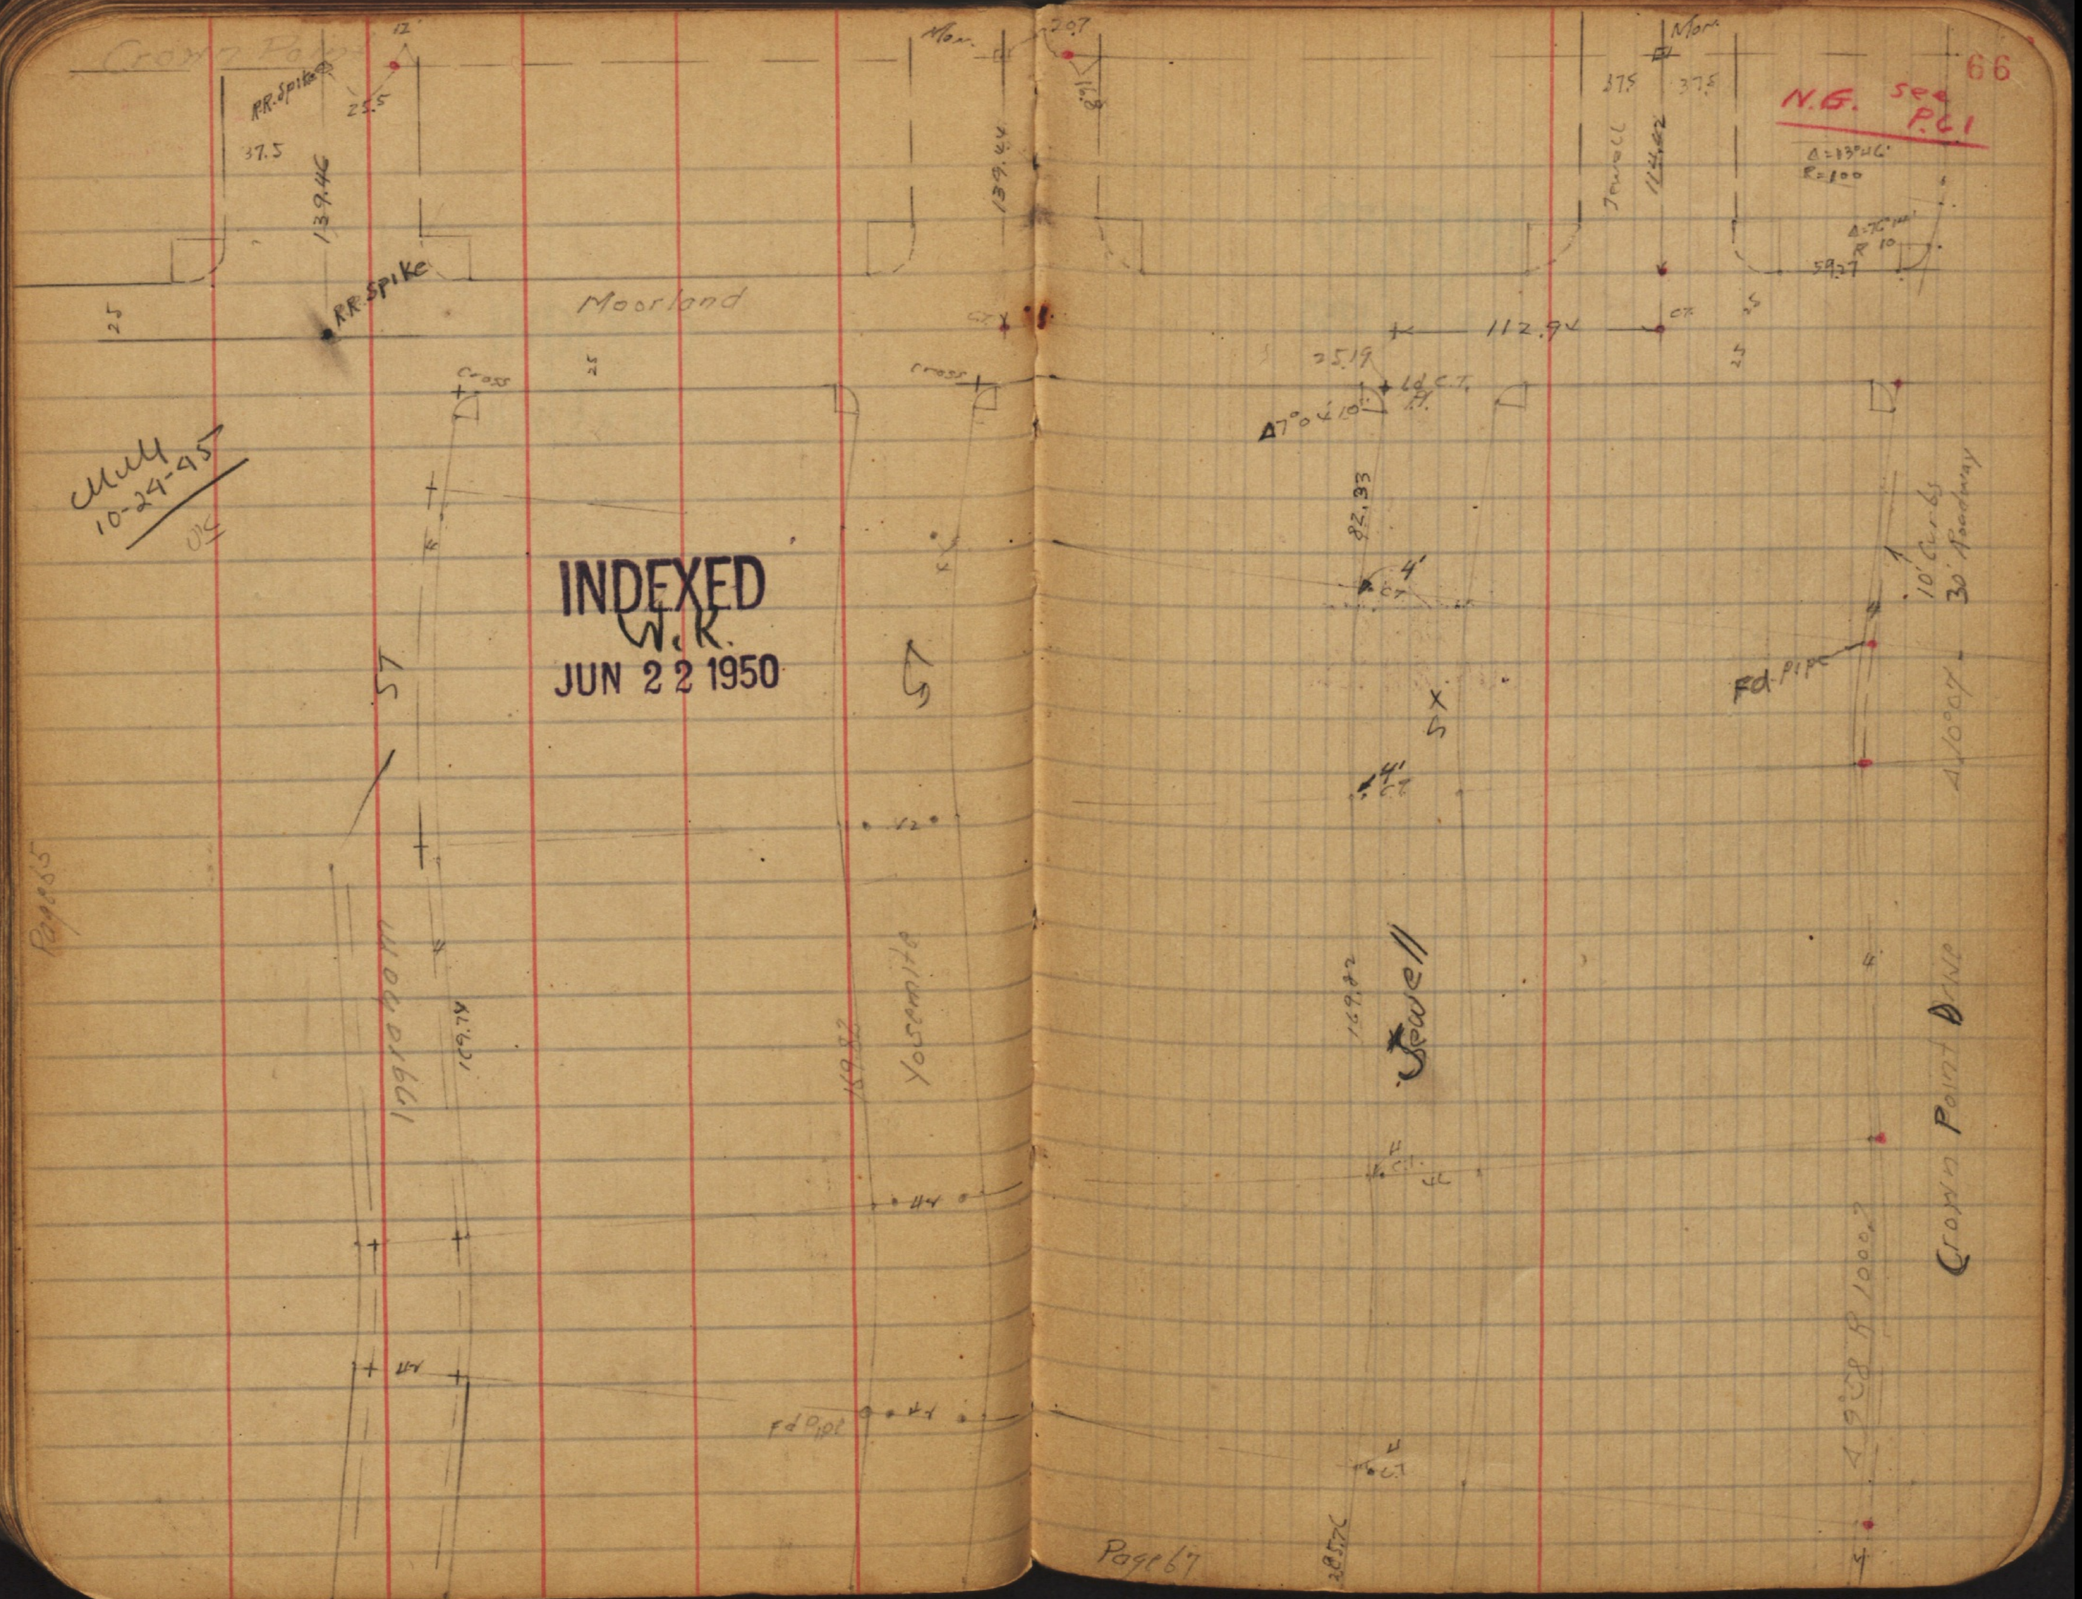

INDEXED
W.K.
JUN 22 1950

N.G. See P.61

Δ=13°46'
R=100

Δ=76°00'
R 10

59.27

Mull
10-24-45

INDEXED
W.K.
JUN 22 1950

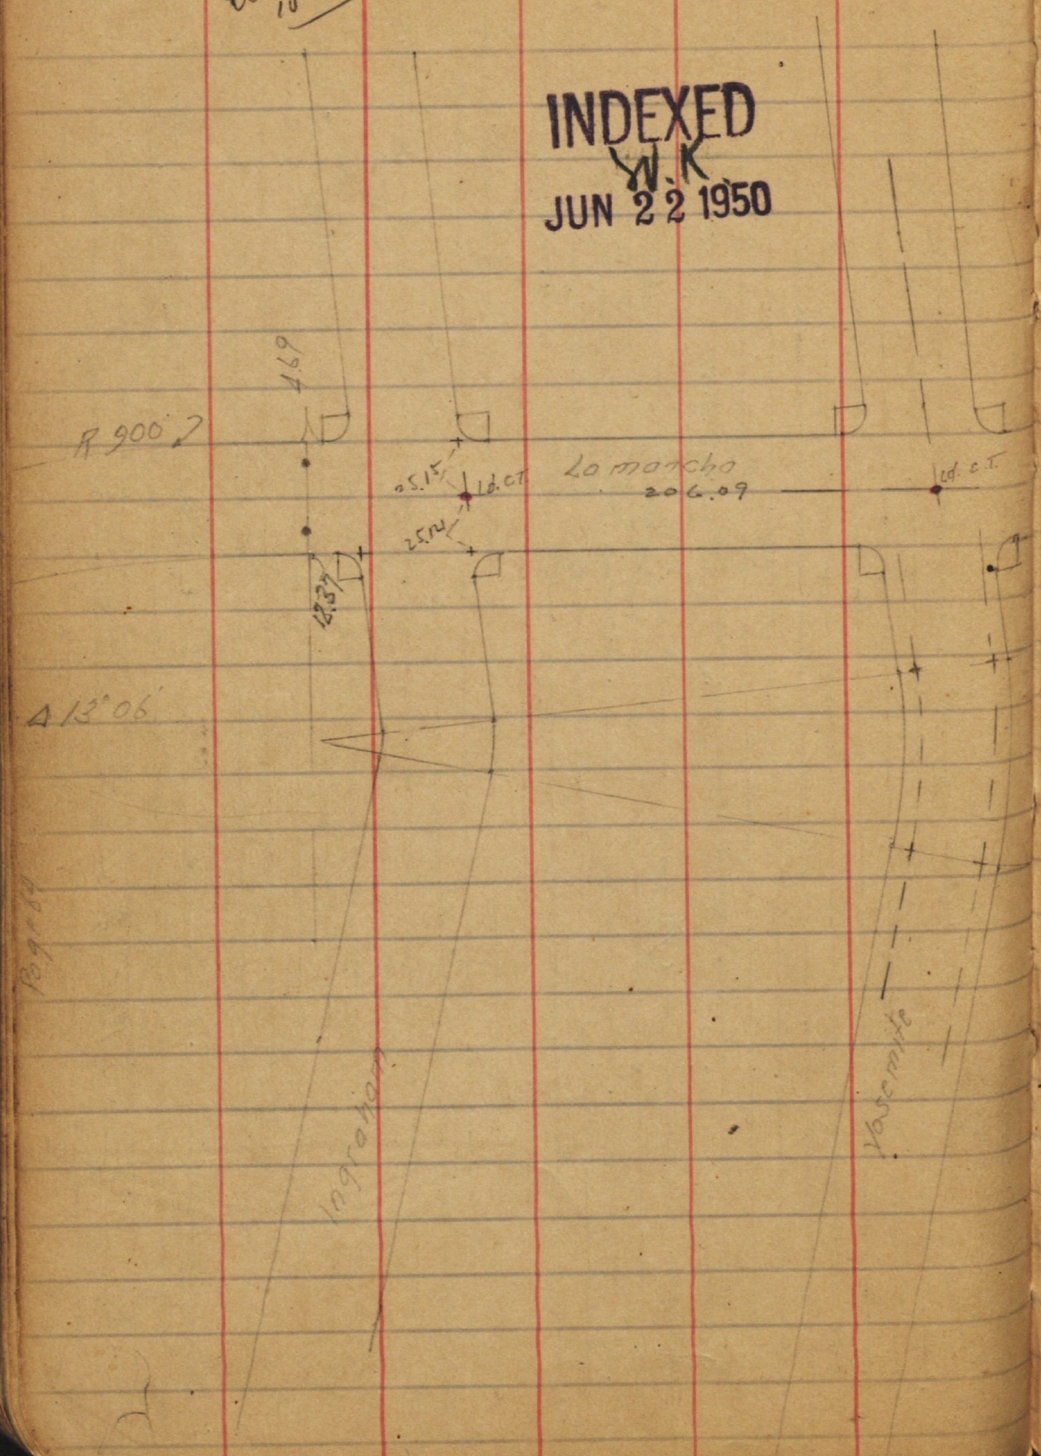

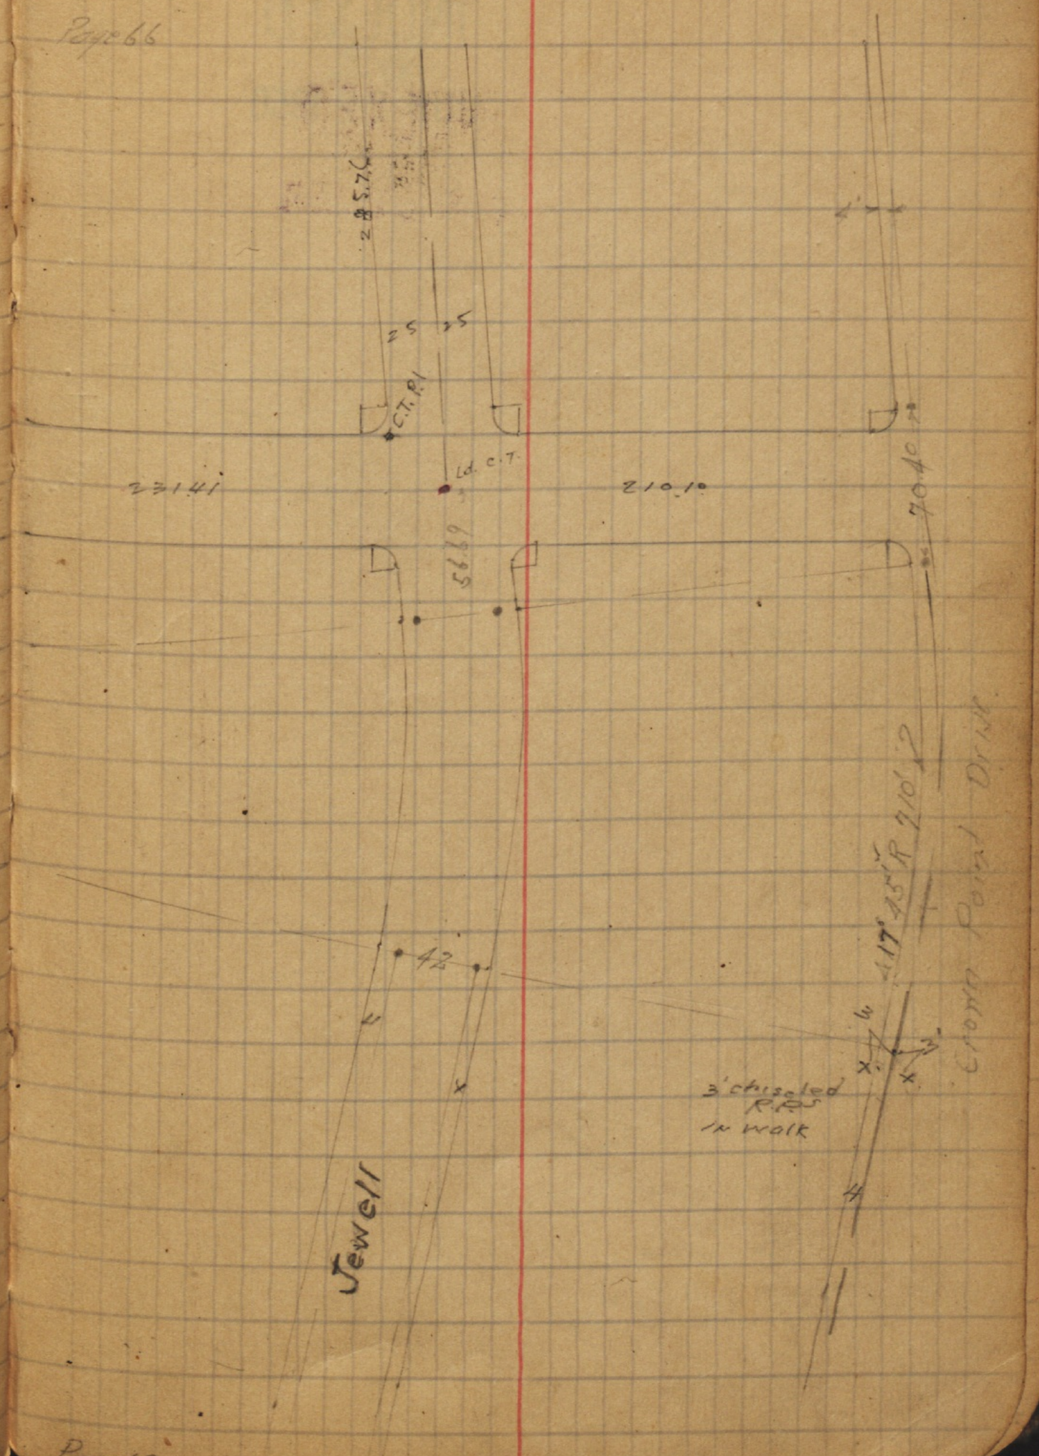

INDEXED
W.K.
JUN 22 1950

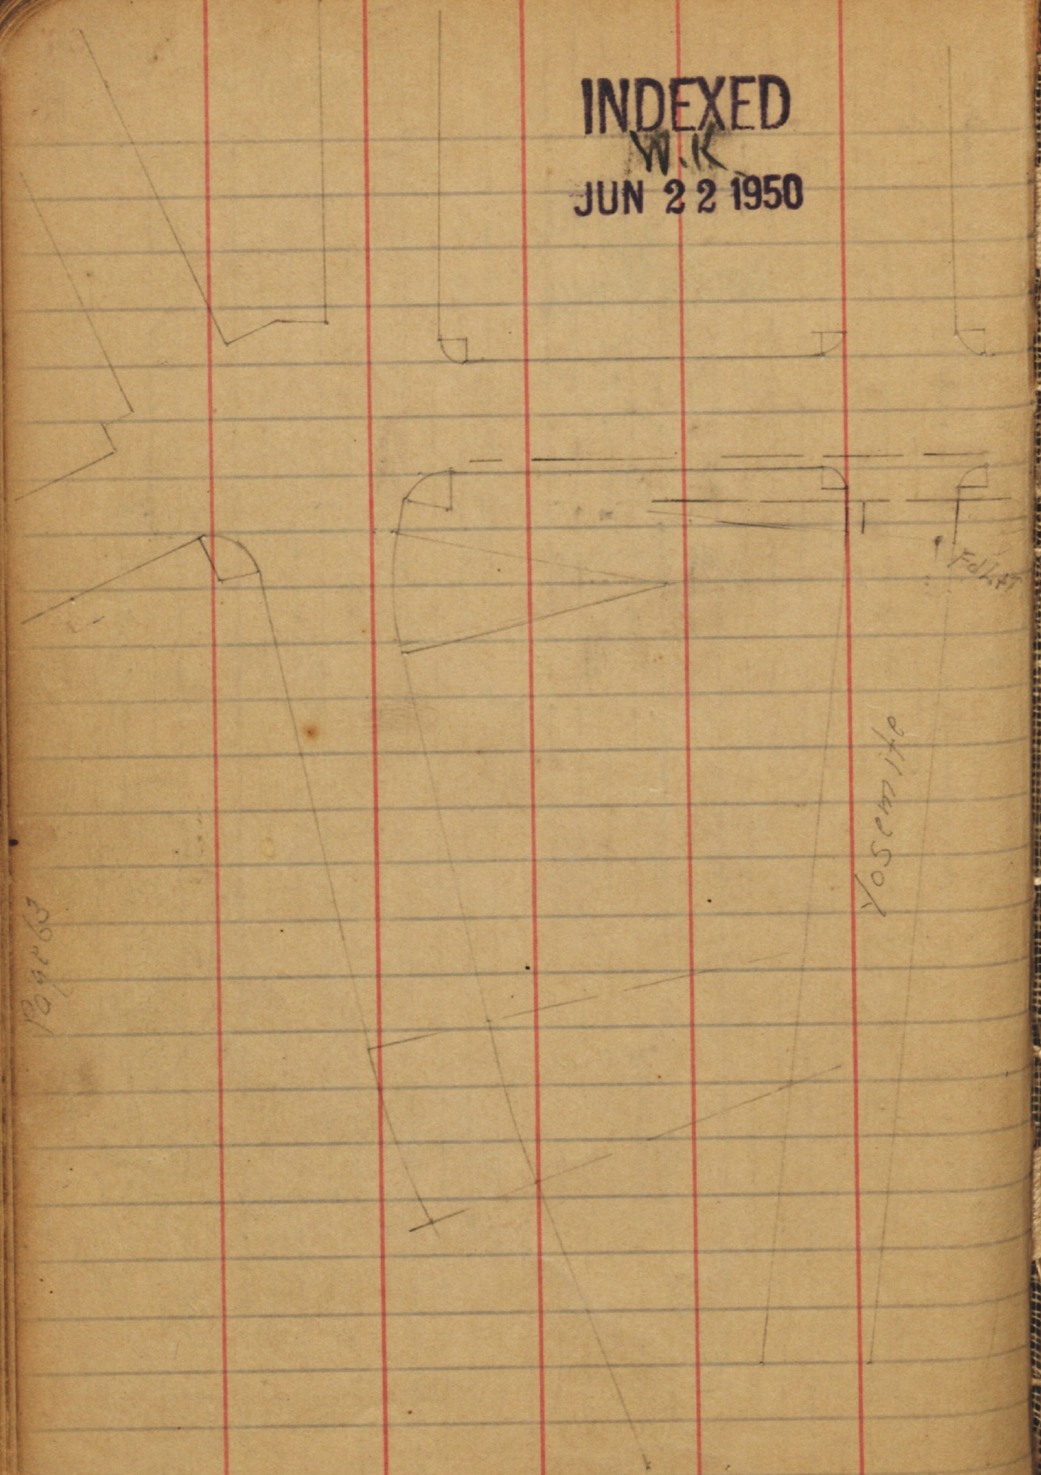

Page 67

10-26-45

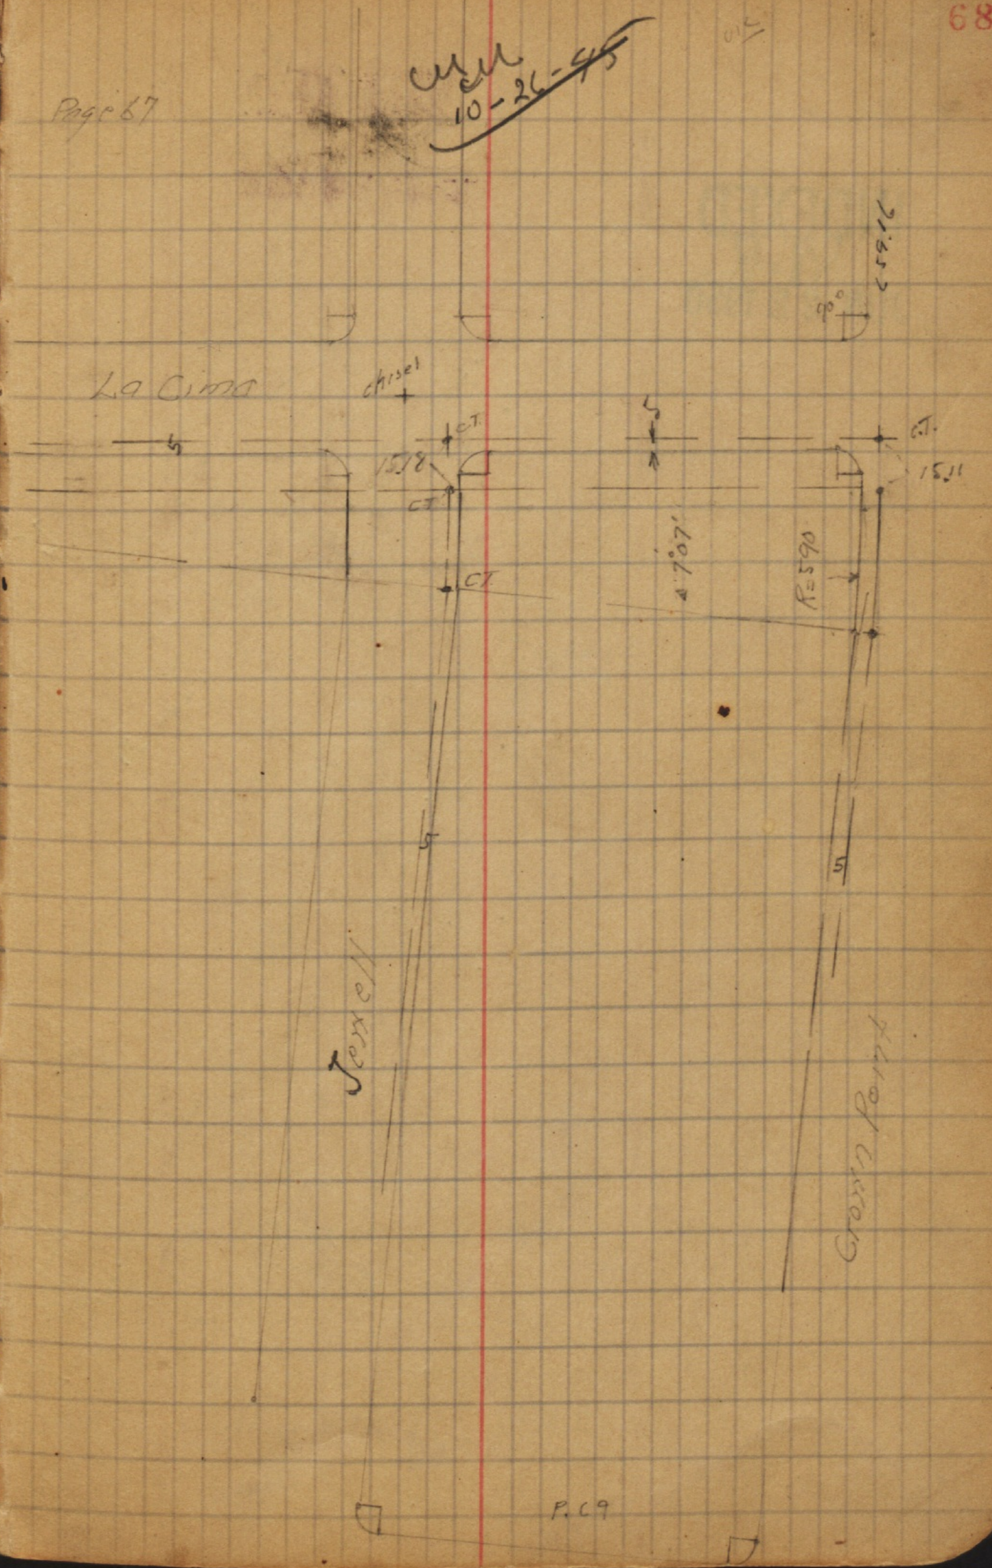

Crown Point

INDEXED
W.R.
JUN 22 1950

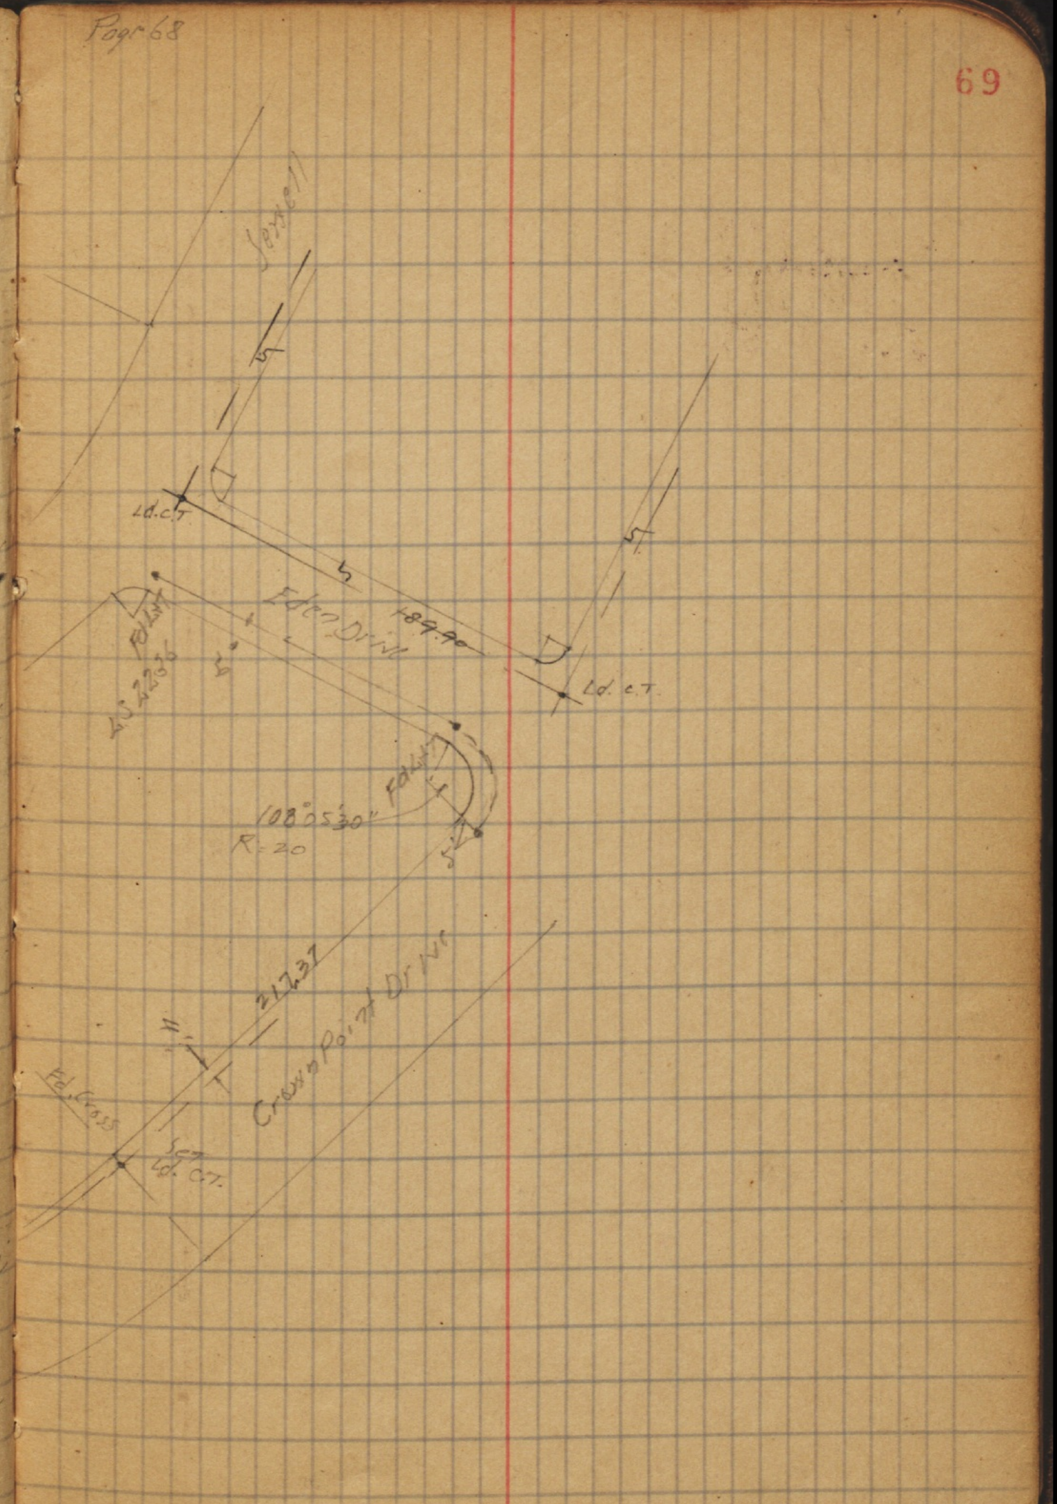

Homeland Villa Ties

⊡ = Hubs
⊙ = Conc Mont.

Moore
Walker
Reed
Hazard
June 1942

Recorded on Tie Point Sheets
8/3/42

TPS.
1524-5-6

INDEXED
W.K.
JUN 22 1950

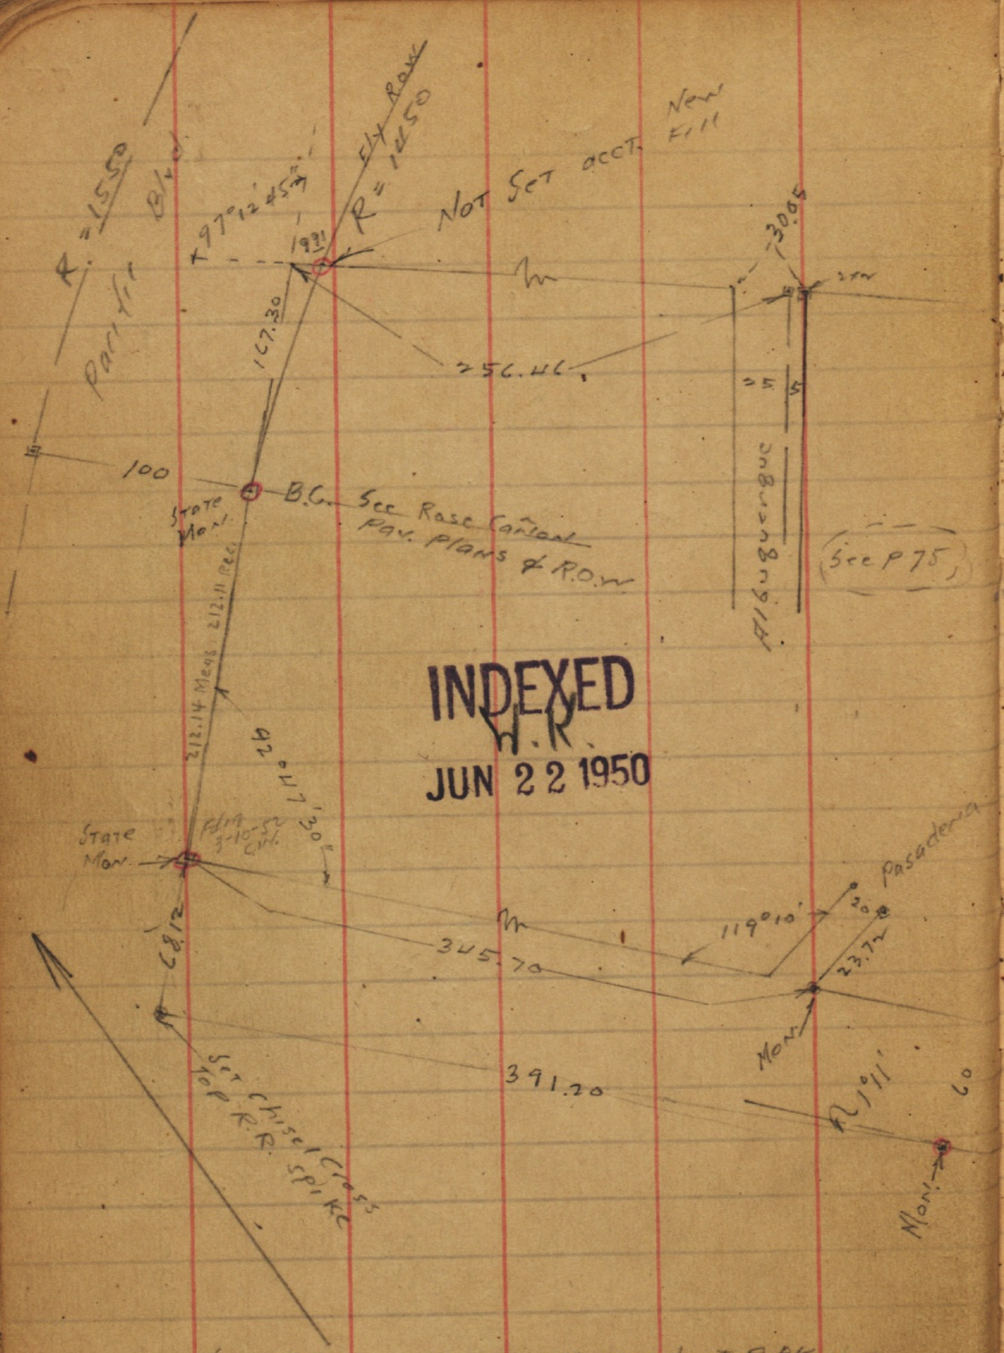

INDEXED
W.R.
JUN 22 1950

See F.B. 1216-13-14 and T.P.BK. 20 for Pueblo Cor Ties & Balboa to West

T.P.S. 1525-6
McQ - 1-28-48

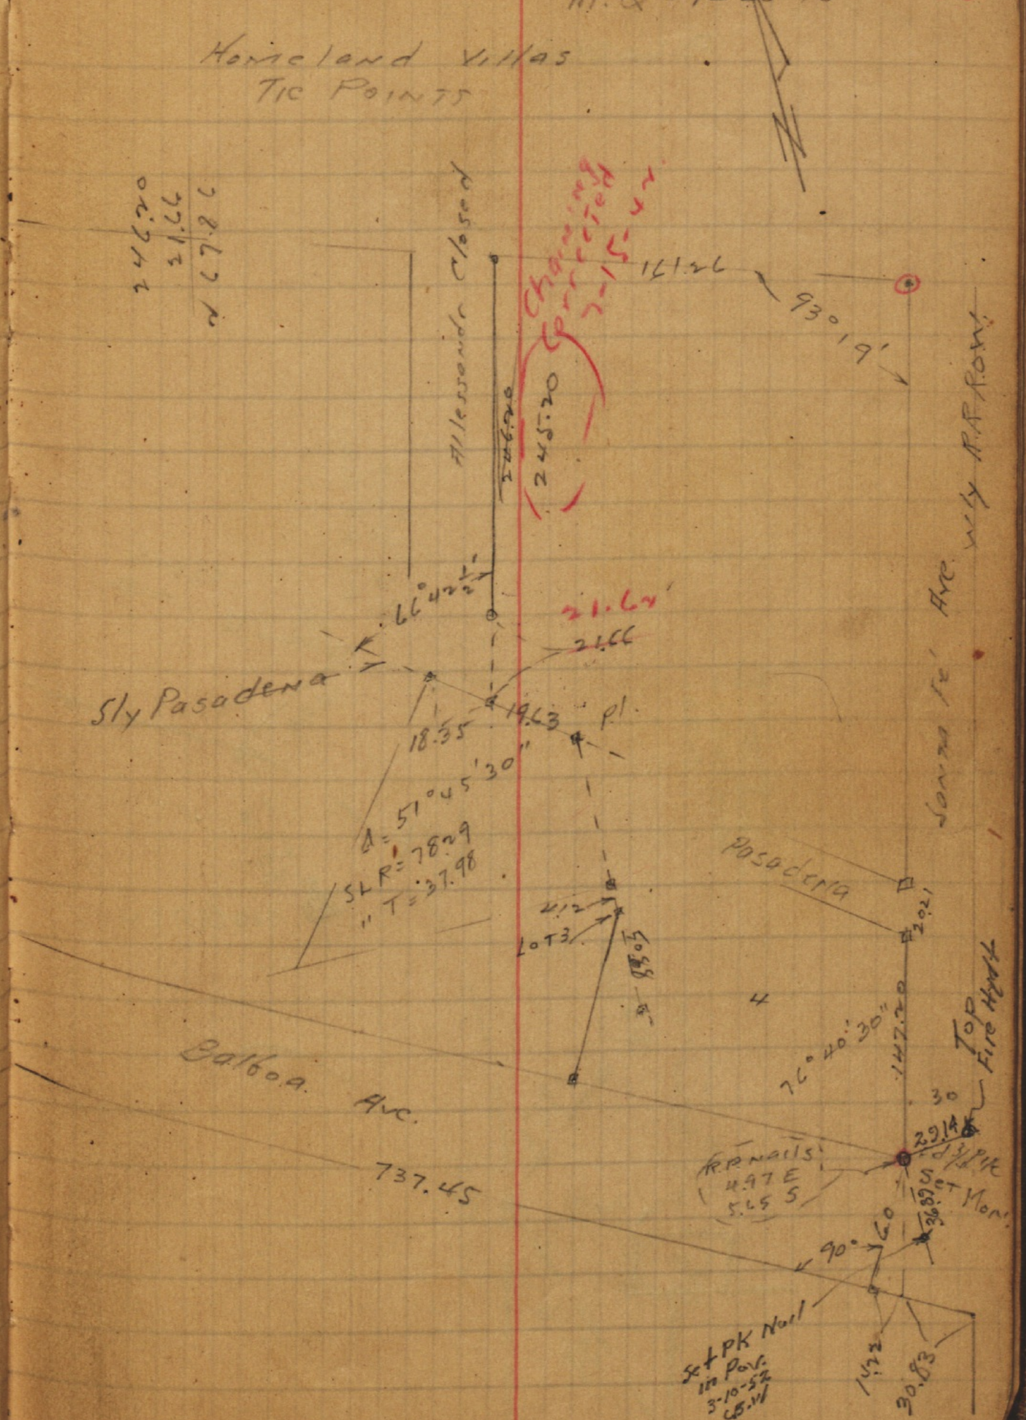

PASADENA

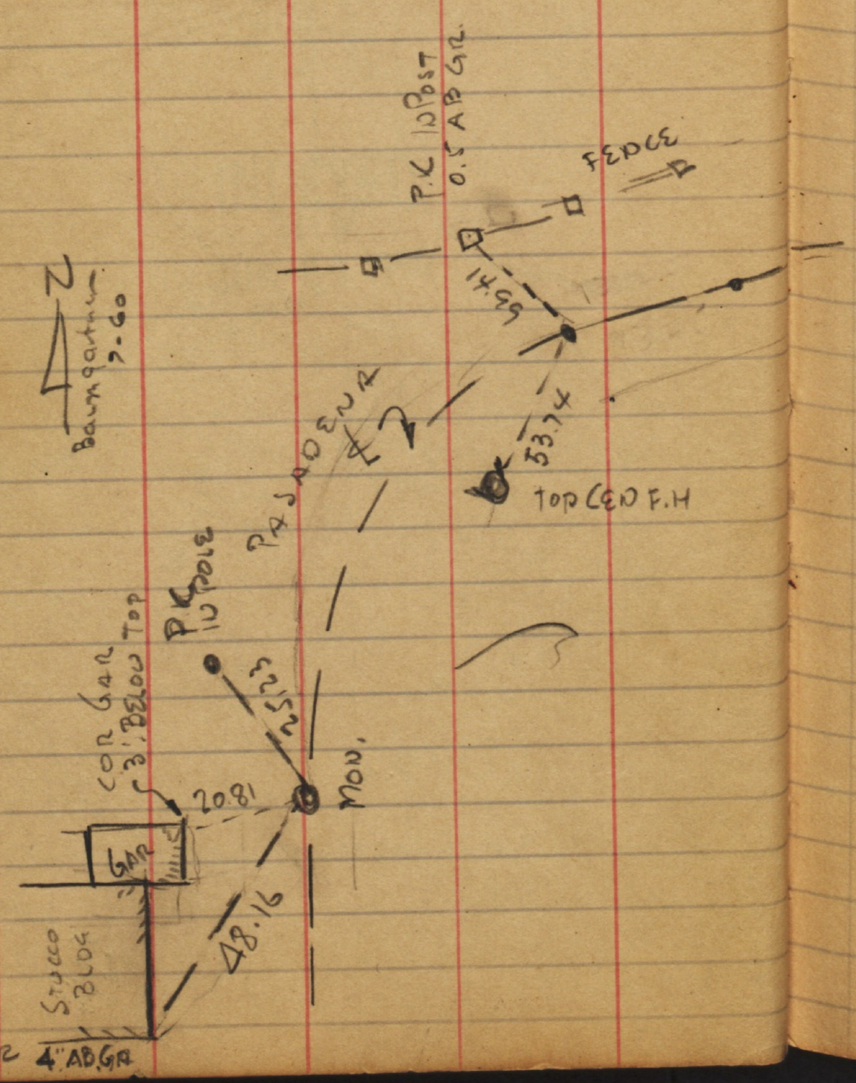
P.K. IN POST
0.5 AB GR.
FENCE
14.69
53.74
TOP CEN F.H
PASADENA
N
Baumgartner
7.60
P.K. IN POLE
25.23
MON.
COR GAR
3' BELOW TOP
20.81
GAR
48.16
STUCCO BLDG
COR 4" AB GR

112
.093
336
1008
20.416
20.83

112
029
1008
2248
2248