216-1692

218-1692
220-1689
220-1692
222-1689
222-1692
224-1689
224-1692
226-1689
226-1692
228-1689
228-1692

16

INDEX NO. 216-1692 TYPE
DATE DEC. 1964 W.O. 20575
SURVEYOR BAUMGARTNER
DESCRIPTION TIE PTS

MISSION BEACH
ADDITIONAL NOTES BY CRAIG 1-9-78 SHEETS (1)
STRANDWAY & BRIGHTON CT.-- SET C.E.D. TO
CORRECT MISSPLACED MONUMENT

MICROFILMED DEC 11 1969

TIE POINTS

CHIEF: BAUMGARTNER

INSTR: _____

CHN: _____

CHN: _____

CITY OF SAN DIEGO

ENGINEERING DEPARTMENT FIELD NOTES

Job Description and Location MISSION BEACH TIE POINT

SHEET NO 1 OF 13 SHEETS

FILED UNDER

INDEX LOCATION 216-18/1692

DATE: DEC 1964

W.O. NO. 20575

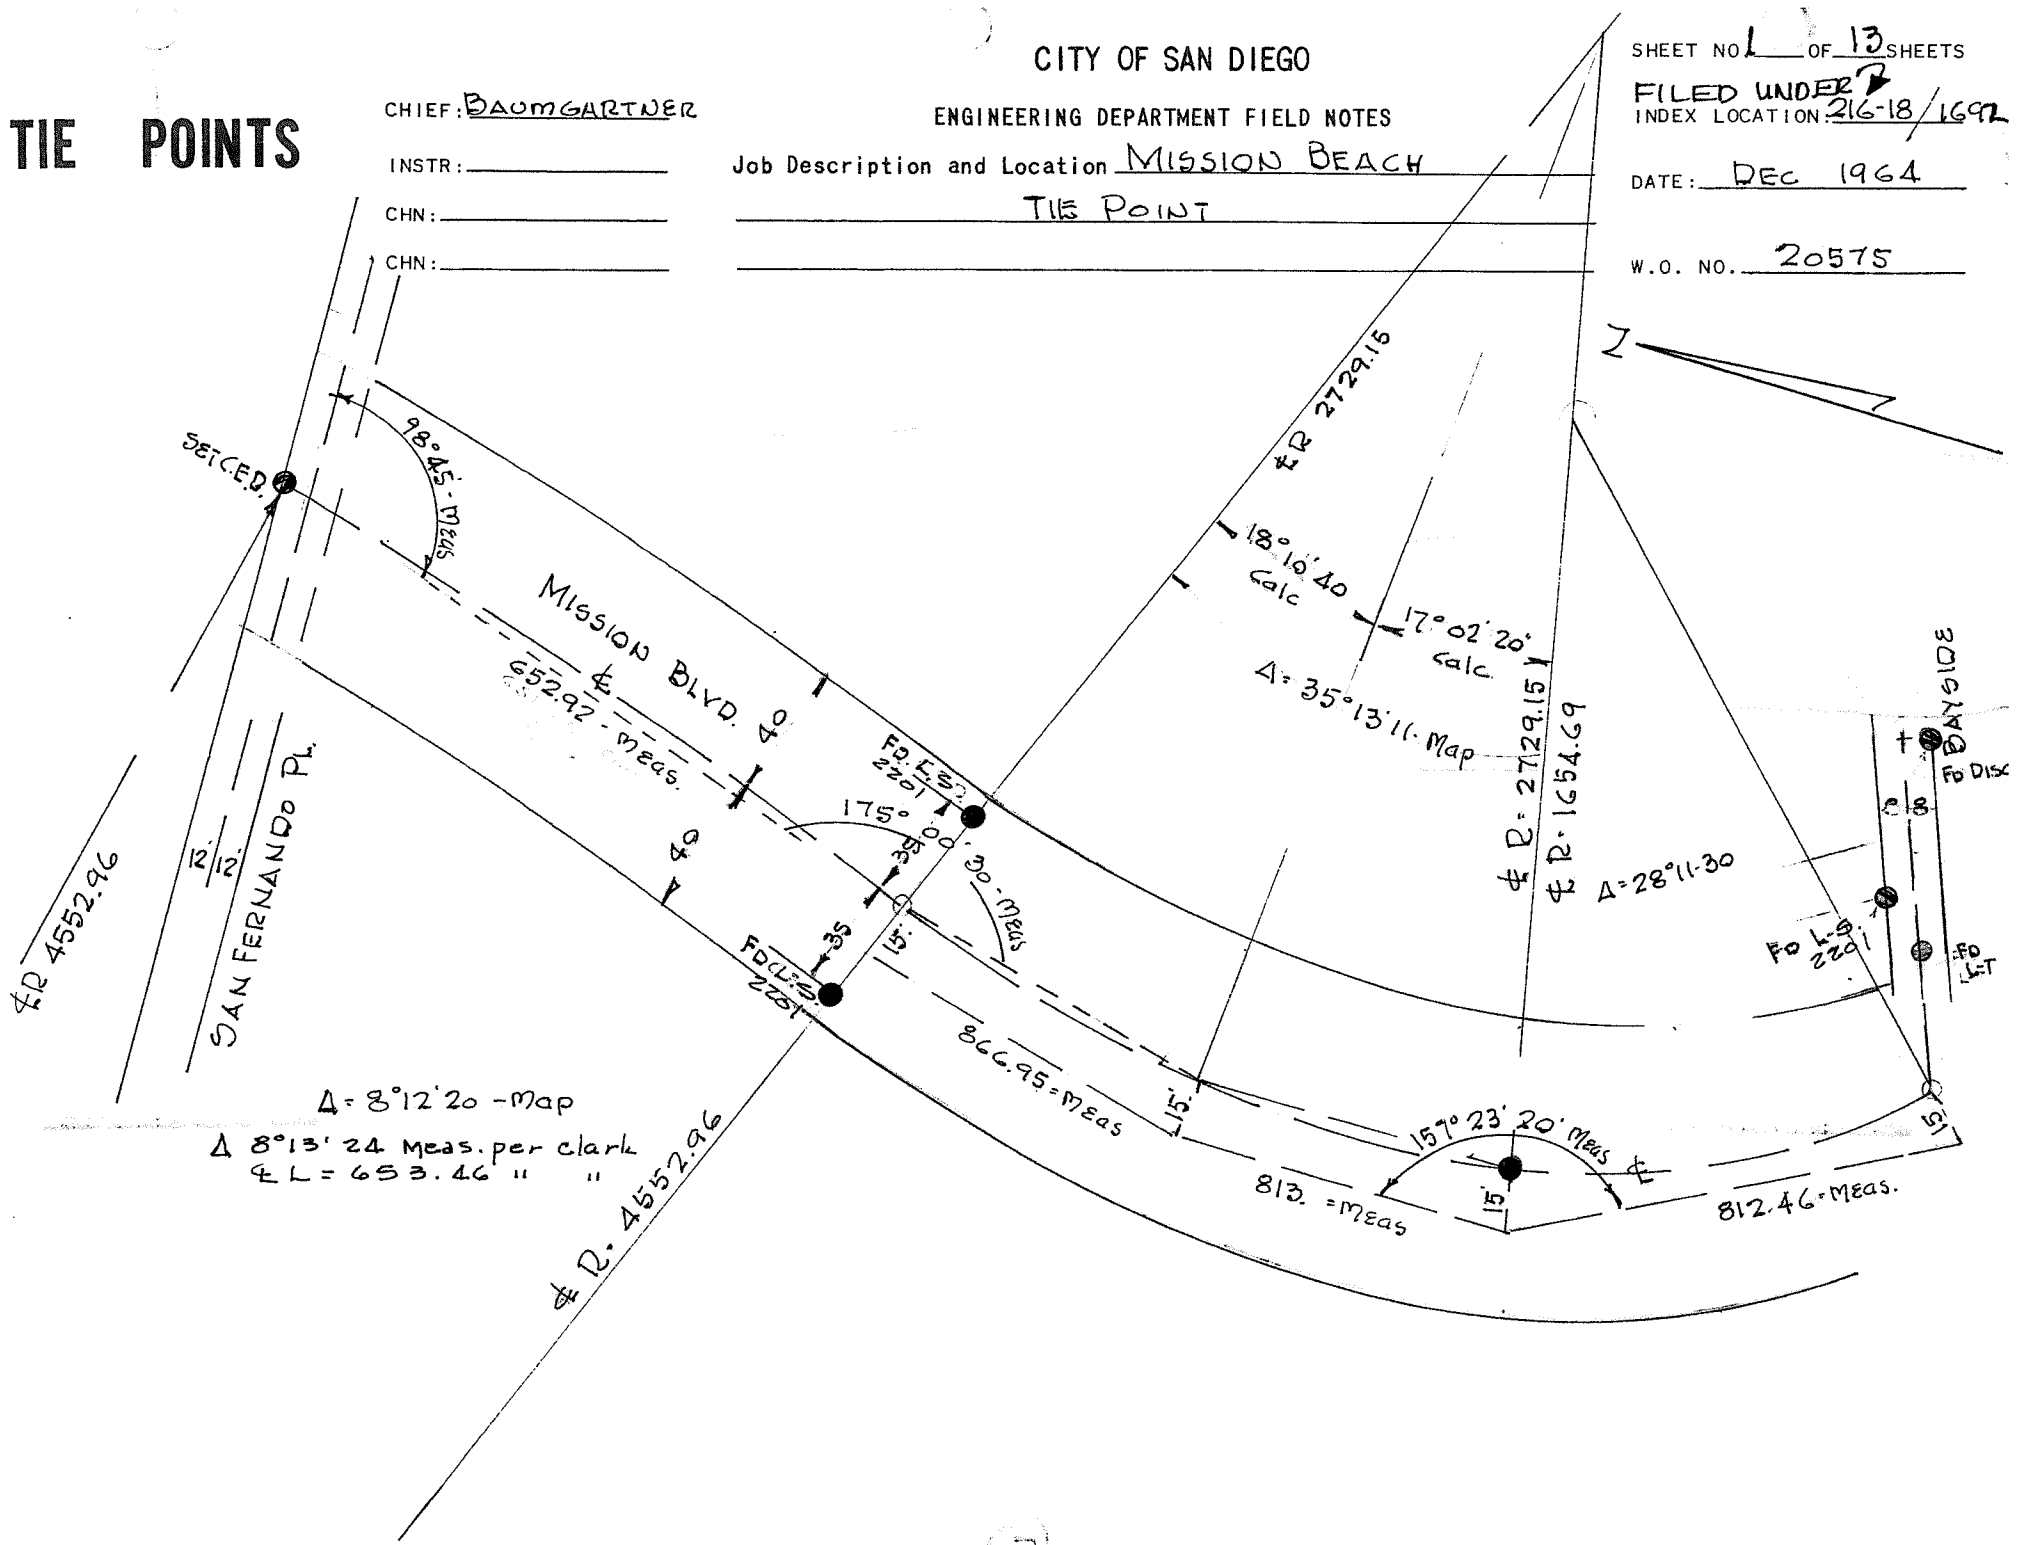

FORM CE-1489 (8-60)

TIE POINTS

CITY OF SAN DIEGO

ENGINEERING DEPARTMENT FIELD NOTES

SHEET NO. 2 — 13 SHEETS

216-1692

INDEX LOCATION: 216-18 ~~/ 169H~~

CHIEF Baumgartner

INSTR Gaddy

CHN: Moralez

CHN: Orlando

Job Description and Location MISSION BEACH

DATE: DEC 1964

TIE POINT SURVEY

W.O. NO. 20575

On Curves All Distances Shown Are Chord Measure.
Set 3'. Tie Outs To All P.I's Shown Herein Except Where P.I Hits On Or Near A Manhole.

- ● Indicates Set City Eng Disc Unless Otherwise Noted
- ○ " Manhole Cover
- ⊽ " Control Mon
- × " Set Ch x Unless Otherwise Noted

East West Courts & Alleys Are A Straight Line Between Strandway & Bayside Lane Unless Otherwise Shown

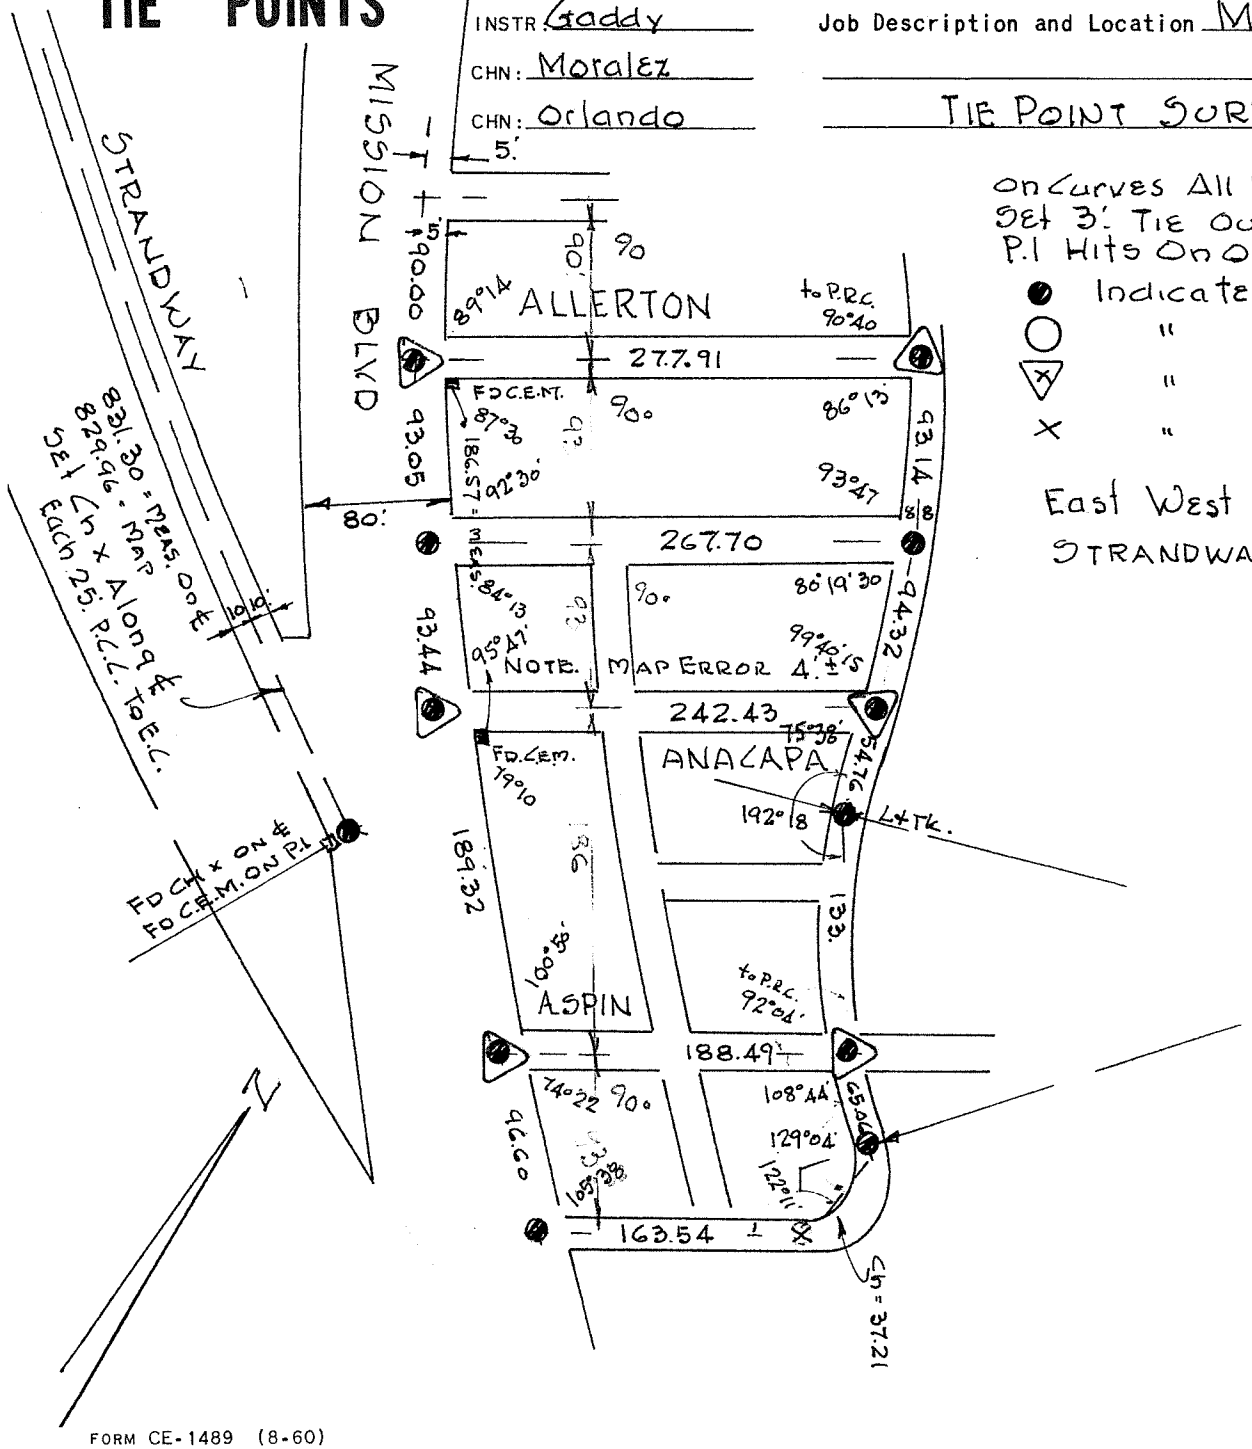

FORM CE-1489 (8-60)

TIE POINTS

CITY OF SAN DIEGO

ENGINEERING DEPARTMENT FIELD NOTES

CHIEF: BAUMGARTNER

INSTR:

CHN: 244.45

CHN:

Job Description and Location MISSION BEACH TIE POINT SURVEY

SHEET NO. 3 : 13 SHEETS

216-1692

INDEX LOCATION: 218-16/1692

DATE: Dec 1964

W.O. NO. 20575

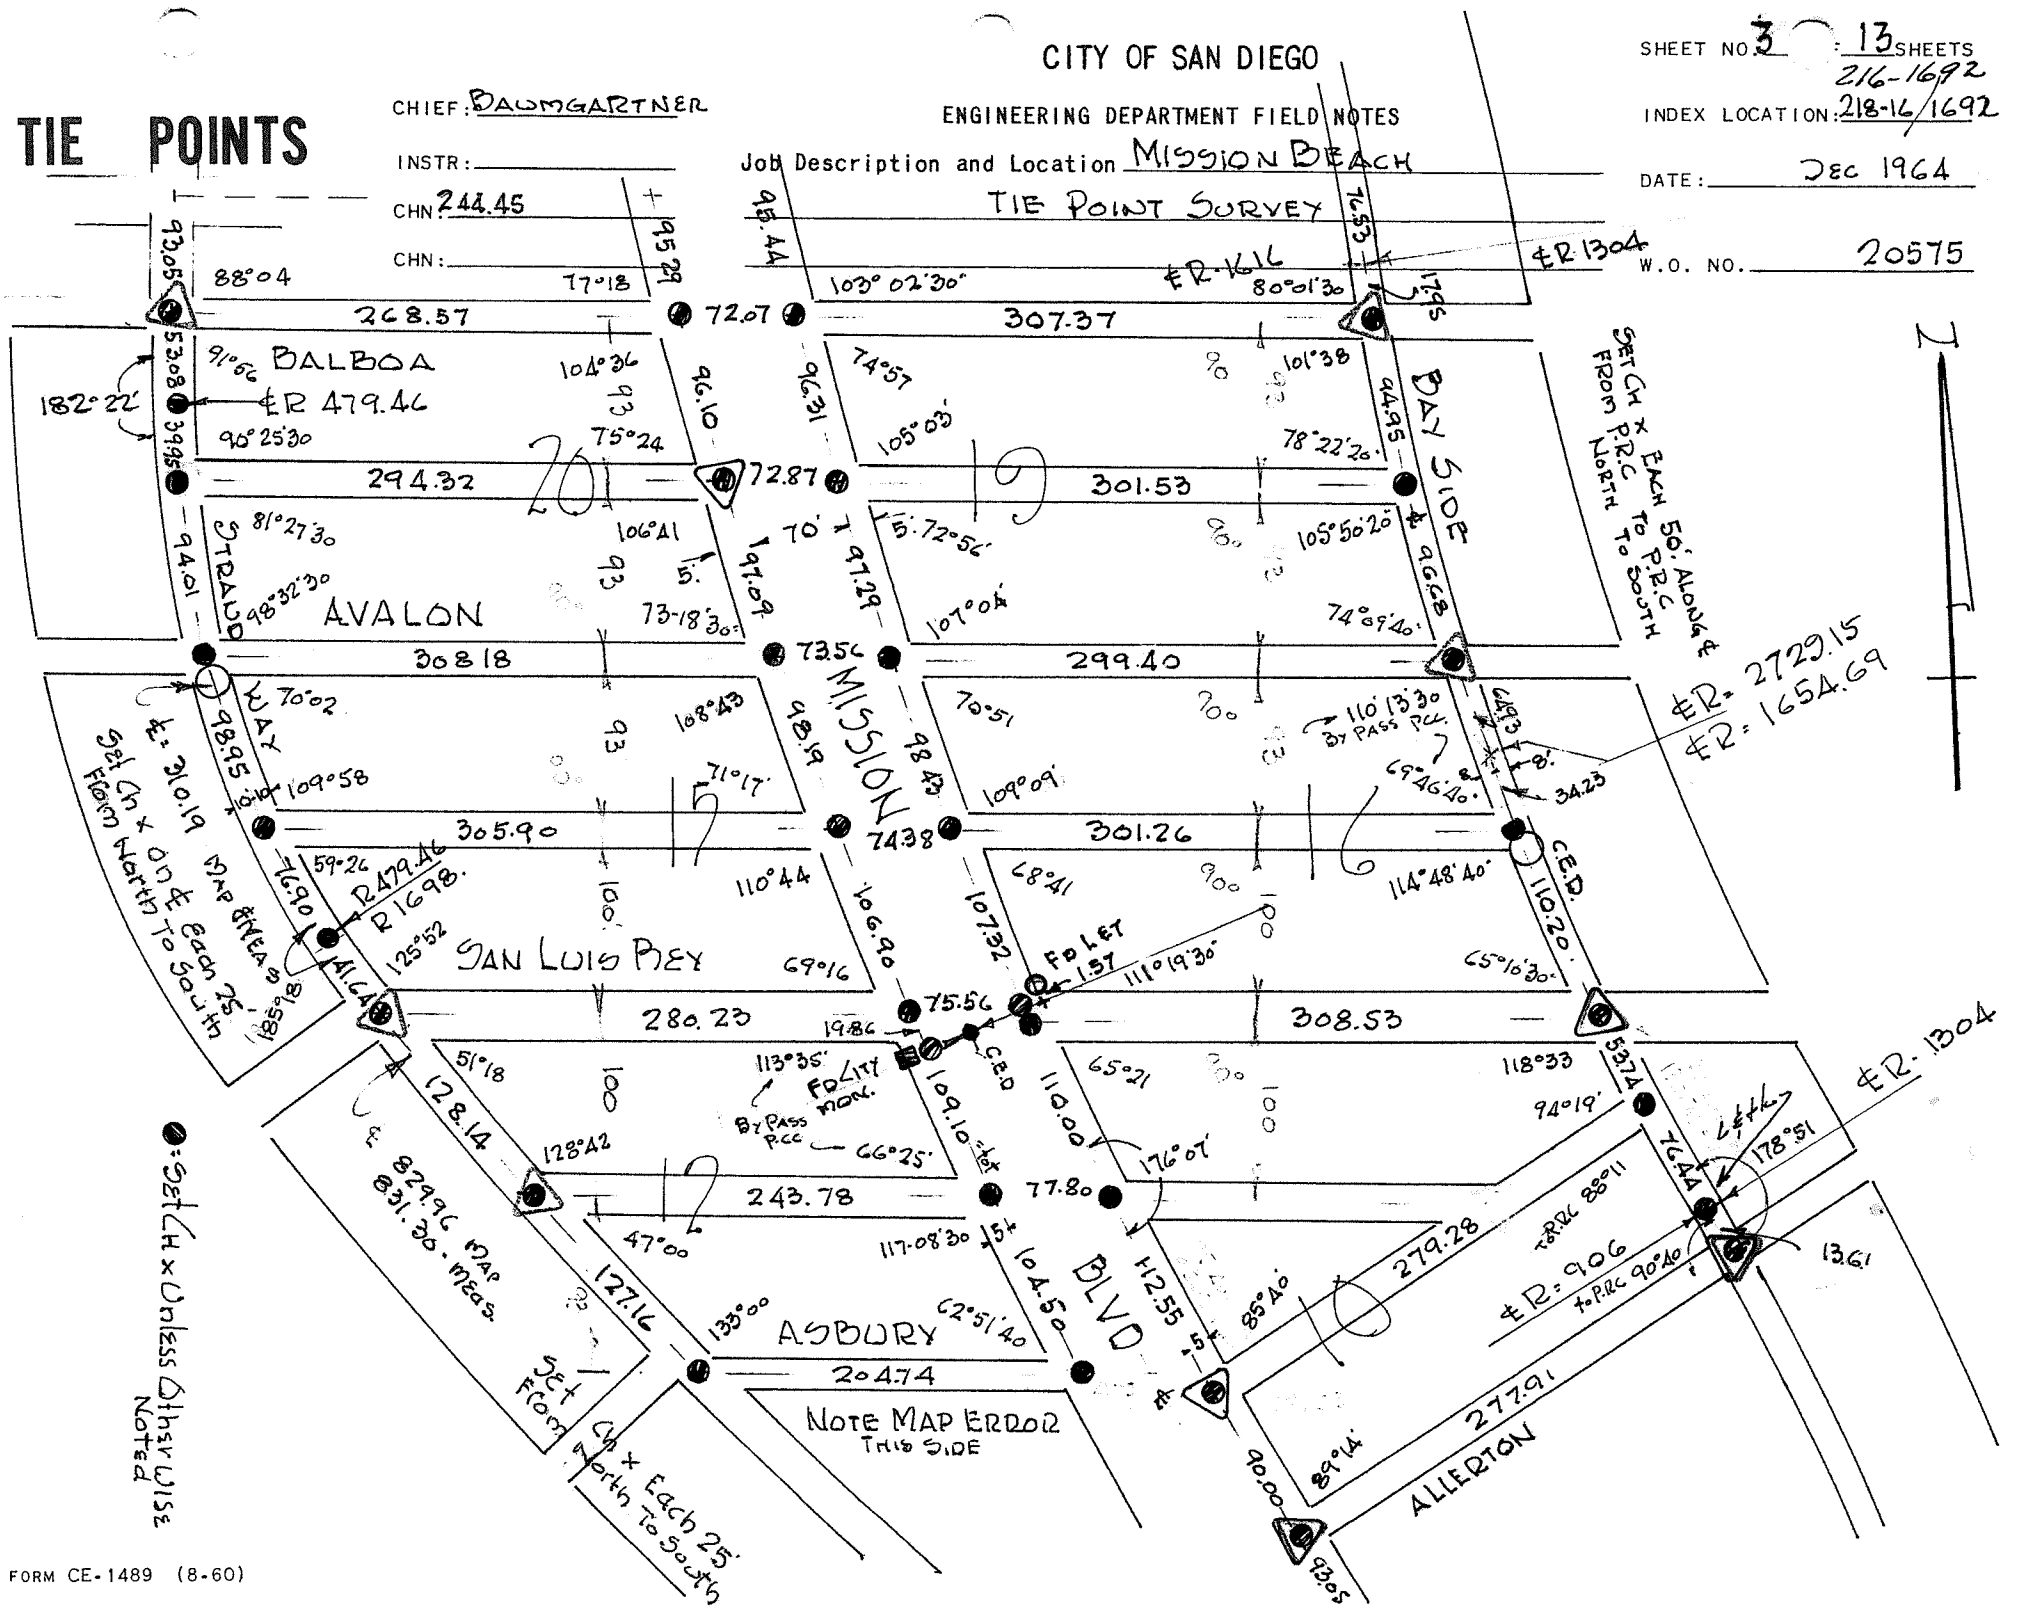

FORM CE-1489 (8-60)

TIE POINTS

CITY OF SAN DIEGO

ENGINEERING DEPARTMENT FIELD NOTES

SHEET NO. 4 13 SHEETS

216-1692

CHIEF Bacmgartner

INSTR:

CHN:

CHN:

Job Description and Location MISSION BEACH TIE POINT

INDEX LOCATION: 216-18/1697

DATE: DEC 1964

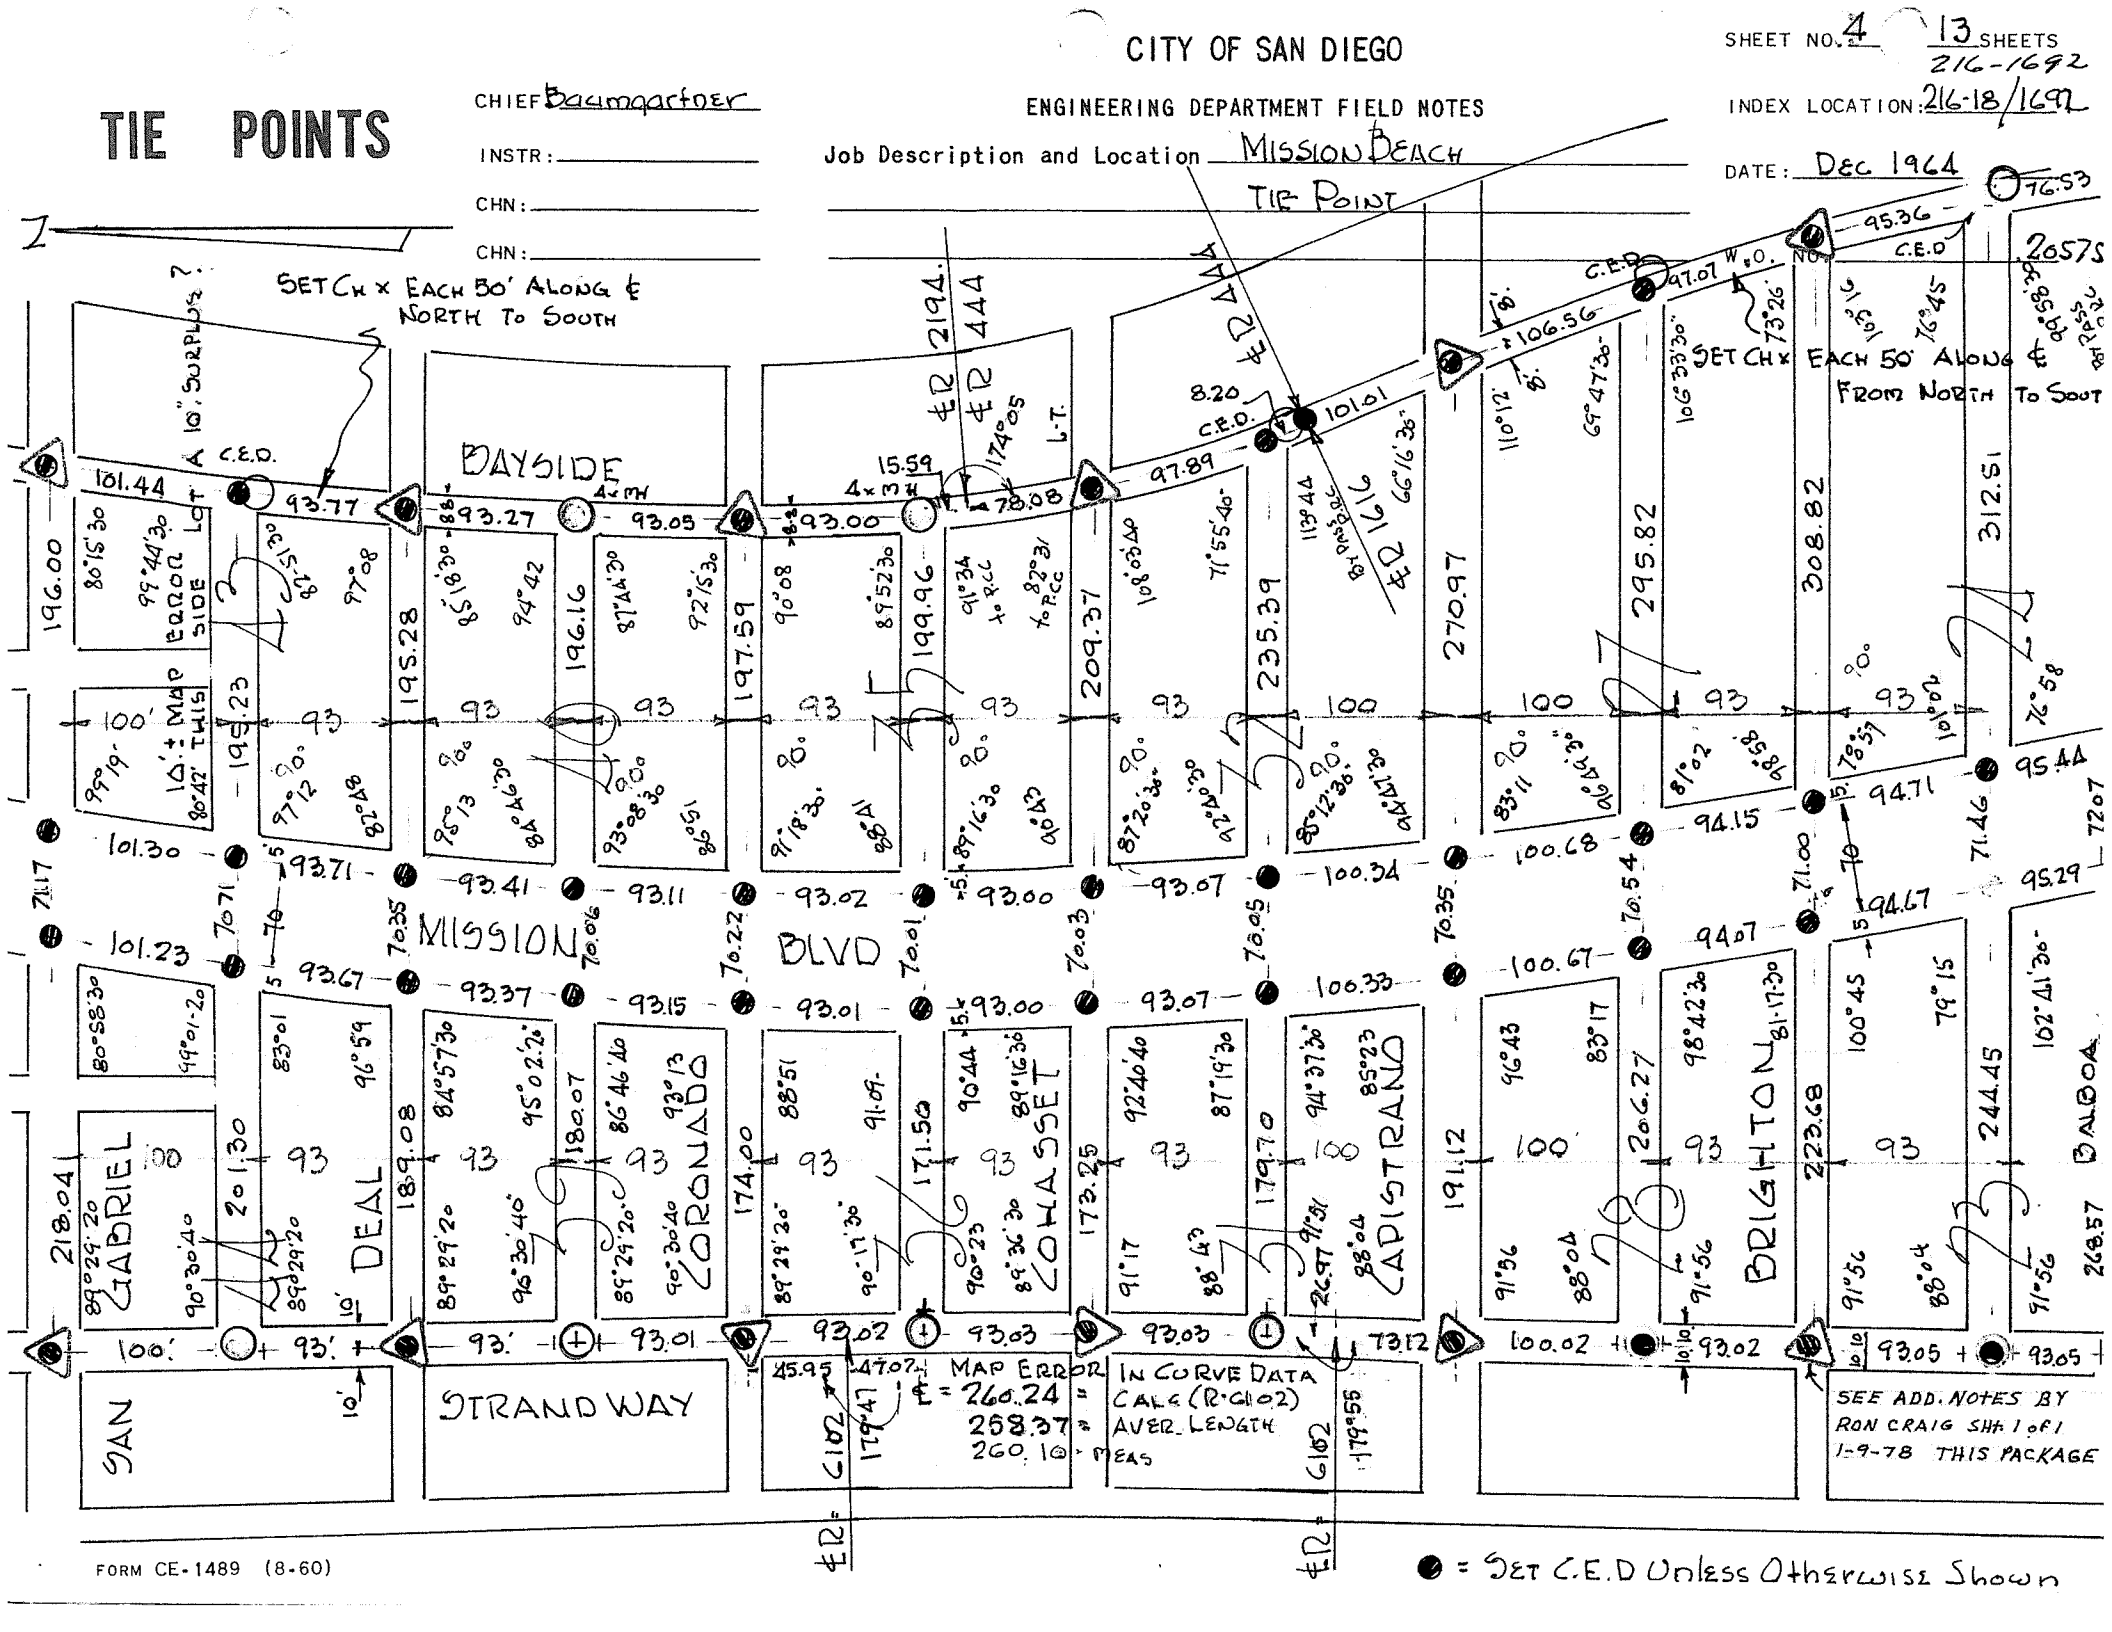

FORM CE-1489 (8-60)

● = SET C.E.D UNLESS OTHERWISE SHOWN

TIE POINTS

CITY OF SAN DIEGO

ENGINEERING DEPARTMENT FIELD NOTES

SHEET NO. 5 : 13 SHEETS

INDEX LOCATION 216-18/1692

DATE: DEC 1964

Location MISSION BEACH 4×3H

W.O. NO. 20575

SET CH x EACH 50' ALONG ℄ FROM P.R.C SOUTH TO P.C.C

CHIEF: BAUTAGARTNER

INSTR: GADDY P.L.

CHN: MORALEZ

CHN:

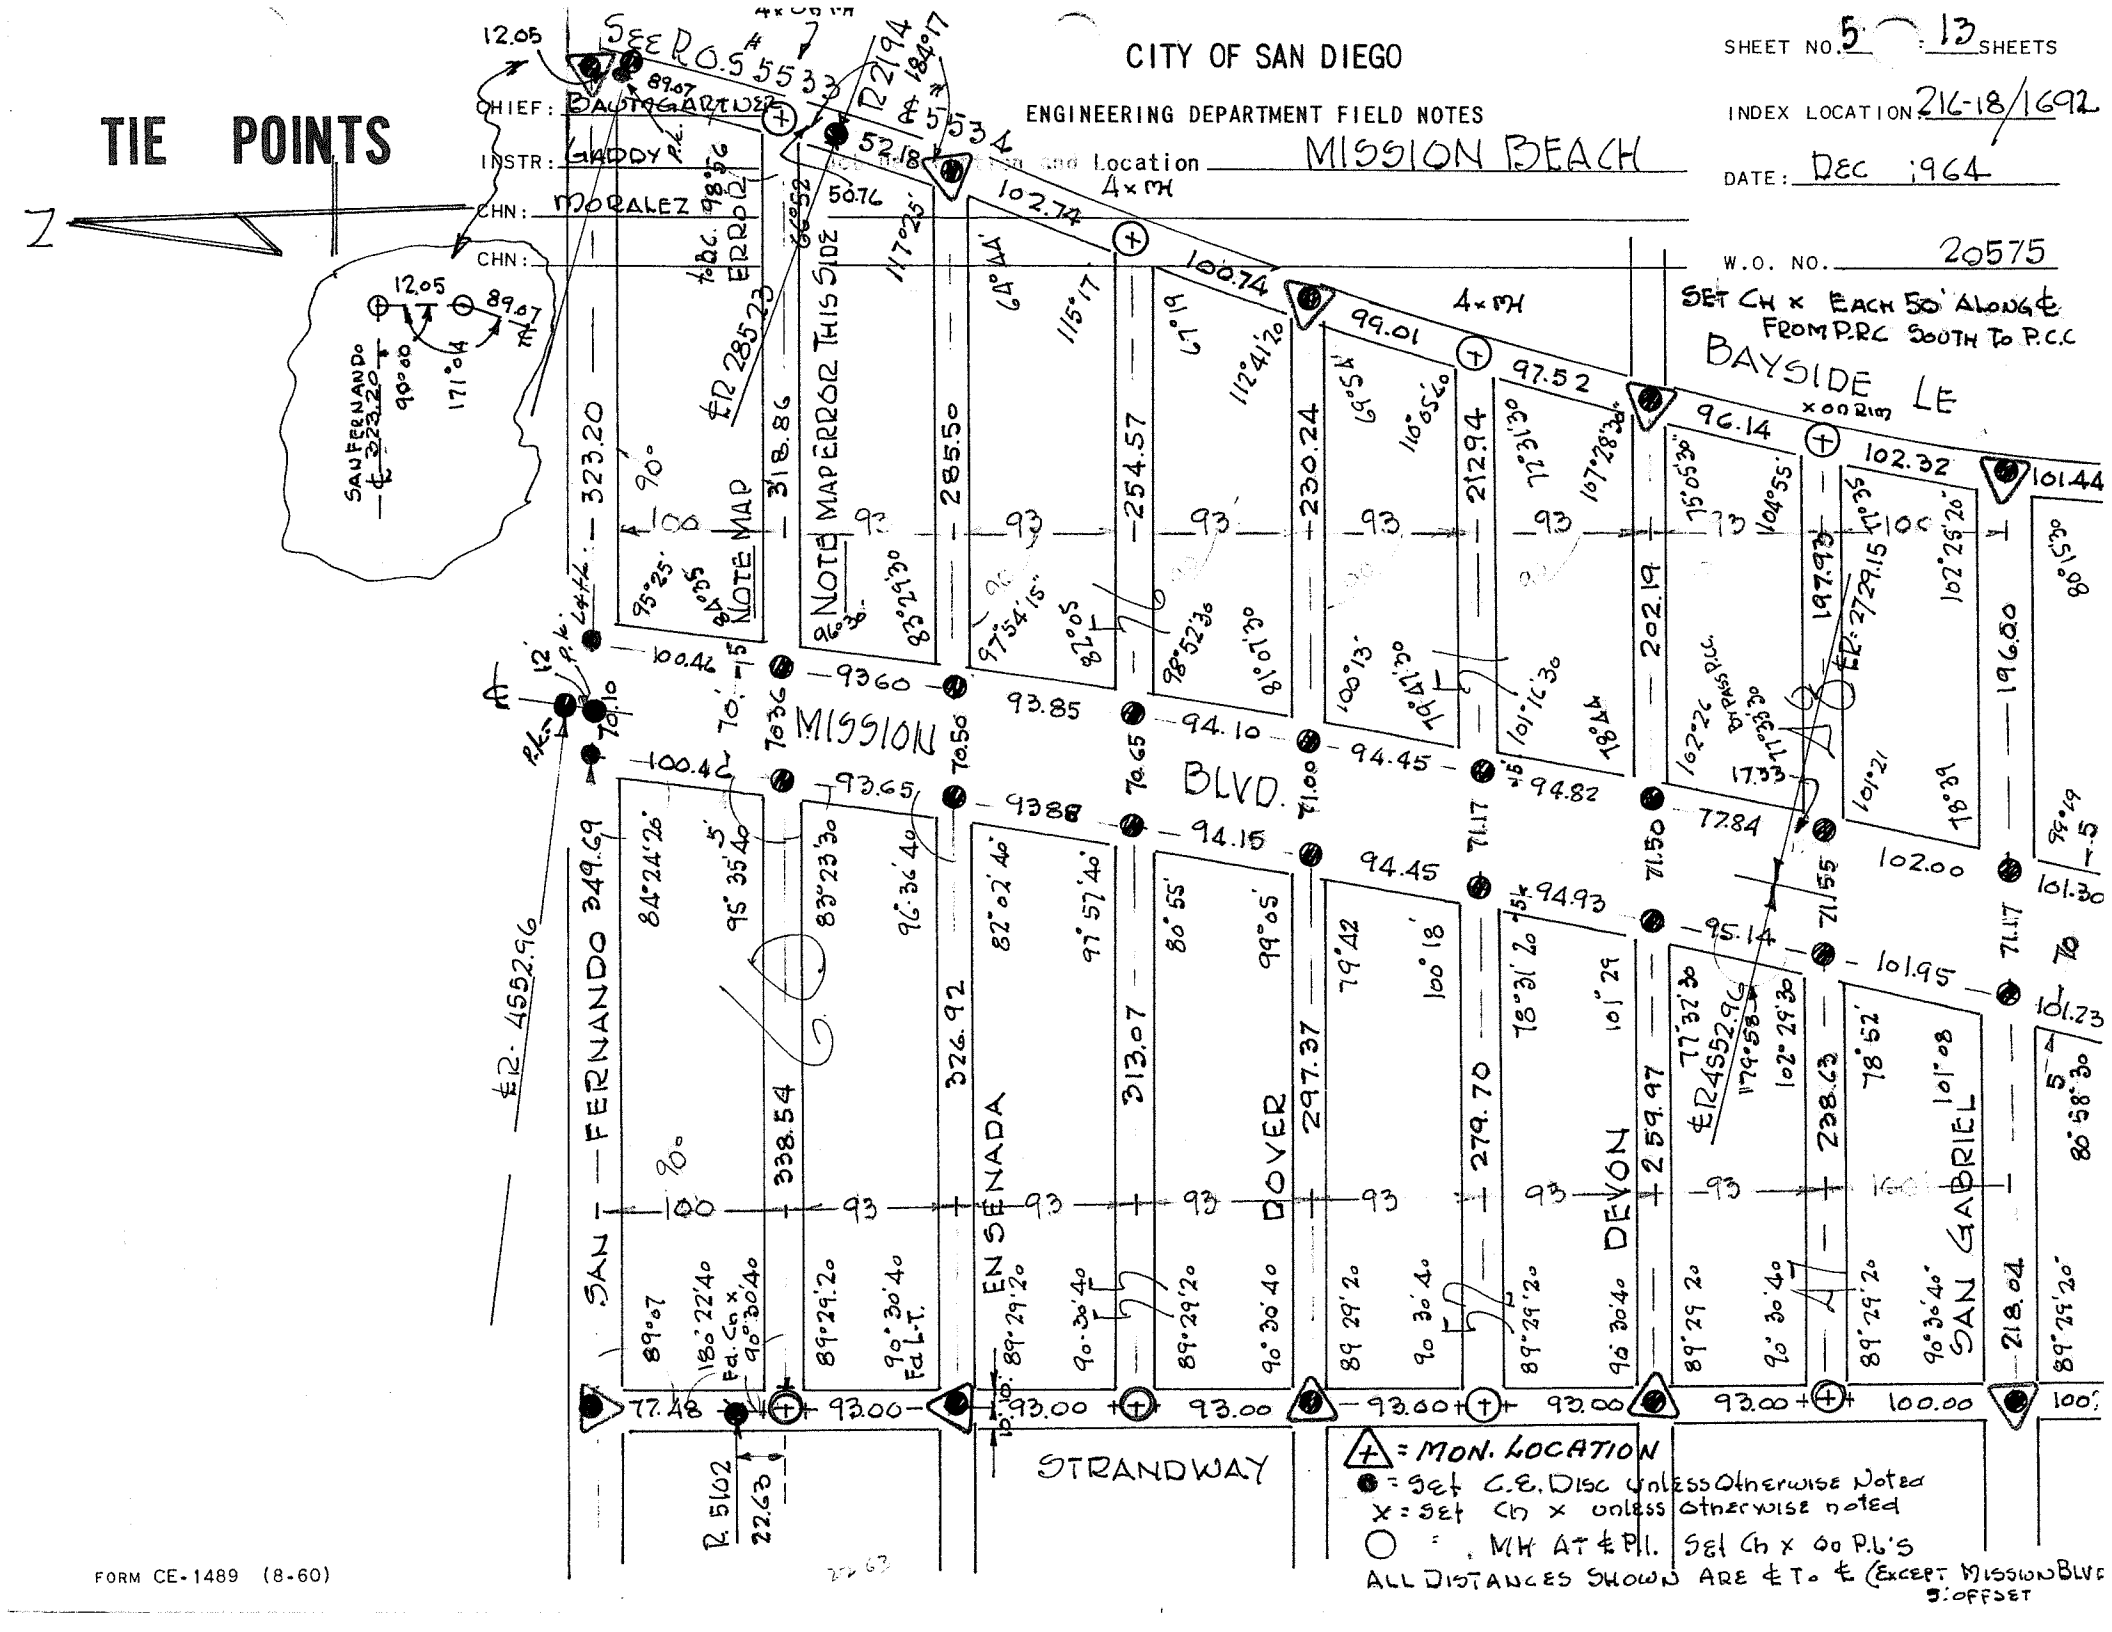
SEE R.O.S. 5553
R 2194
ER 28523
ER 27915
ER 24552.96
ER 4552.96
NOTE MAP ERROR THIS SIDE
NOTE MAP
BAYSIDE LE
MISSION BLVD.
SAN FERNANDO
ENSENADA
DOVER
DEVON
SAN GABRIEL
STRANDWAY
SAN FERNANDO
12.05
89.07
171°04
90°00
323.20
318.86
285.50
254.57
230.24
212.94
202.19
196.80
102.32
101.44
100.46
93.60
93.85
94.10
94.45
94.82
93.65
93.88
94.15
94.45
94.93
95.14
101.95
101.23
338.54
326.92
313.07
297.37
279.70
259.97
238.63
218.04
93.00
100.00
77.48
22.63
R 5102
349.69
4552.96
102.74
100.74
99.01
97.52
96.14
50.76
52.18
117°25'
64°44'
115°17'
67°19'
112°41'20
69°54'
110°05'40
77°31'30
107°28'30
75°05'30
104°05'55"
102°25'20"
80°51'30
99°59
80°58'30
84°24'26"
95°35'40"
83°23'30
96°36'40
82°02'40
97°57'40
80°55'
99°05'
79°42
100°18'
78°31'20
101°29'
77°32'30
102°29'30
78°52'
101°08
89°07
180°22'40
Fd. Cn x
90°30'40
89°29'20
90°30'40
Fd L.T.
89°29'20
90°30'40
89°29'20
90°30'40
89°29'20
90°30'40

TIE POINTS

CITY OF SAN DIEGO

ENGINEERING DEPARTMENT FIELD NOTES

B15-16

SHEET NO. 6 13 SHEETS

INDEX LOCATION 216-1692 ~~222-26~~ 1692

CHIEF: Baumgartner

INSTR: Gaddy

CHN: Moralez

CHN: Orlando

Job Description and Location: MISSION BEACH

TIE POINT SURVEY

DATE: FEB 1965

W.O. NO. 20575

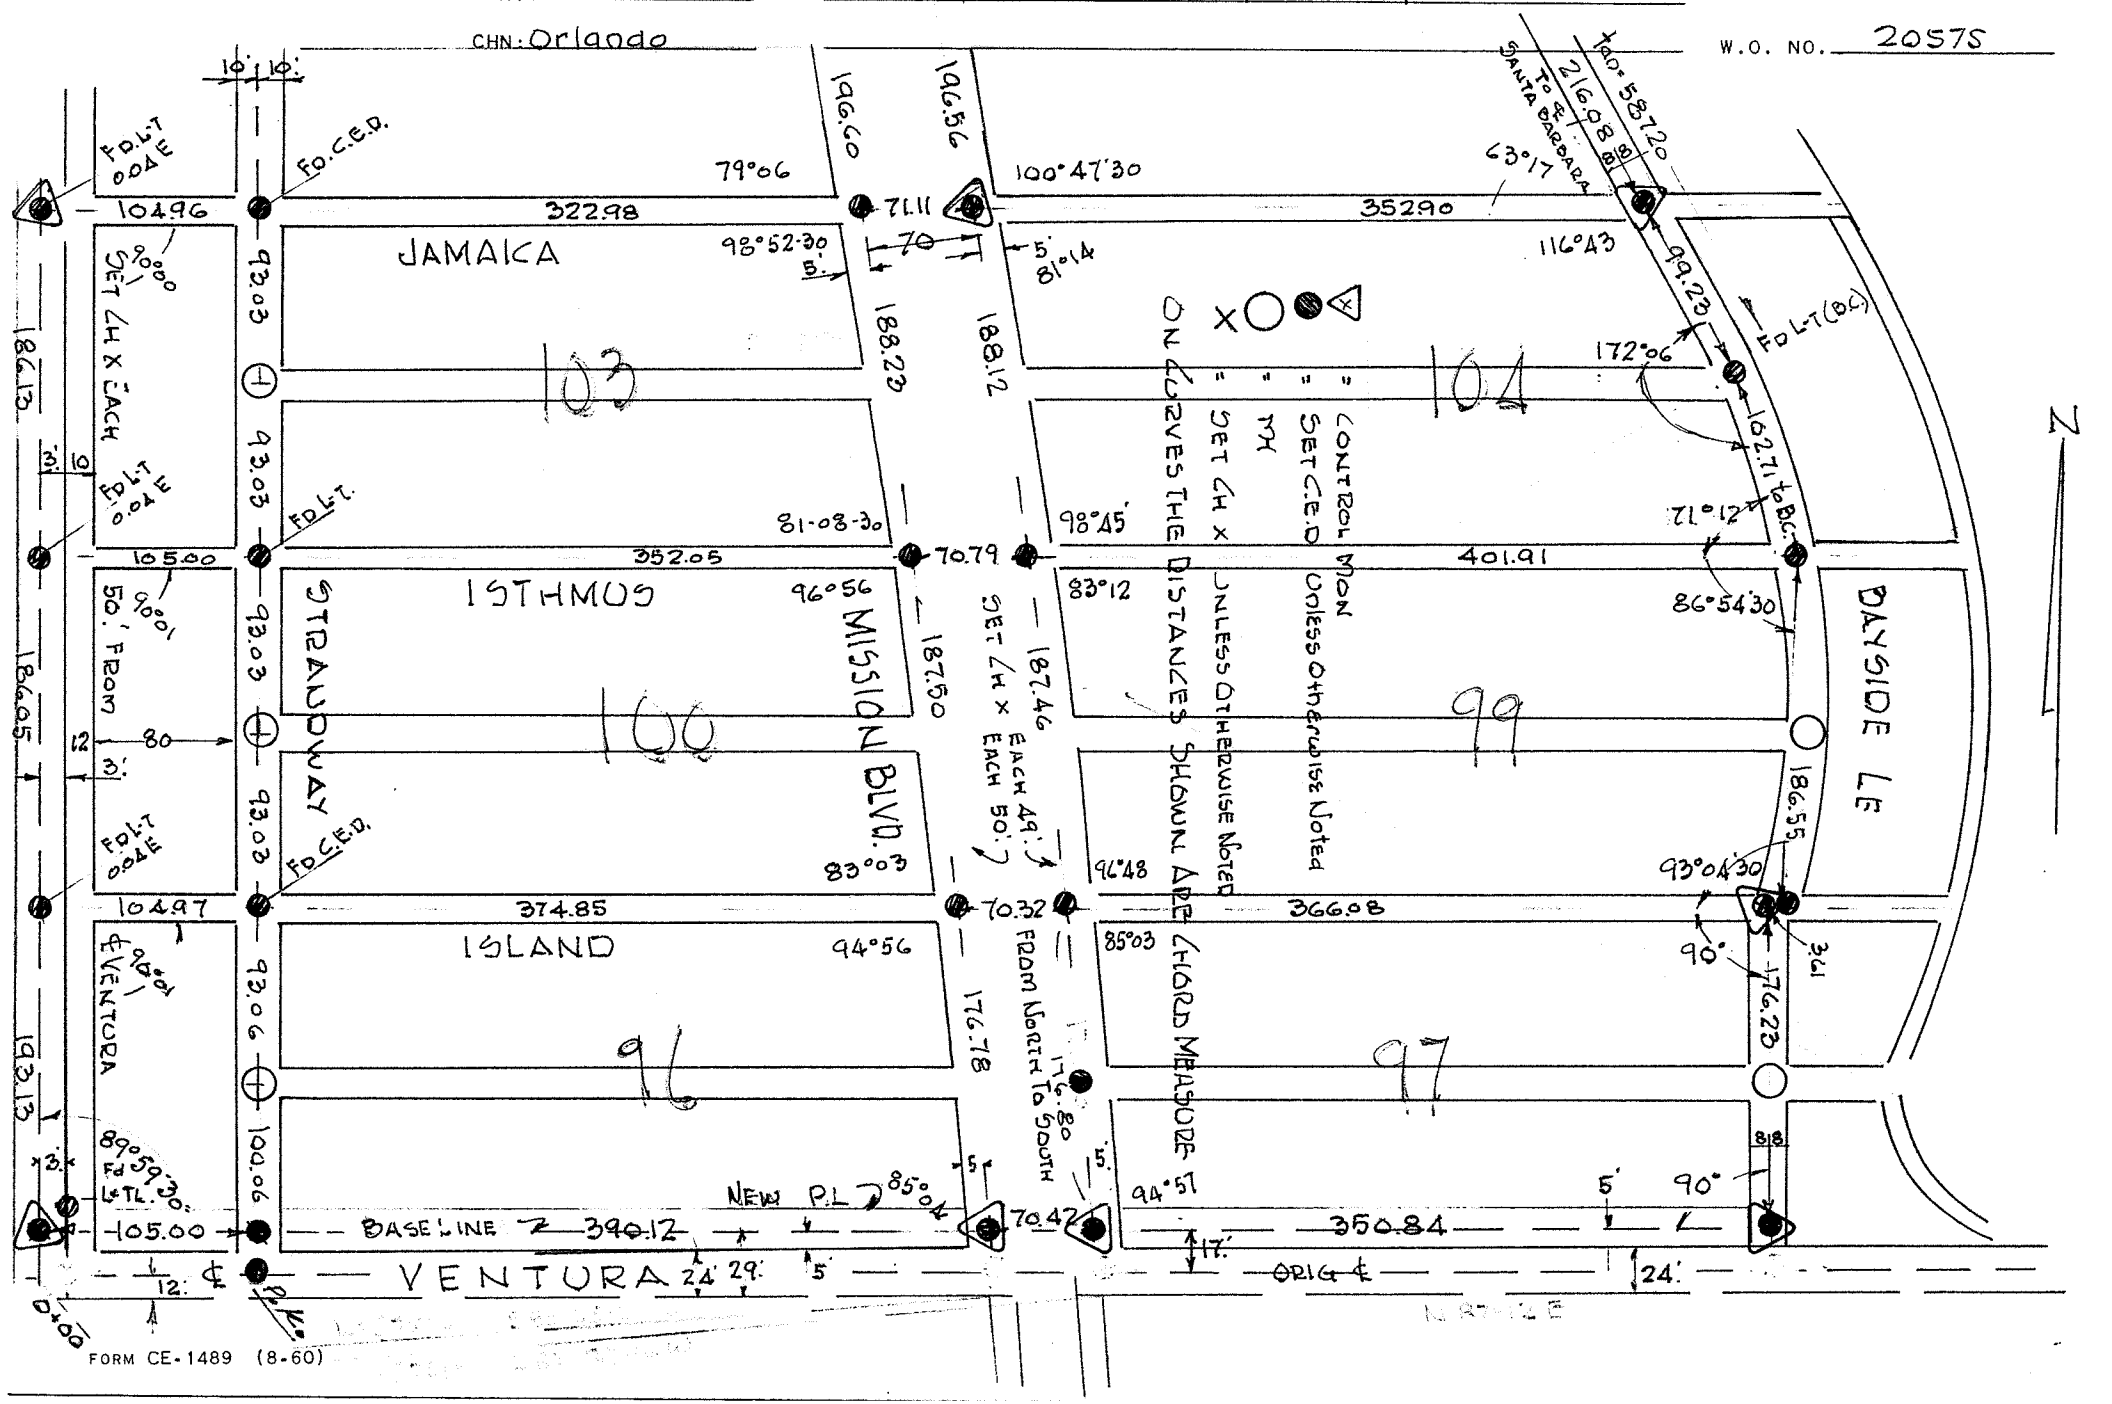

FORM CE-1489 (8-60)

TIE POINTS

CITY OF SAN DIEGO

ENGINEERING DEPARTMENT FIELD NOTES

CHIEF: Baumgartner

INSTR:

Job Description and Location: MISSION BEACH

DATE:

W.O. NO. 20575

SHEET NO. 7 13 SHEETS

INDEX LOCATION: 216 1692

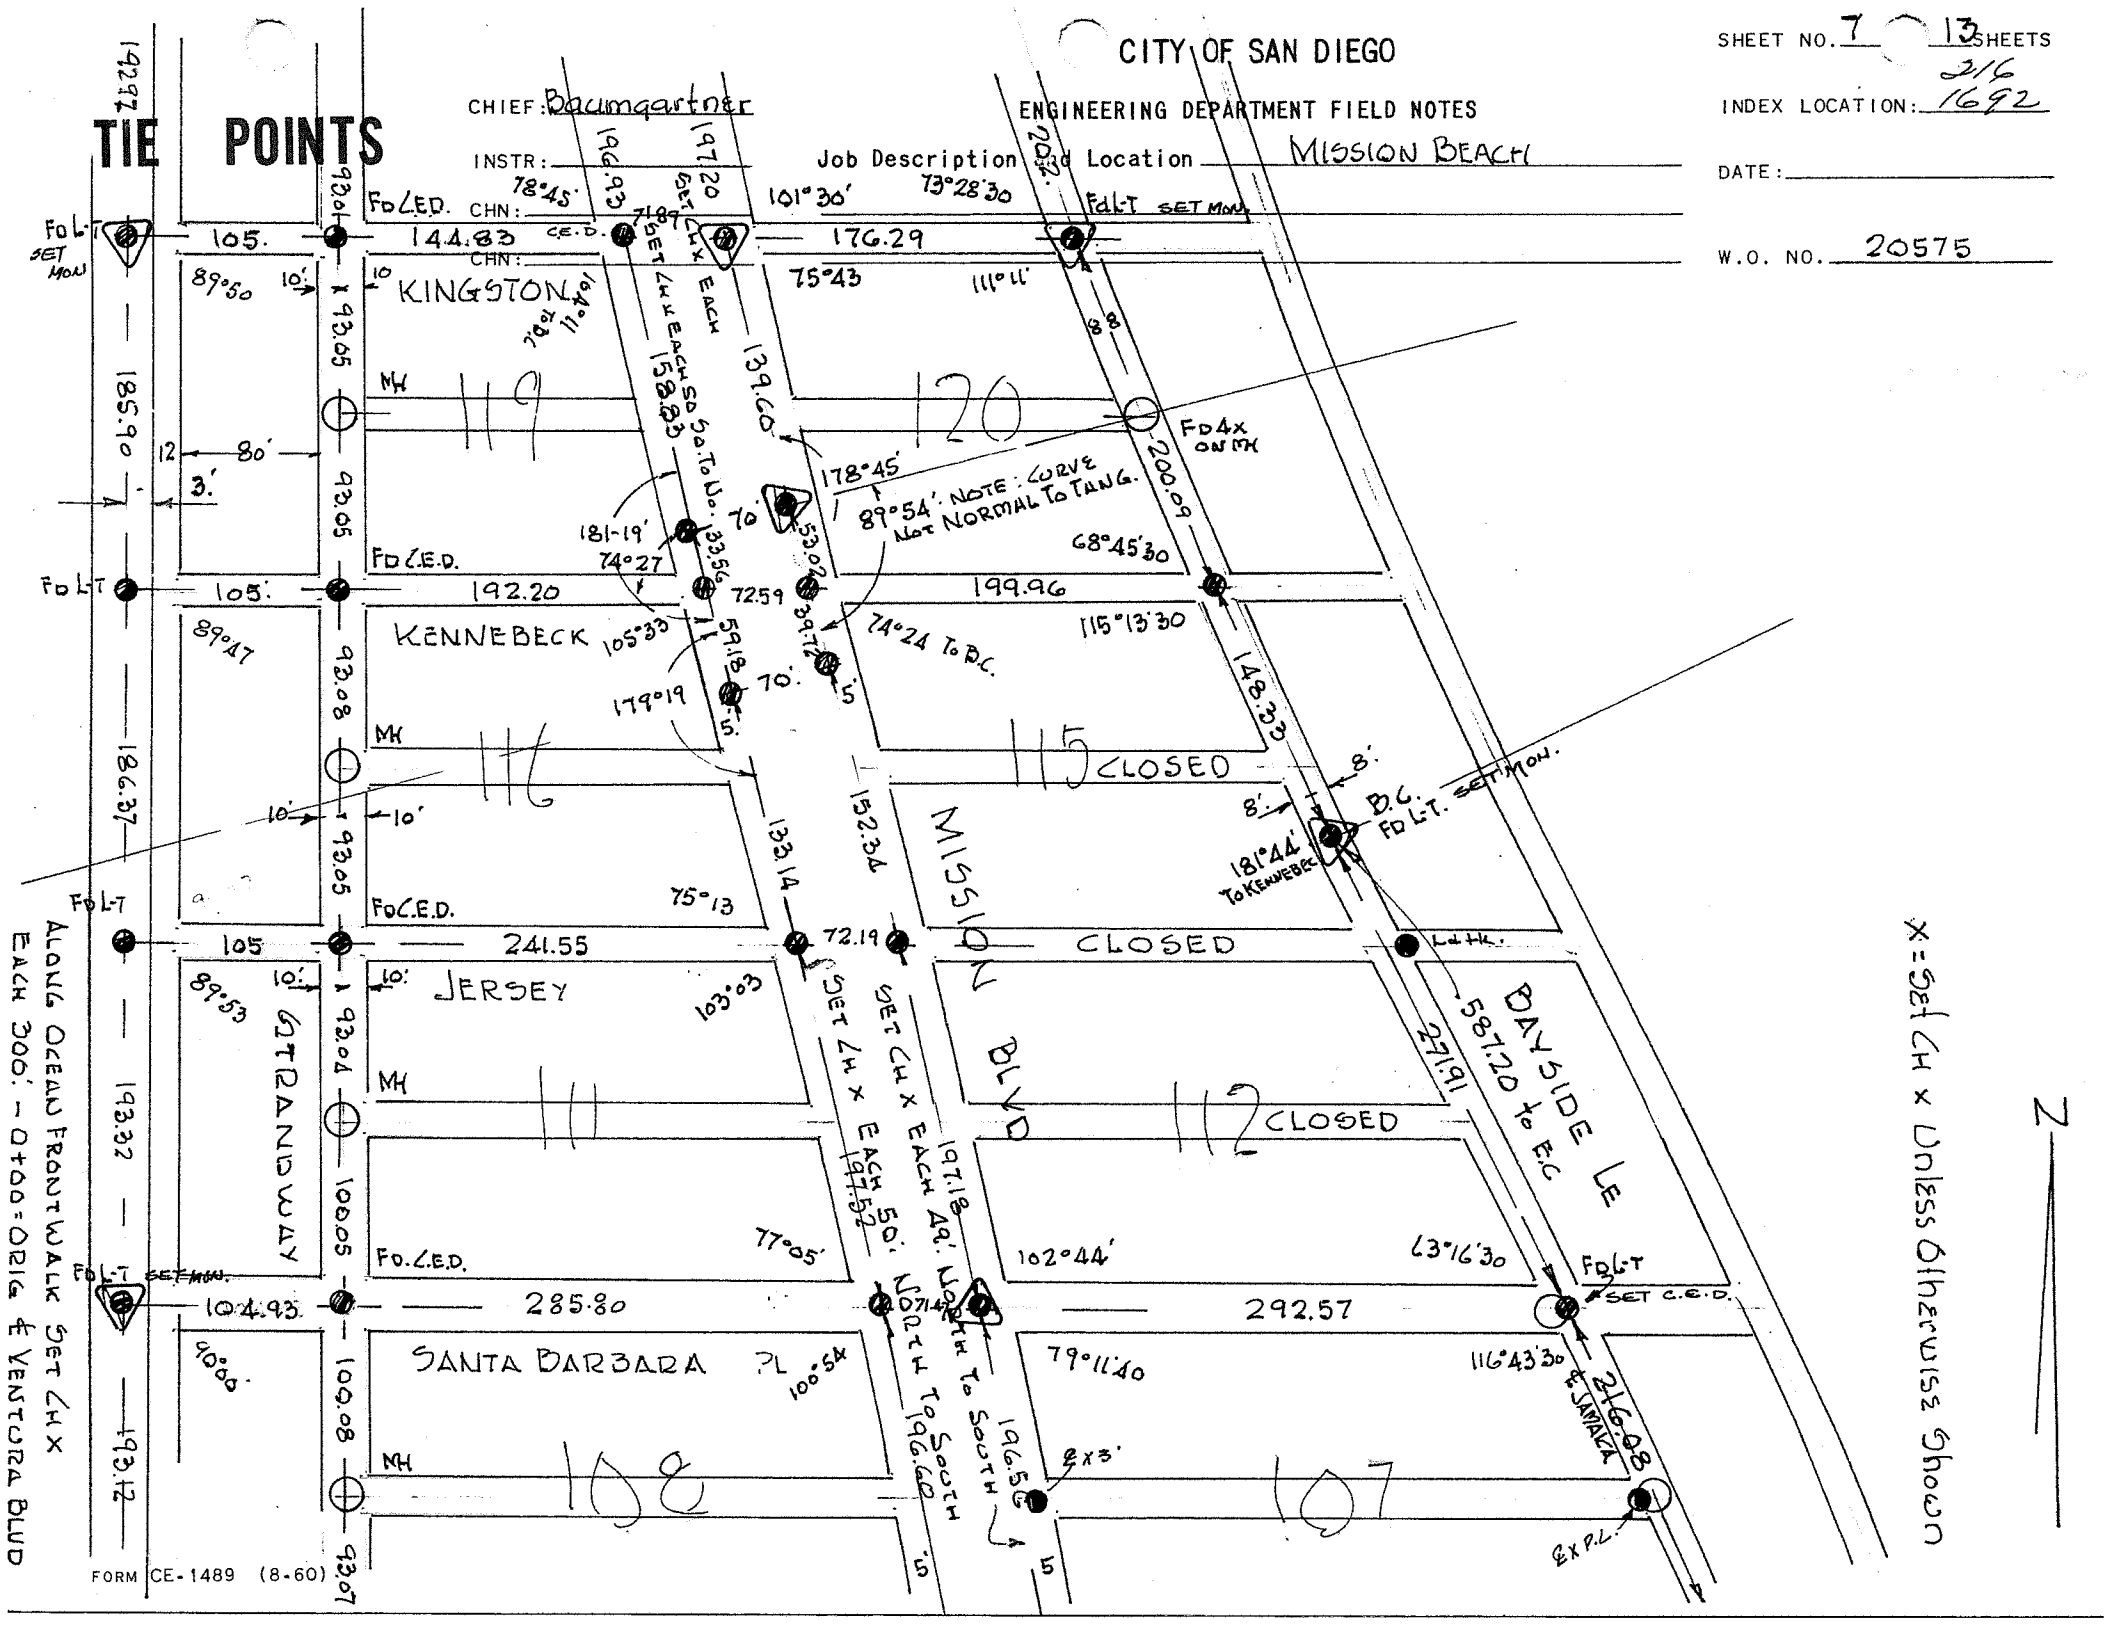

FORM CE-1489 (8-60)

CITY OF SAN DIEGO

ENGINEERING DEPARTMENT FIELD NOTES

SHEET NO. 8 13 SHEETS 216

INDEX LOCATION: 1692

CHIEF: Baumgartner

INSTR

CHN:

CHN:

Job Description and Location MISSION BEACH

DATE: FEB 1965

W.O. NO. 20575

X = Set Ch X Unless Otherwise Noted

TIE POINTS

SEE OPENINGS & CLOSINGS BAYSIDE LE SANTA CLARA TO TANGIERS

Distances On Curves Are Chord Measure

ALLEY 144

BAYSIDE LE

MISSION BLVD.

STRANDWAY

MONTEREY

EL CARMEL

MANHATTAN

LIVERPOOL

LIDO

VENICE

LUIS-101

SAN

FORM CE-1489 (8-60)

TIE POINTS

CITY OF SAN DIEGO

ENGINEERING DEPARTMENT FIELD NOTES

CHIEF: Baumgartner

INSTR: Gaddy

CHN: Moralez

CHN:

Job Description and Location: MISSION BEACH

TIE POINT EL CARMEL to NAHANT

SHEET NO. B-15 OF 2/6-1692 SHEETS

INDEX LOCATION: ~~222-1496~~

DATE: Jan. 1964

~~624~~ 1692

W.O. NO. 20575

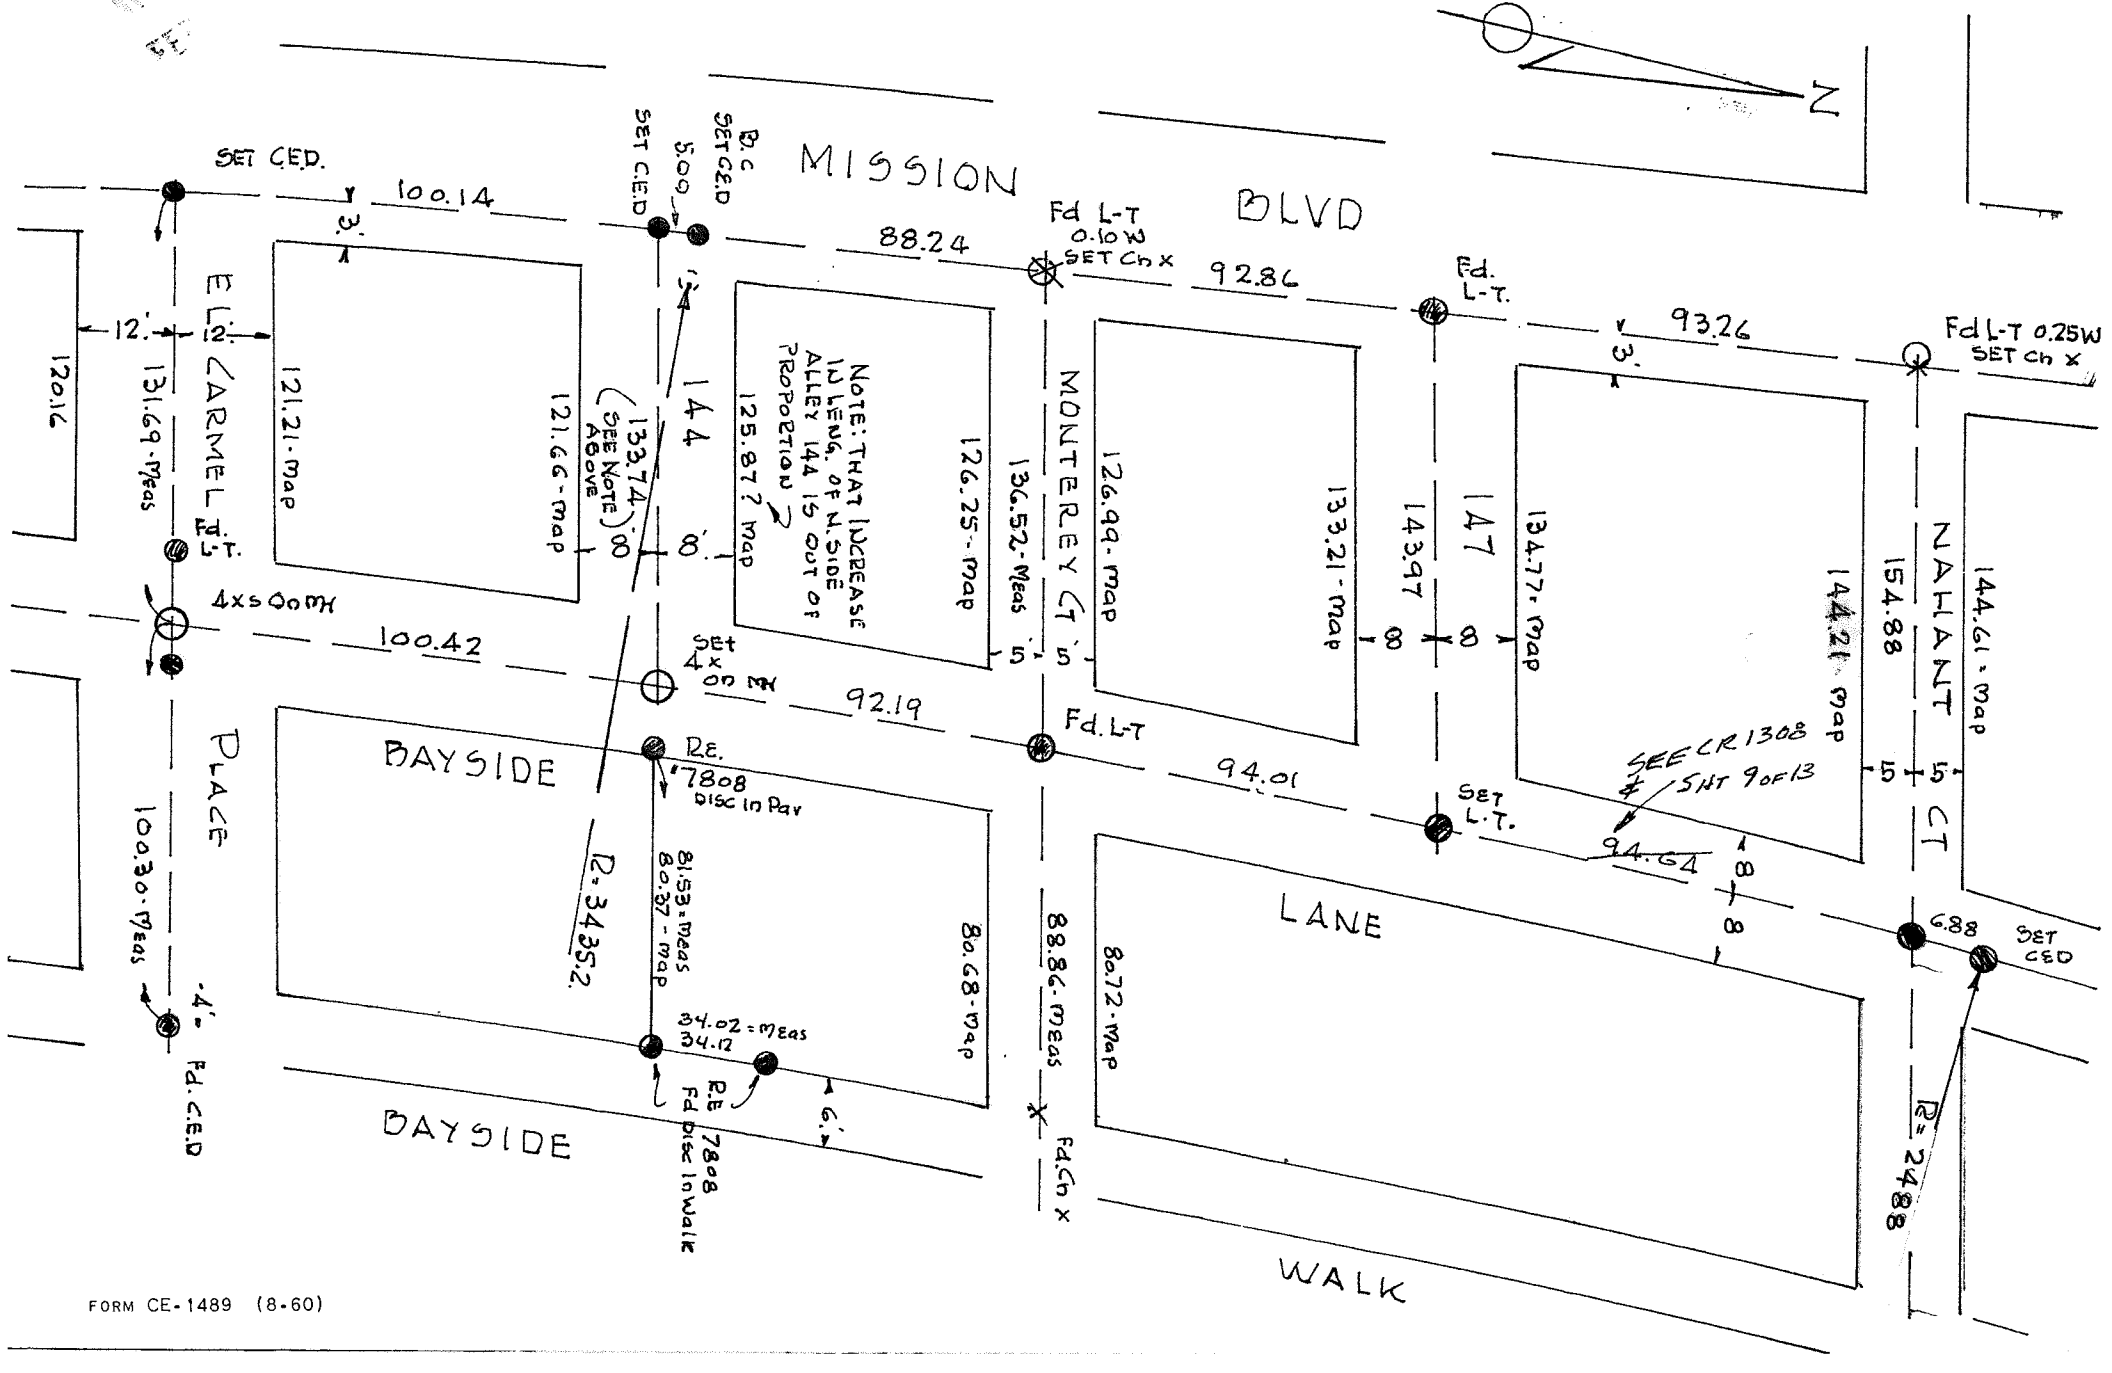

FORM CE-1489 (8-60)

TIE POINTS

CITY OF SAN DIEGO

ENGINEERING DEPARTMENT FIELD NOTES

SHEET NO. 9 13 SHEETS 216

INDEX LOCATION: 1692

CHIEF Baumgartner

INSTR: _____

CHN: _____

CHN: _____

Job Description and Location MISSION BEACH

DATE: MAY 1965

W.O. NO. 20575

● = SET L.E.D UNLESS OTHERWISE NOTED

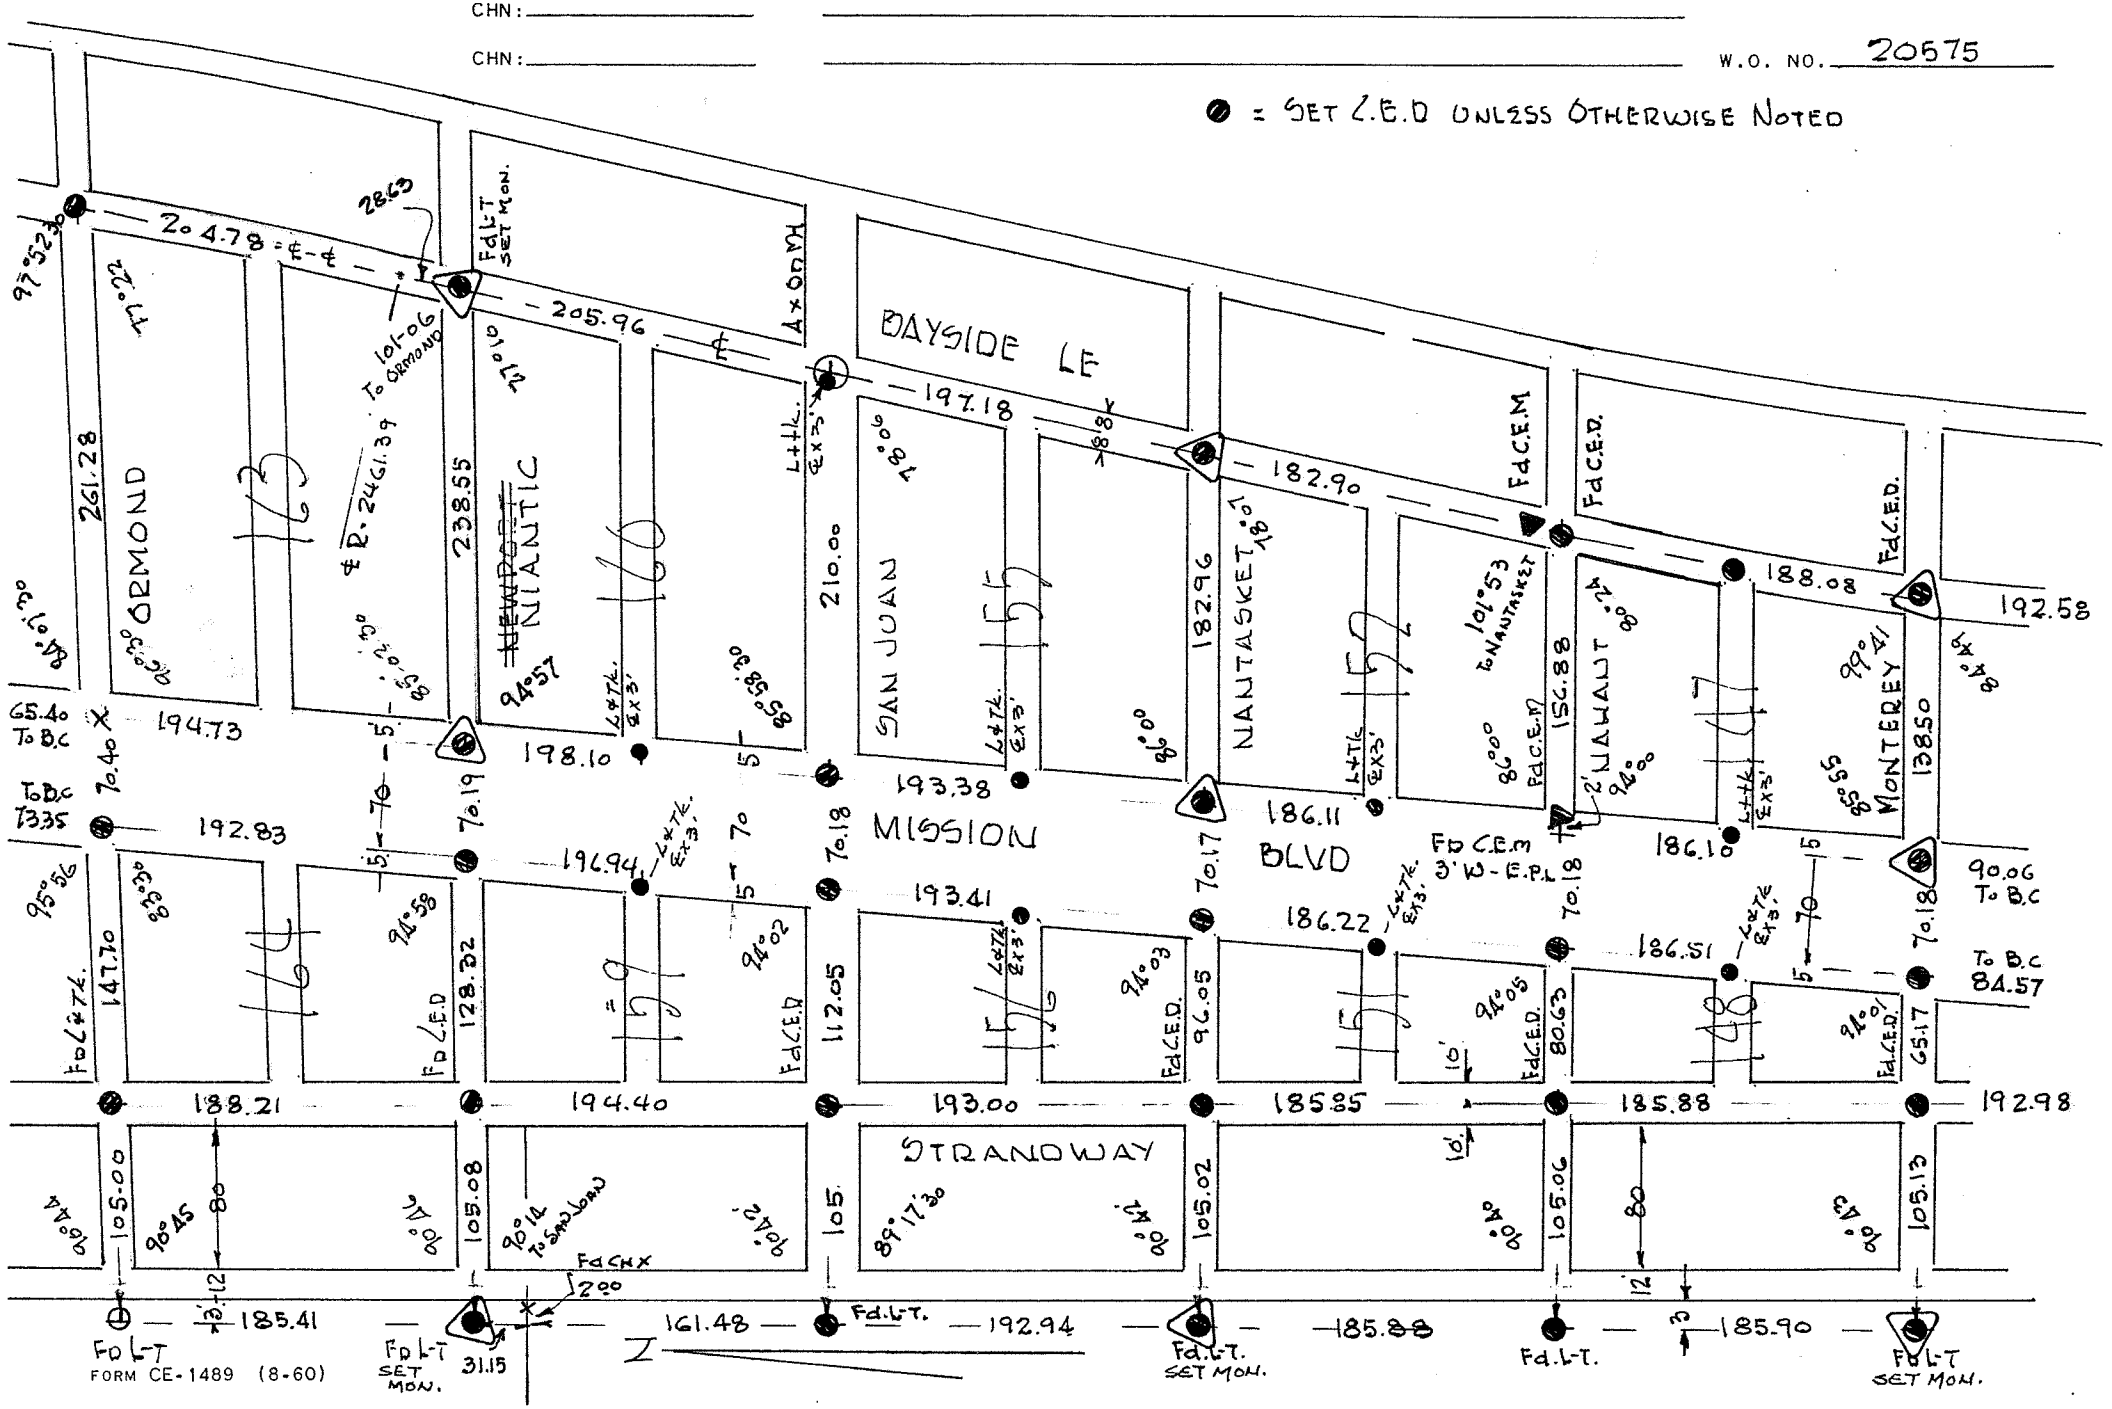

TIE POINTS

CITY OF SAN DIEGO

ENGINEERING DEPARTMENT FIELD NOTES

CHIEF: Baumgartner

INSTR: _____

Job Description and Location MISSION BEACH

CHN: _____

CHN: _____

SHEET NO. 10 13 SHEETS

J16

INDEX LOCATION: 1692

DATE: MAY 1965

W.O. NO. 20575

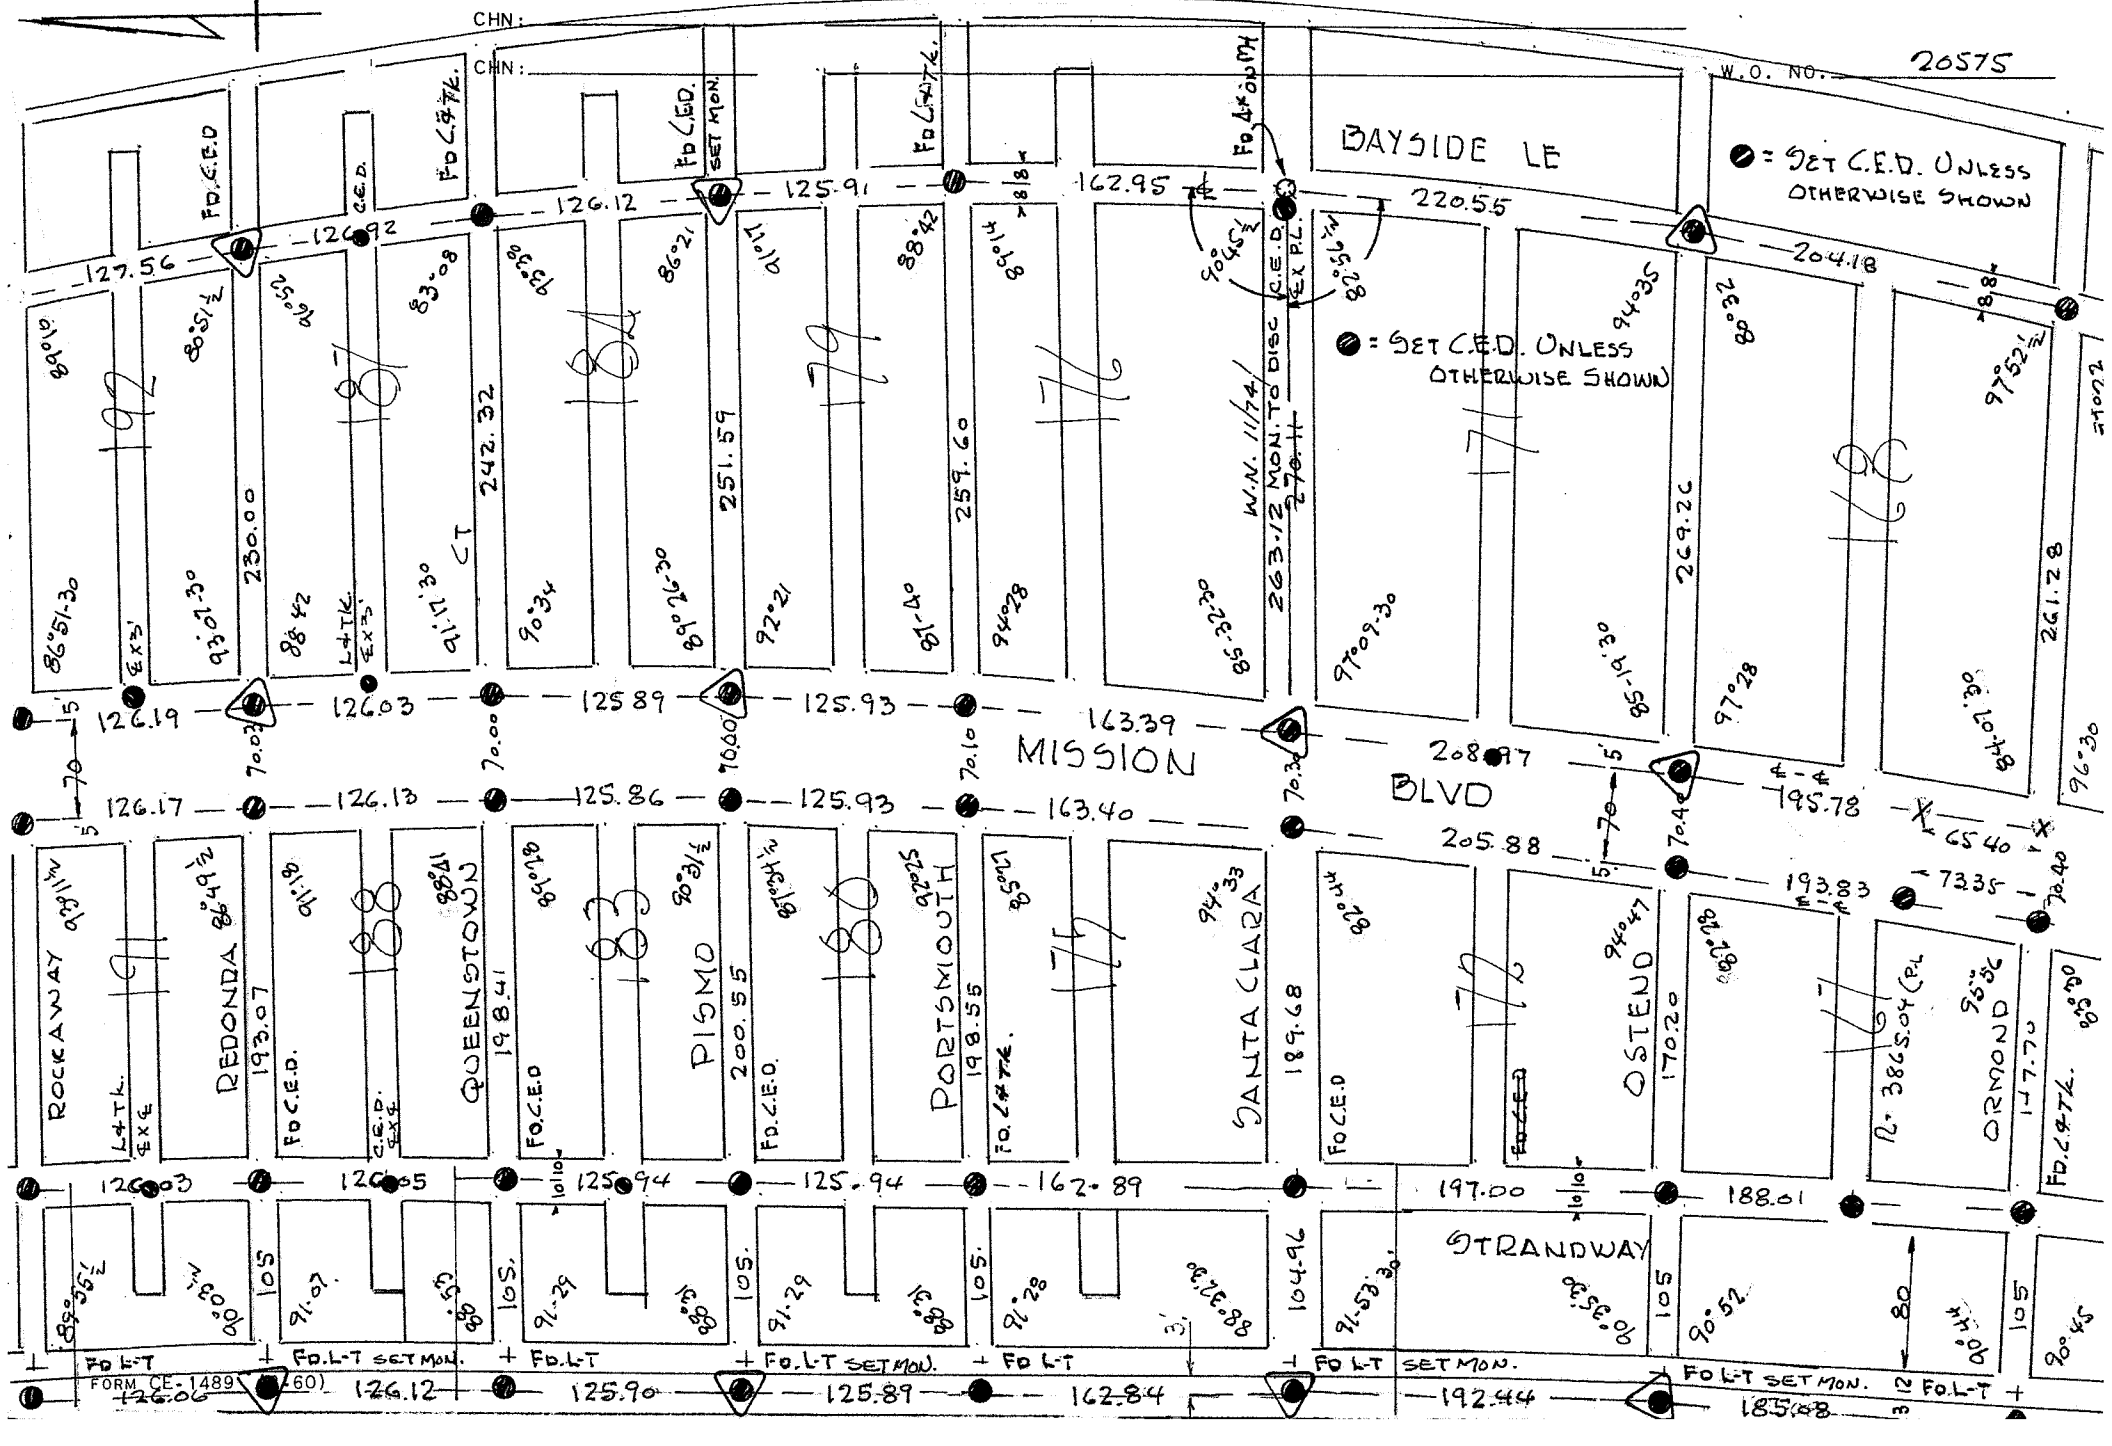

FORM CE-1489 (REV-60)

TIE POINTS

CITY OF SAN DIEGO

ENGINEERING DEPARTMENT FIELD NOTES

SHEET NO. 11 13 SHEETS

INDEX LOCATION: 1692

CHIEF Baumgartner

INSTR:

CHN:

CHN:

Job Description and Location MISSION BEACH

DATE:

W.O. NO. 20575

(SEE OPENING
SEE CLOSING BAYSIDE LE
ALLEY 177 TO ALLEY 211

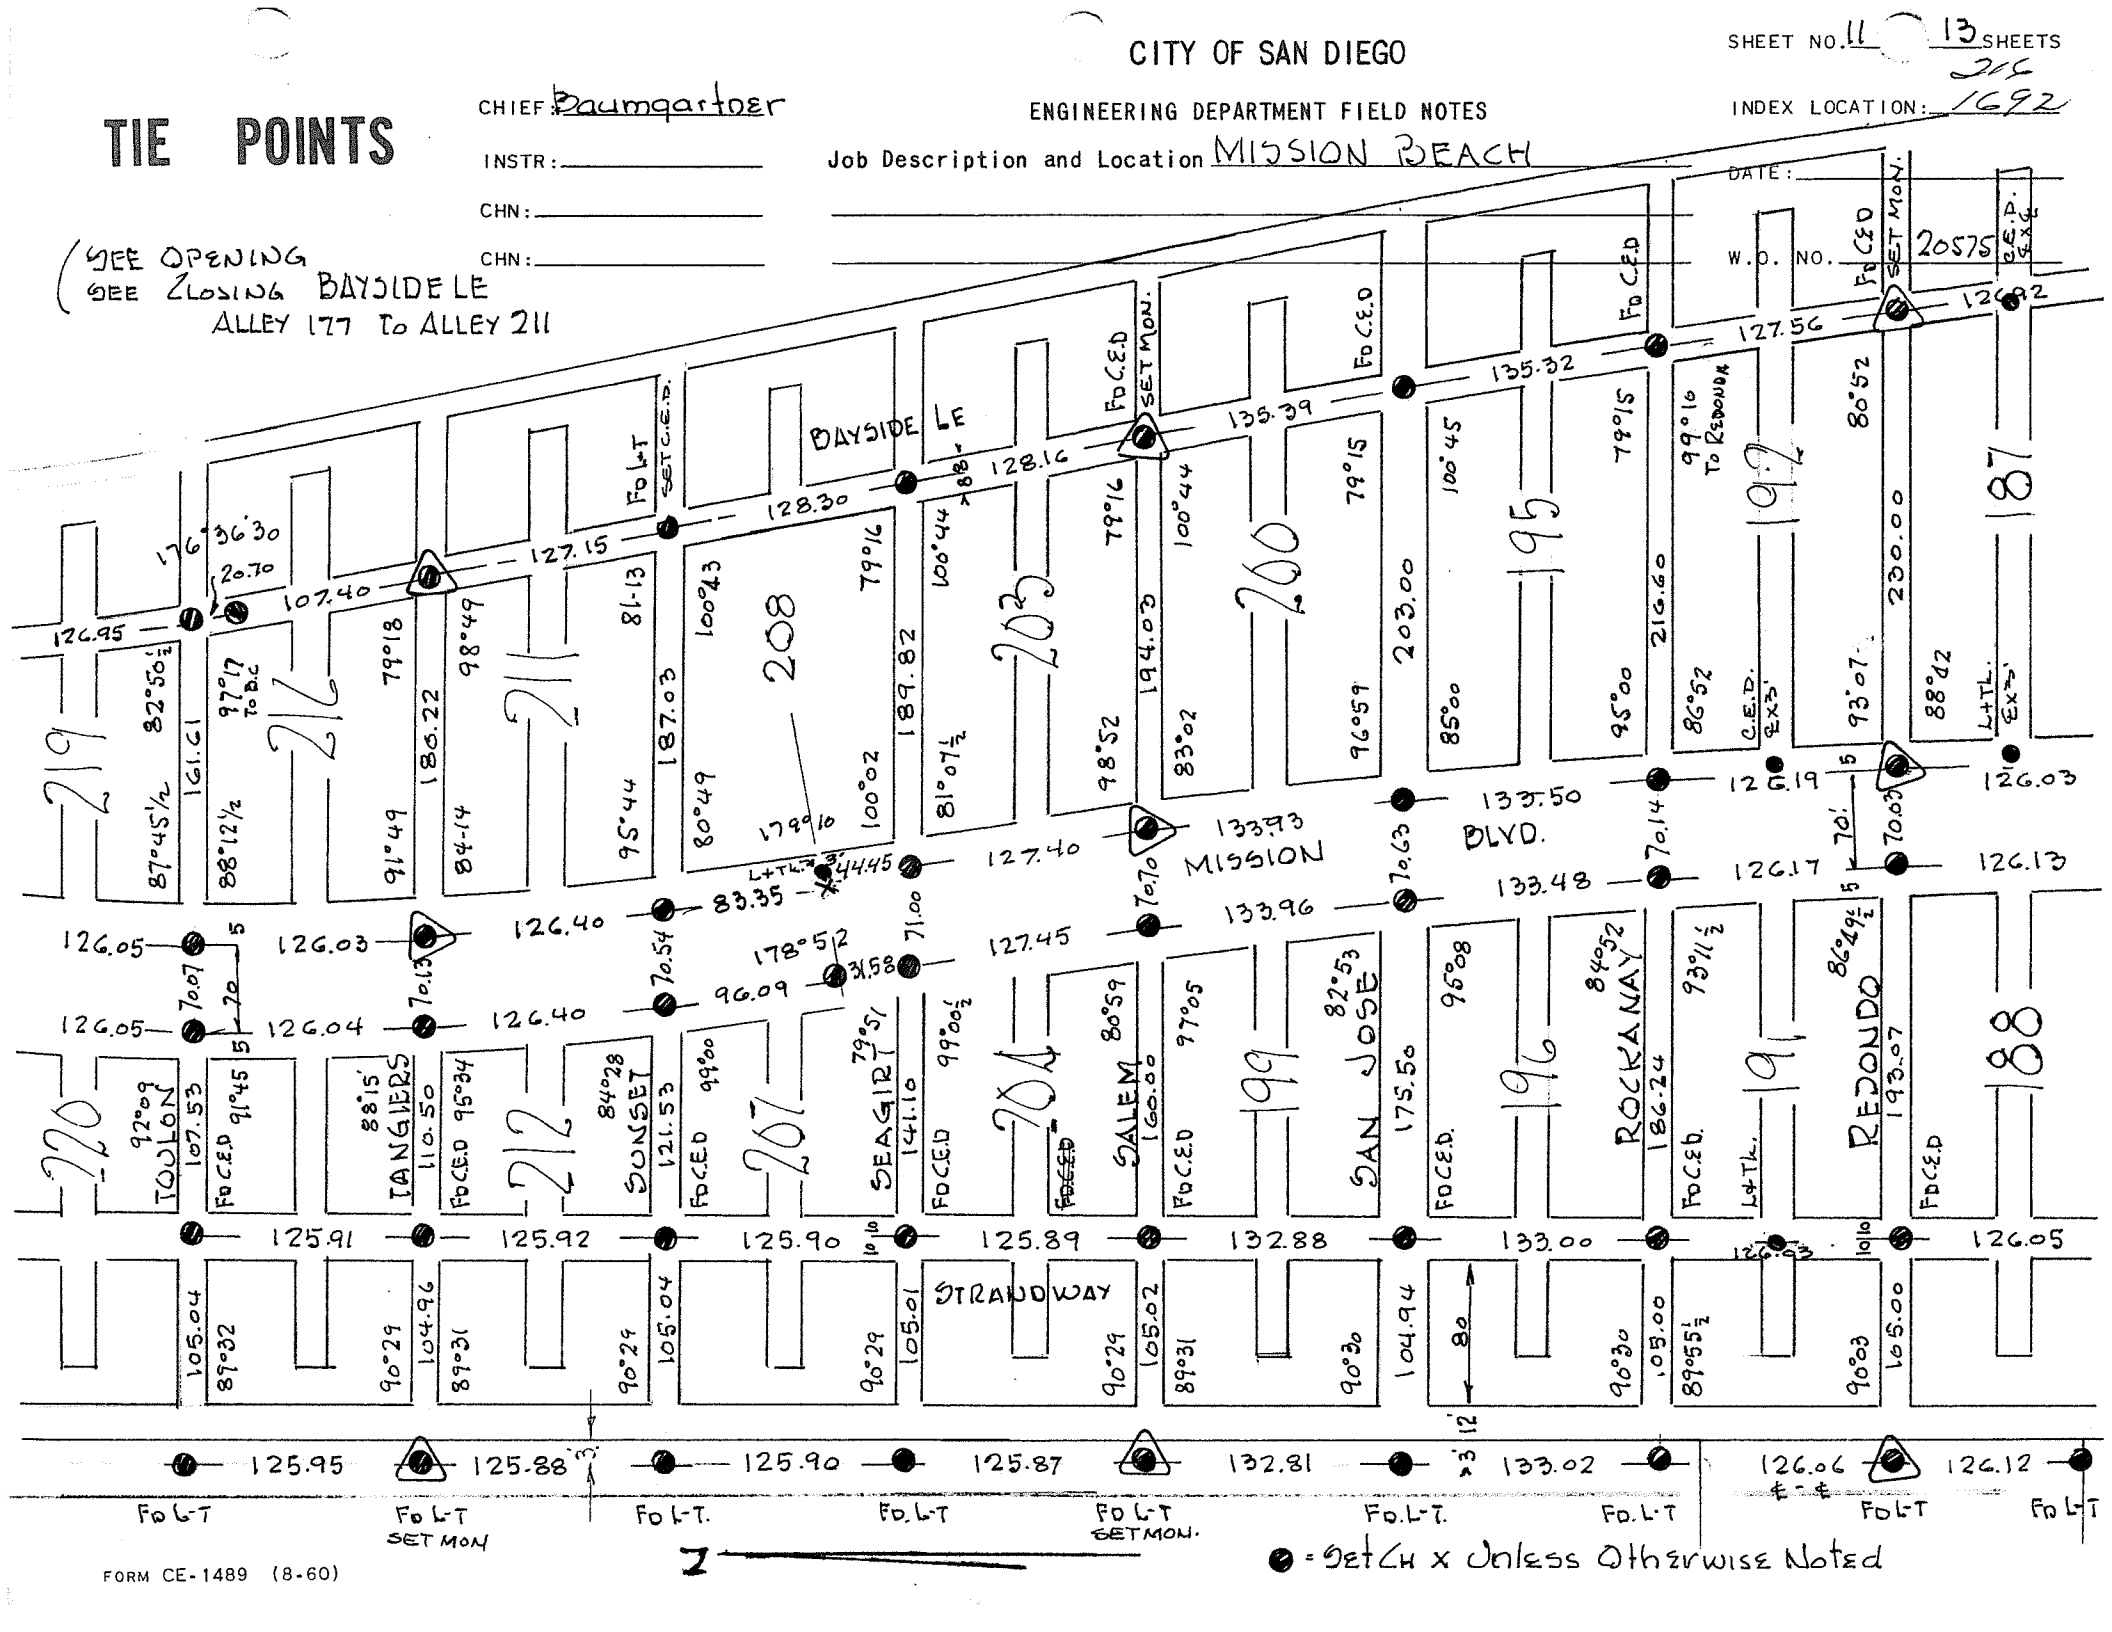

FORM CE-1489 (8-60)

CITY OF SAN DIEGO

ENGINEERING DEPARTMENT FIELD NOTES

SHEET NO. 12 OF 13 SHEETS

316-1692

INDEX LOCATION ~~222-26~~ 1692

CHIEF Baumgartner

INSTR:

CHN:

CHN:

Job Description and Location MISSION BEACH

DATE: MAY 1965

W.O. NO. 20575

NOTE:
LOTS IN BLKS
234 - 235 - 240
EVIDENTLY GO TO
SOR LINE &
ELIMINATE ALLEY
SEE T.P. BK 25/14-15

On ℄ Set Ch x Each 25'. B.C. to E.C.
South to North

SEE T.P.B 25 P 14&15

BAYSIDE LE

MISSION BLVD.

YORK

YARMOUTH

WINDEMERE

WHITING

VERONA

VENICE

SAN RAFAEL

VANITIE

TOULON

STRAND

X = Set Ch x Unless Otherwise Noted

FORM CE-1489 (8-60)

CITY OF SAN DIEGO

ENGINEERING DEPARTMENT FIELD NOTES

SHEET NO. 13 OF 13 SHEETS

INDEX LOCATION: 216 1692

CHIEF: Baumgartner

INSTR: Gaddy

CHN: Moralez

CHN: Orlando

Job Description and Location MISSION BEACH
TIE POINT SURVEY

DATE: MAY 1965

W.O. NO. 20575

● = Ch x Unless Otherwise Noted

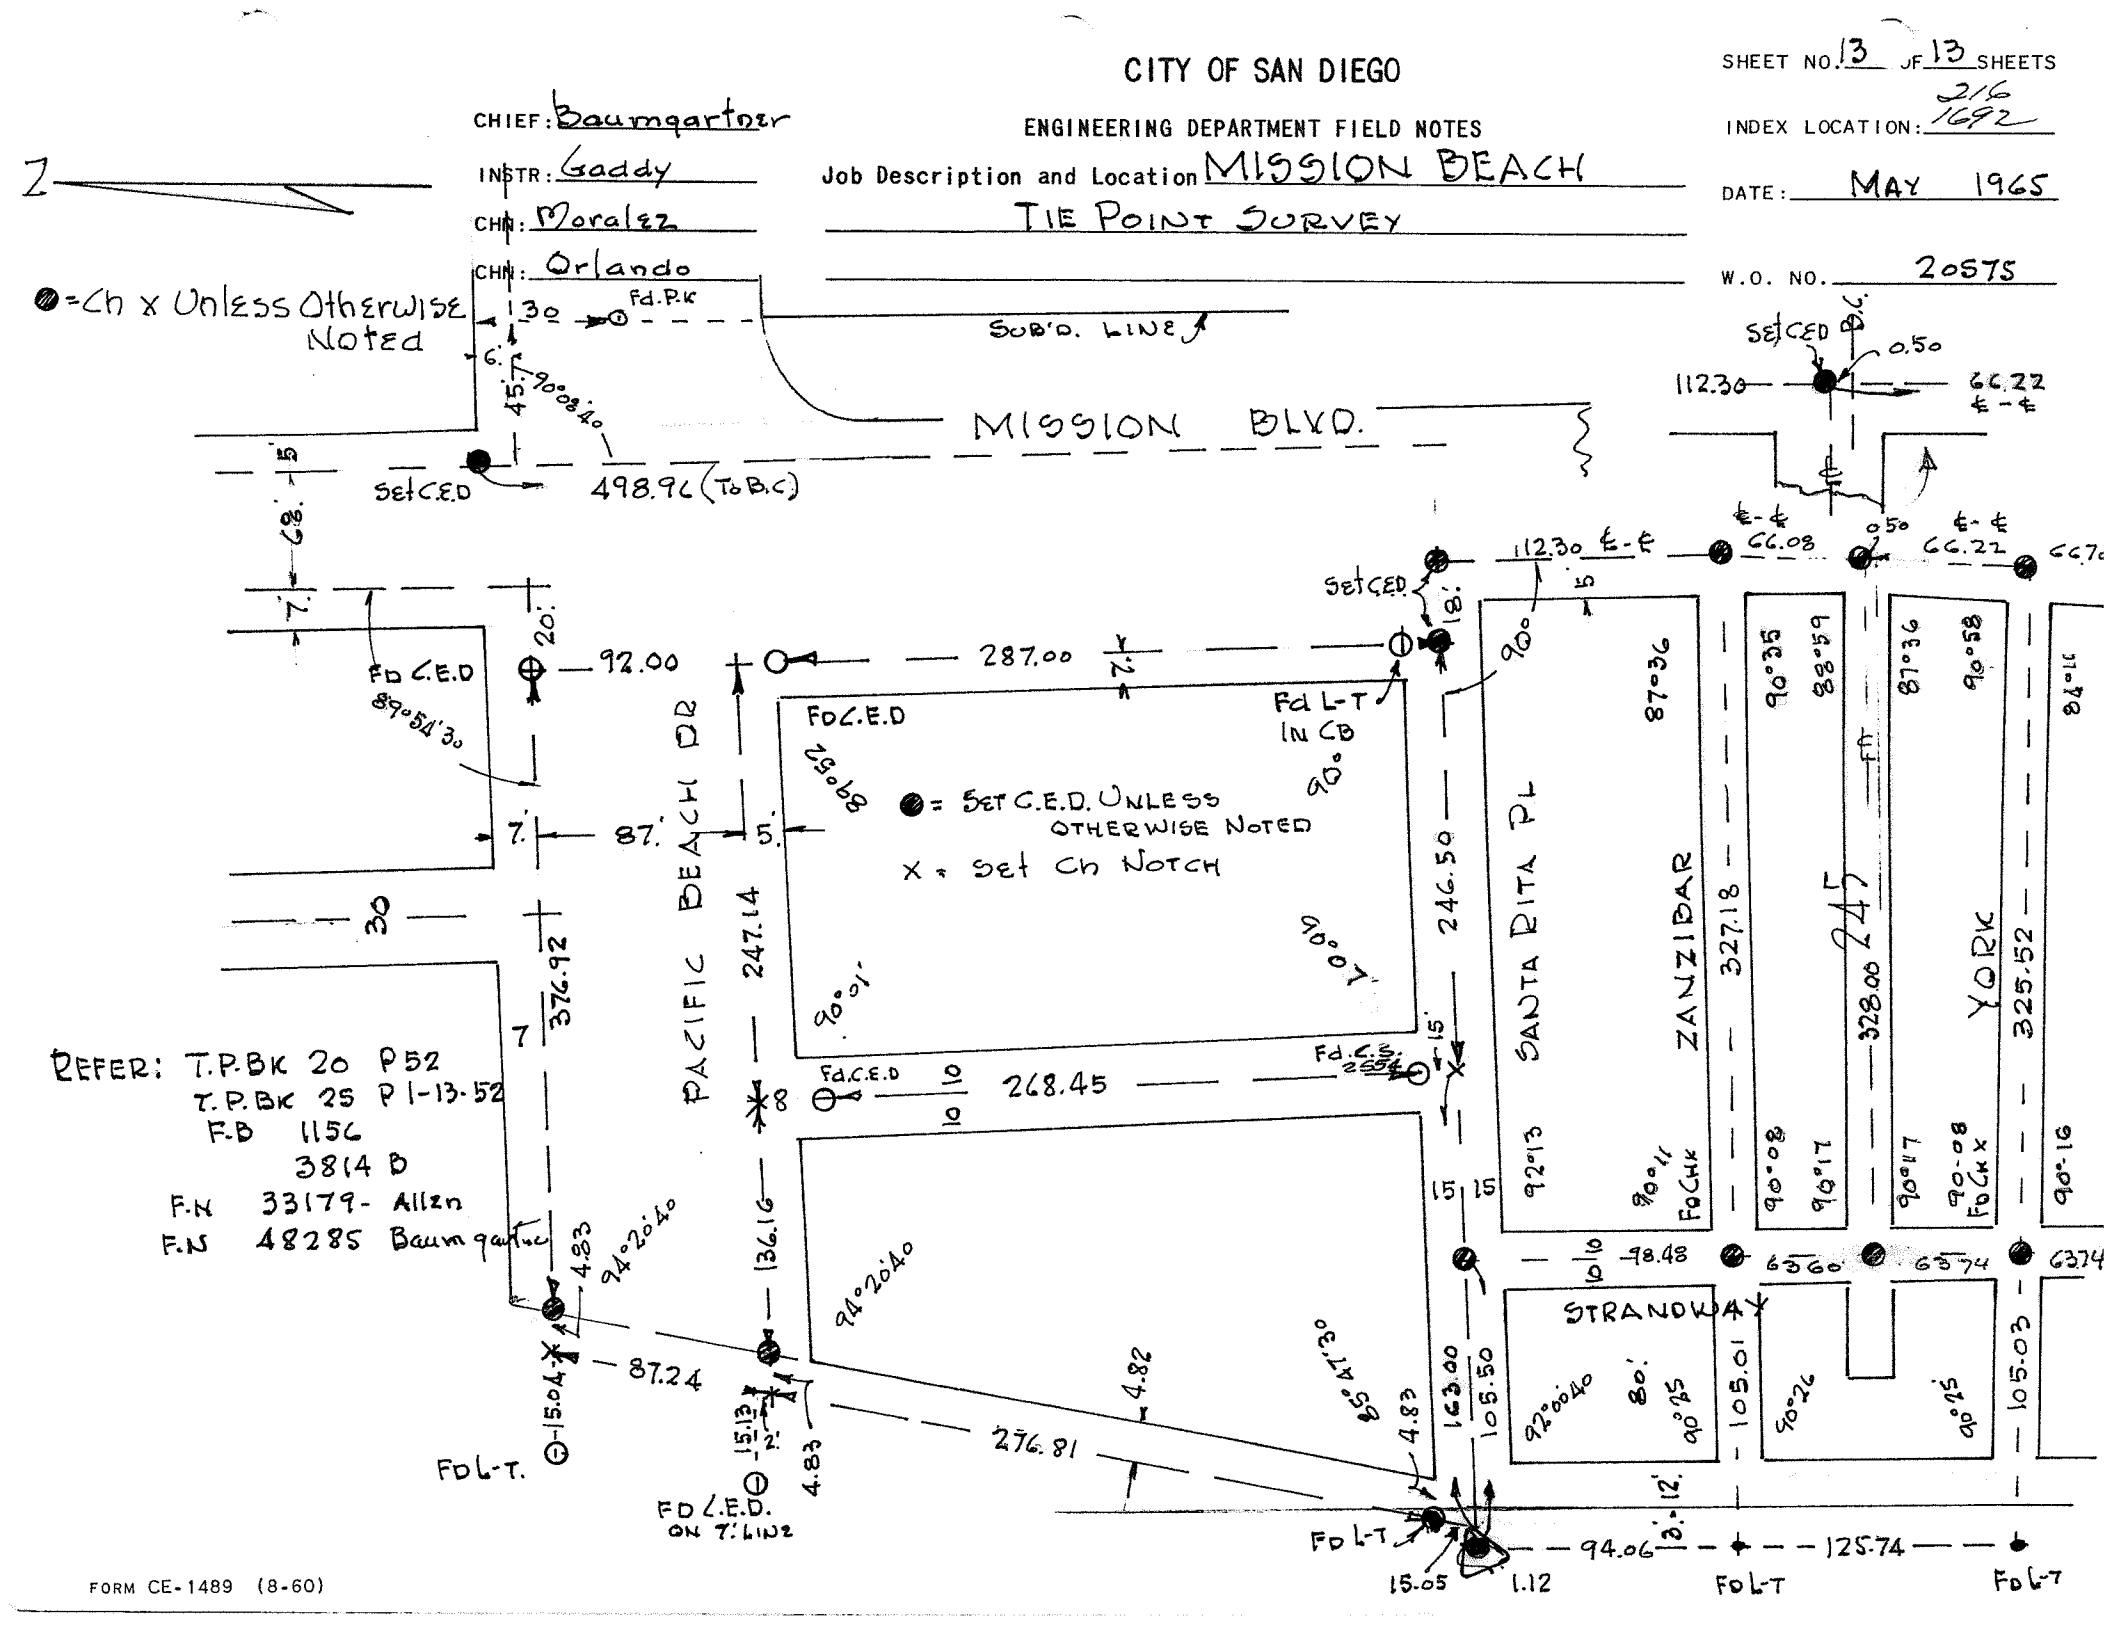

REFER: T.P.BK 20 P52
T.P.BK 25 P 1-13-52
F.B 1156
3814 B
F.N 33179- Allen
F.N 48285 Baumgartner

FORM CE-1489 (8-60)